

INDIANA DEPARTMENT OF NATURAL RESOURCES

SALAMONIE RESERVOIR


LOST BRIDGE WEST STATE RECREATION AREA

WASTEWATER TREATMENT PLANT IMPROVEMENTS PROJECT

PUBLIC WORKS PROJECT NO. E031410M

MARCH, 2004

SHEET INDEX	
SHEET	SHEET DESCRIPTION
1)	TITLE SHEET
2)	TREATMENT PLANT DEMOLITION
3)	SITE PLAN AND HYDRAULIC PROFILE
4)	HEADWORKS STRUCTURE
5-10)	TREATMENT PLANT PLAN AND SECTIONS
11)	ULTRAVIOLET STRUCTURE
12)	FLUME STRUCTURE
13)	CASCADE STRUCTURE
14)	BLOWER AND CONTROL DETAIL
15)	CAMPGROUND LIFT STATION DEMO
16)	CAMPGROUND LIFT STATION
17)	CAMPGROUND LIFT STATION SECTION AND DETAILS
18)	MODIFICATION OF EXISTING WET WELL
19)	BEACH LIFT STATION
20)	BEACH LIFT STATION SECTION AND DETAILS
21-22)	VISITOR CENTER GRINDER STATION AND FORCE MAIN
23-25)	MISCELLANEOUS DETAILS
26)	GRINDER STATIONS
27-34)	ARCHITECTURAL DRAWINGS
35-41)	STRUCTURAL DRAWINGS
41-51)	ELECTRICAL DRAWINGS
52)	NEW WATER MAIN

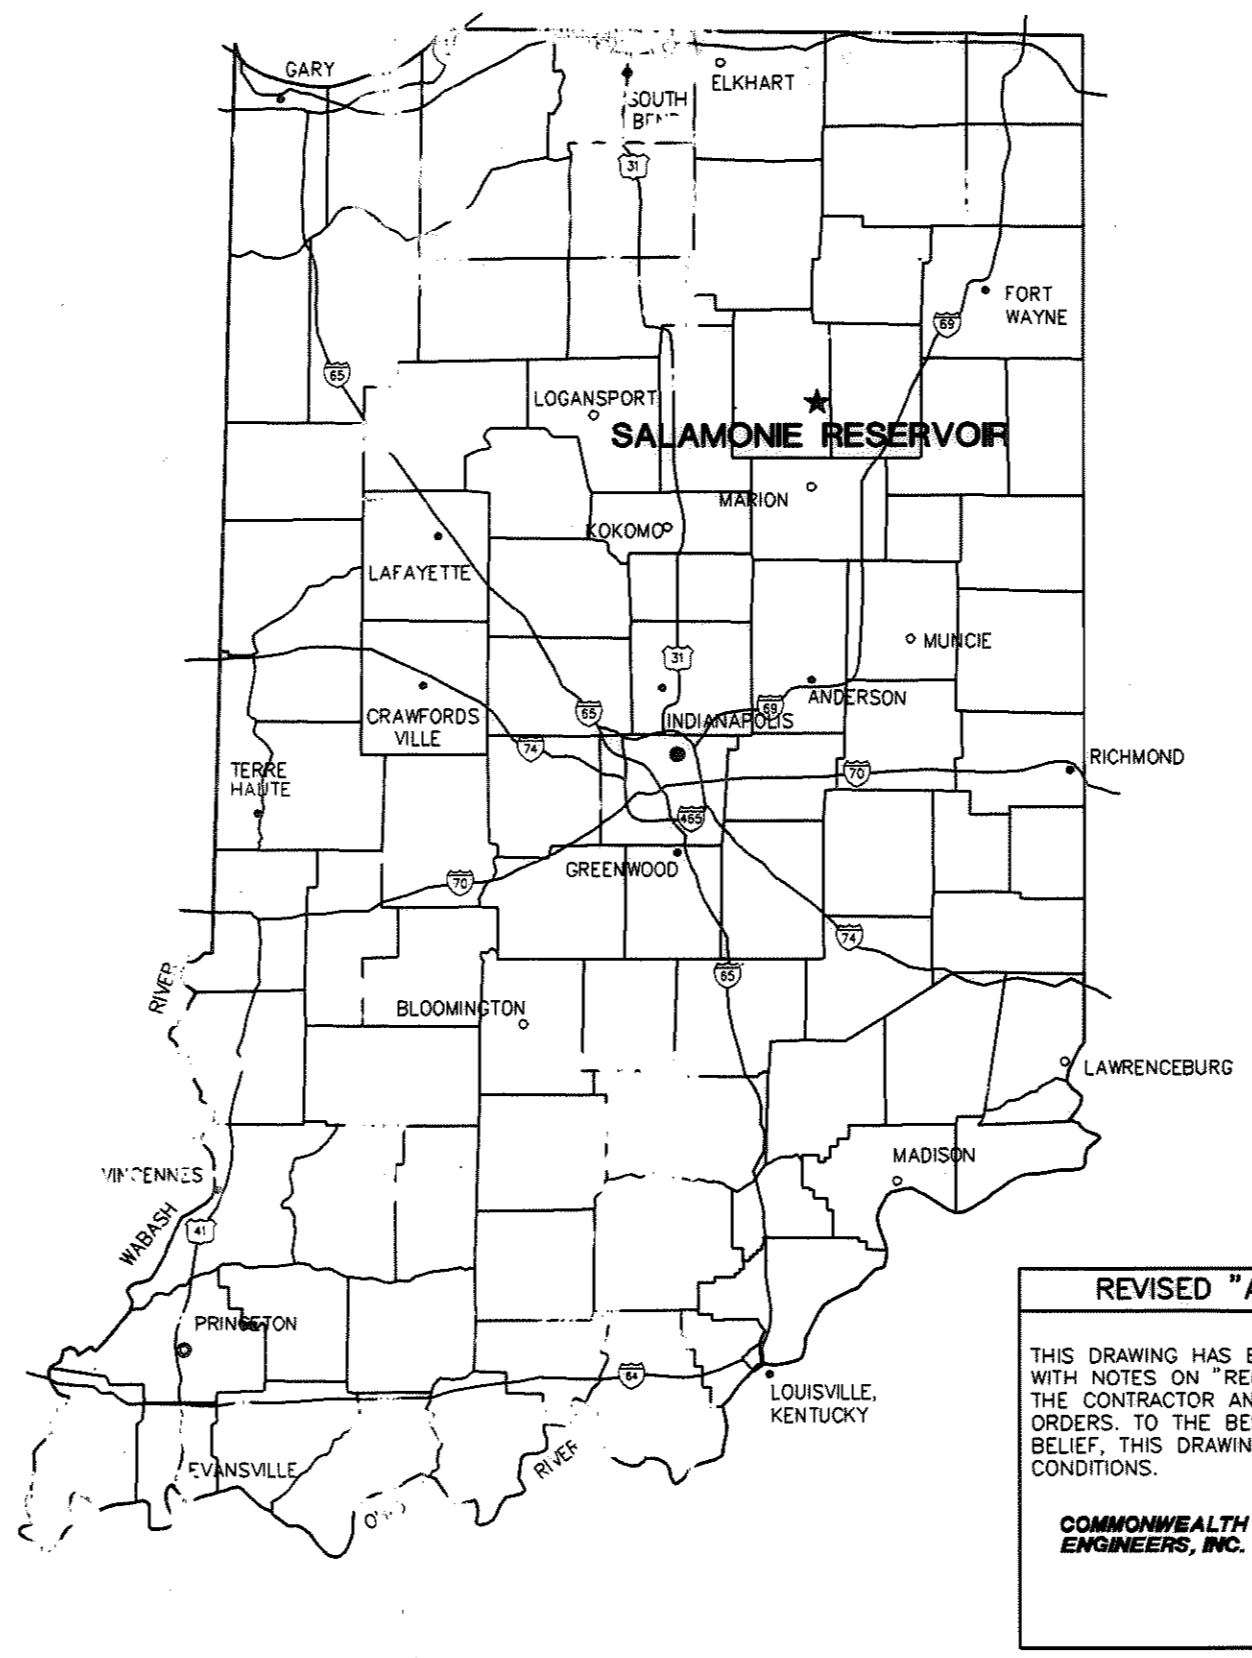

REVISED "AS-BUILT" DRAWING

THIS DRAWING HAS BEEN REVISED IN ACCORDANCE WITH NOTES ON "RECORD DRAWINGS" FURNISHED BY THE CONTRACTOR AND WITH EXECUTED CHANGE ORDERS. TO THE BEST OF OUR KNOWLEDGE AND BELIEF, THIS DRAWING SHOWS ACTUAL "AS-BUILT" CONDITIONS.

COMMONWEALTH ENGINEERS, INC.

REVISED: DATE 10/06
BY JCW, CK BY CWW

PROJECT AREA MAP

LOST BRIDGE WEST STATE RECREATION AREA

OFFICE ADDRESS: 9214 WEST LOST BRIDGE WEST
ANDREWS, INDIANA 46702-9731
TELEPHONE NO: (260) 468-2125



DNR DIRECTOR - JOHN R. GOSS
GOVERNOR OF INDIANA - JOSEPH E. KERNAN




COMMONWEALTH ENGINEERS, INC.

APPROVED: MARK D. DOWNEY, P.E., L.S. DATE: _____
Indiana P.E. No. 17210


CERTIFIED: CURTISS W. WHITE, P.E. DATE: _____
Indiana P.E. No. 19400134

CONTRACT NO: S02119-02

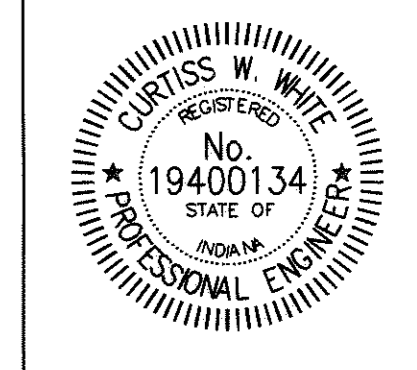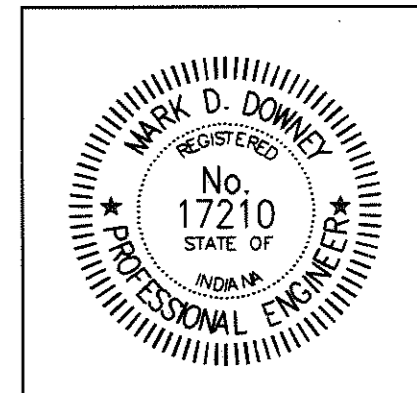

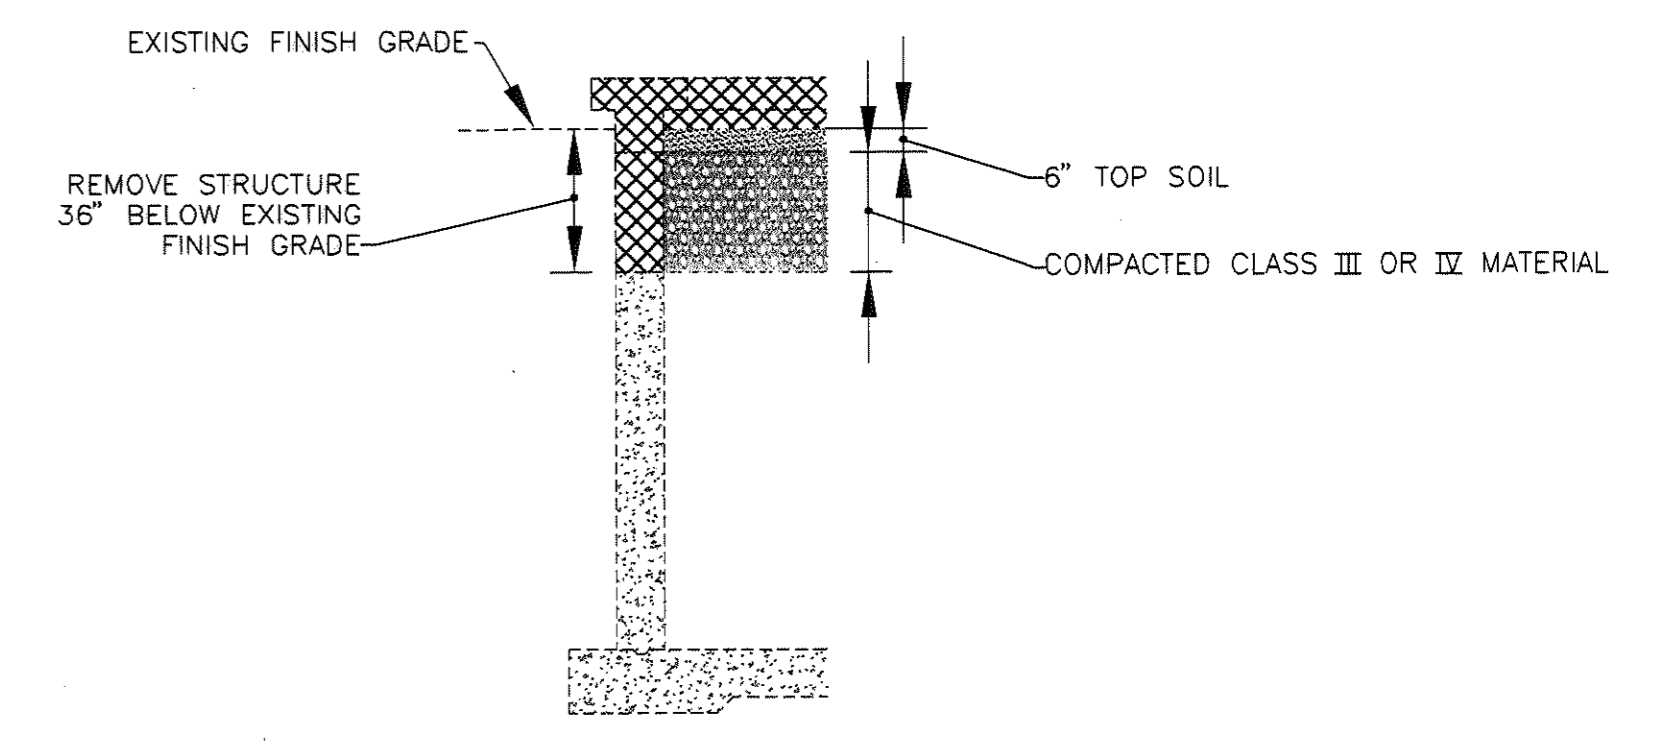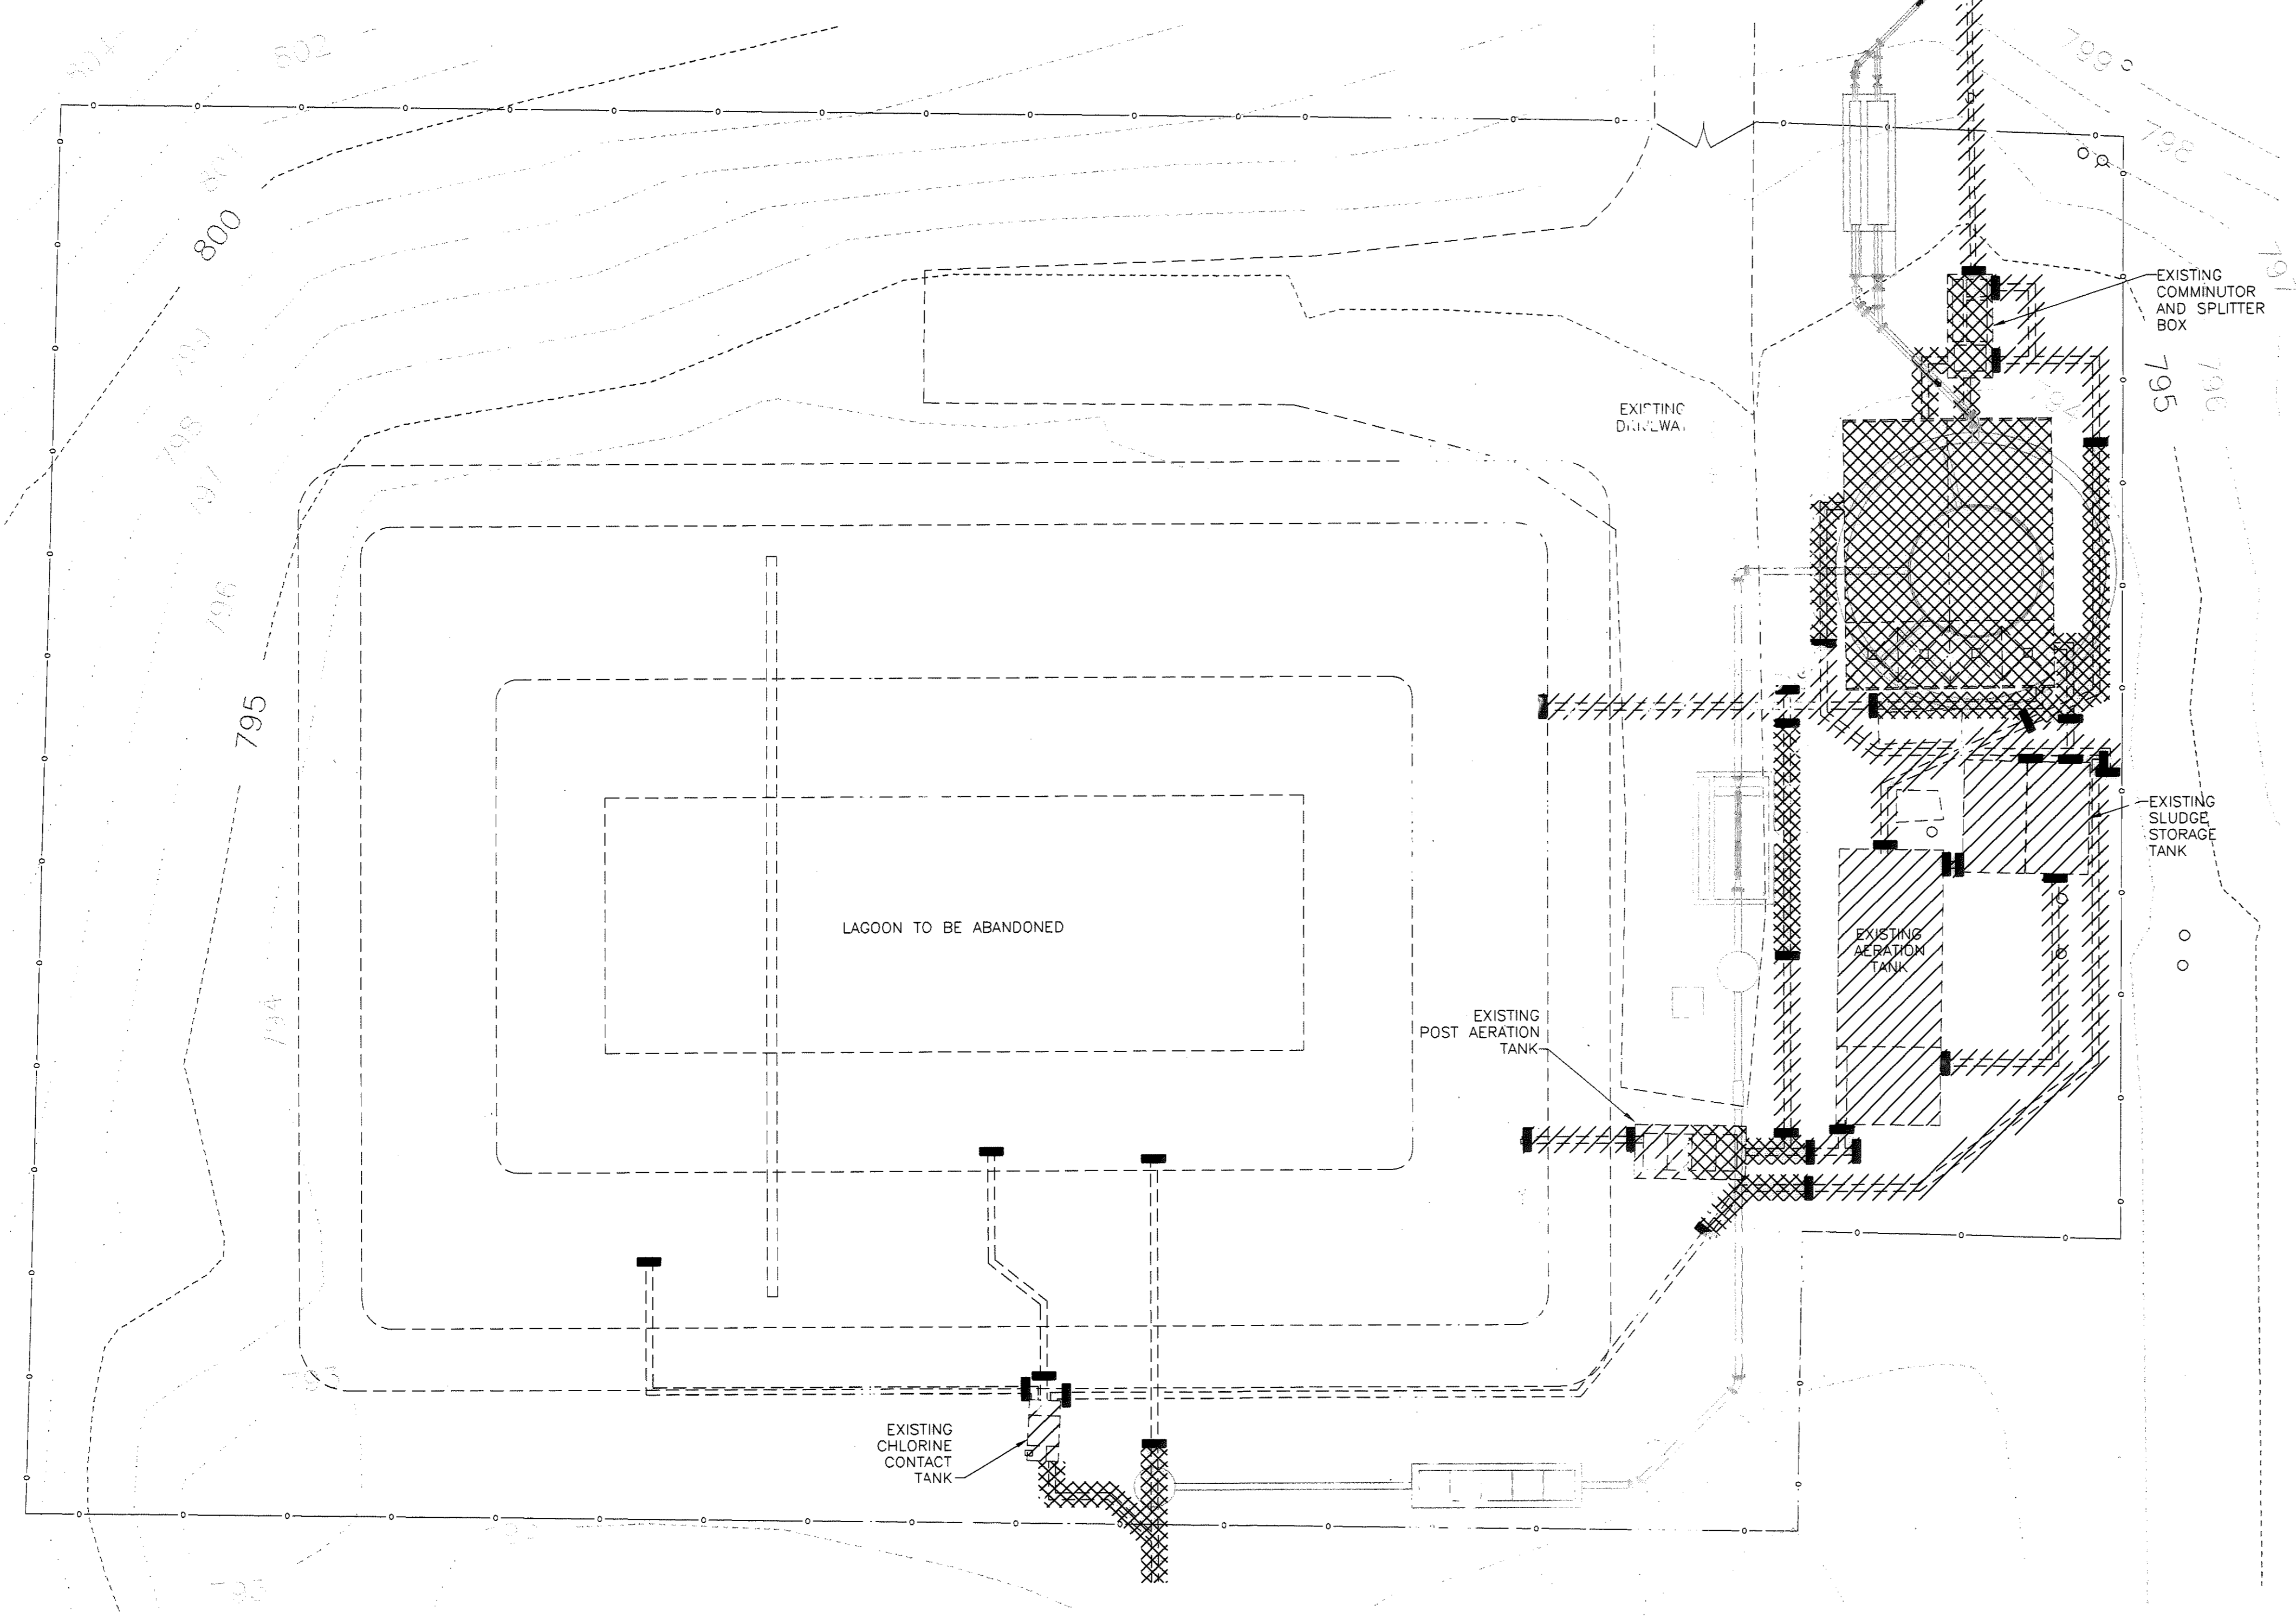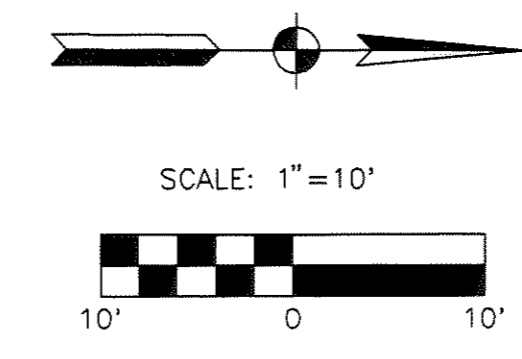


**EXISTING CONCRETE STRUCTURE
 TO BE PARTIALLY REMOVED**
 SCALE : 1/4" = 1'-0"

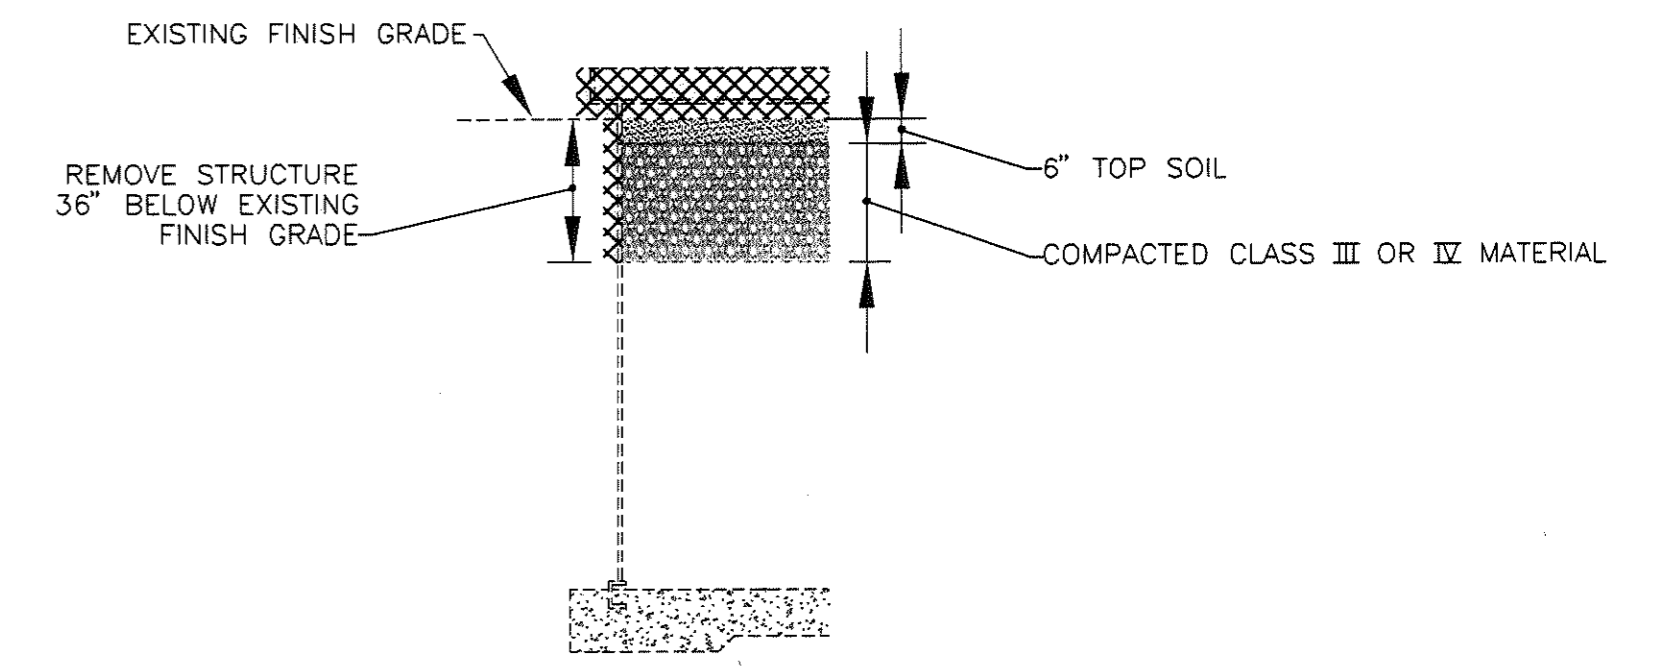

**EXISTING STEEL STRUCTURE
 TO BE PARTIALLY REMOVED**
 SCALE : 1/4" = 1'-0"

LEGEND :

- ===== EXISTING PIPE TO REMAIN
- ##### EXISTING PIPE TO BE ABANDONED
- XXXXXX EXISTING PIPE TO BE REMOVED
- ////// EXISTING STRUCTURE TO BE PARTIALLY REMOVED (SEE DETAILS ABOVE)
- XXXXXX EXISTING STRUCTURE TO BE REMOVED
- +++++ EXISTING PIPE PLUG AND SEAL

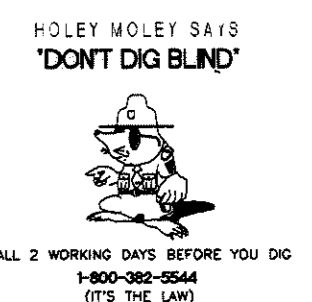


02-DEMO.dwg 120

REVISED "AS-BUILT" DRAWING

THIS DRAWING HAS BEEN REVISED IN ACCORDANCE WITH NOTES ON "RECORD DRAWINGS" FURNISHED BY THE CONTRACTOR AND WITH EXECUTED CHANGE ORDERS. TO THE BEST OF OUR KNOWLEDGE AND BELIEF, THIS DRAWING SHOWS ACTUAL "AS-BUILT" CONDITIONS.

COMMONWEALTH ENGINEERS, INC.

REVISED: DATE 10/06
 BY: JCW, CK. BY: CWV

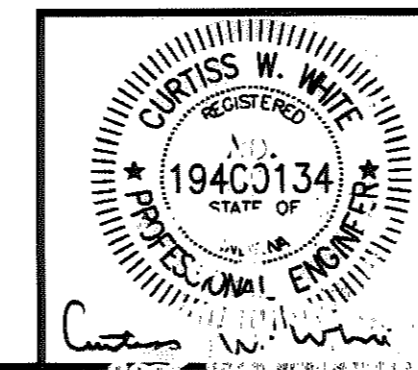


COMMONWEALTH ENGINEERS, INC.


DRAWN BY:	CB
DESIGNED BY:	CWW
CHECKED BY:	CWW
DATE:	12/03
JOB NO.:	S02119-02
SCALE:	AS NOTED

SALAMONIE RESERVOIR
 WASTEWATER TREATMENT PLANT IMPROVEMENTS PROJECT
 PUBLIC WORKS PROJECT NO. E031410M
 TREATMENT PLANT DEMOLITION


DRAWING NO.	2
2 OF 52	

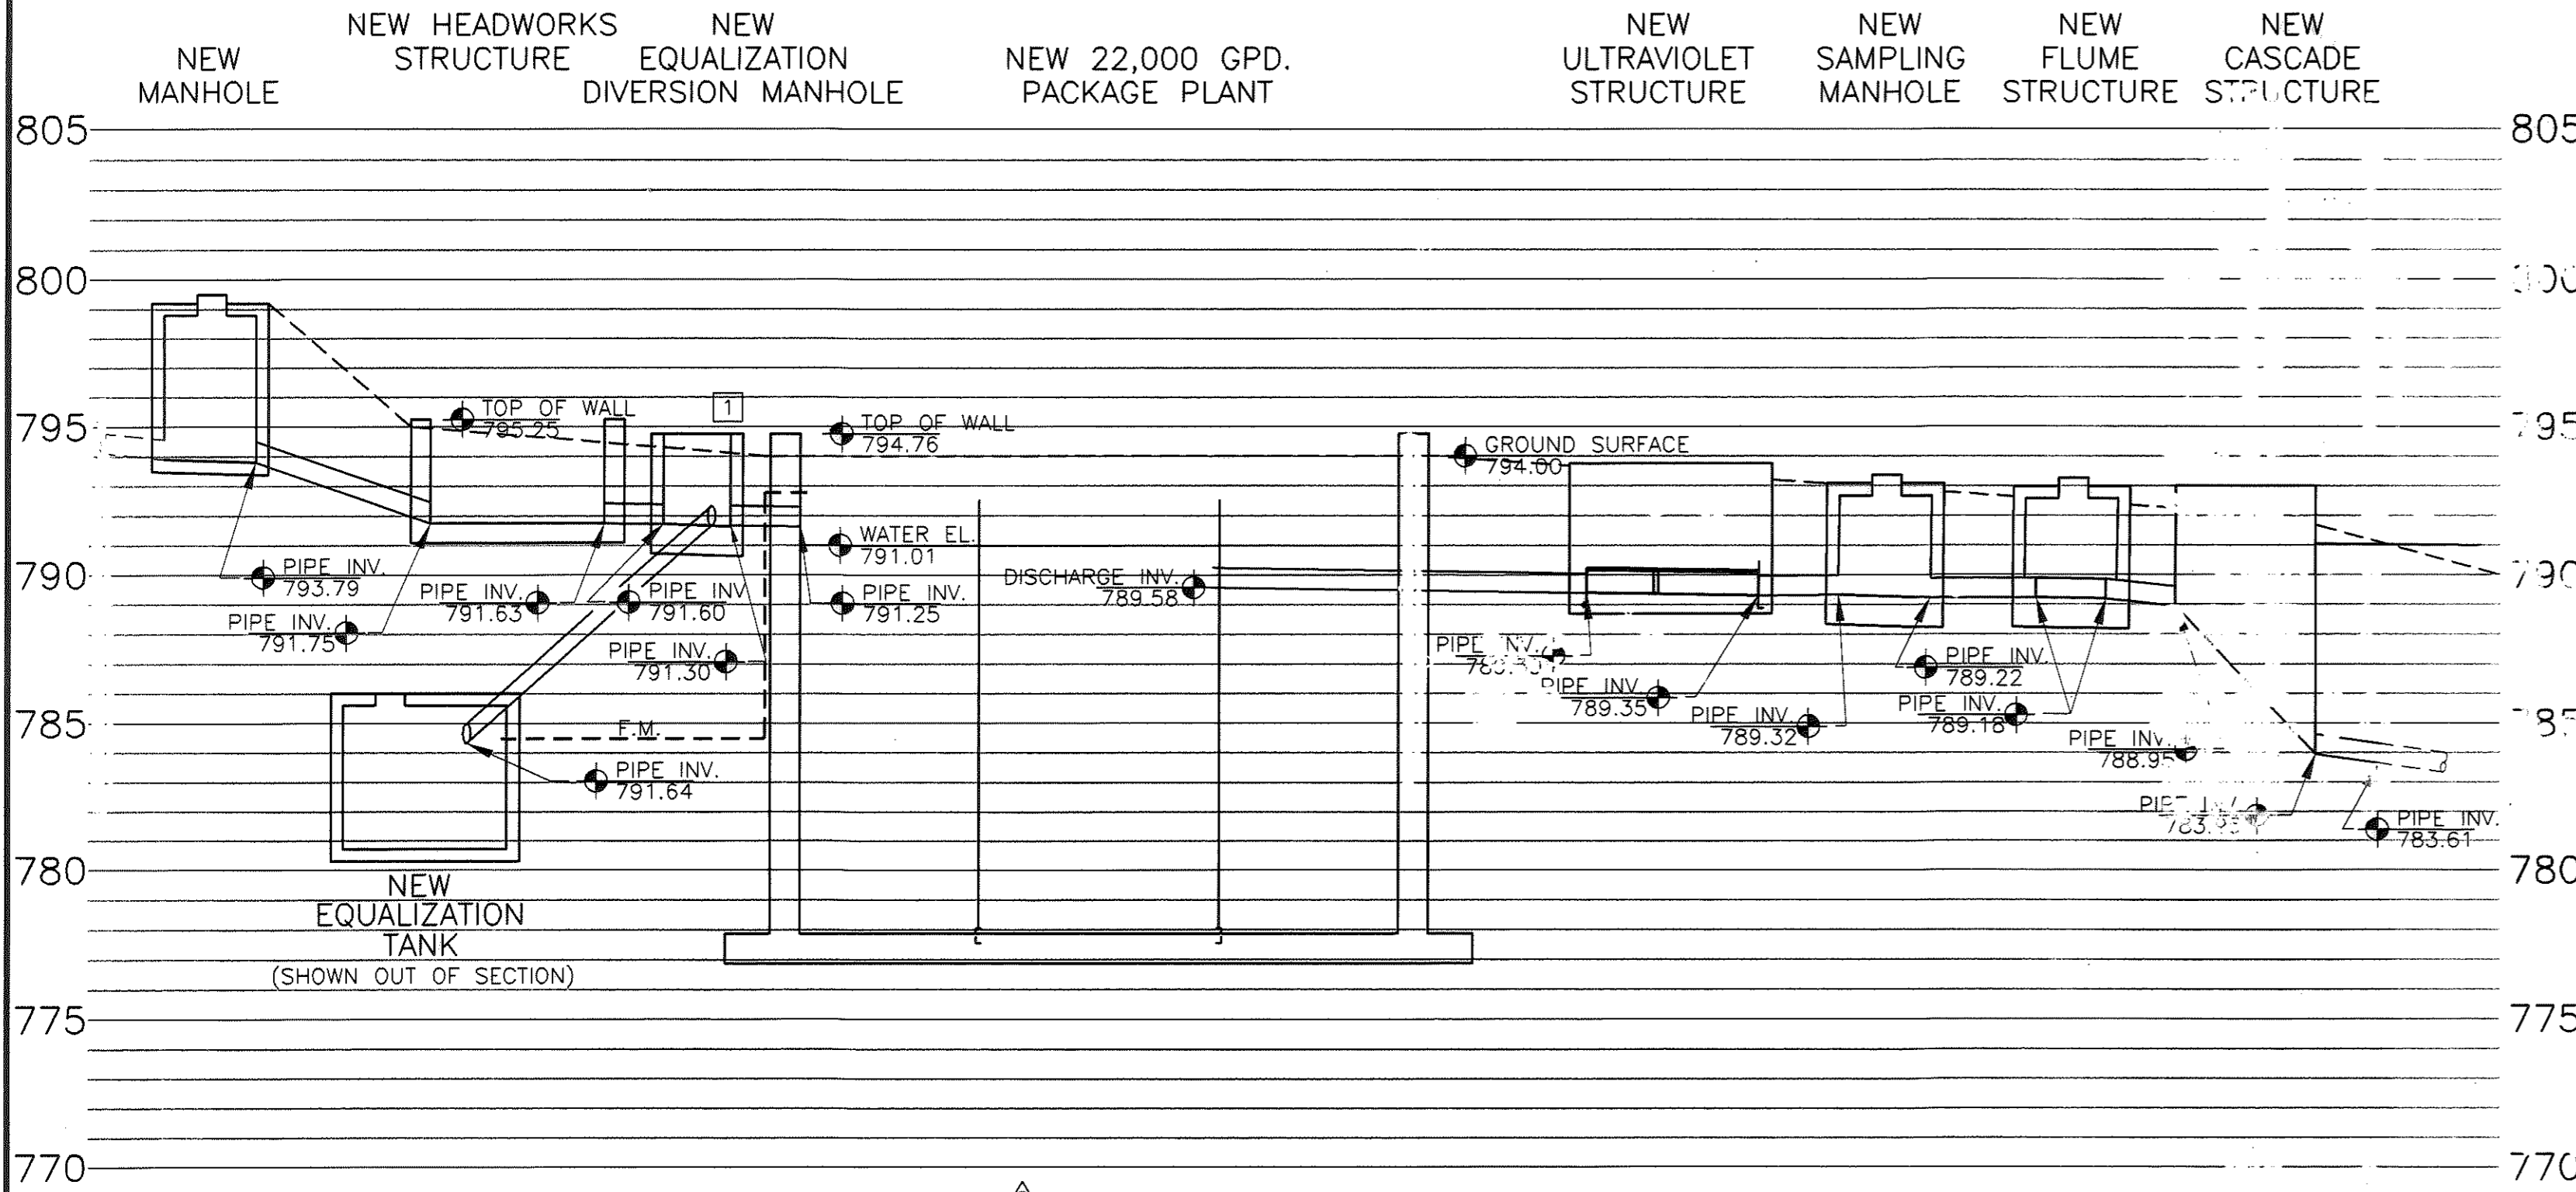

HYDRAULIC PROFILE
 SCALE: VERT. - 1" = 5'-0"
 HORZ. - NOT TO SCALE

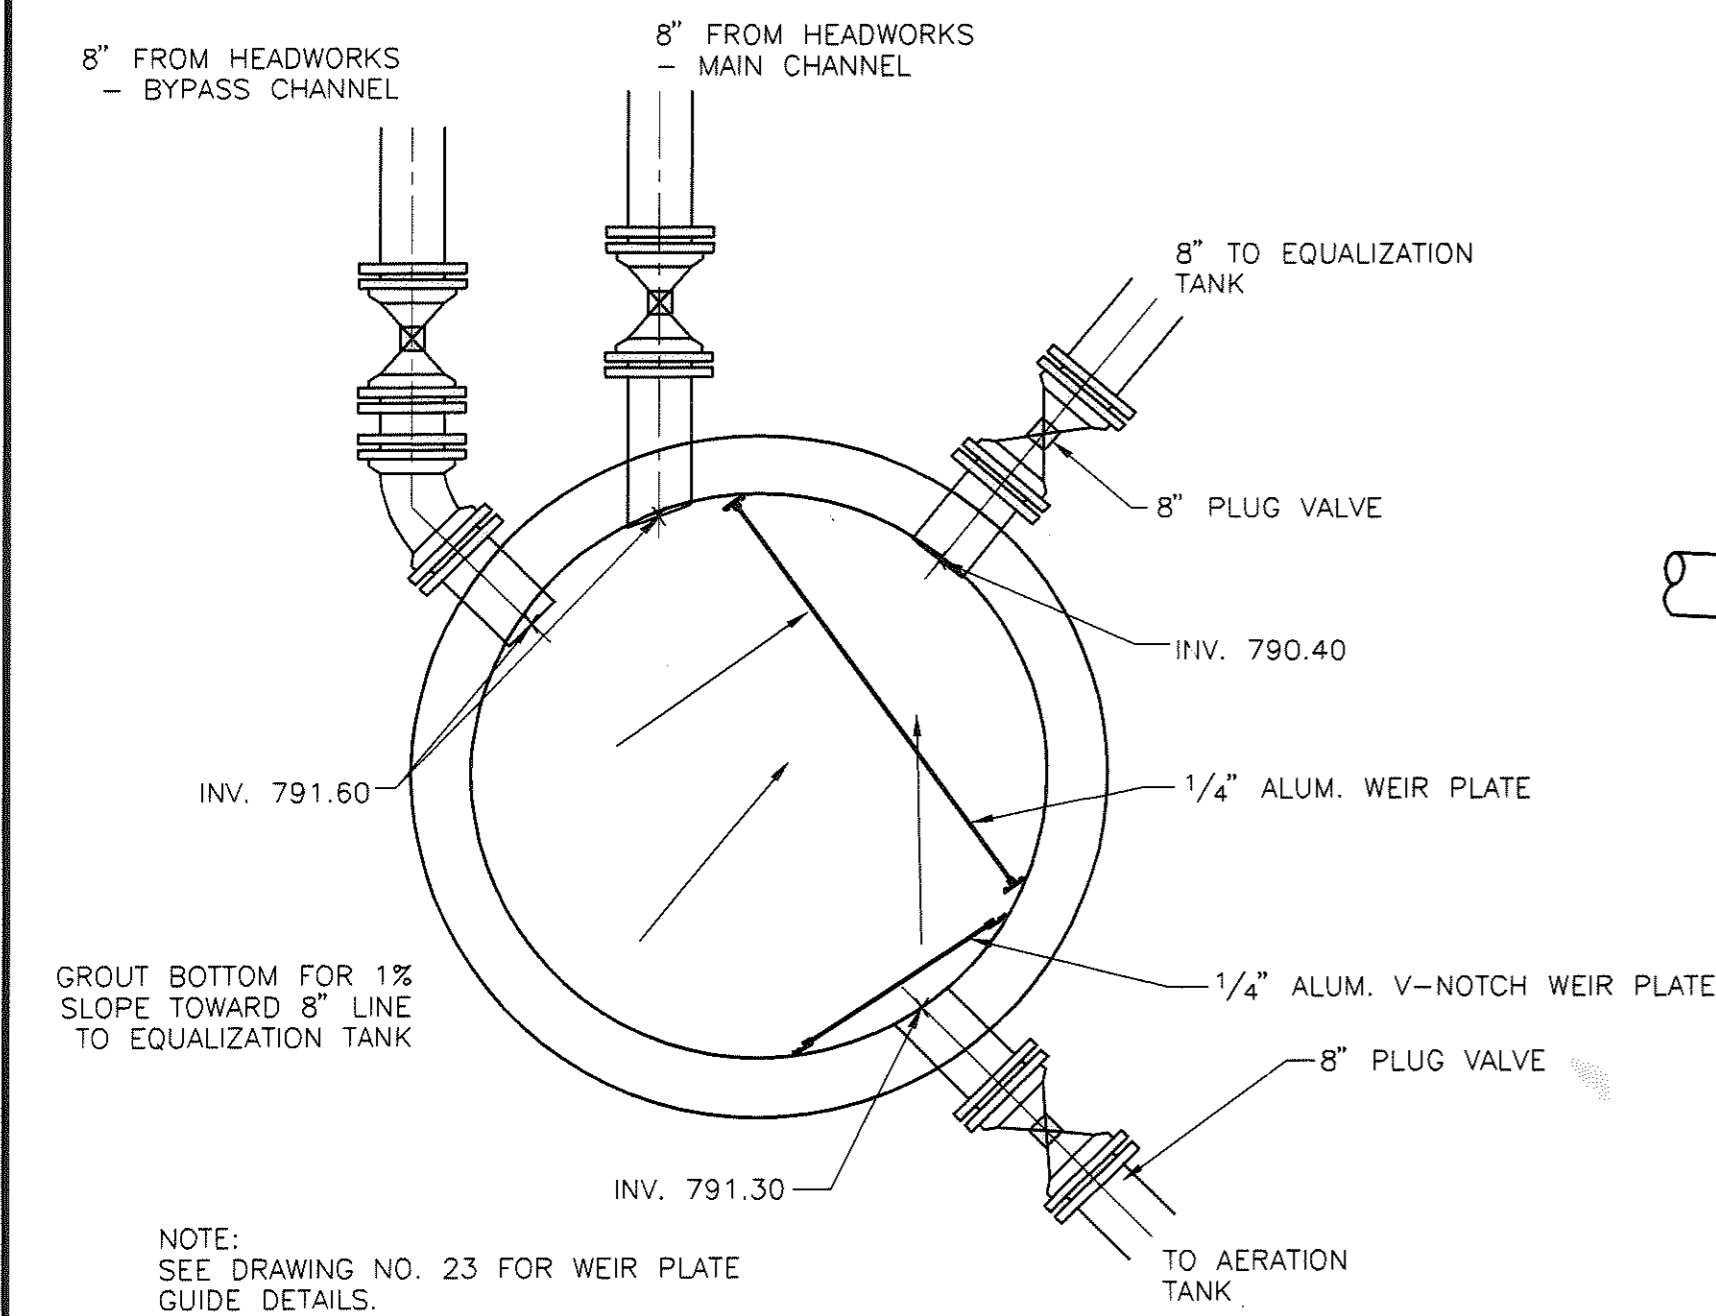


EQUALIZATION DIVERSION MANHOLE

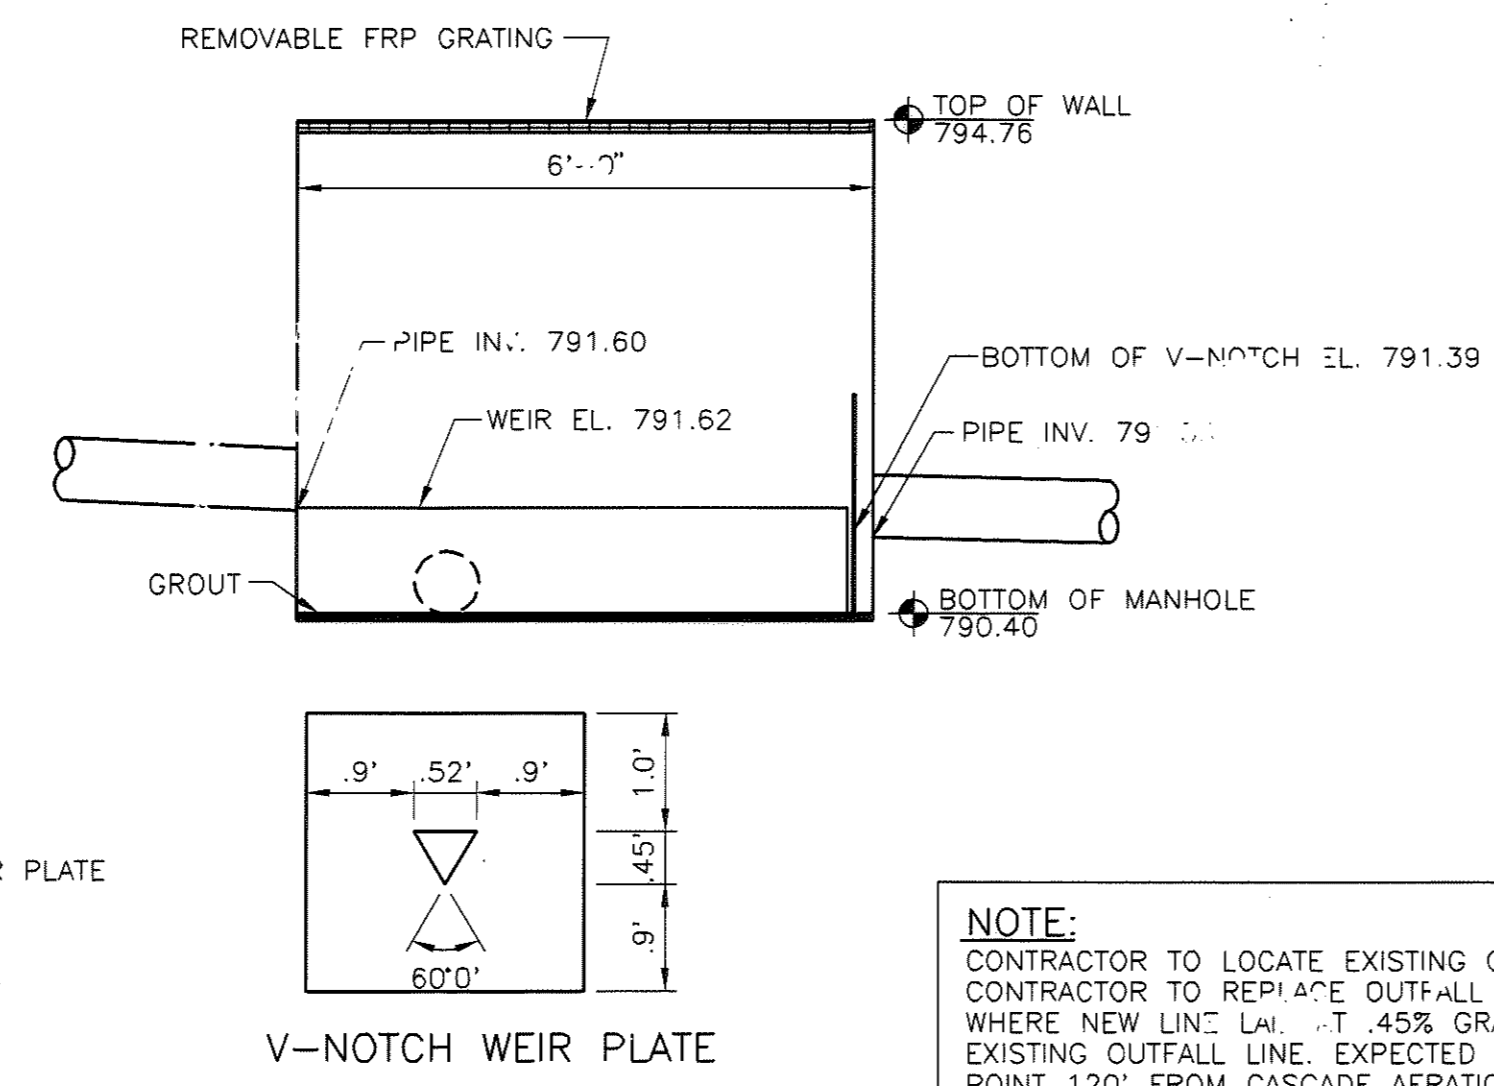

V-NOTCH WEIR PLATE

NOTE:
 CONTRACTOR TO LOCATE EXISTING OUTFALL LINE.
 CONTRACTOR TO REPLACE OUTFALL LINE TO POINT
 WHERE NEW LINE HAS AT LEAST .45% GRADE, INTERCEPTS
 EXISTING OUTFALL LINE. EXPECTED INTERCEPTION
 POINT 120' FROM CASCADE AERATION STRUCTURE

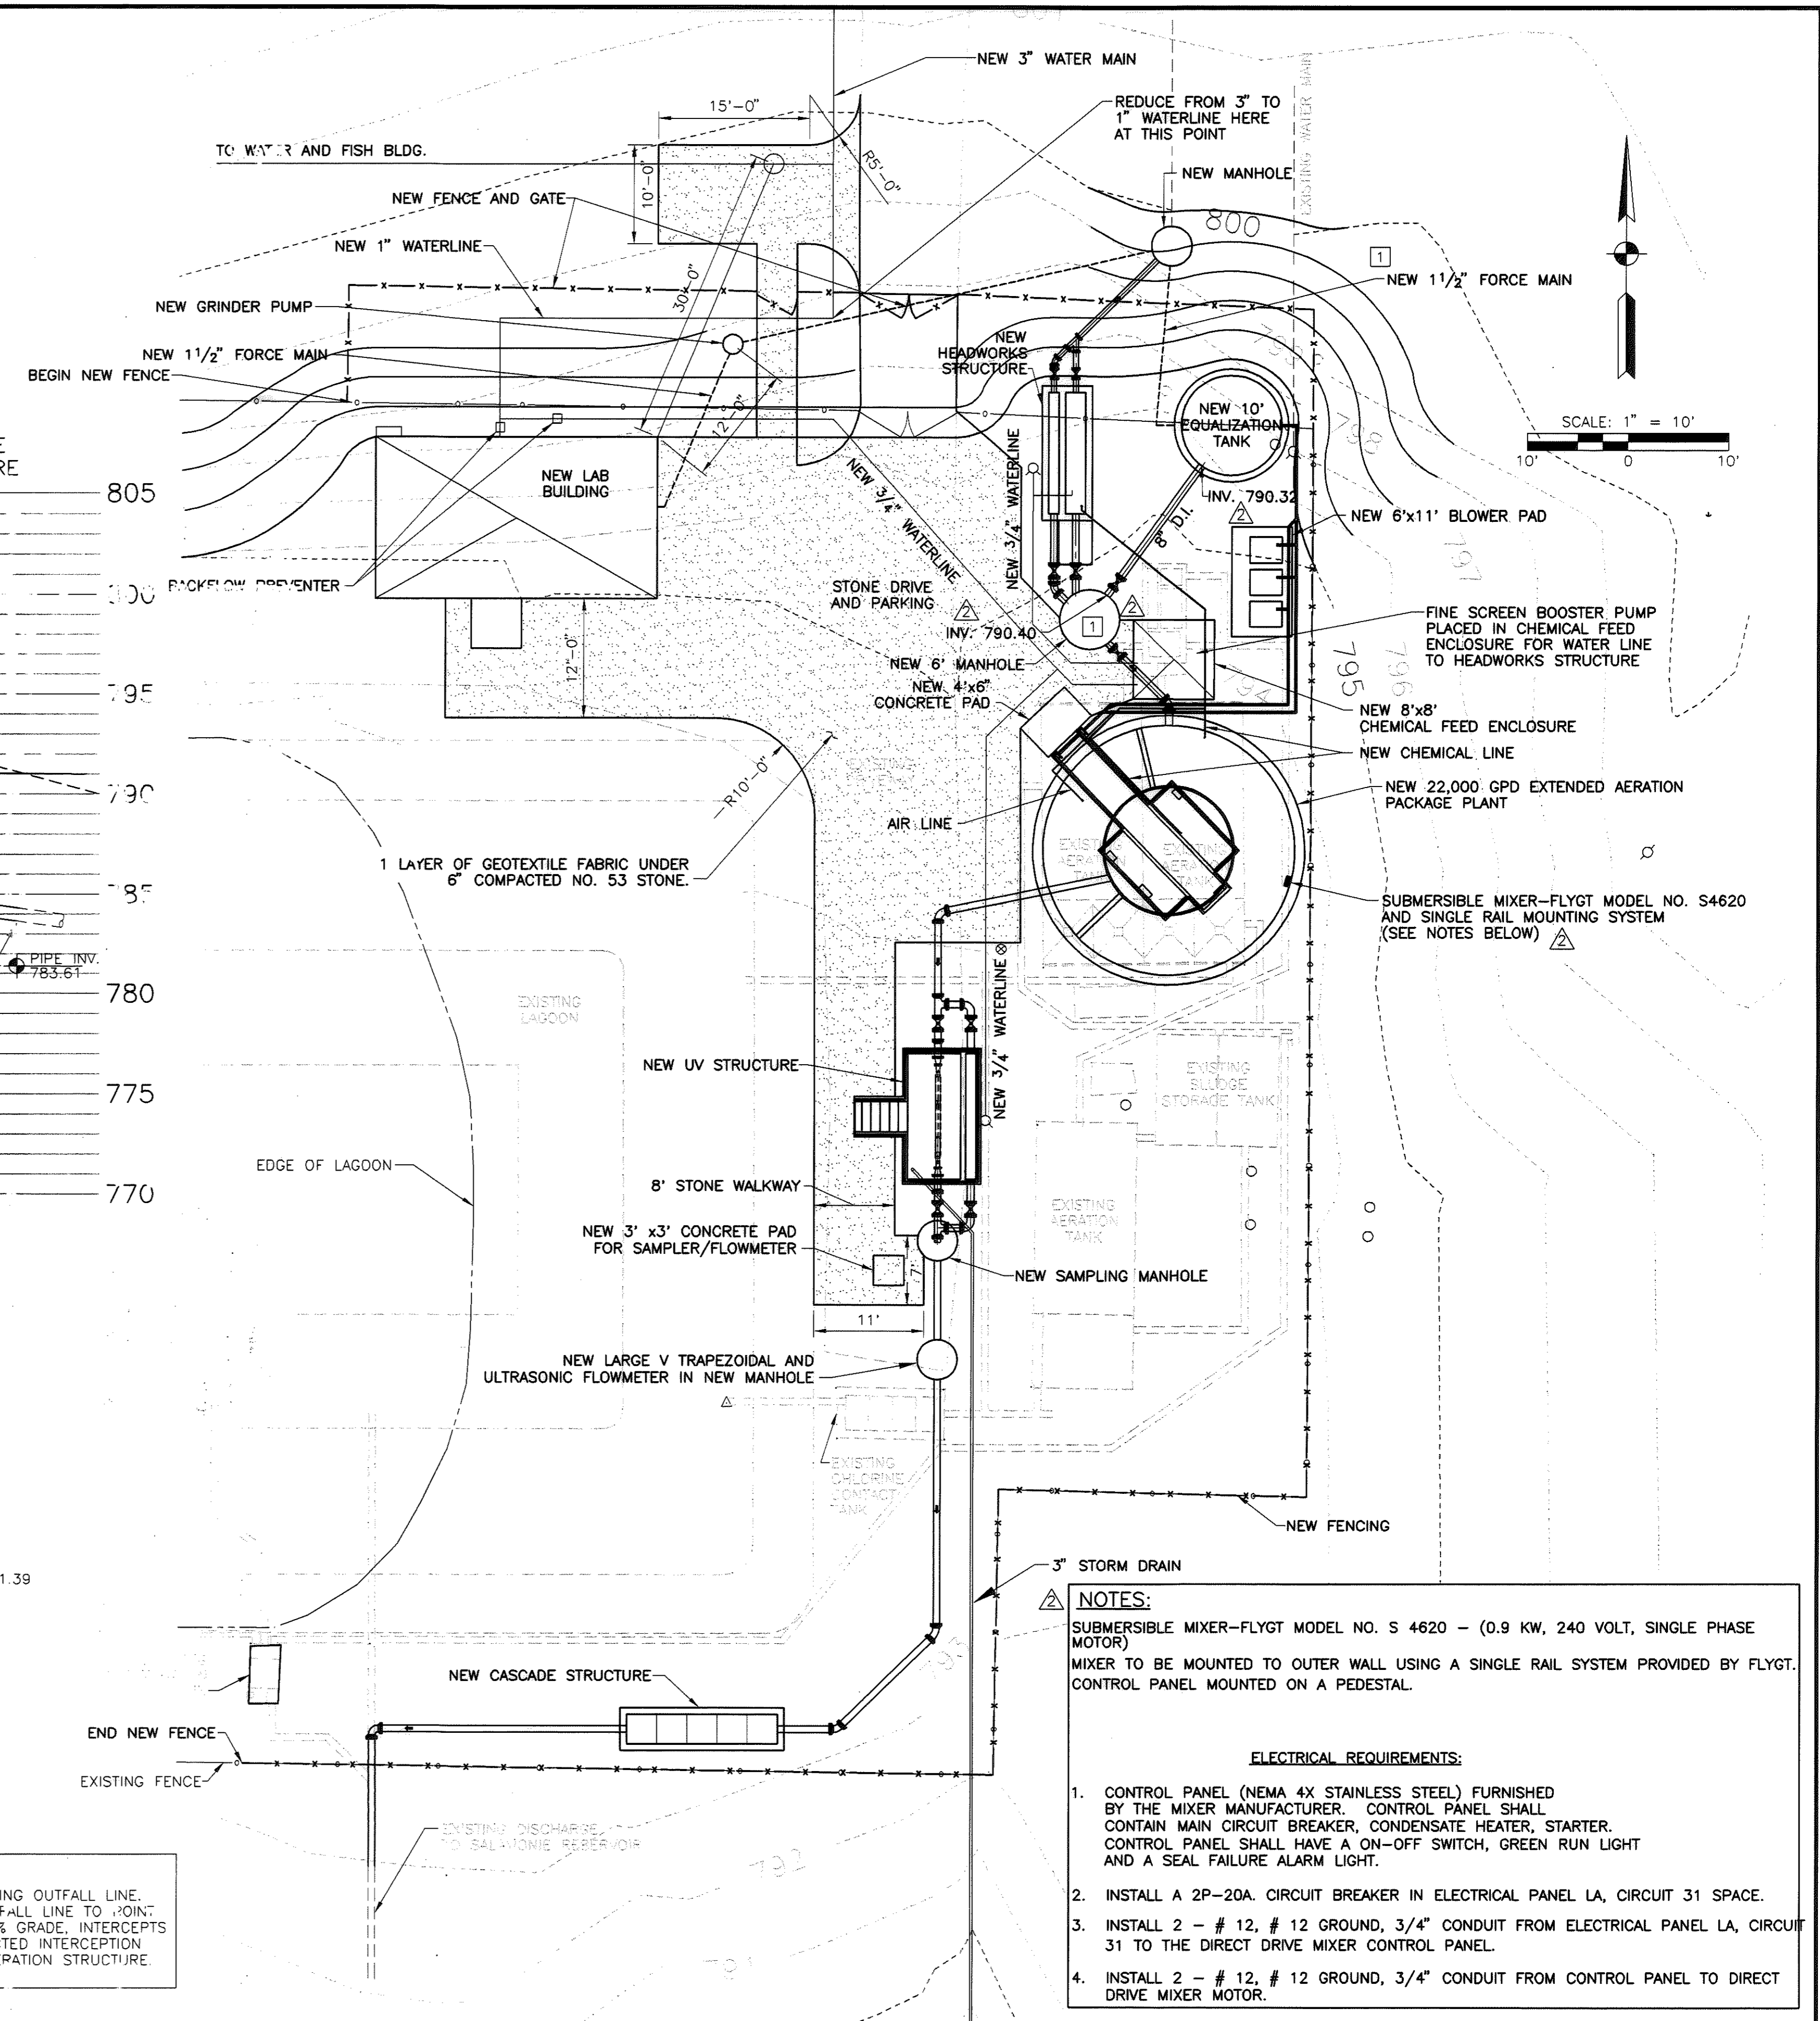


- NOTES:**
- SUBMERSIBLE MIXER-FLYGT MODEL NO. S 4620 - (0.9 KW, 240 VOLT, SINGLE PHASE MOTOR)
 - MIXER TO BE MOUNTED TO OUTER WALL USING A SINGLE RAIL SYSTEM PROVIDED BY FLYGT. CONTROL PANEL MOUNTED ON A PEDESTAL.
- ELECTRICAL REQUIREMENTS:**
- CONTROL PANEL (NEMA 4X STAINLESS STEEL) FURNISHED BY THE MIXER MANUFACTURER. CONTROL PANEL SHALL CONTAIN MAIN CIRCUIT BREAKER, CONDENSATE HEATER, STARTER. CONTROL PANEL SHALL HAVE A ON-OFF SWITCH, GREEN RUN LIGHT AND A SEAL FAILURE ALARM LIGHT.
 - INSTALL A 2P-20A CIRCUIT BREAKER IN ELECTRICAL PANEL LA, CIRCUIT 31 SPACE.
 - INSTALL 2 - # 12, # 12 GROUND, 3/4" CONDUIT FROM ELECTRICAL PANEL LA, CIRCUIT 31 TO THE DIRECT DRIVE MIXER CONTROL PANEL.
 - INSTALL 2 - # 12, # 12 GROUND, 3/4" CONDUIT FROM CONTROL PANEL TO DIRECT DRIVE MIXER MOTOR.

- ADDENDUM NO. 1 REVISED 5/18/04
- ADDENDUM NO. 2 REVISED 7/19/04
- CHANGE ORDER NO. 1 REVISED 9/1/04

REVISED "AS-BUILT" DRAWING

THIS DRAWING HAS BEEN REVISED IN ACCORDANCE WITH NOTES ON "RECORD DRAWINGS" FURNISHED BY THE CONTRACTOR AND WITH EXECUTED CHANGE ORDERS TO THE BEST OF OUR KNOWLEDGE AND BELIEF. THIS DRAWING SHOWS ACTUAL "AS-BUILT" CONDITIONS.

COMMONWEALTH ENGINEERS, INC.
 REVISED: DATE 10/06
 BY JCW, CK BY CWW

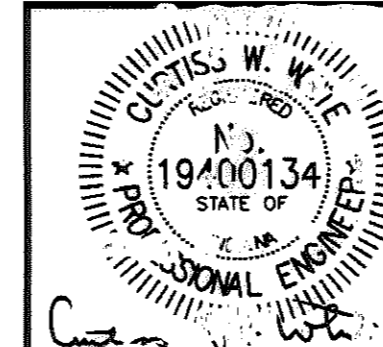


COMMONWEALTH ENGINEERS, INC.

DRAWN BY: CB
 DESIGNED BY: CWW
 CHECKED BY: CWW
 DATE: 12/03
 JOB NO: S02119-02
 SCALE: AS NOTED


SALAMONIE RESERVOIR
 WASTEWATER TREATMENT PLANT IMPROVEMENTS PROJECT
 PUBLIC WORKS PROJECT NO. E031410M
 SITE PLAN AND HYDRAULIC PROFILE

DRAWING NO.
3
 3 OF 52


NOTE:
 THESE CONTROL PANELS HAVE BEEN DESIGNED TO POWER ONLY THOSE ELECTRICAL LOADS SPECIFICALLY SHOWN OR NOTED ON EQUIPMENT MANUFACTURER ELECTRICAL DRAWINGS. CONNECTIONS TO OTHER POWER CONSUMING DEVICES WILL VOID THE WARRANTY.

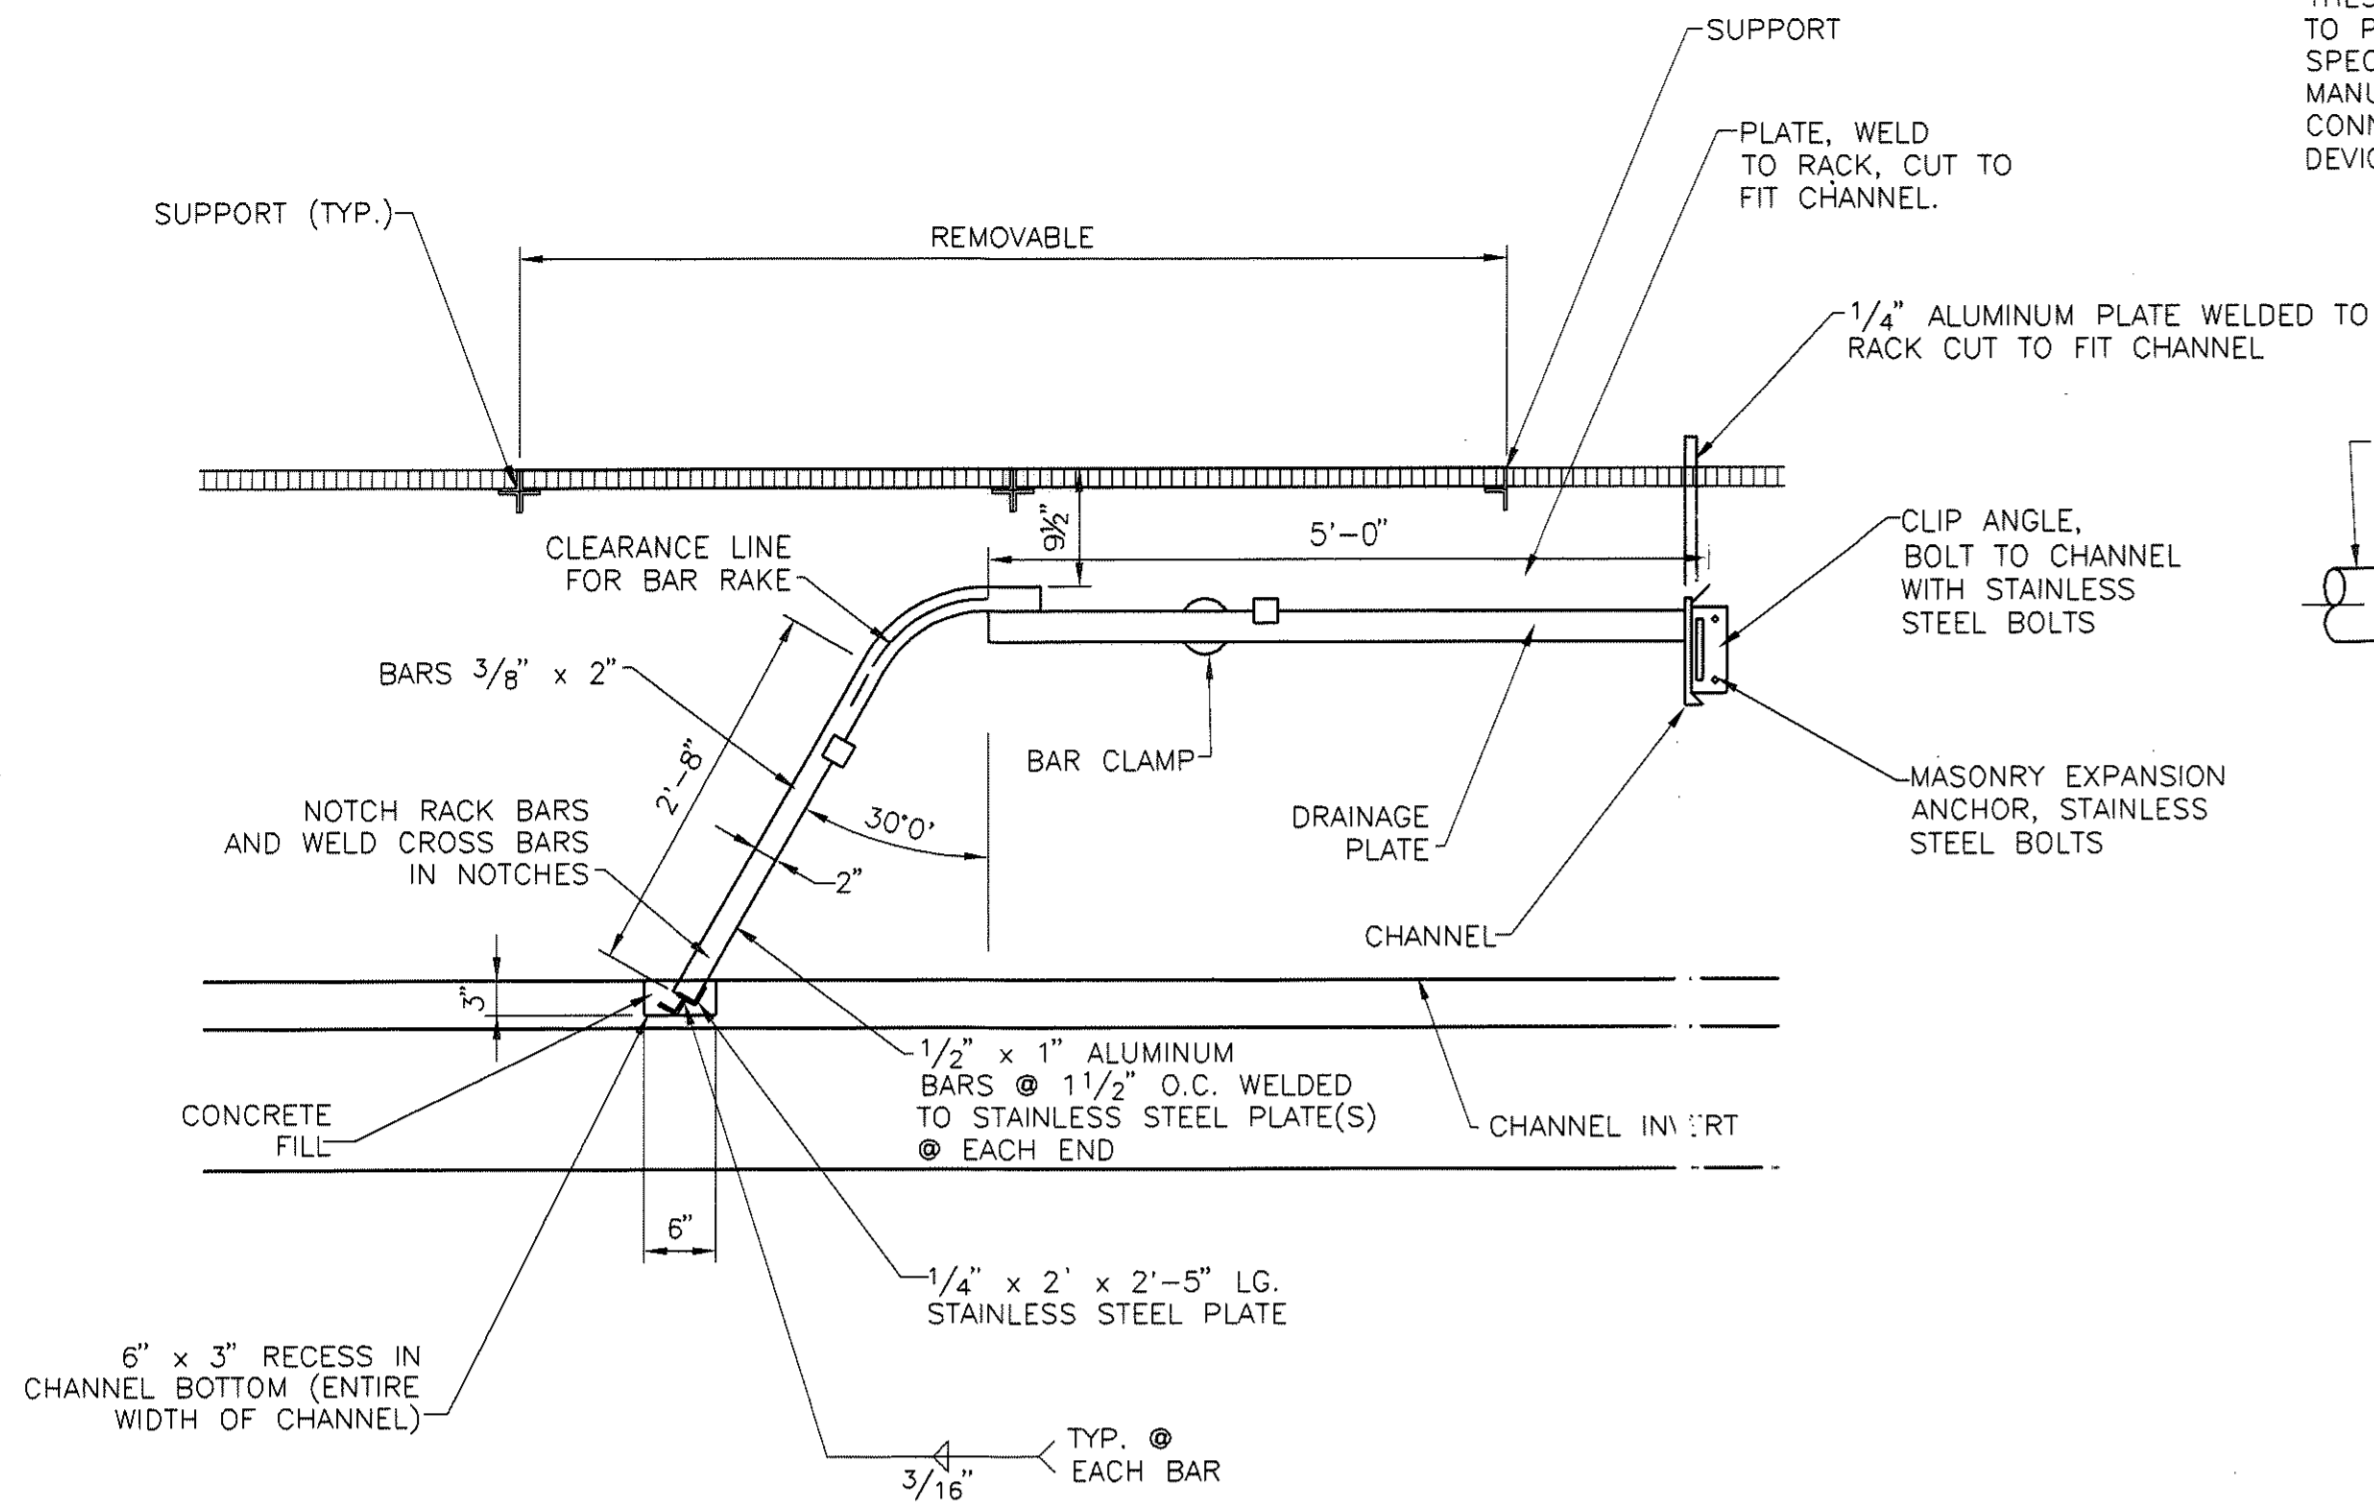


BAR RACK DETAIL
 SCALE: 3/4"=1'-0"

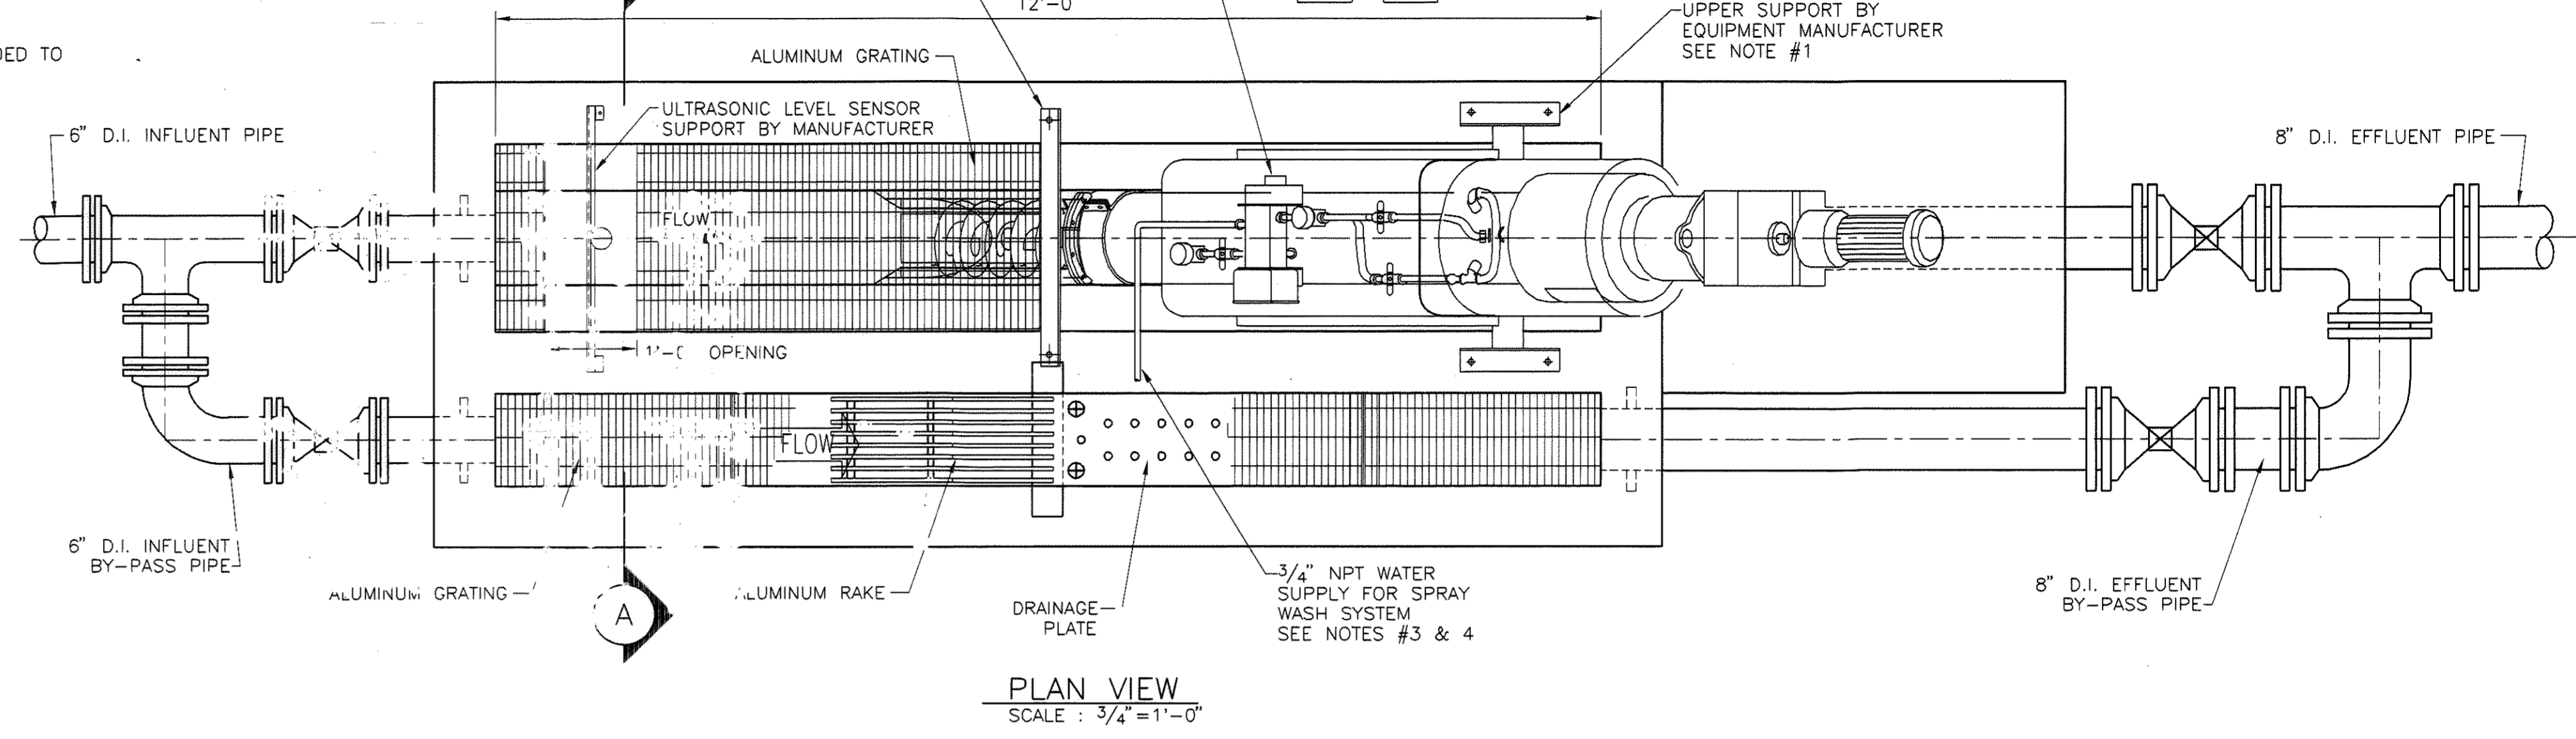

PLAN VIEW
 SCALE: 3/4"=1'-0"

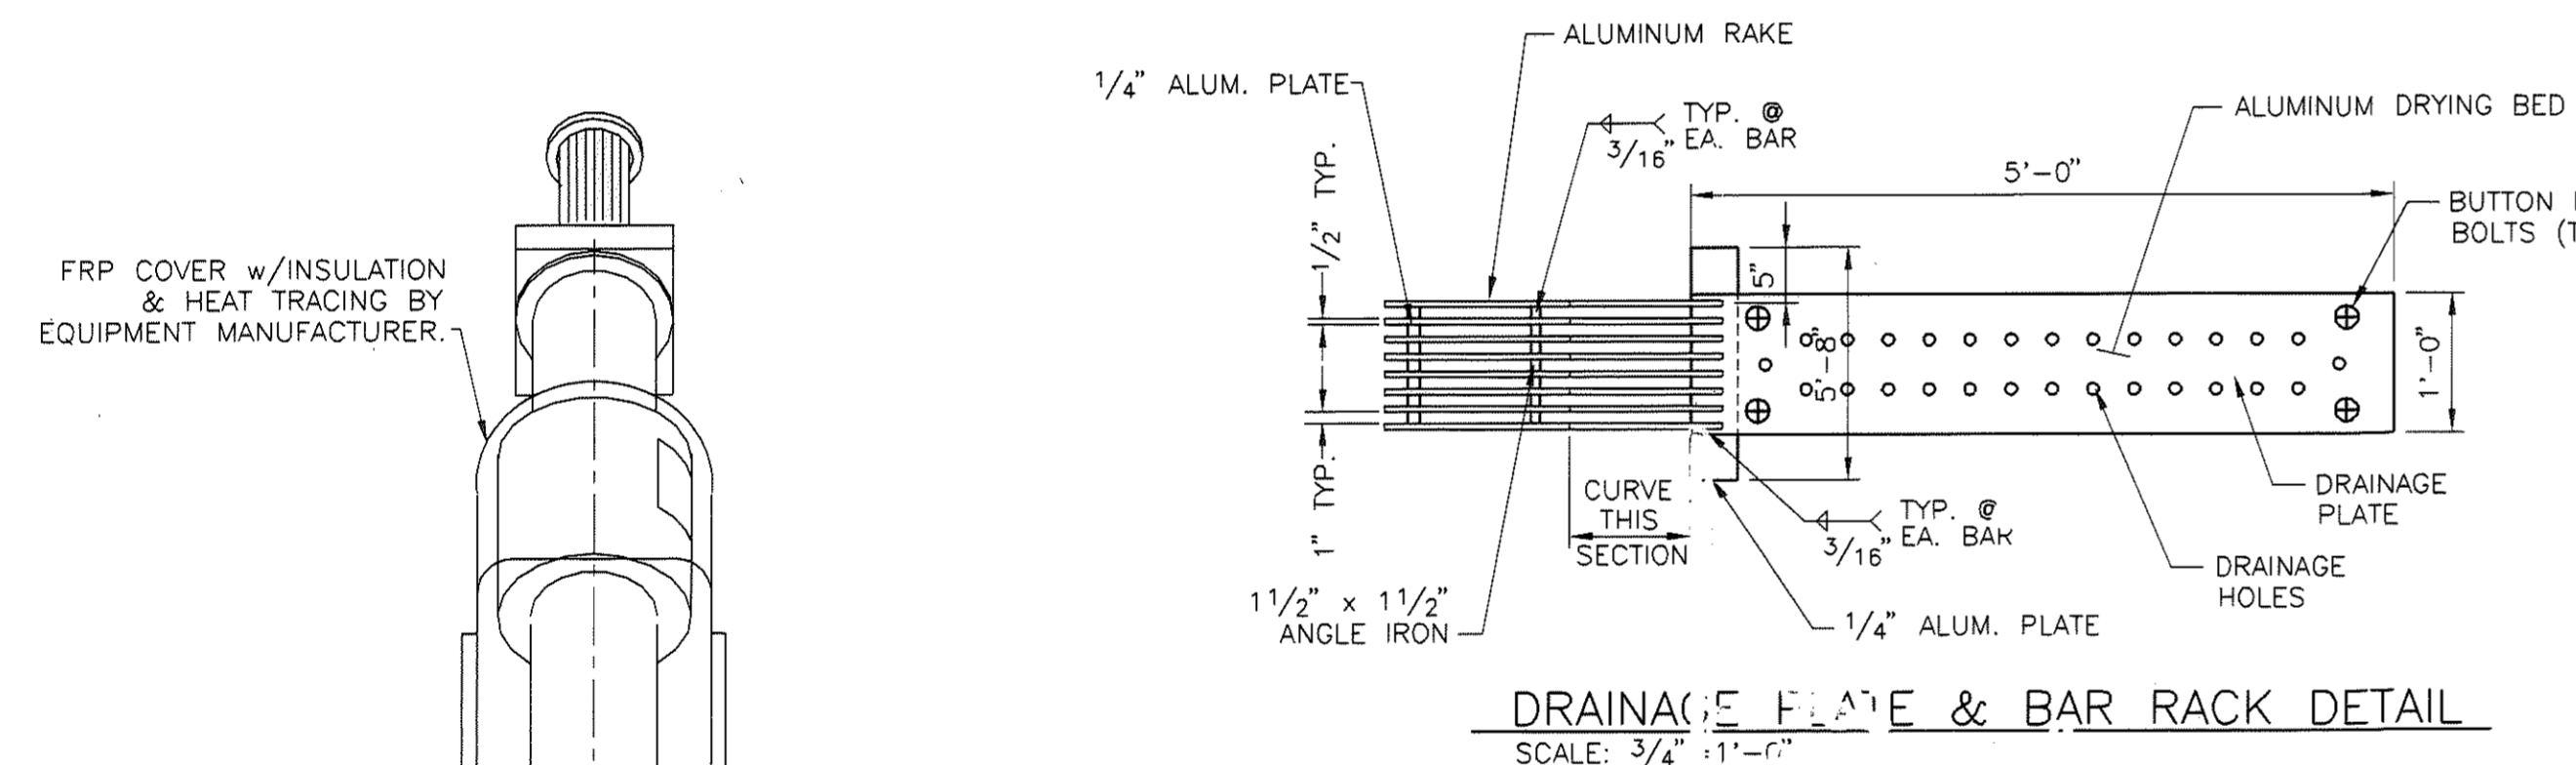


DRAINAGE PLATE & BAR RACK DETAIL
 SCALE: 3/4"=1'-0"

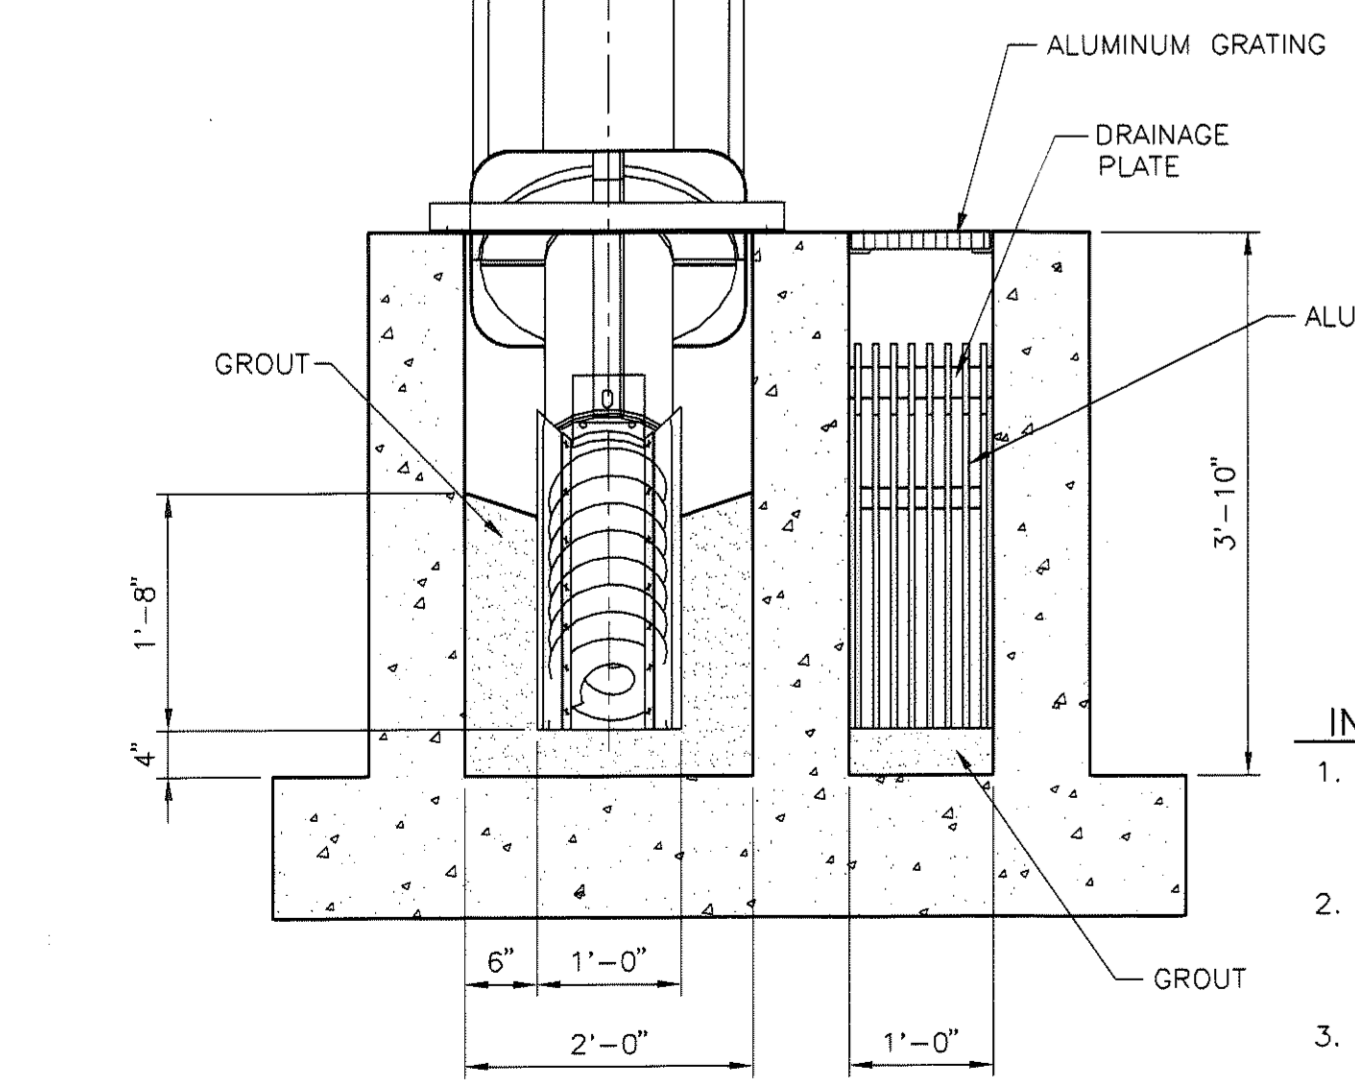


SECTION A
 SCALE: 3/4"=1'-0"

- INSTALLATION NOTES:**
1. AFTER LOWERING SCREEN INTO CHANNEL, ANCHOR UPPER SUPPORT ASSEMBLY WITH 5/8" X 7 5/8" LG. STAINLESS STEEL ADHESIVE ANCHORS PROVIDED BY EQUIPMENT MANUFACTURER.
 2. AFTER LOWERING SCREEN INTO CHANNEL, ANCHOR LOWER SUPPORT ASSEMBLY WITH 5/8" X 7 5/8" LG. STAINLESS STEEL ADHESIVE ANCHORS PROVIDED BY EQUIPMENT MANUFACTURER.
 3. WATER SUPPLY LINES AND ELECTRICAL CONNECTIONS TO BE FLEXIBLE OR QUICK DISCONNECT TYPE TO ALLOW UNIT TO PIVOT OUT OF CHANNEL.
 4. KEEP AREA UNDER SCREENS TRANSPORT SCREW FREE FROM FIXED OBSTRUCTION SUCH AS ELECTRICAL CONDUIT, PIPING ETC. TO PERMIT ROTATION OF THE SCREEN OF THE CHANNEL FOR SERVICE.

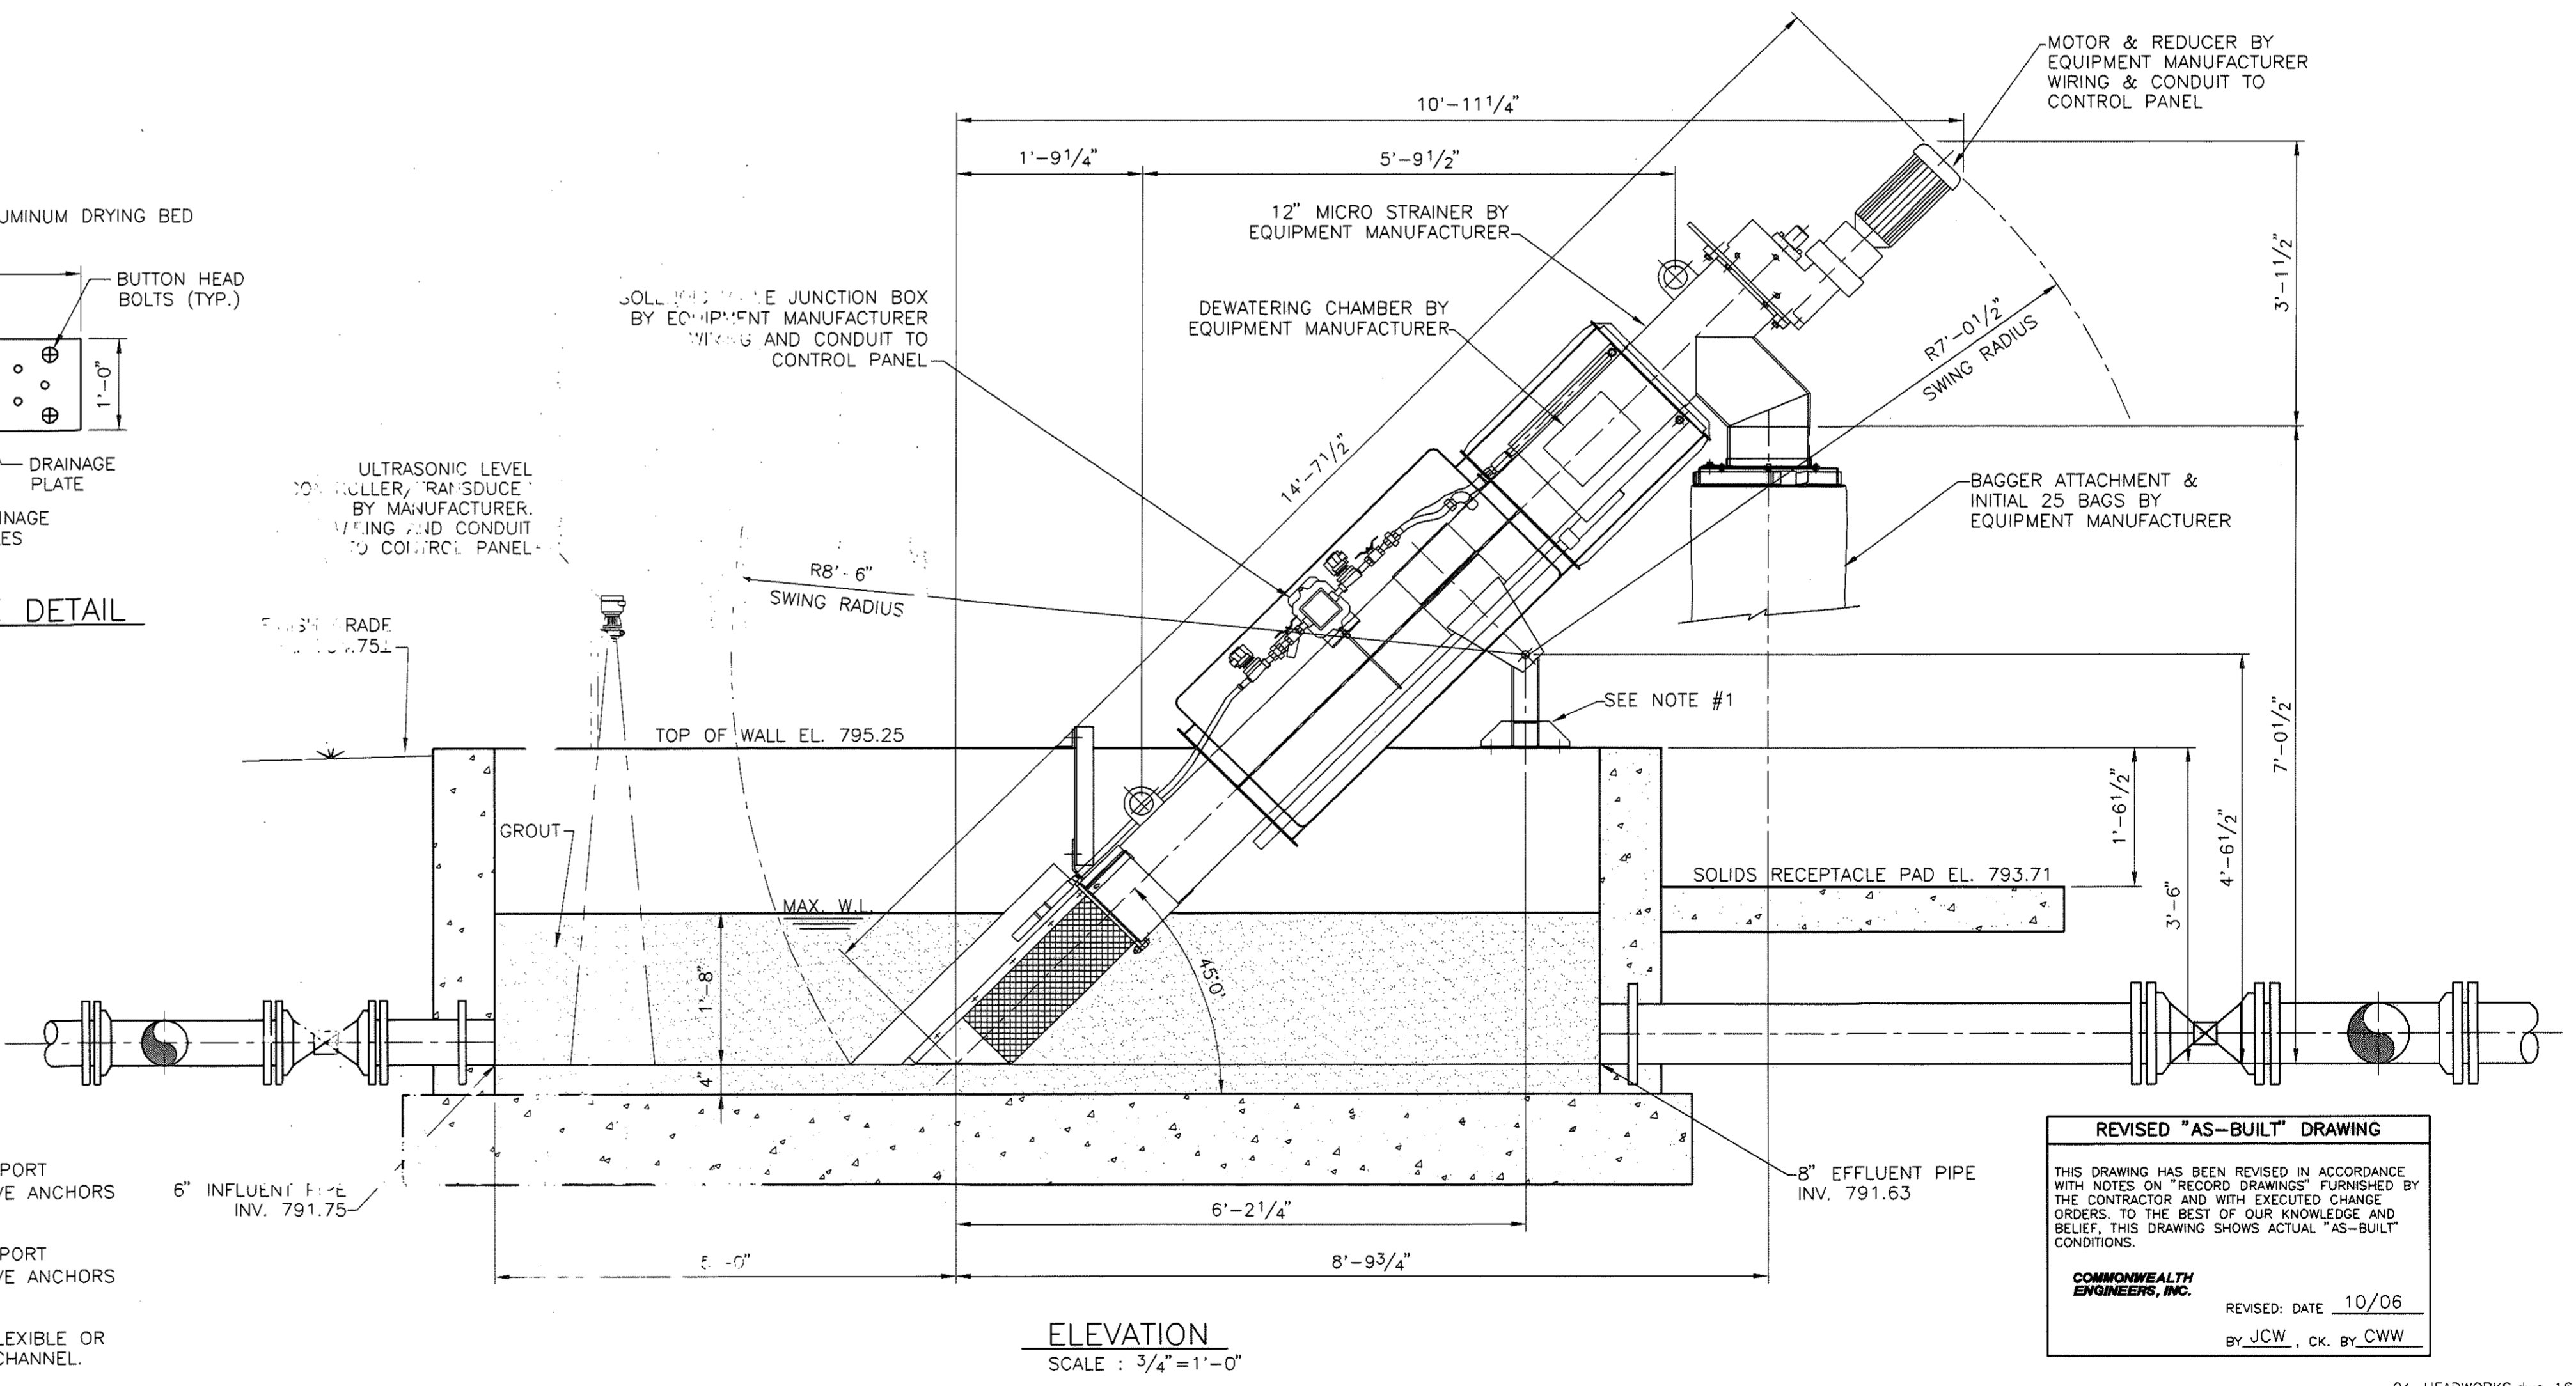

ELEVATION
 SCALE: 3/4"=1'-0"

REVISED "AS-BUILT" DRAWING
 THIS DRAWING HAS BEEN REVISED IN ACCORDANCE WITH NOTES ON "RECORD DRAWINGS" FURNISHED BY THE CONTRACTOR AND WITH EXECUTED CHANGE ORDERS. TO THE BEST OF OUR KNOWLEDGE AND BELIEF, THIS DRAWING SHOWS ACTUAL "AS-BUILT" CONDITIONS.
 COMMONWEALTH ENGINEERS, INC.
 REVISED DATE: 10/06
 BY: JCW, CK. BY: CWW

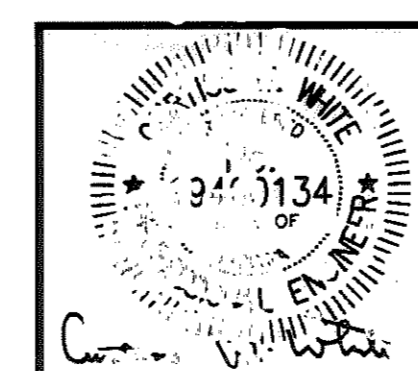

COMMONWEALTH ENGINEERS, INC.

DRAWN BY: CB	SALAMONIE RESERVOIR WASTEWATER TREATMENT PLANT IMPROVEMENTS PROJECT	DRAWING NO.
DESIGNED BY: CWW		4
CHECKED BY: CWW	PUBLIC WORKS PROJECT NO. E031410M	4 OF 52
DATE: 12/03		
JOB NO: S02119-02		
SCALE: AS NOTED		

MEMBRANE DISC AERATION SYSTEM MATERIAL AND MANUFACTURING SPECIFICATIONS (304L PVC)				CERAMIC DISC AERATION SYSTEM MATERIAL AND MANUFACTURING SPECIFICATIONS (304L PVC)			
ITEM	MATERIAL SPECIFICATION	MANUFACTURING SPECIFICATION	NOTES	ITEM	MATERIAL SPECIFICATION	MANUFACTURING SPECIFICATION	NOTES
DROPLEG	304L STAINLESS STEEL ASTM A240	FITTINGS: TUBULAR PRODUCTS: DIMENSIONS: ASTM A774 ASTM A778 ASTM A554	150# DRILLING FOR TERMINATION FLANGE CONNECTION. 12 GAUGE PIPE (0.109") WALL THICKNESS ON DROPLEG. *SEE BELOW	DROPLEG	304L STAINLESS STEEL ASTM A240	FITTINGS: TUBULAR PRODUCTS: DIMENSIONS: ASTM A774 ASTM A778 ASTM A554	150# DRILLING FOR TERMINATION FLANGE CONNECTION. 12 GAUGE PIPE (0.109") WALL THICKNESS ON DROPLEG. *SEE BELOW
SUPPORTS	304L STAINLESS STEEL SHEETS AND PLATES PER ASTM A240 THREADED RODS PER ASTM A276		"L" GRADE NOT REQUIRED FOR NON-WELDED PARTS	SUPPORTS	304L STAINLESS STEEL SHEETS AND PLATES PER ASTM A240 THREADED RODS PER ASTM A276		"L" GRADE NOT REQUIRED FOR NON-WELDED PARTS
BOLTS, NUTS, WASHERS	18-8 STAINLESS STL			BOLTS, NUTS, WASHERS	18-8 STAINLESS STL		
FIXED JOINT O-RING	NATURAL RUBBER/SBR		45 ± 5 DUROMETER SHORE A COMPRESSION SET 5% MAX	FIXED JOINT O-RING	NATURAL RUBBER/SBR		45 ± 5 DUROMETER SHORE A COMPRESSION SET 5% MAX
EXPANSION JOINT O-RING	NATURAL RUBBER/SBR		40 ± 5 DUROMETER SHORE A 0.45 COEFFICIENT OF FRICTION MAX.	EXPANSION JOINT O-RING	NATURAL RUBBER/SBR		40 ± 5 DUROMETER SHORE A 0.45 COEFFICIENT OF FRICTION MAX.
LOWER DROPLEG	PVC, ASTM D1784 COMPOUND 12454-B	PIPE: FITTINGS: ASTM D1785 ASTM D2466		LOWER DROPLEG	PVC, ASTM D1784 COMPOUND 12454-B	PIPE: FITTINGS: ASTM D1785 ASTM D2466	
AIR DISTRIBUTORS AND MANIFOLD	PVC, ASTM D3915 COMPOUND 124524	PIPE: FITTINGS: ASTM D3034 ASTM D3034	MINIMUM 2% TITANIUM DIOXIDE	AIR DISTRIBUTORS AND MANIFOLD	PVC, ASTM D3915 COMPOUND 124524	PIPE: FITTINGS: ASTM D3034 ASTM D3034	MINIMUM 2% TITANIUM DIOXIDE
DIFFUSER HOLDER SUBPLATE, RETAINING RING	PVC, ASTM D3915 COMPOUND 124524		MINIMUM 2% TITANIUM DIOXIDE	DIFFUSER HOLDER, RETAINING RING	PVC, ASTM D3915 COMPOUND 124524		MINIMUM 2% TITANIUM DIOXIDE
DIFFUSER ELEMENT	EPDM			DIFFUSER ELEMENT	FUSED ALUMINA		
PVC SOLVENT WELDING	ASTM D2564	ASTM D2855		PVC SOLVENT WELDING	ASTM D2564	ASTM D2855	

*STAINLESS STEEL DROPLEG FABRICATION
FACTORY WELD ONLY WITH MIG, TIG, OR PLASMA-ARC WELDING INERT GAS PROCESSES, FULL PENETRATION BUTT WELDS, ER 316L FILLER WIRE. AFTER FABRICATION FINISH CLEAN ALL WELDED STAINLESS STEEL ASSEMBLIES BY FULL IMMERSION CLEANING TECHNIQUES IN ACCORDANCE TO 6.2.11 OF ASTM A380-88. THE ACID FOR USE DEFINED BY TABLE A2.1 OF ANNEX A2 OF ASTM A380. FINAL RINSE AND DRY IN ACCORDANCE TO SECTION 8.3 OF ASTM A380. ALL WELDED SURFACES TO CONFORM TO AISI NO. 2D FINISH.

*STAINLESS STEEL DROPLEG FABRICATION
FACTORY WELD ONLY WITH MIG, TIG, OR PLASMA-ARC WELDING INERT GAS PROCESSES, FULL PENETRATION BUTT WELDS, ER 316L FILLER WIRE. AFTER FABRICATION FINISH CLEAN ALL WELDED STAINLESS STEEL ASSEMBLIES BY FULL IMMERSION CLEANING TECHNIQUES IN ACCORDANCE TO 6.2.11 OF ASTM A380-88. THE ACID FOR USE DEFINED BY TABLE A2.1 OF ANNEX A2 OF ASTM A380. FINAL RINSE AND DRY IN ACCORDANCE TO SECTION 8.3 OF ASTM A380. ALL WELDED SURFACES TO CONFORM TO AISI NO. 2D FINISH.

RAILINGS- 1 1/2" SCH 40 ALUMINUM
MAIN BRIDGE- 6 X 4 X 1/4 RECTANGULAR TUBE A36 STEEL
AIRLIFT EDUCTOR PIPE- 304 STN STL
AIRLIFT AIR SUPPLY- 304 STN STL
STILLING WELL SCUM TROUGH- 3/16" THICK STEEL PLATE A36
STRUCTURAL SHAPES- A36 STEEL
EFFLUENT LAUNDER- 3/16" THICK STEEL PLATE A36
EFFLUENT LAUNDER WEIR PLATES- 18 GA STN STL W/STN STL BOLTS
WALKWAY GRATING- 1 1/2 X 3/16 I-BAR ALUMINUM

SLUDGE COLLECTOR DRIVE ASSEMBLY
REV /HOUR 7.7 OVER LOAD PROTECTION MICROSWITCH
DRIVE- DBS SX-AE DBS MANUFACTURING
*RUNNING TORQUE ALARM SETTING FT LBS- 3,000 KICK OUT FT LBS- 3,600
MOTOR-MODEL BALDOR (MILL AND CHEMICAL DUTY) 1/2 HP 1750 RPM
*AGMA RATED TORQUE FOR 1 MILLION CYCLE LIFE 3/60/240 POWER
TORQUE TUBE- 4" SCH 40 PIPE

COLLECTOR ARMS
2 SWEEP ARMS-DOUBLE ANGLES- 3" X 3" X 1/4"
6 FLOW BLADES 3 1/2" X 3 1/2" X 1/4" ANGLES W/ 1/4" NEOPRENE SOUEEGEES

CORROSION PROTECTION
SURFACE PREPARATION- SSPC-SP-10 (SUBMERGED) SSPC-SP-6 (NON SUBMERGED)
PRIMER- TNEC 66-1211, 3-5 MILS DFT



REVISED "AS-BUILT" DRAWING
THIS DRAWING HAS BEEN REVISED IN ACCORDANCE WITH NOTES ON "RECORD DRAWINGS" FURNISHED BY THE CONTRACTOR AND WITH EXECUTED CHANGE ORDERS TO THE BEST OF OUR KNOWLEDGE AND BELIEF. THIS DRAWING SHOWS ACTUAL "AS-BUILT" CONDITIONS.
COMMONWEALTH ENGINEERS, INC.
REVISED: DATE 10/06
BY JCW, CK BY CWW

AERATION TANK


GRID INFORMATION

- 2 - GRIDS
- 3 - AIR DISTRIBUTORS PER GRID
- 12 - DIFFUSERS PER GRID
- 24 - TOTAL DIFFUSERS INSTALLED
- SEE DWG. 8 FOR GRID LAYOUT

NOTE:
DIFFUSER LAYOUT AS PER MANUFACTURERS REQUIREMENTS

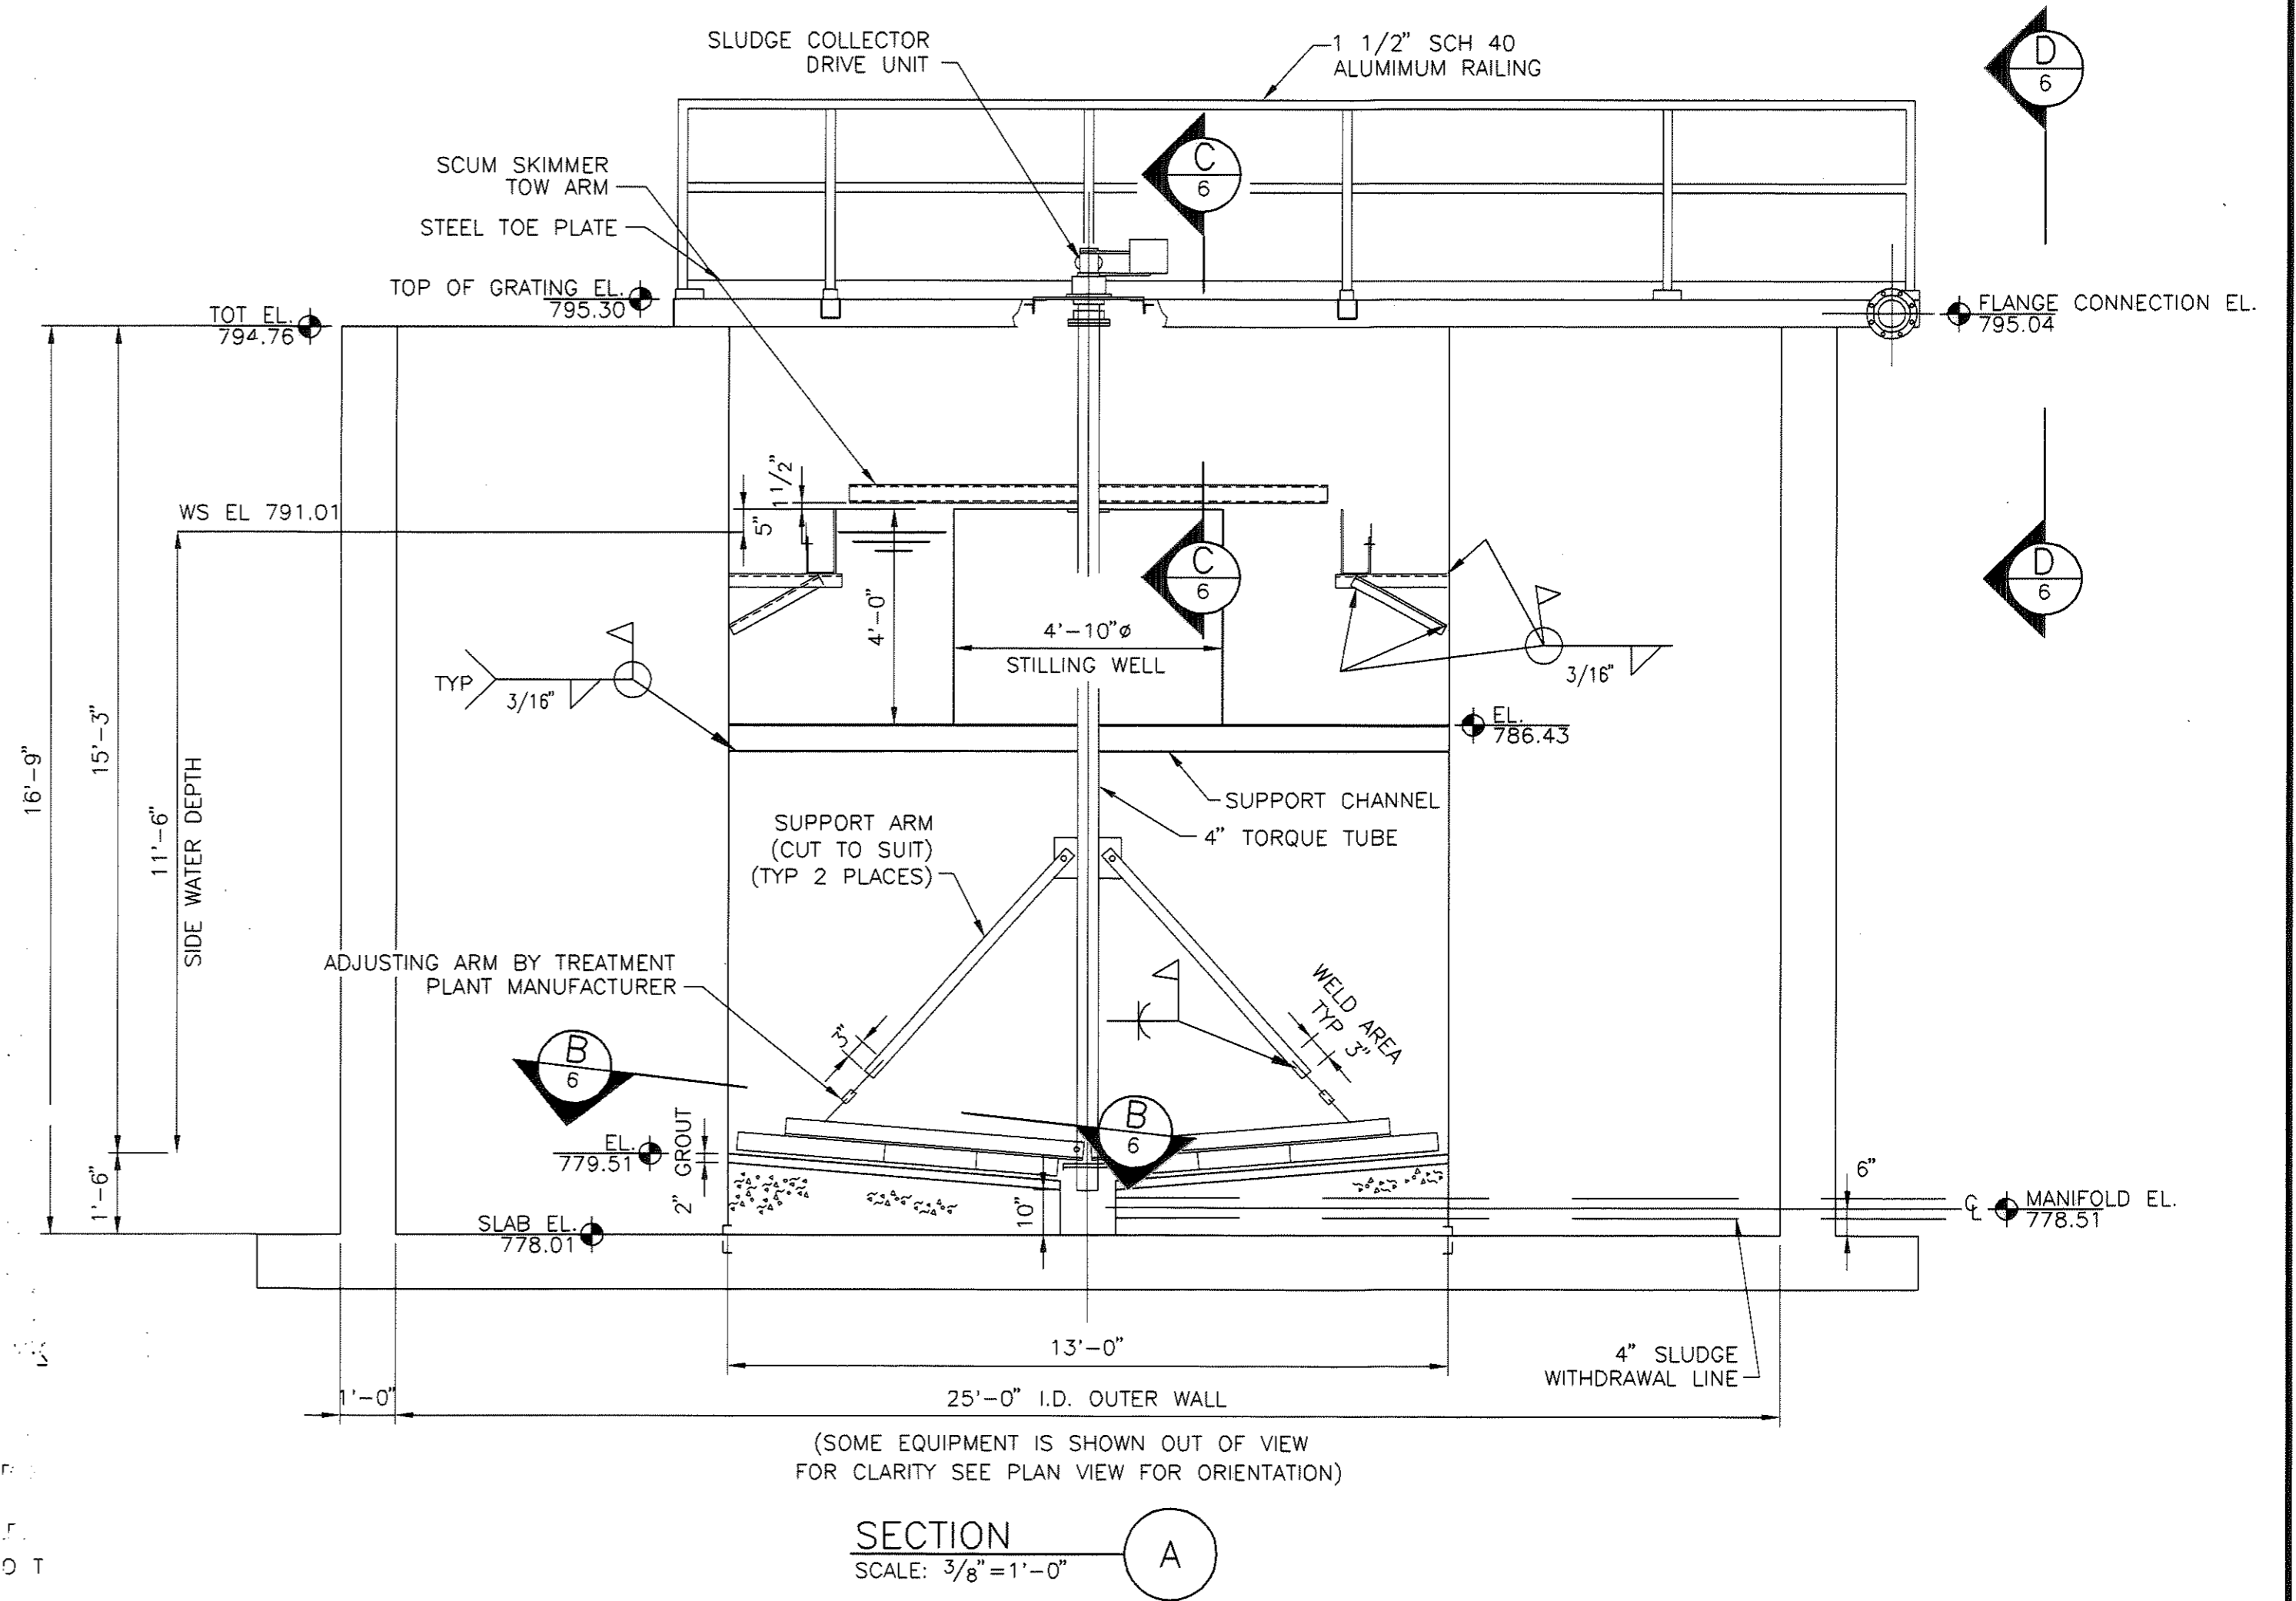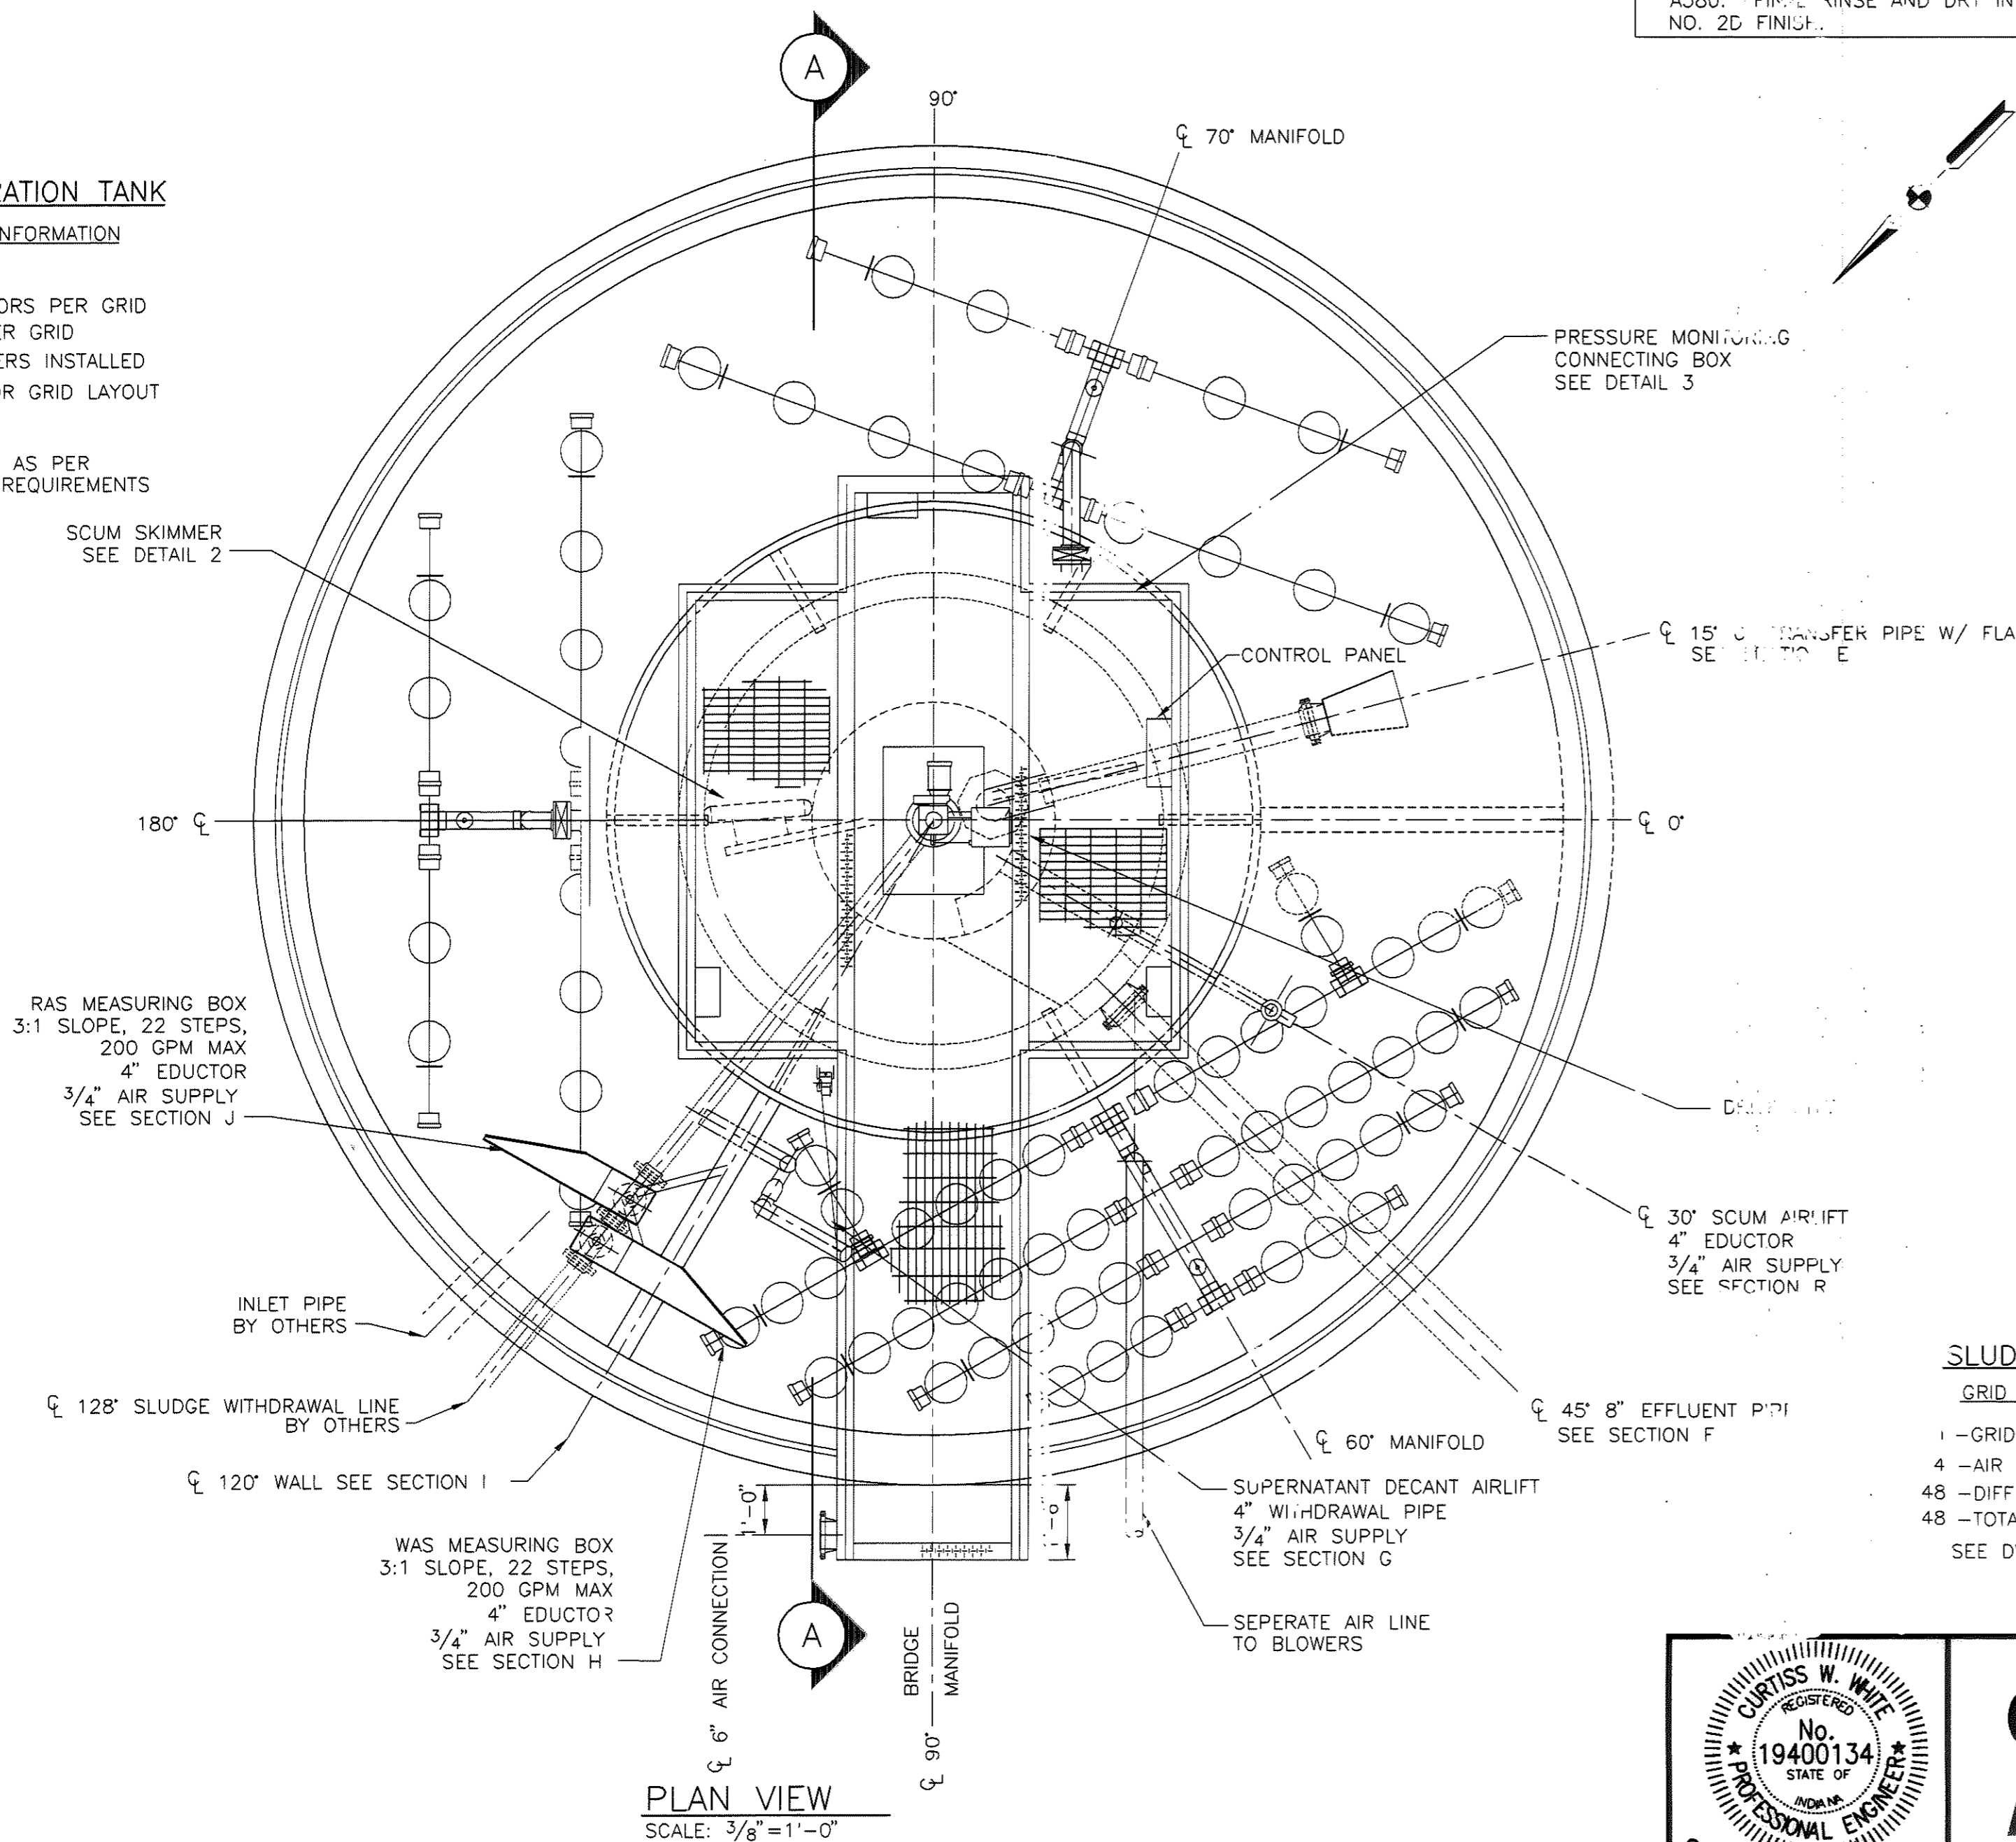


SLUDGE HOLDING TANK
GRID INFORMATION
1 - GRID
4 - AIR DISTRIBUTORS PER GRID
48 - DIFFUSERS PER GRID
48 - TOTAL DIFFUSERS INSTALLED
SEE DWG. 8 FOR GRID LAYOUT

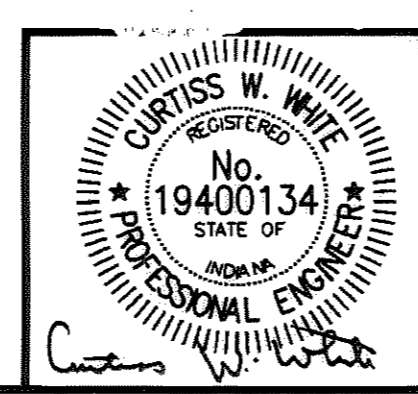


COMMONWEALTH ENGINEERS, INC.


DRAWN BY: CB	SALAMONIE RESERVOIR	DRAWING NO.
DESIGNED BY: CWW	WASTEWATER TREATMENT PLANT IMPROVEMENTS PROJECT	5
CHECKED BY: CWW	PUBLIC WORKS PROJECT NO. E031410M	
DATE: 12/03	TREATMENT PLANT PLAN AND SECTIONS	5 OF 52
JOB NO: S02119-02		
SCALE: AS NOTED		

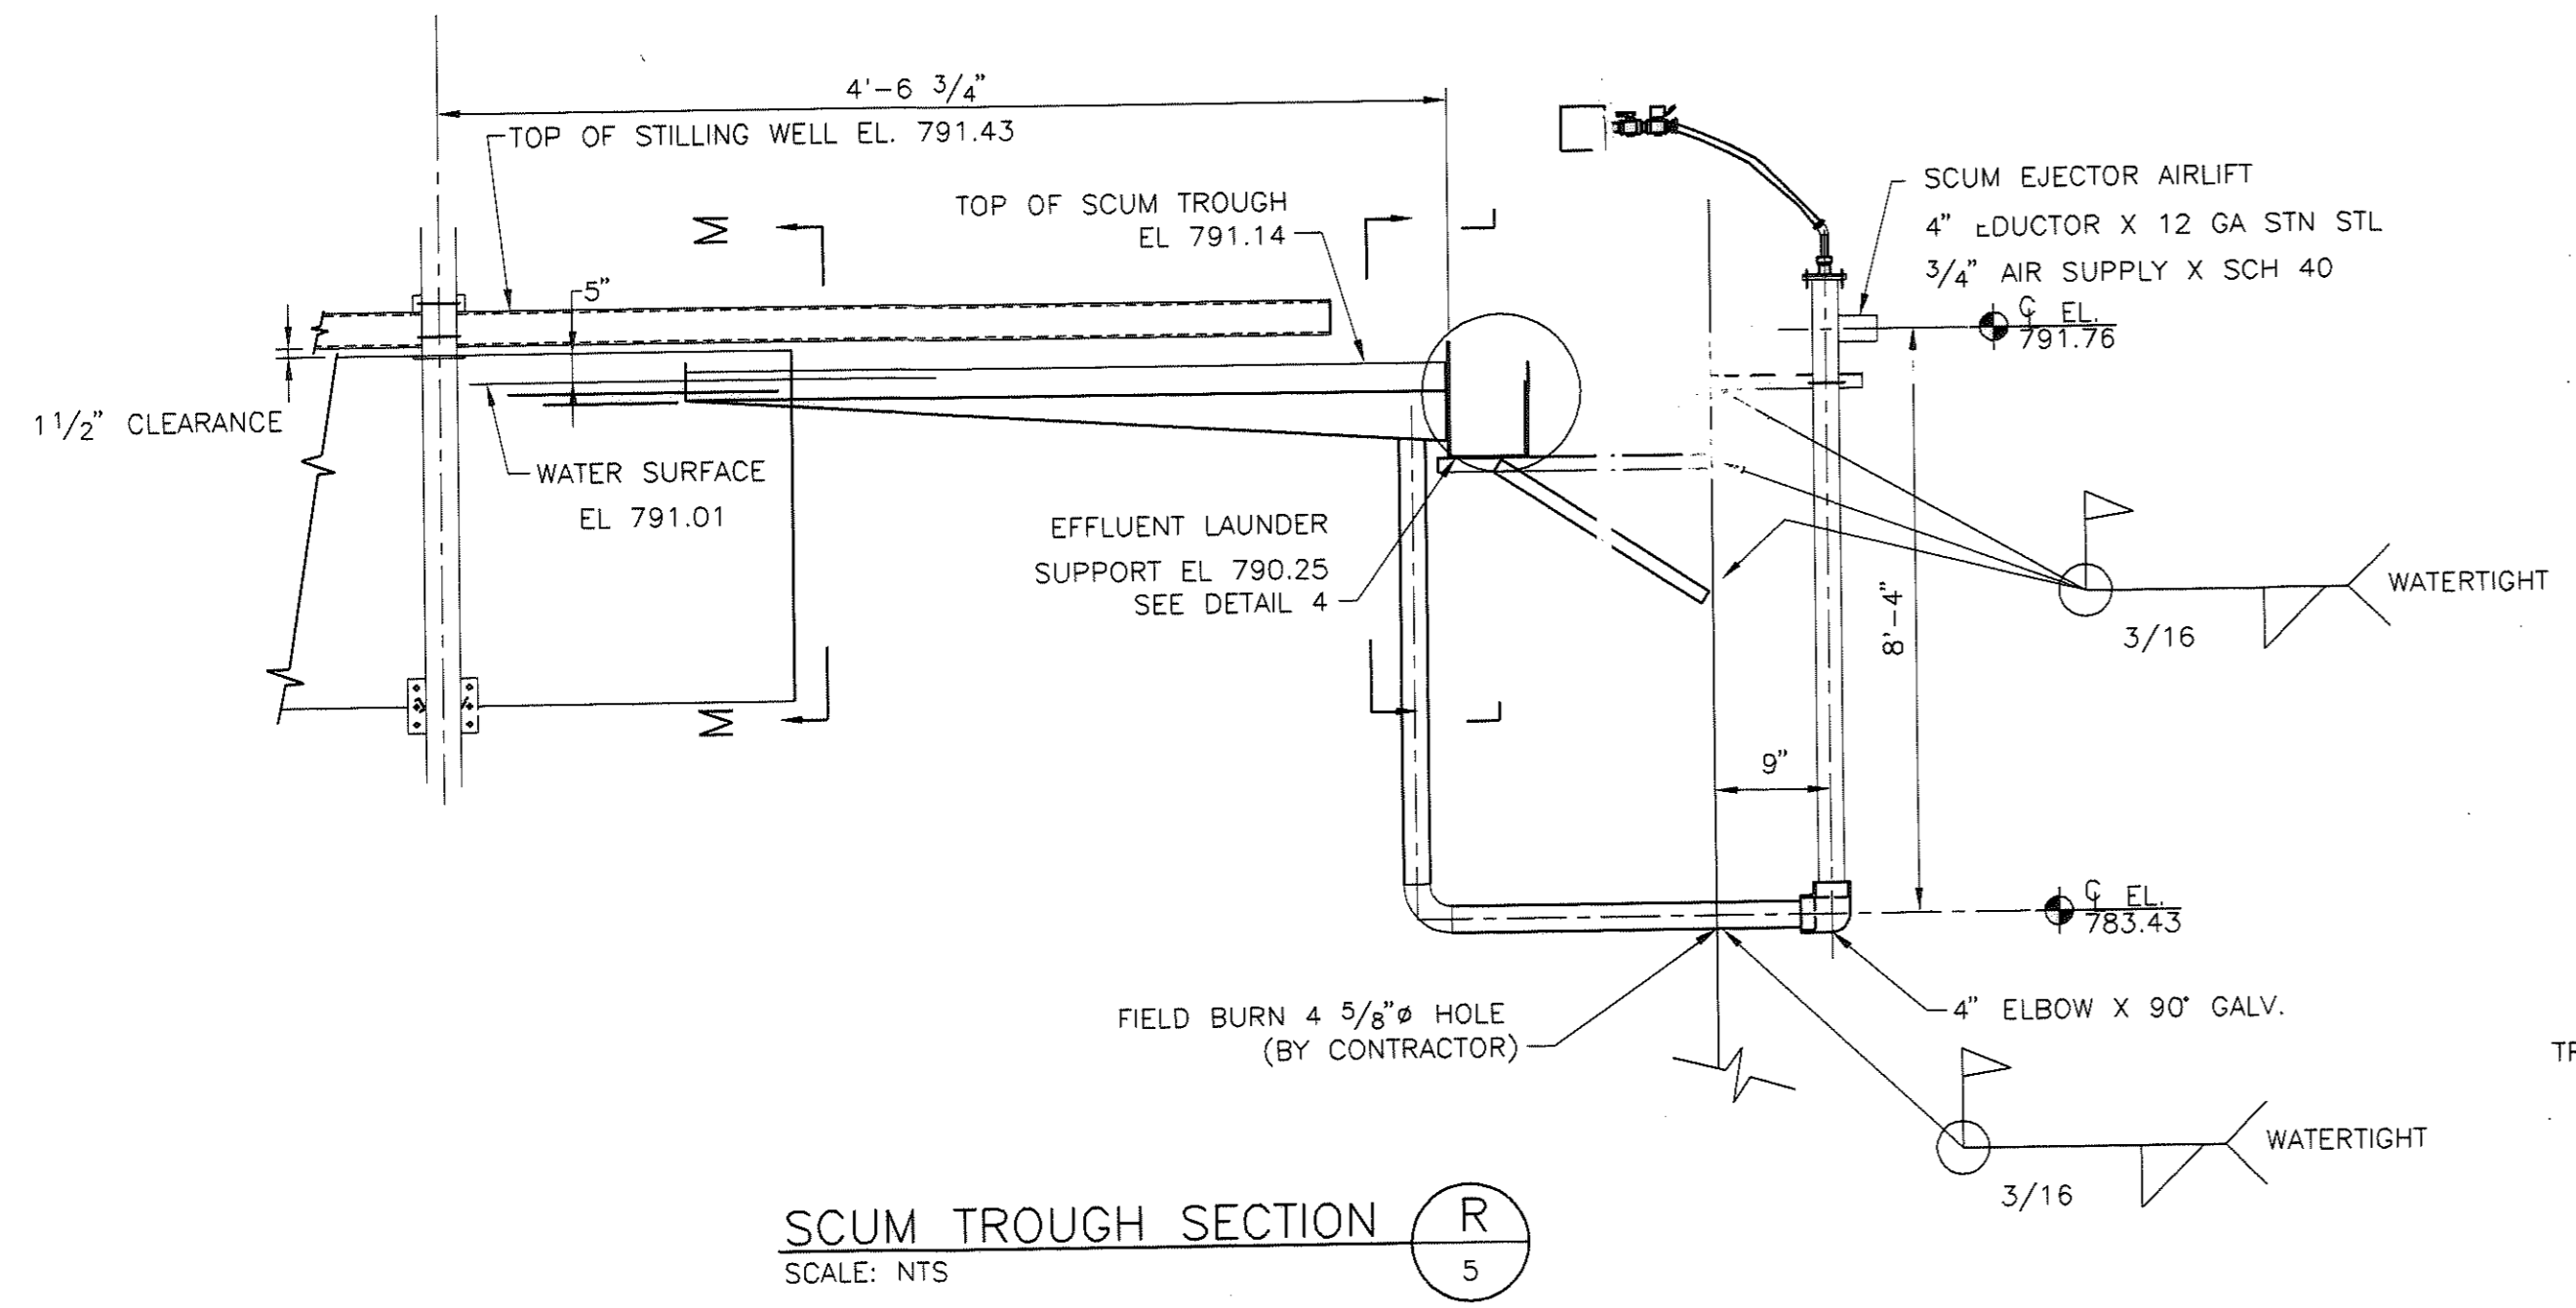


SCUM TROUGH SECTION R-5
SCALE: NTS

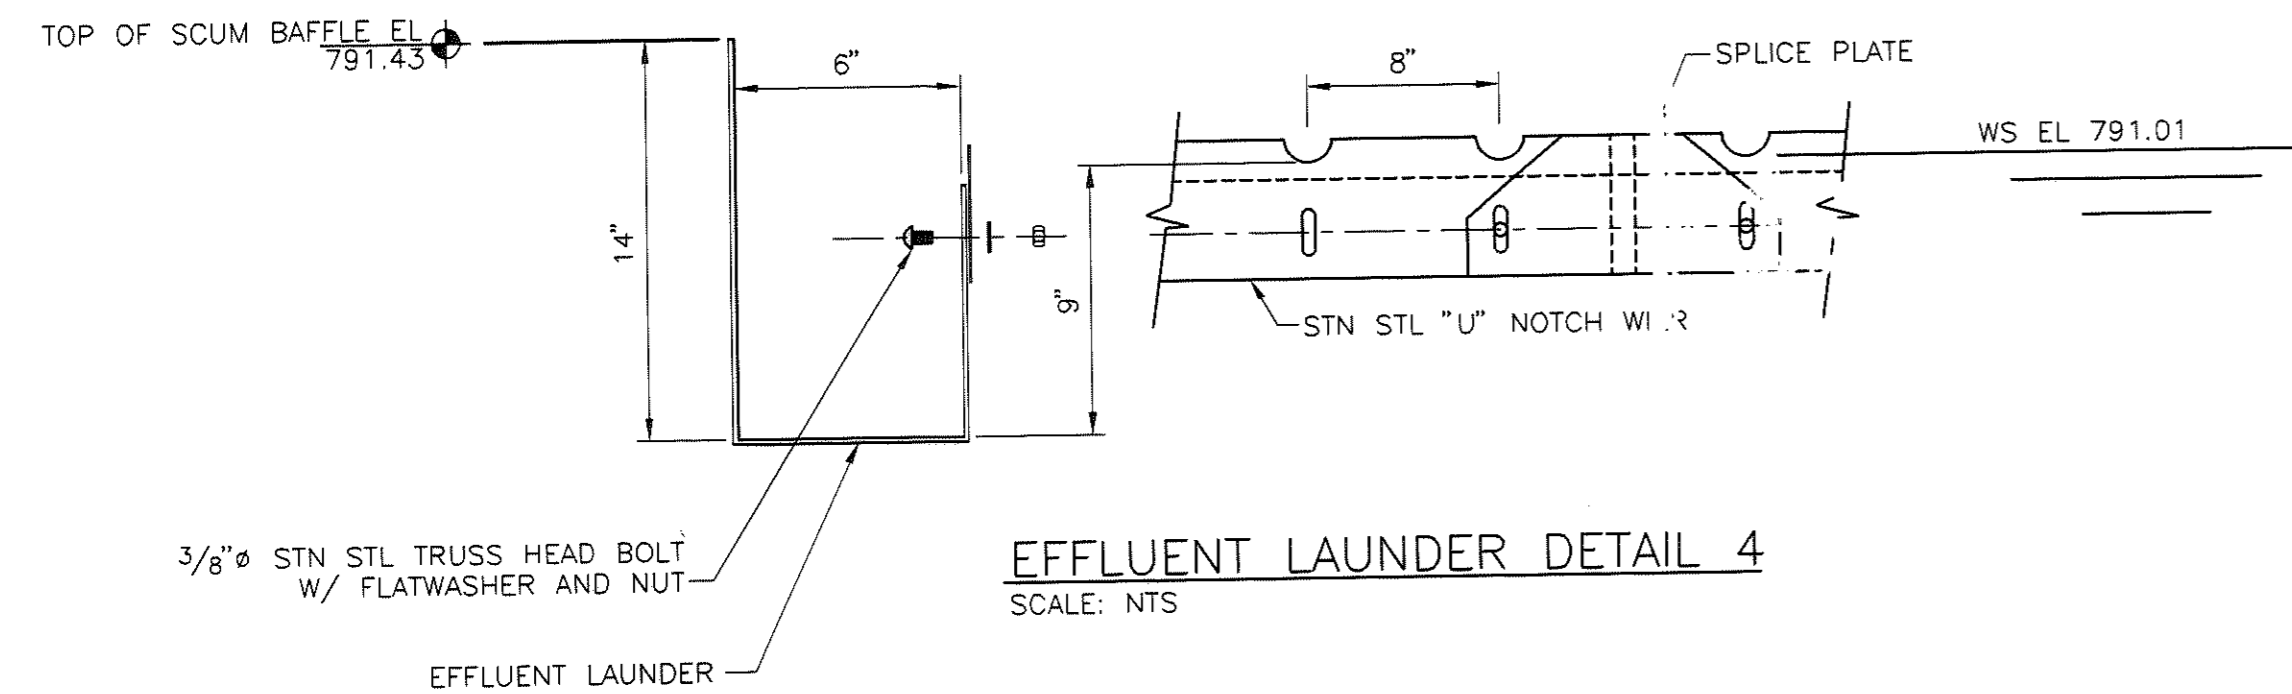


EFFLUENT LAUNDER DETAIL 4
SCALE: NTS

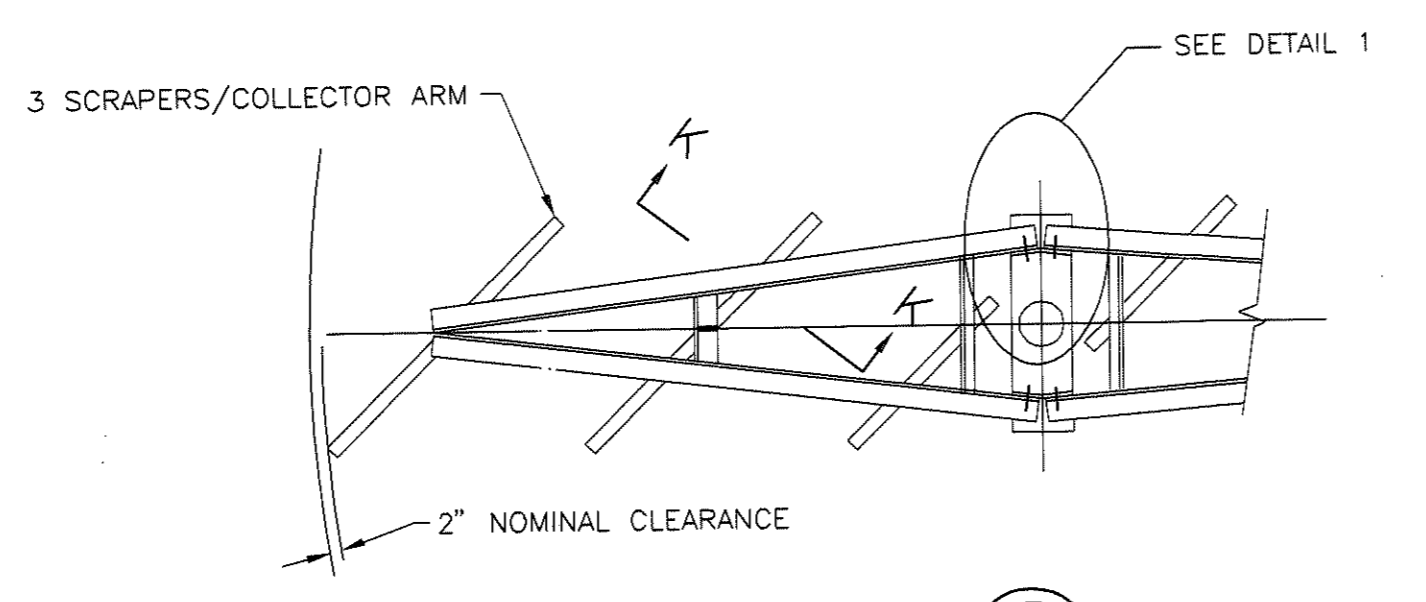


SECTION B-5
SCALE: NTS

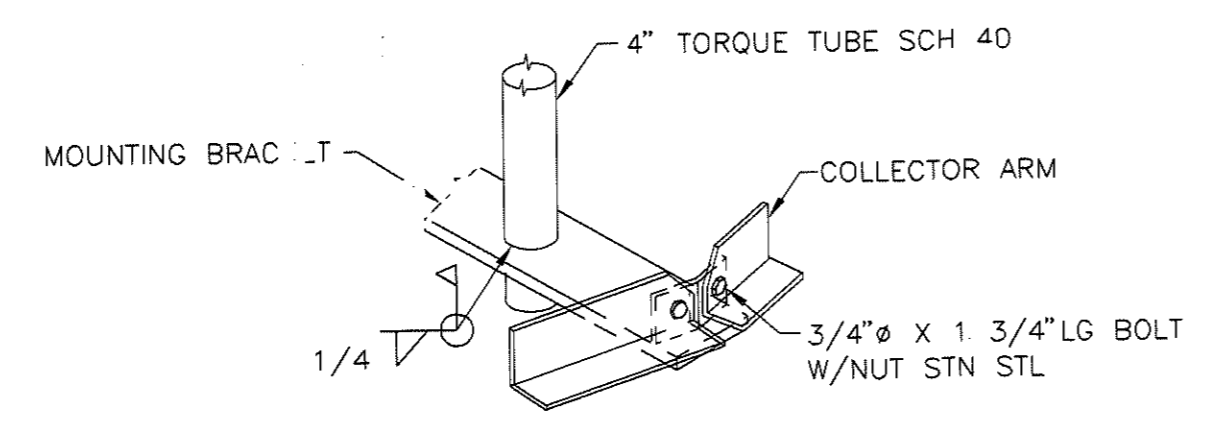


DETAIL 1
SCALE: NTS

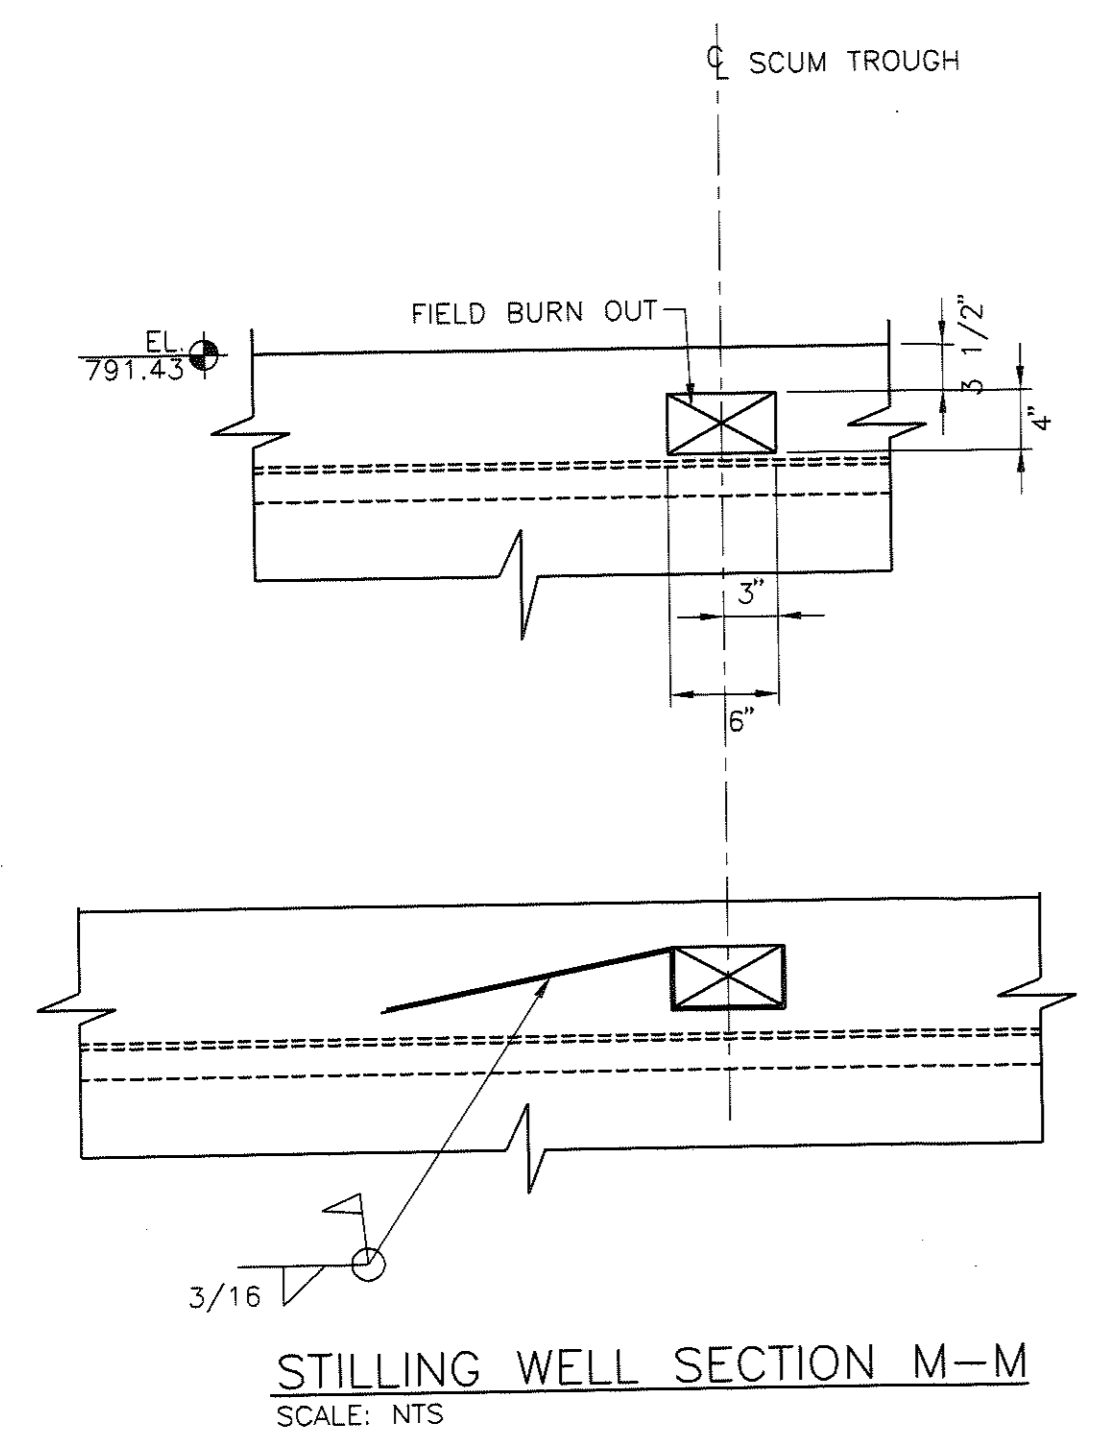


STILLING WELL SECTION M-M
SCALE: NTS

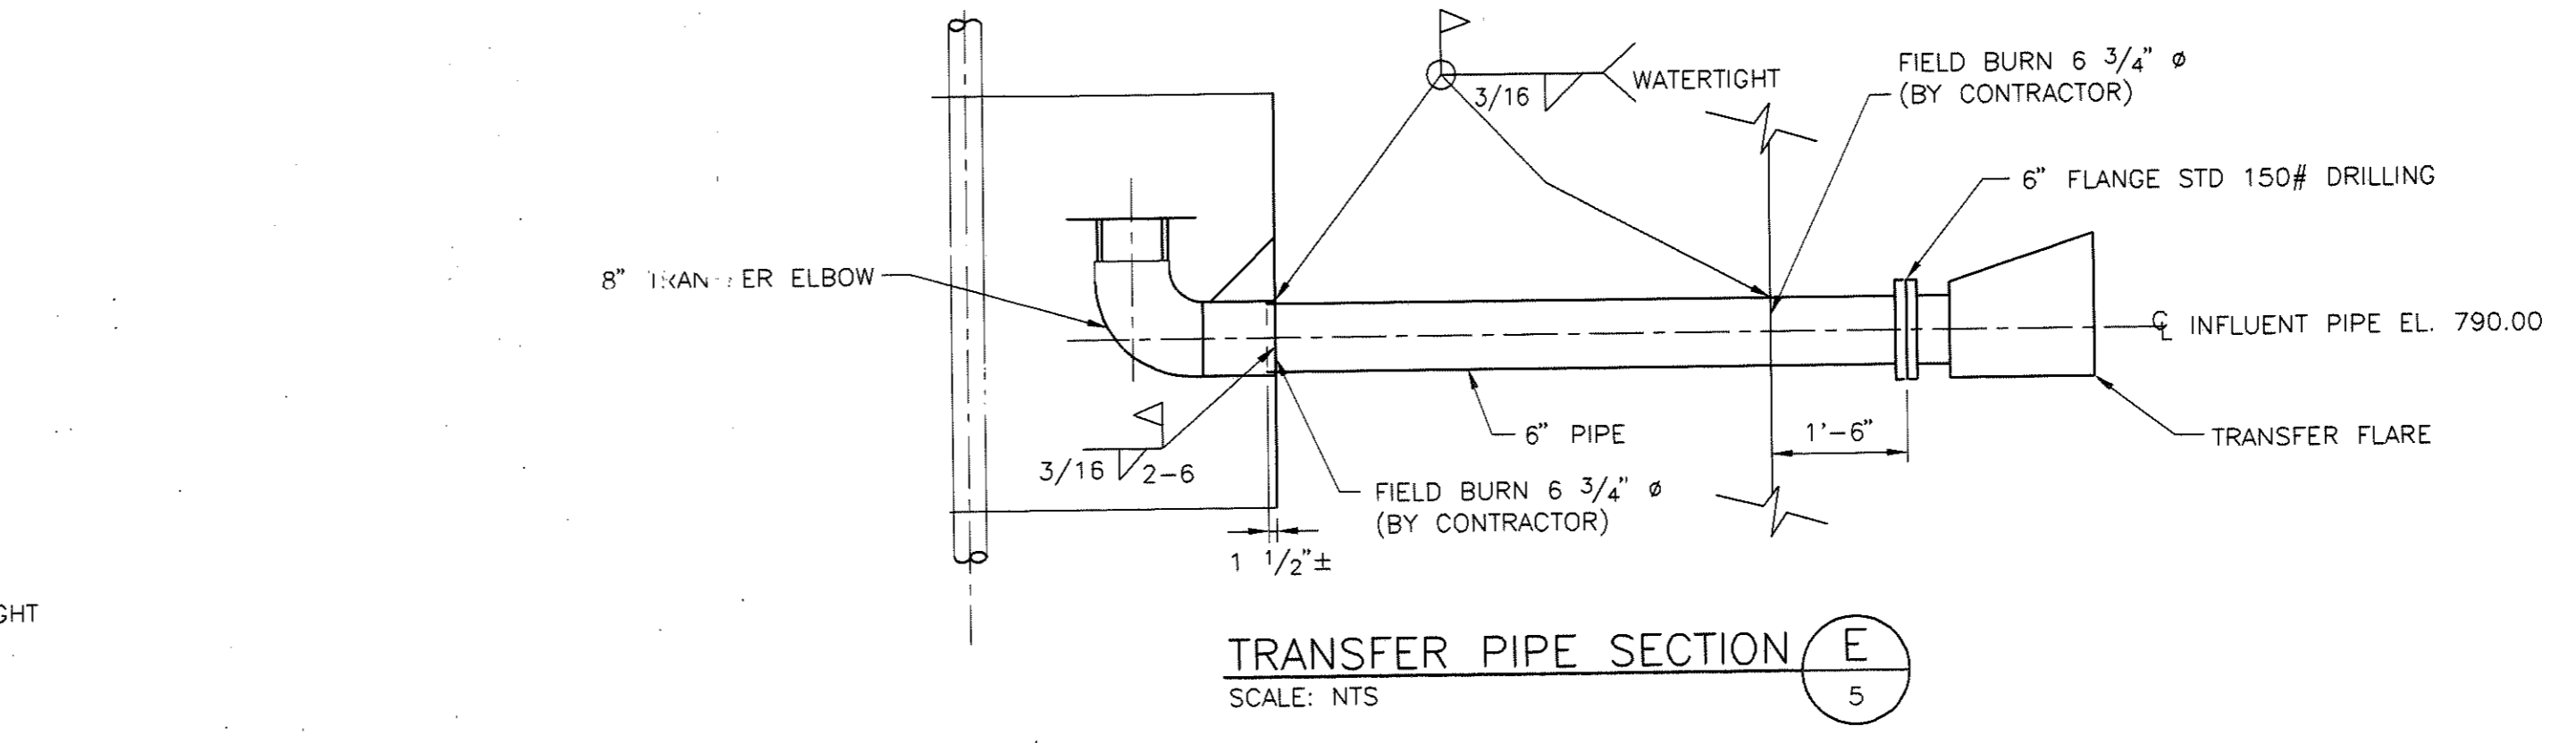


TRANSFER PIPE SECTION E-5
SCALE: NTS

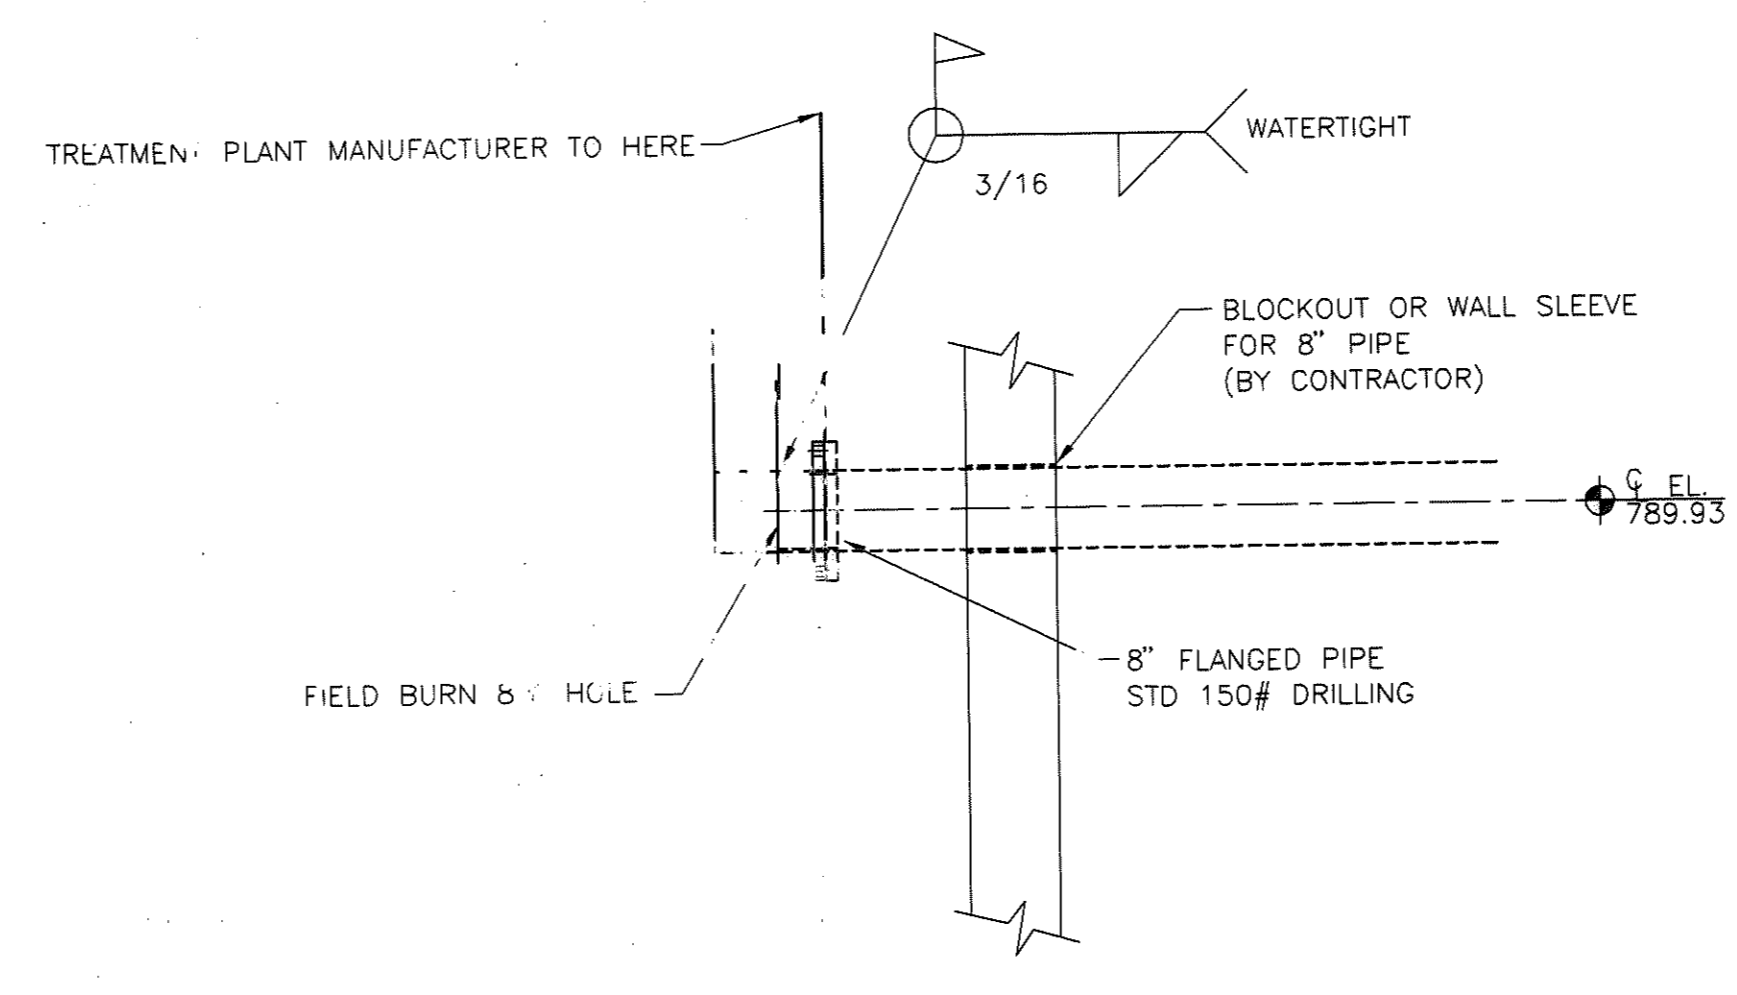


EFFLUENT SUMP/PIPE SECTION F-5
SCALE: NTS

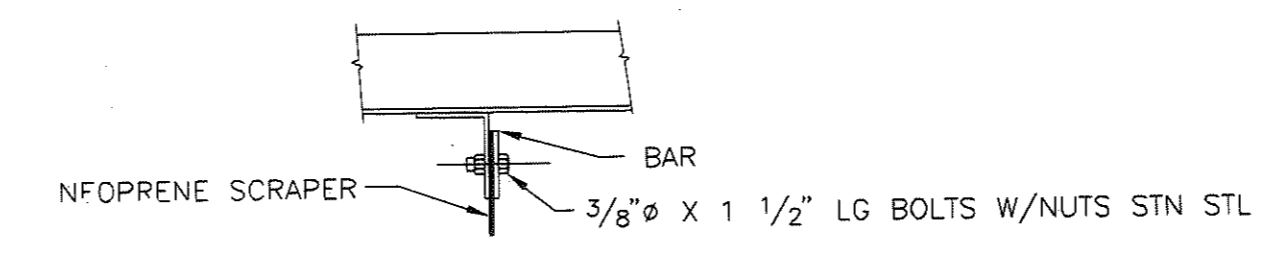


SECTION K-K
SCALE: NTS

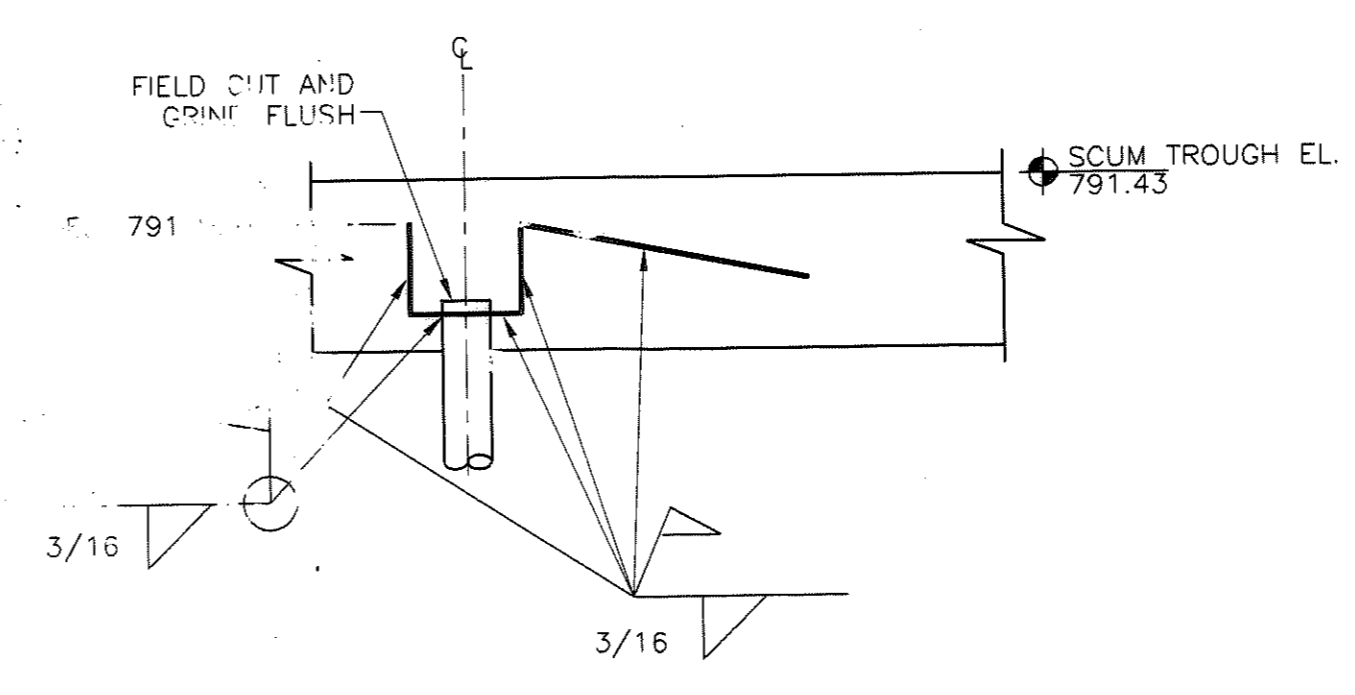

SCUM BAFFLE SECTION L-L
SCALE: NTS

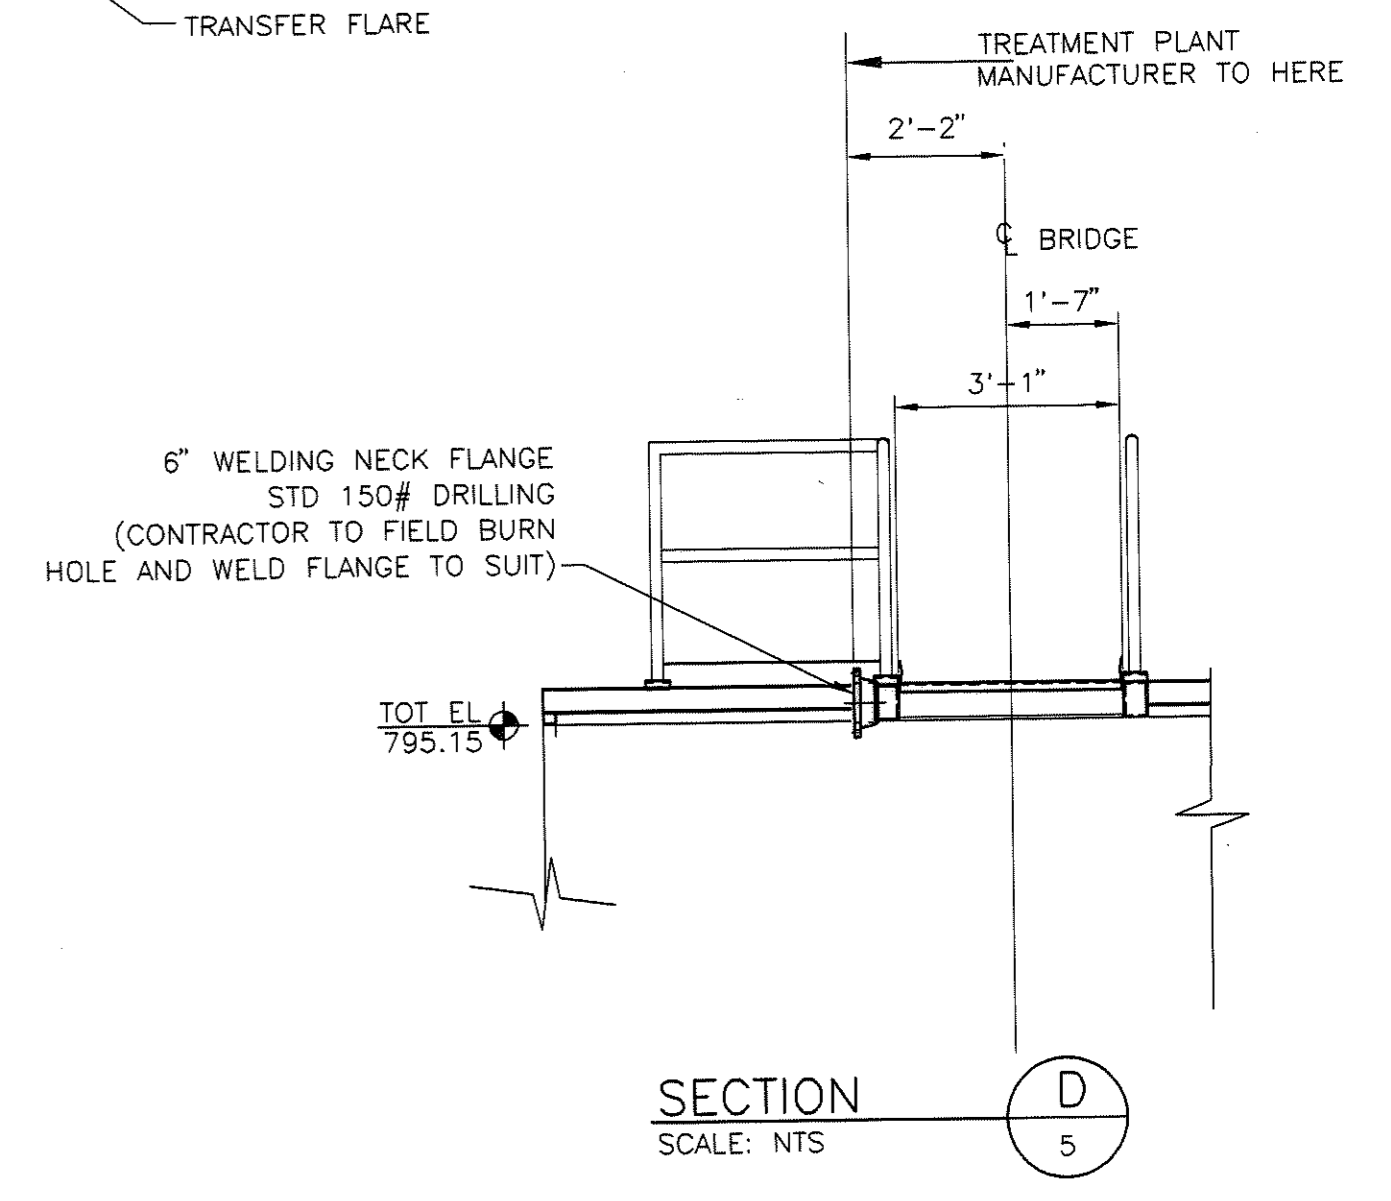


SECTION D-5
SCALE: NTS

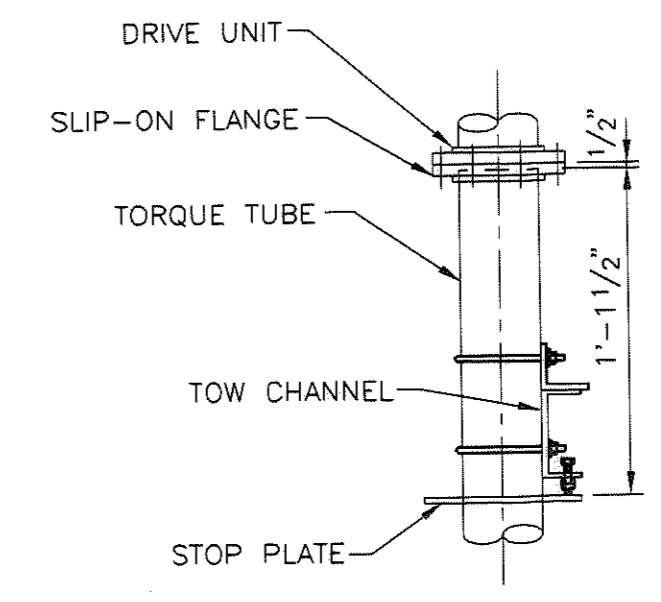


SECTION C-5
SCALE: NTS

INSTALL THE COLLECTOR DRIVE UNIT. CHECK FOR LEVEL, AND CENTER WITH REFERENCE TO THE SUMP AND BRIDGE BASE LINE. WITH THE SLIP-ON FLANGE BOLTED TO THE DRIVE UNIT, POSITION THE TORQUE TUBE INTO THE FLANGE. CHECK FOR PLUMB AND WELD. 1/4" FILLET ALL AROUND) 2 PASS WELD. REMOVE TORQUE TUBE WITH SLIP-ON FLANGE AND WELD INSIDE FLANGE. (1/4" FILLET ALL AROUND) 1 PASS WELD. ASSEMBLE TORQUE TO DRIVE UNIT.

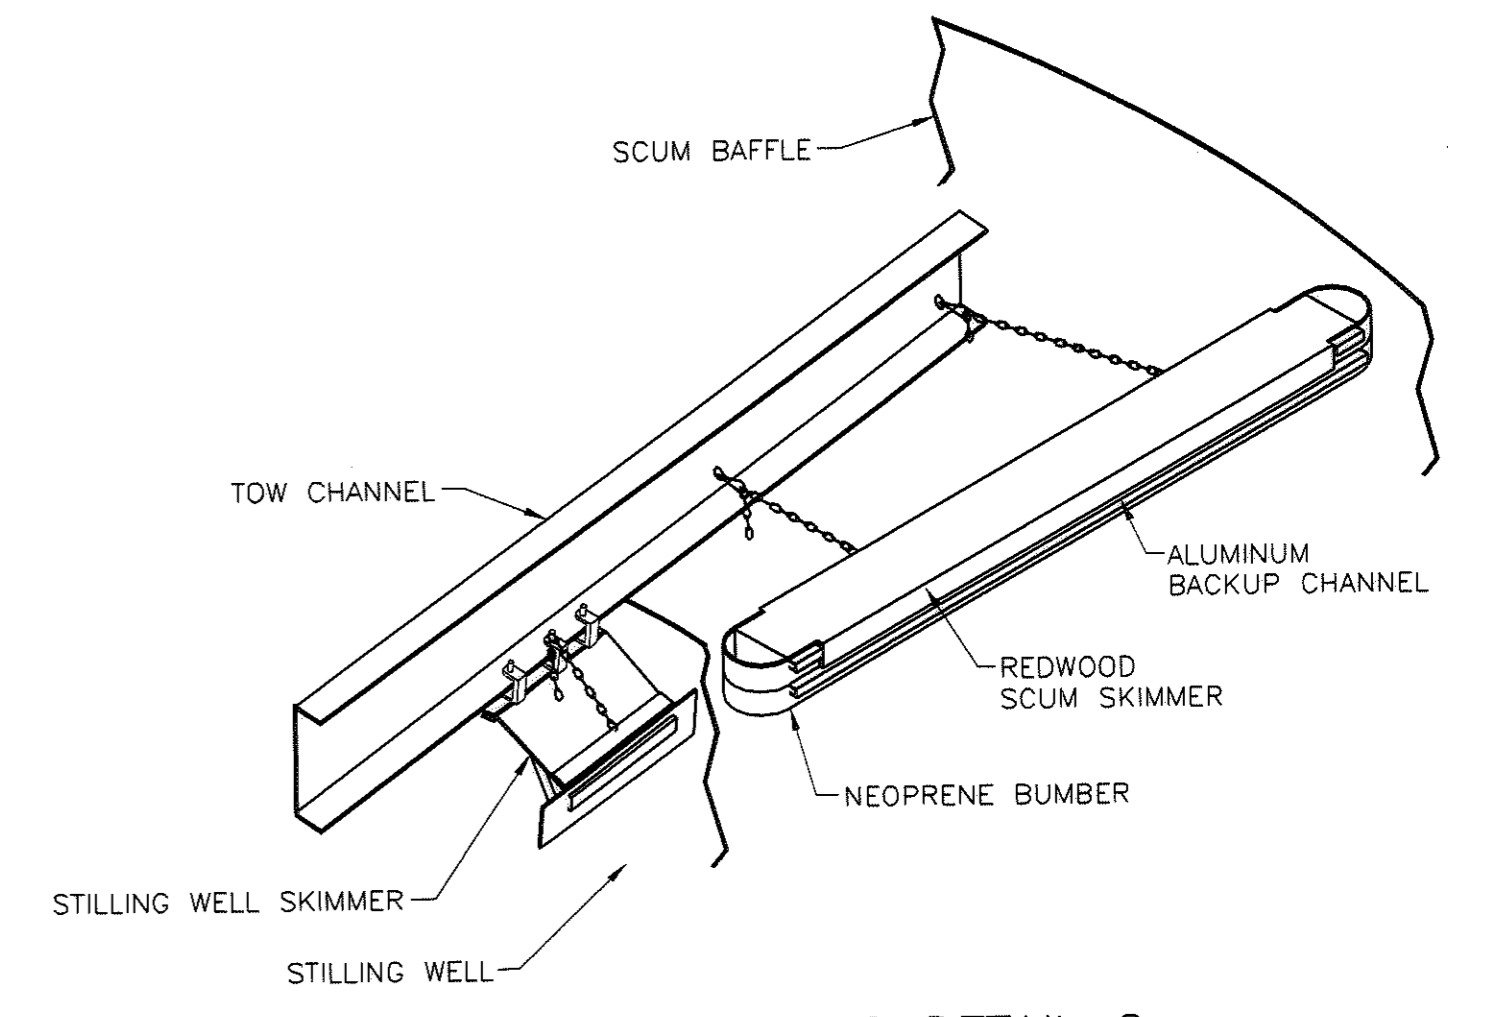

SCUM SKIMMERS DETAIL 2
SCALE: NTS

REVISED "AS-BUILT" DRAWING
THIS DRAWING HAS BEEN REVISED IN ACCORDANCE WITH NOTES ON "RECORD DRAWINGS" FURNISHED BY THE CONTRACTOR AND WITH EXECUTED CHANGE ORDERS. TO THE BEST OF OUR KNOWLEDGE AND BELIEF, THIS DRAWING SHOWS ACTUAL "AS-BUILT" CONDITIONS.
COMMONWEALTH ENGINEERS, INC.
REVISED: DATE 10/06
BY: JCW, CK. BY: CWW

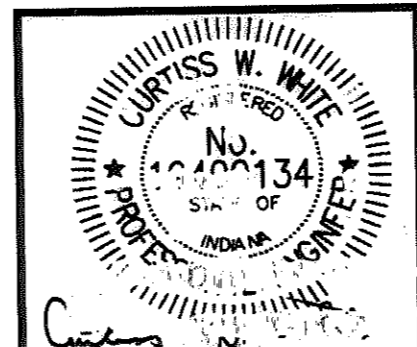


COMMONWEALTH ENGINEERS, INC.


DRAWN BY: CB
DESIGNED BY: CWW
CHECKED BY: CWW
DATE: 12/03
JOB NO: S02119-02
SCALE: AS NOTED

SALAMONIE RESERVOIR
WASTEWATER TREATMENT PLANT IMPROVEMENTS PROJECT
PUBLIC WORKS PROJECT NO. E031410M
TREATMENT PLANT PLAN AND SECTIONS


06-PACKAGE PLANT.dwg 32
DRAWING NO. 6
6 OF 52

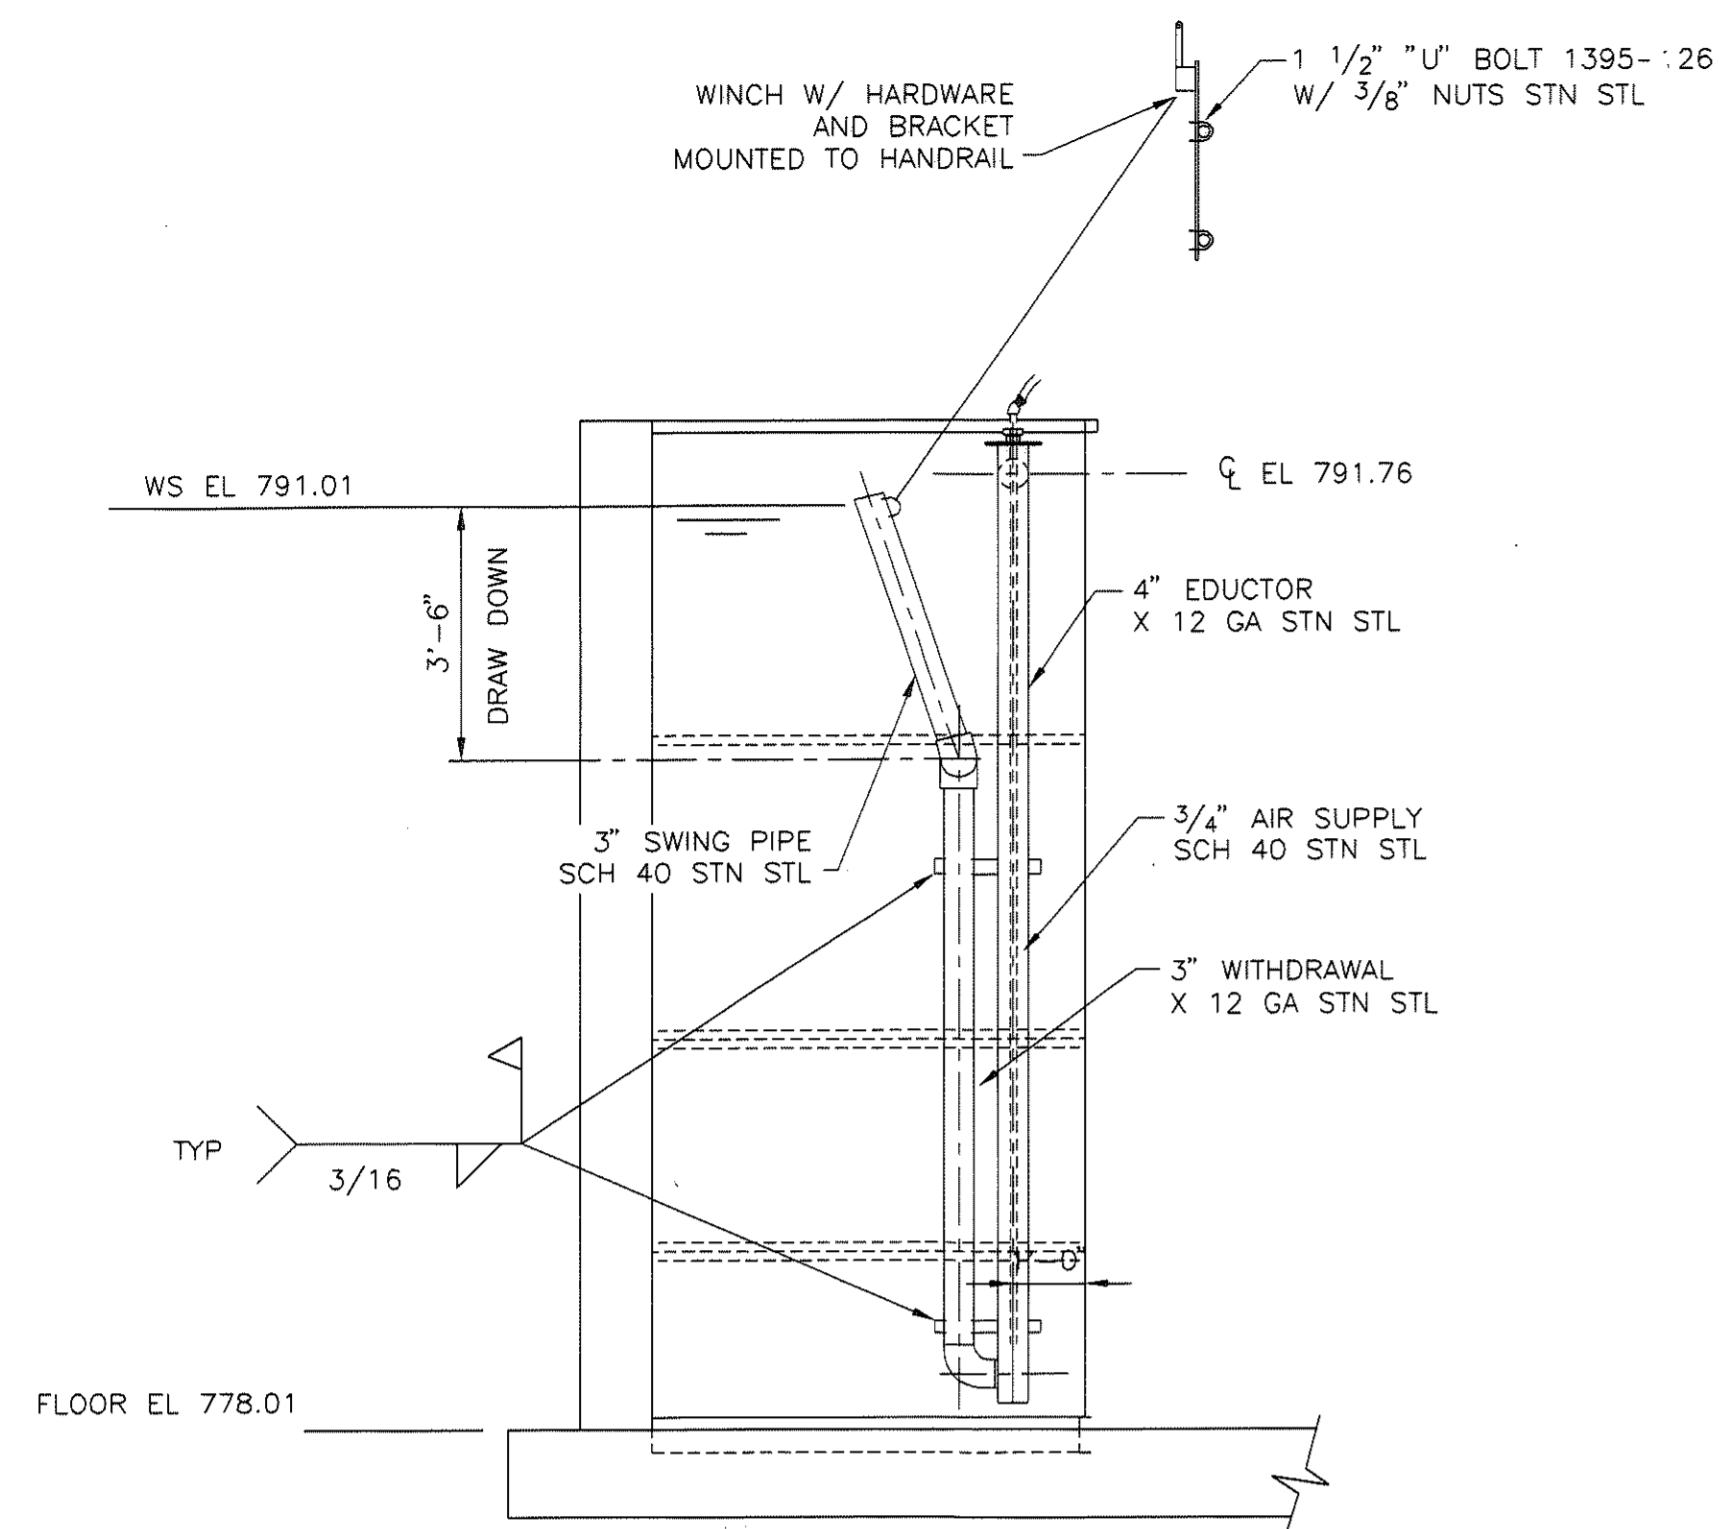


SUPERNATANT DECANT AIRLIFT SECTION G
SCALE: NTS

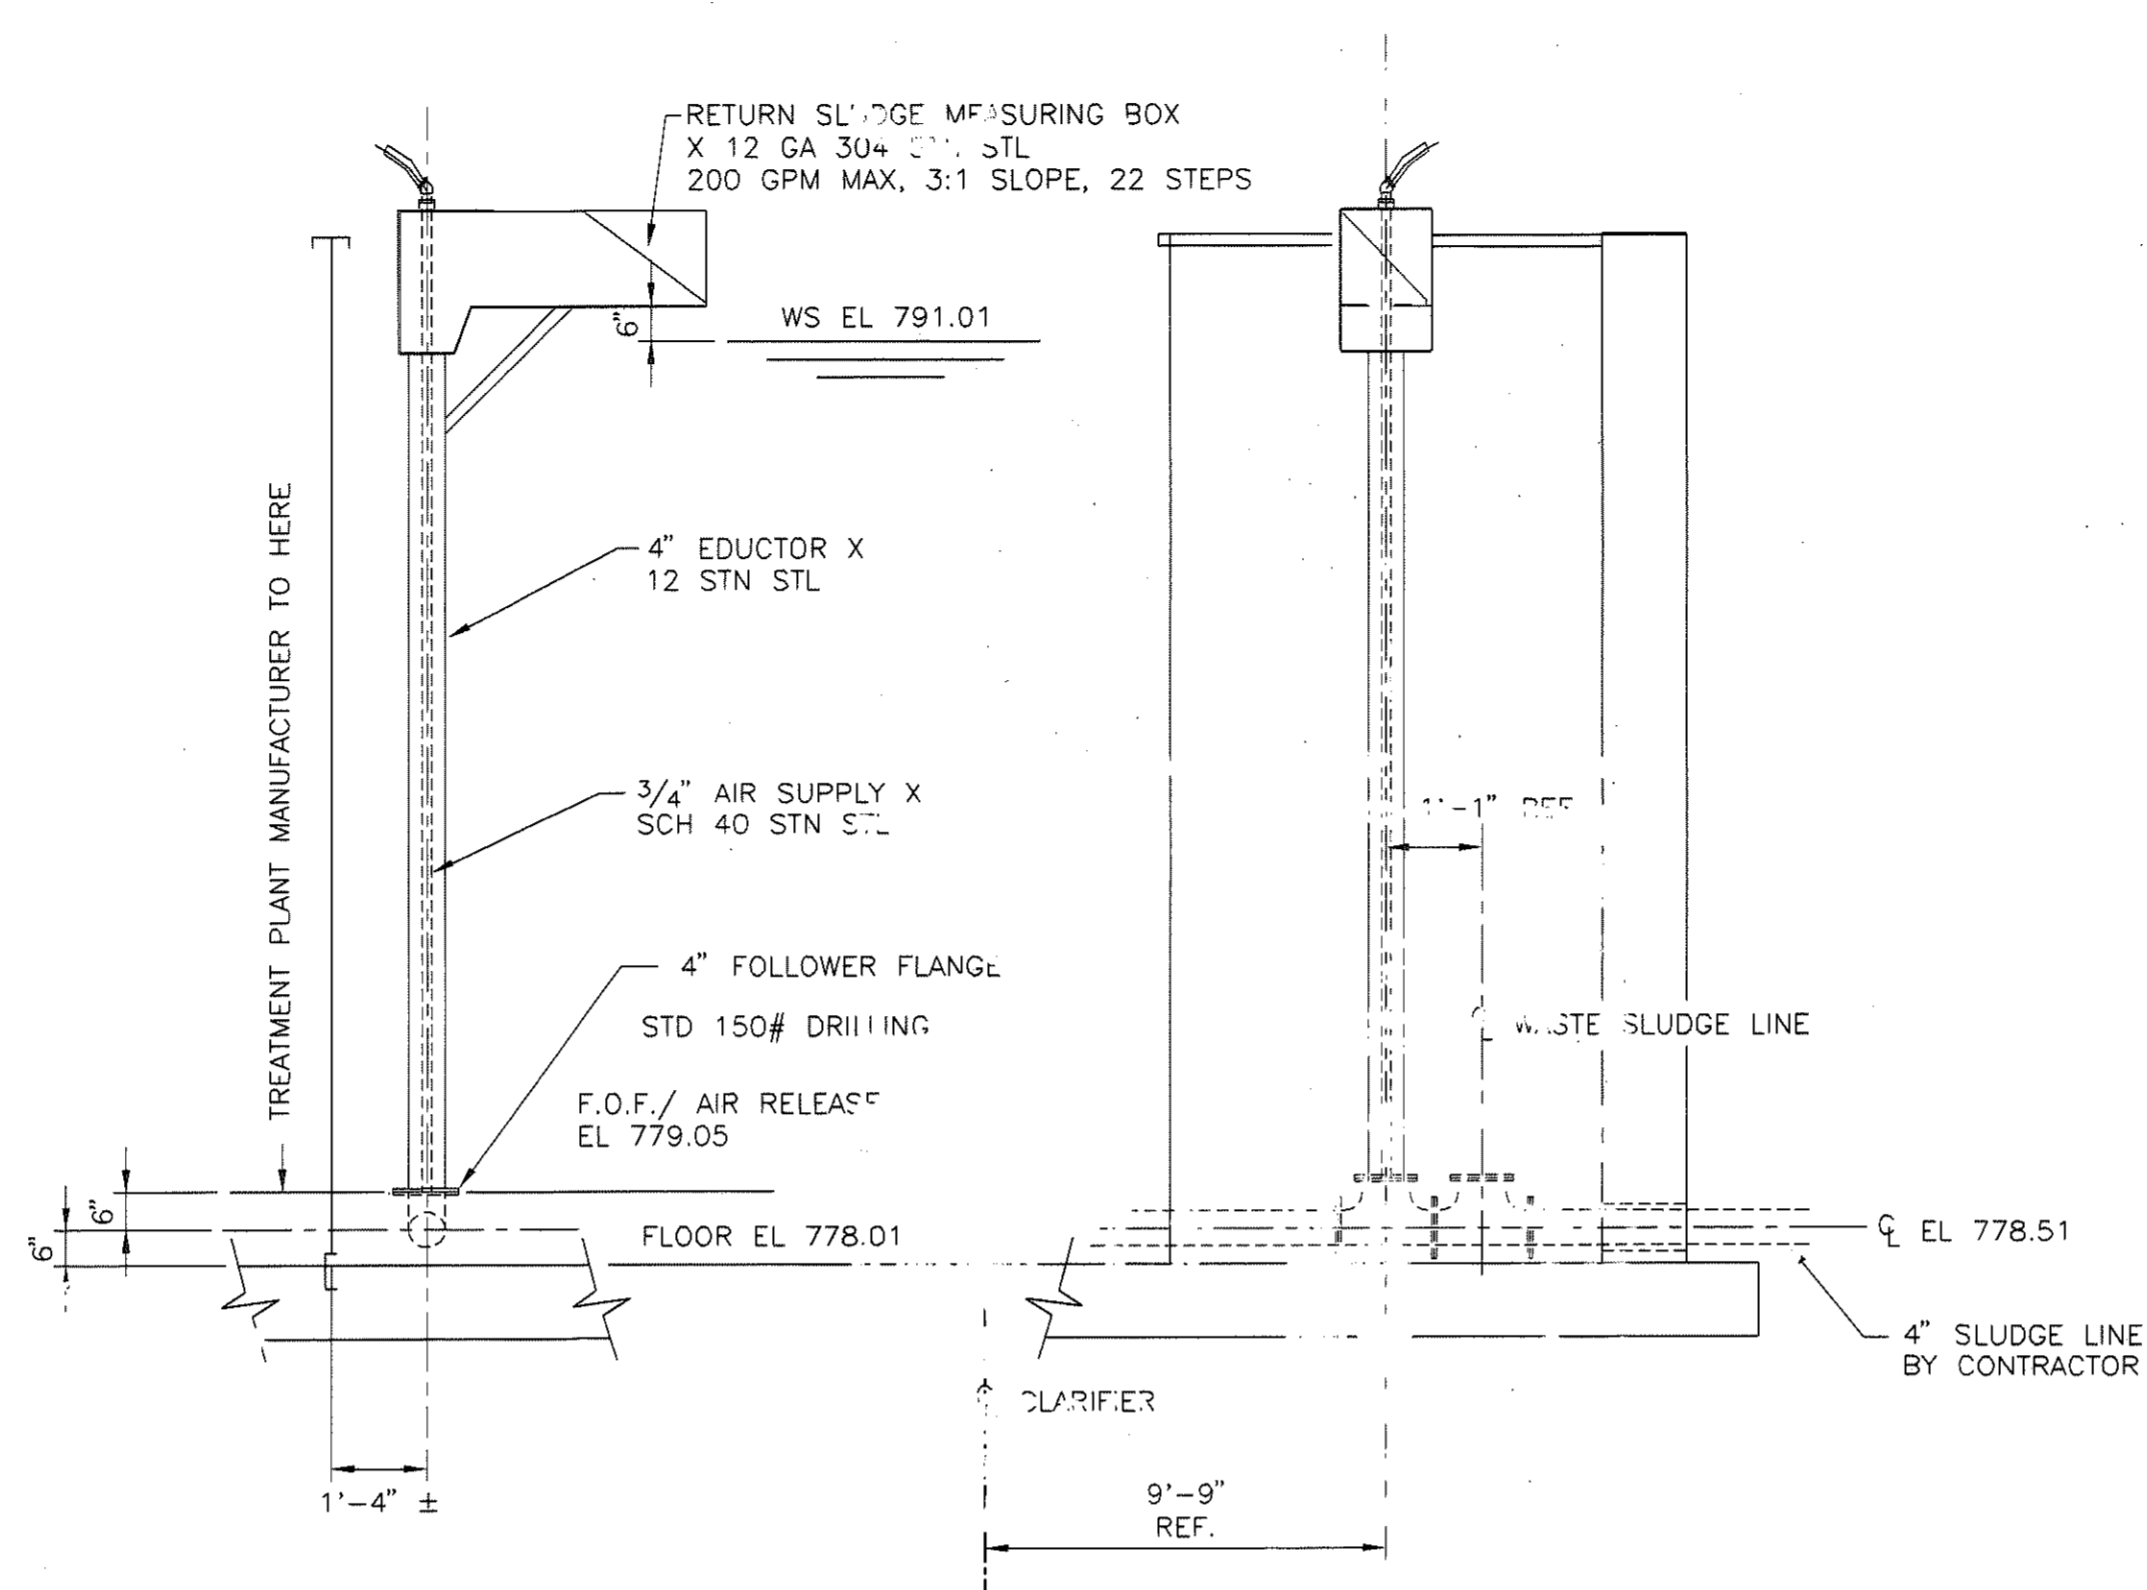

RETURN SLUDGE AIRLIFT SECTION J
SCALE: NTS

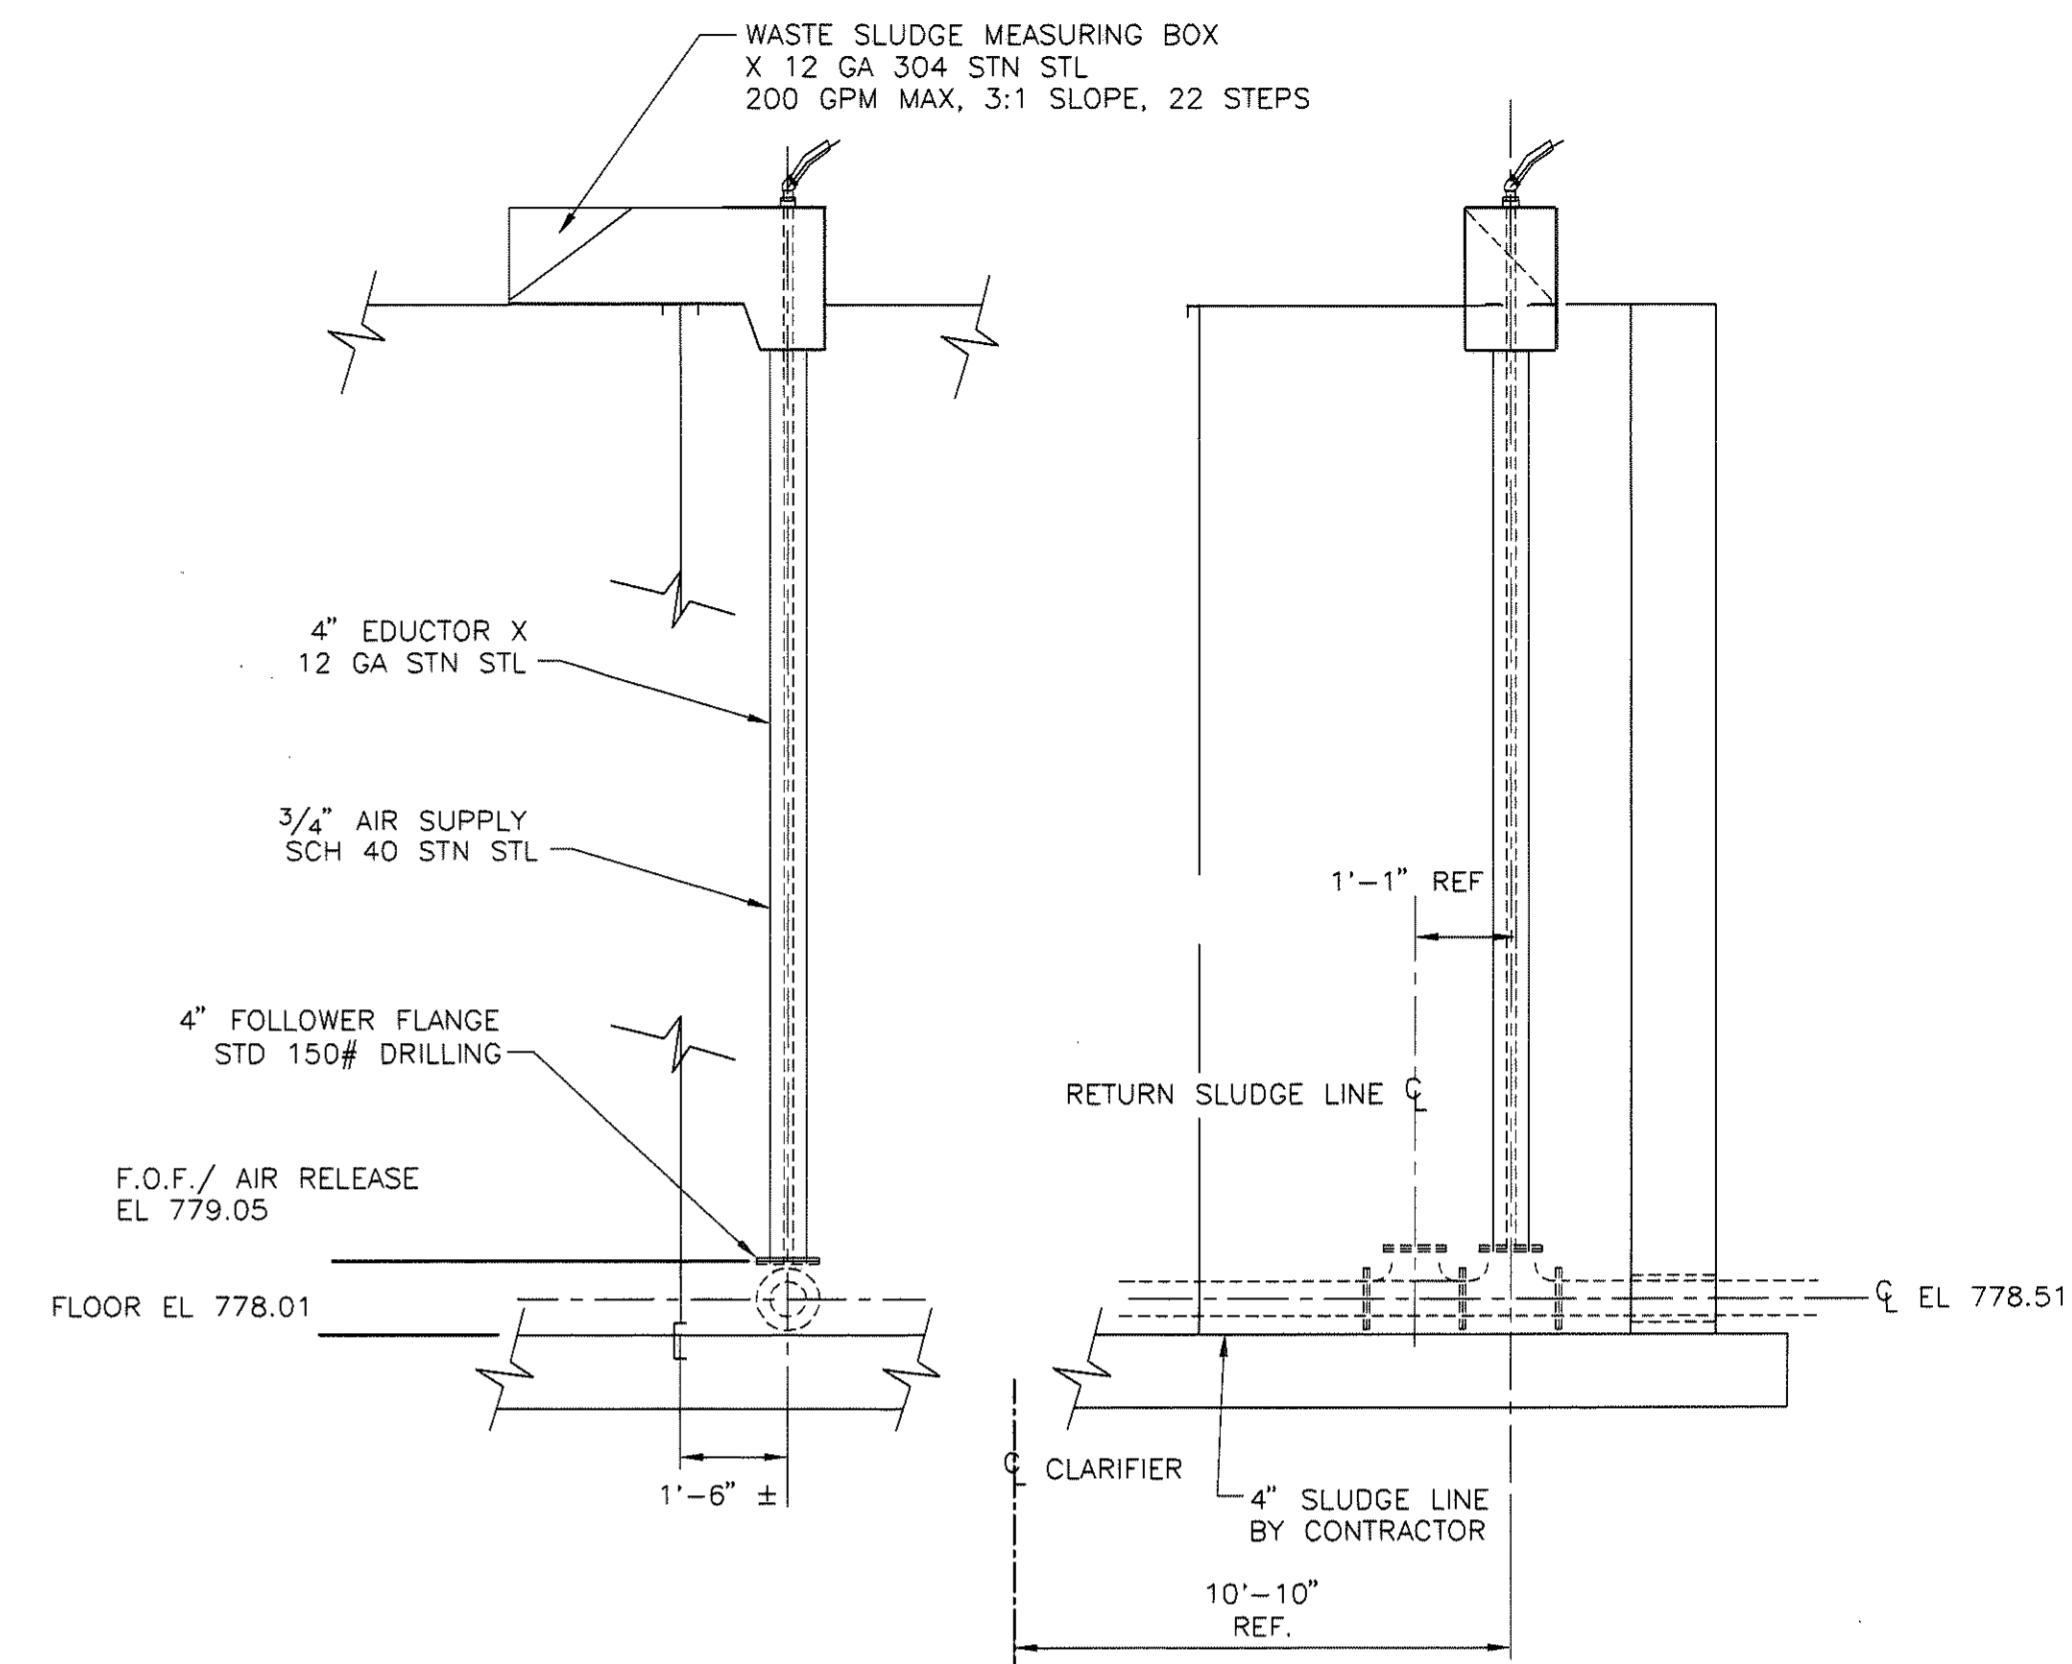


WASTE SLUDGE AIR LIFT SECTION H
SCALE: NTS

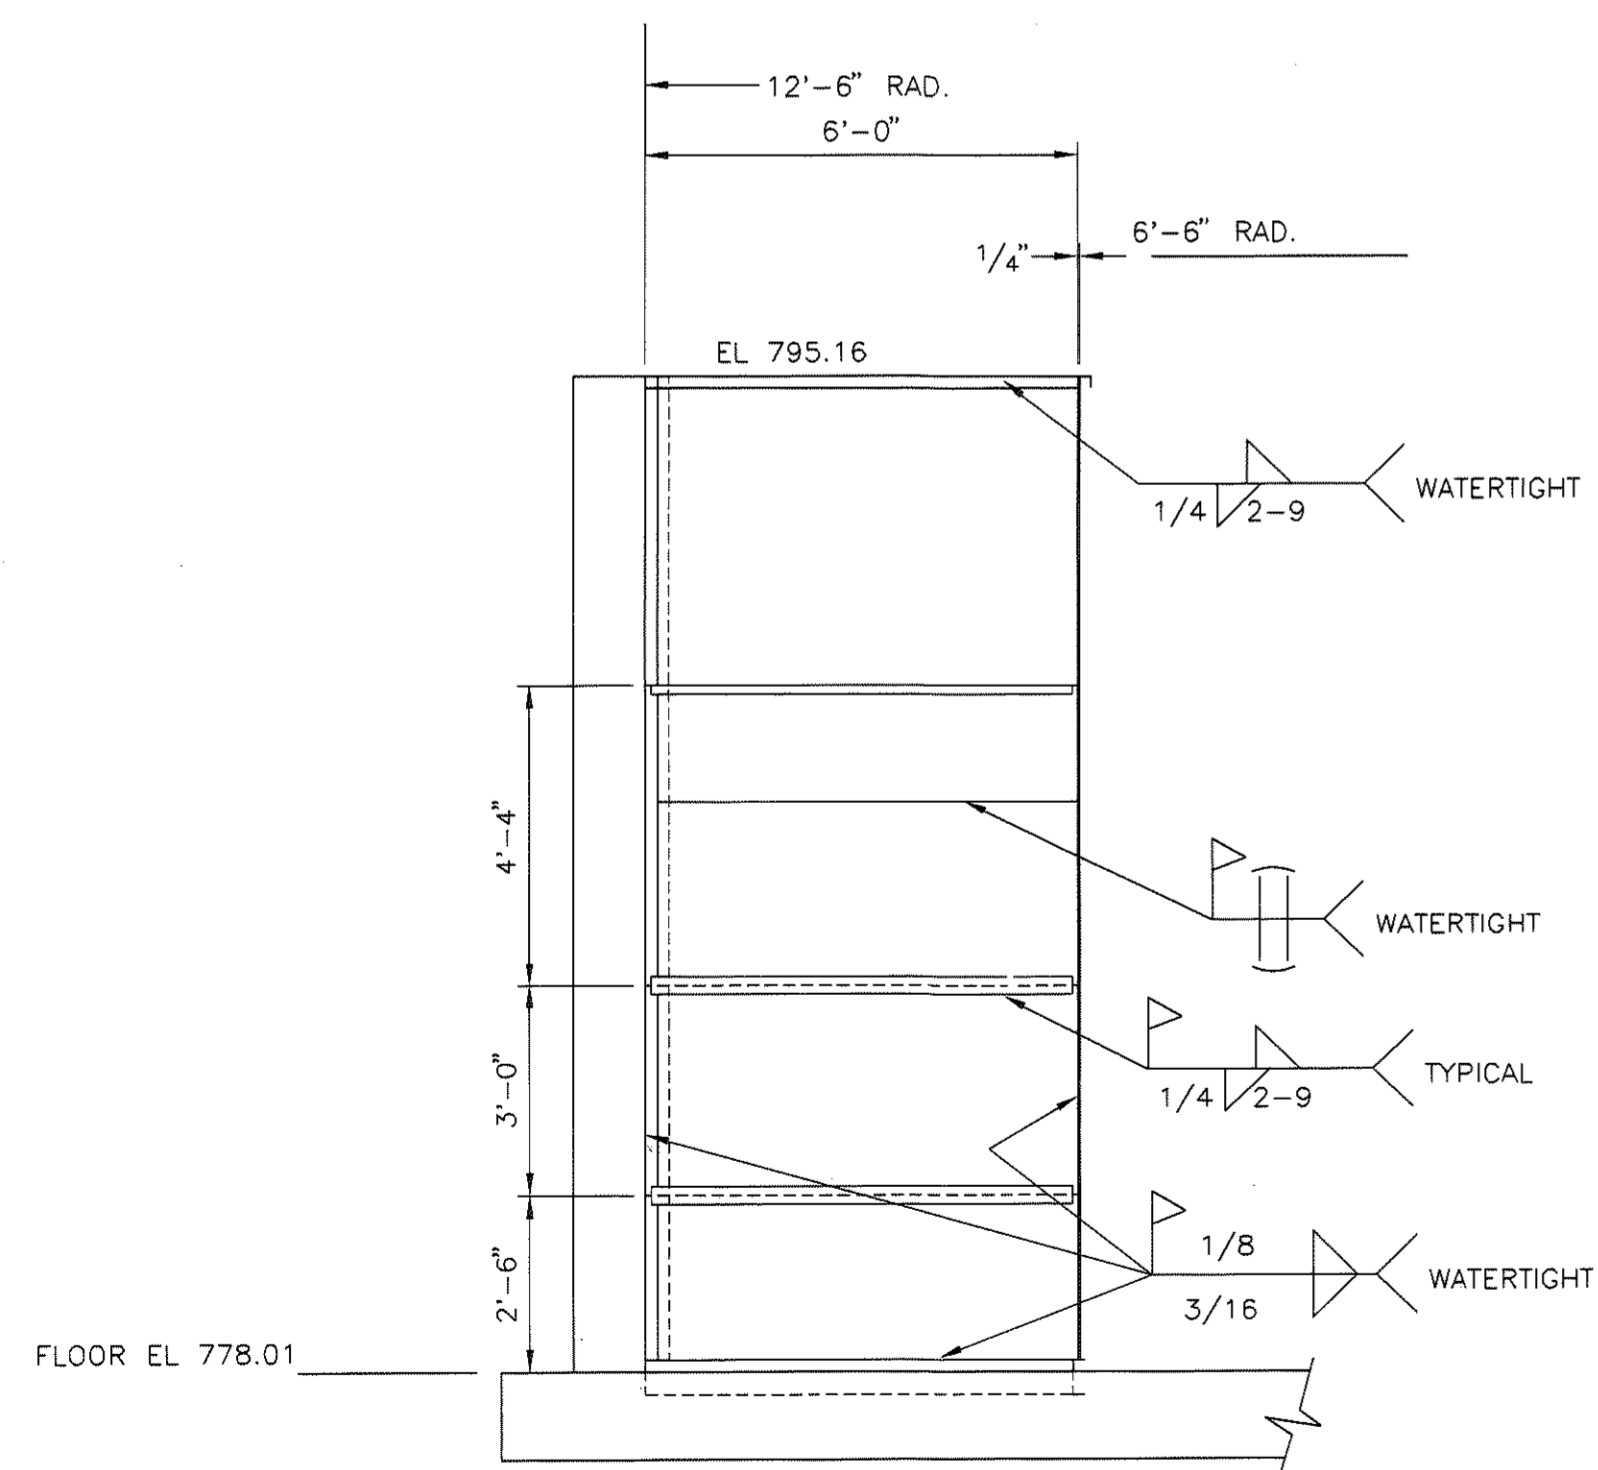


DIVIDING WALL SECTION I
SCALE: NTS

REINFORCED FOR FULL DEWATERING
(1) REQUIRED AS SHOWN
(1) REQUIRED MIRROR IMAGE

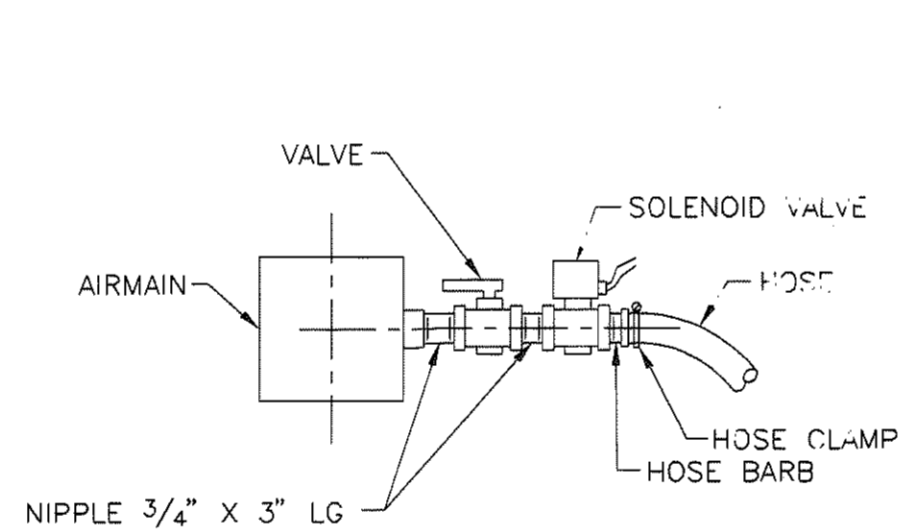


3/4" SCUM EJECTOR AIR SUPPLY SECTION N
SCALE: NTS

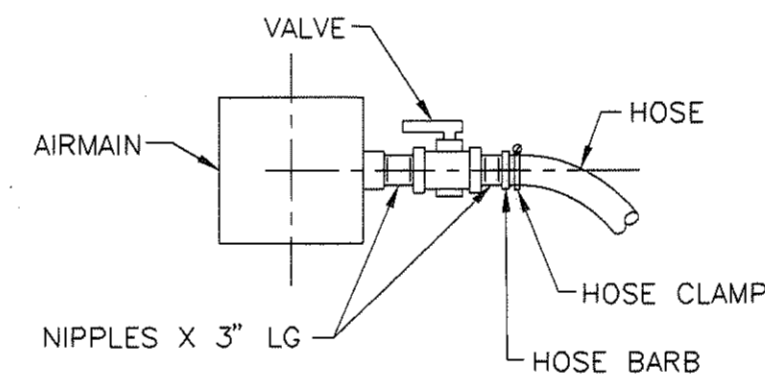

3/4" SUPERNATANT DECANT AIR SUPPLY SECTION O
SCALE: NTS

REVISED "AS-BUILT" DRAWING
THIS DRAWING HAS BEEN REVISED IN ACCORDANCE WITH NOTES ON "RECORD DRAWINGS" FURNISHED BY THE CONTRACTOR AND WITH EXECUTED CHANGE ORDERS. TO THE BEST OF OUR KNOWLEDGE AND BELIEF, THIS DRAWING SHOWS ACTUAL "AS-BUILT" CONDITIONS.
COMMONWEALTH ENGINEERS, INC.
REVISED: DATE 10/06
BY JCW, CK, BY CWW

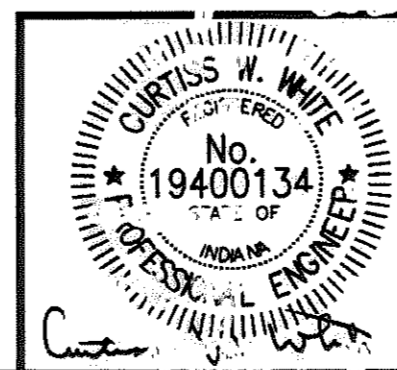


COMMONWEALTH ENGINEERS, INC.


DRAWN BY: CB
DESIGNED BY: CWW
CHECKED BY: CWW
DATE: 12/03
JOB NO: S02119-02
SCALE: AS NOTED

SALAMONIE RESERVOIR
WASTEWATER TREATMENT PLANT IMPROVEMENTS PROJECT
PUBLIC WORKS PROJECT NO. E01410M
TREATMENT PLANT PLAN AND SECTIONS

DRAWING NO.
7
7 OF 52

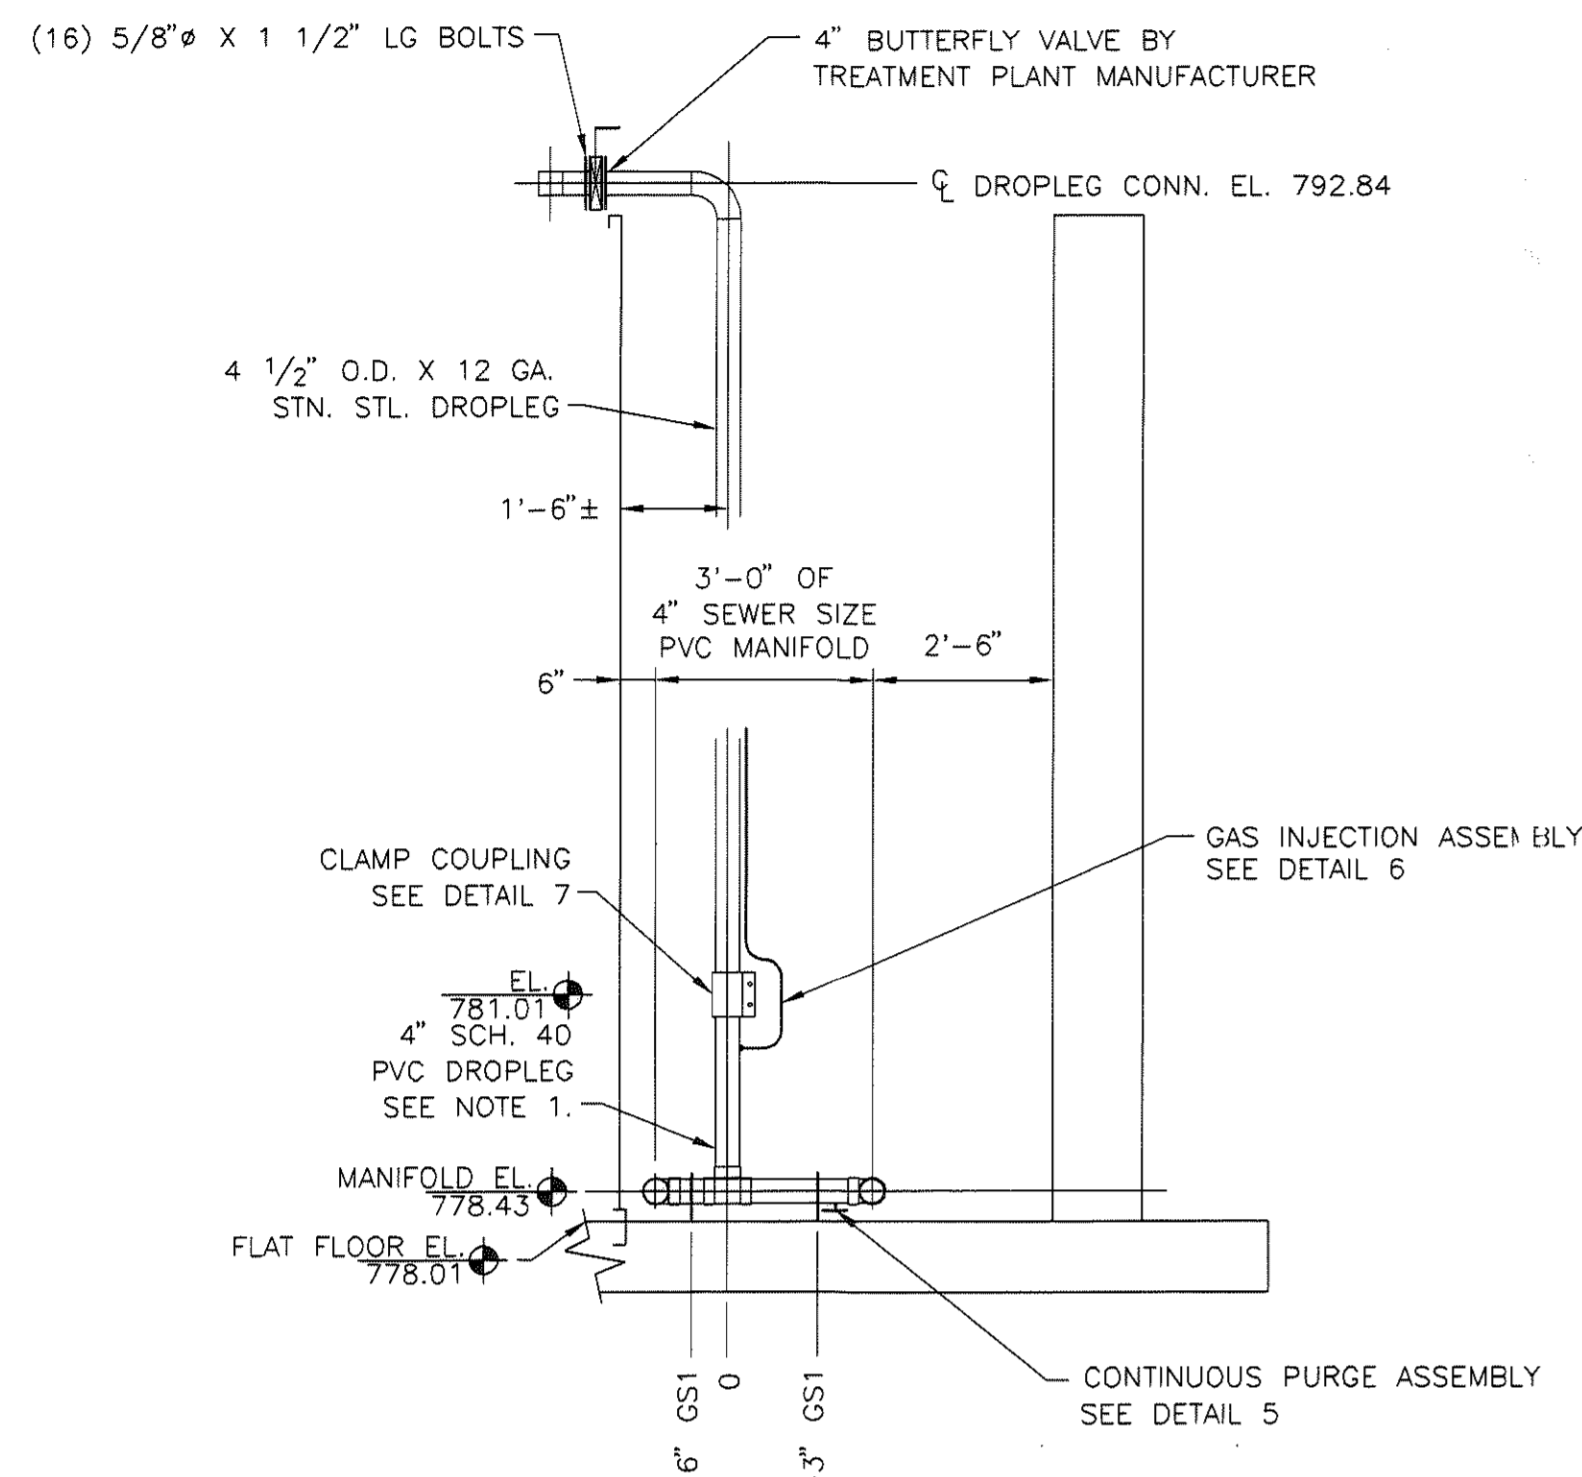


2 REQUIRED
MANIFOLD SECTION P
 SCALE: NTS

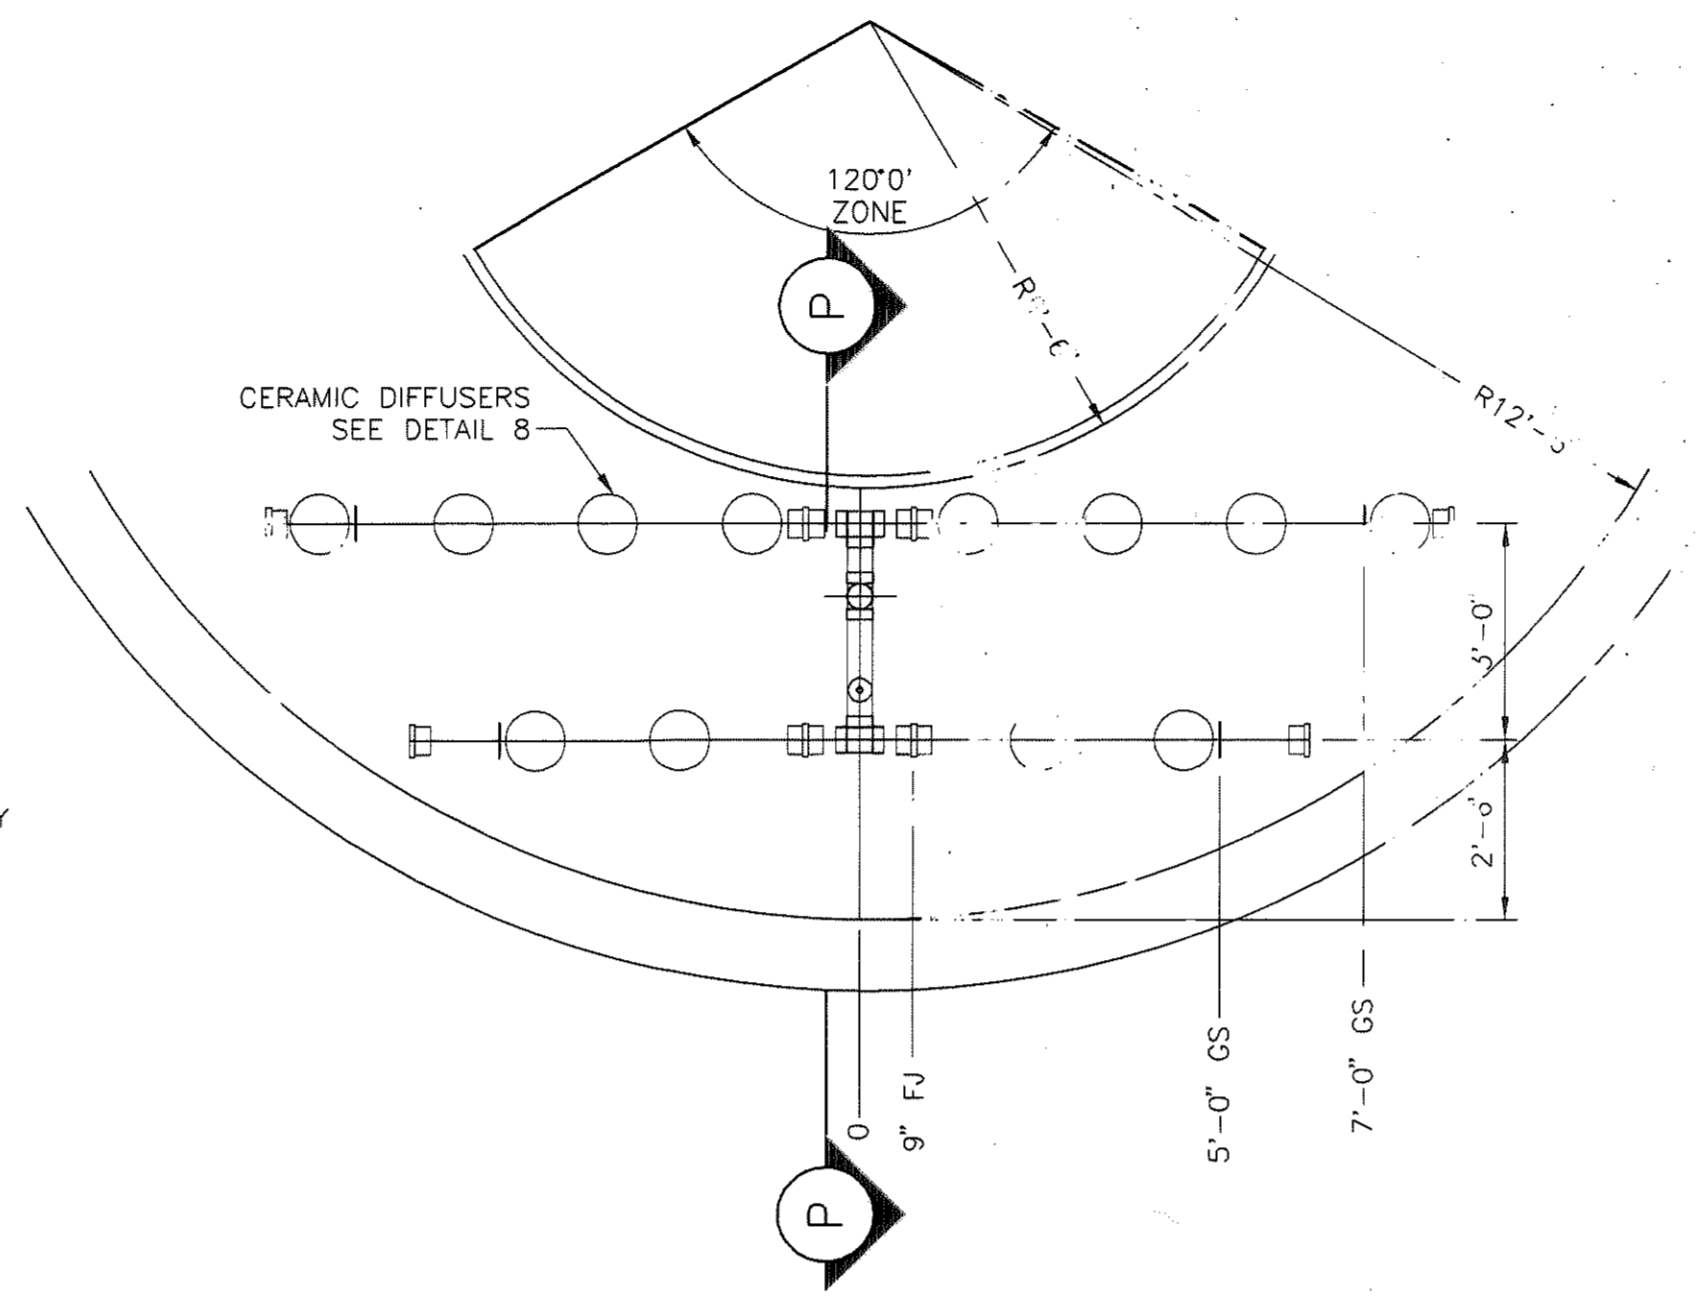


2 REQUIRED
AERATION TANK PLAN VIEW
 SCALE: NTS

- LEGEND**
- GS - GUIDE SUPPORT
SEE DETAIL 16
 - GS1 - GUIDE SUPPORT
SEE DETAIL 17
 - FJ - FIXED JOINT
SEE DETAIL 20
- FOR TYPICAL AIR DISTRIBUTOR SECTION SEE DETAIL 18

- NOTES:**
1. PVC DROPLEG WILL BE SHIPPED TO JOBSITE 6" LONGER THAN REQUIRED, TO ACCOUNT FOR TANK VARIANCES. CONTRACTOR TO CUT TO SUIT AND SOLVENT WELD INTO MANIFOLD TO MAINTAIN 1/8" MAXIMUM GAP BETWEEN STAINLESS STEEL AND PVC DROPLEGS.
 2. DIFFUSER LAYOUT AS PER MANUFACTURERS REQUIREMENTS

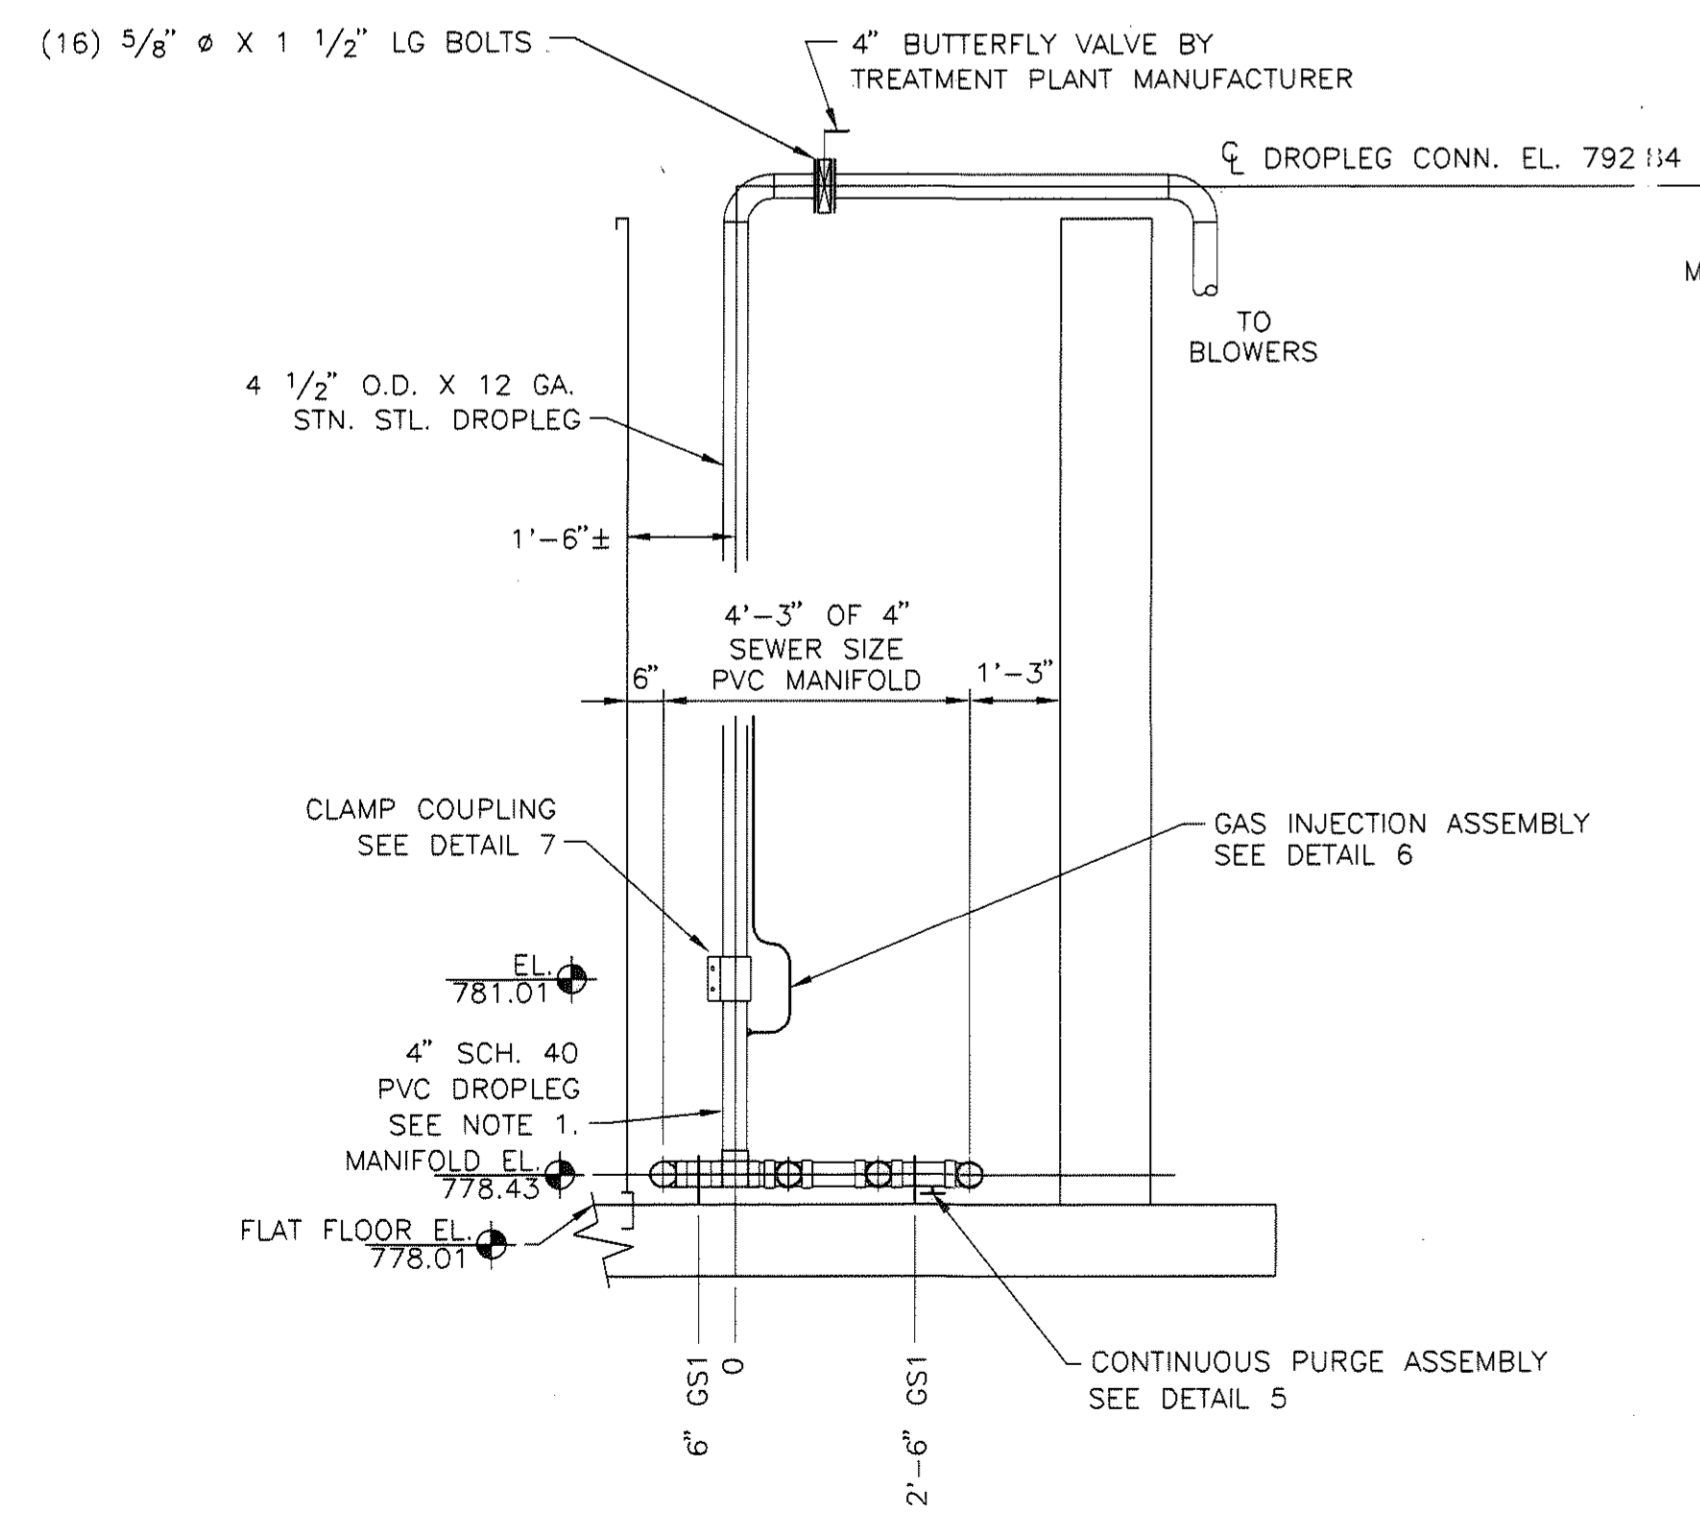

1 REQUIRED
MANIFOLD SECTION Q
 SCALE: NTS

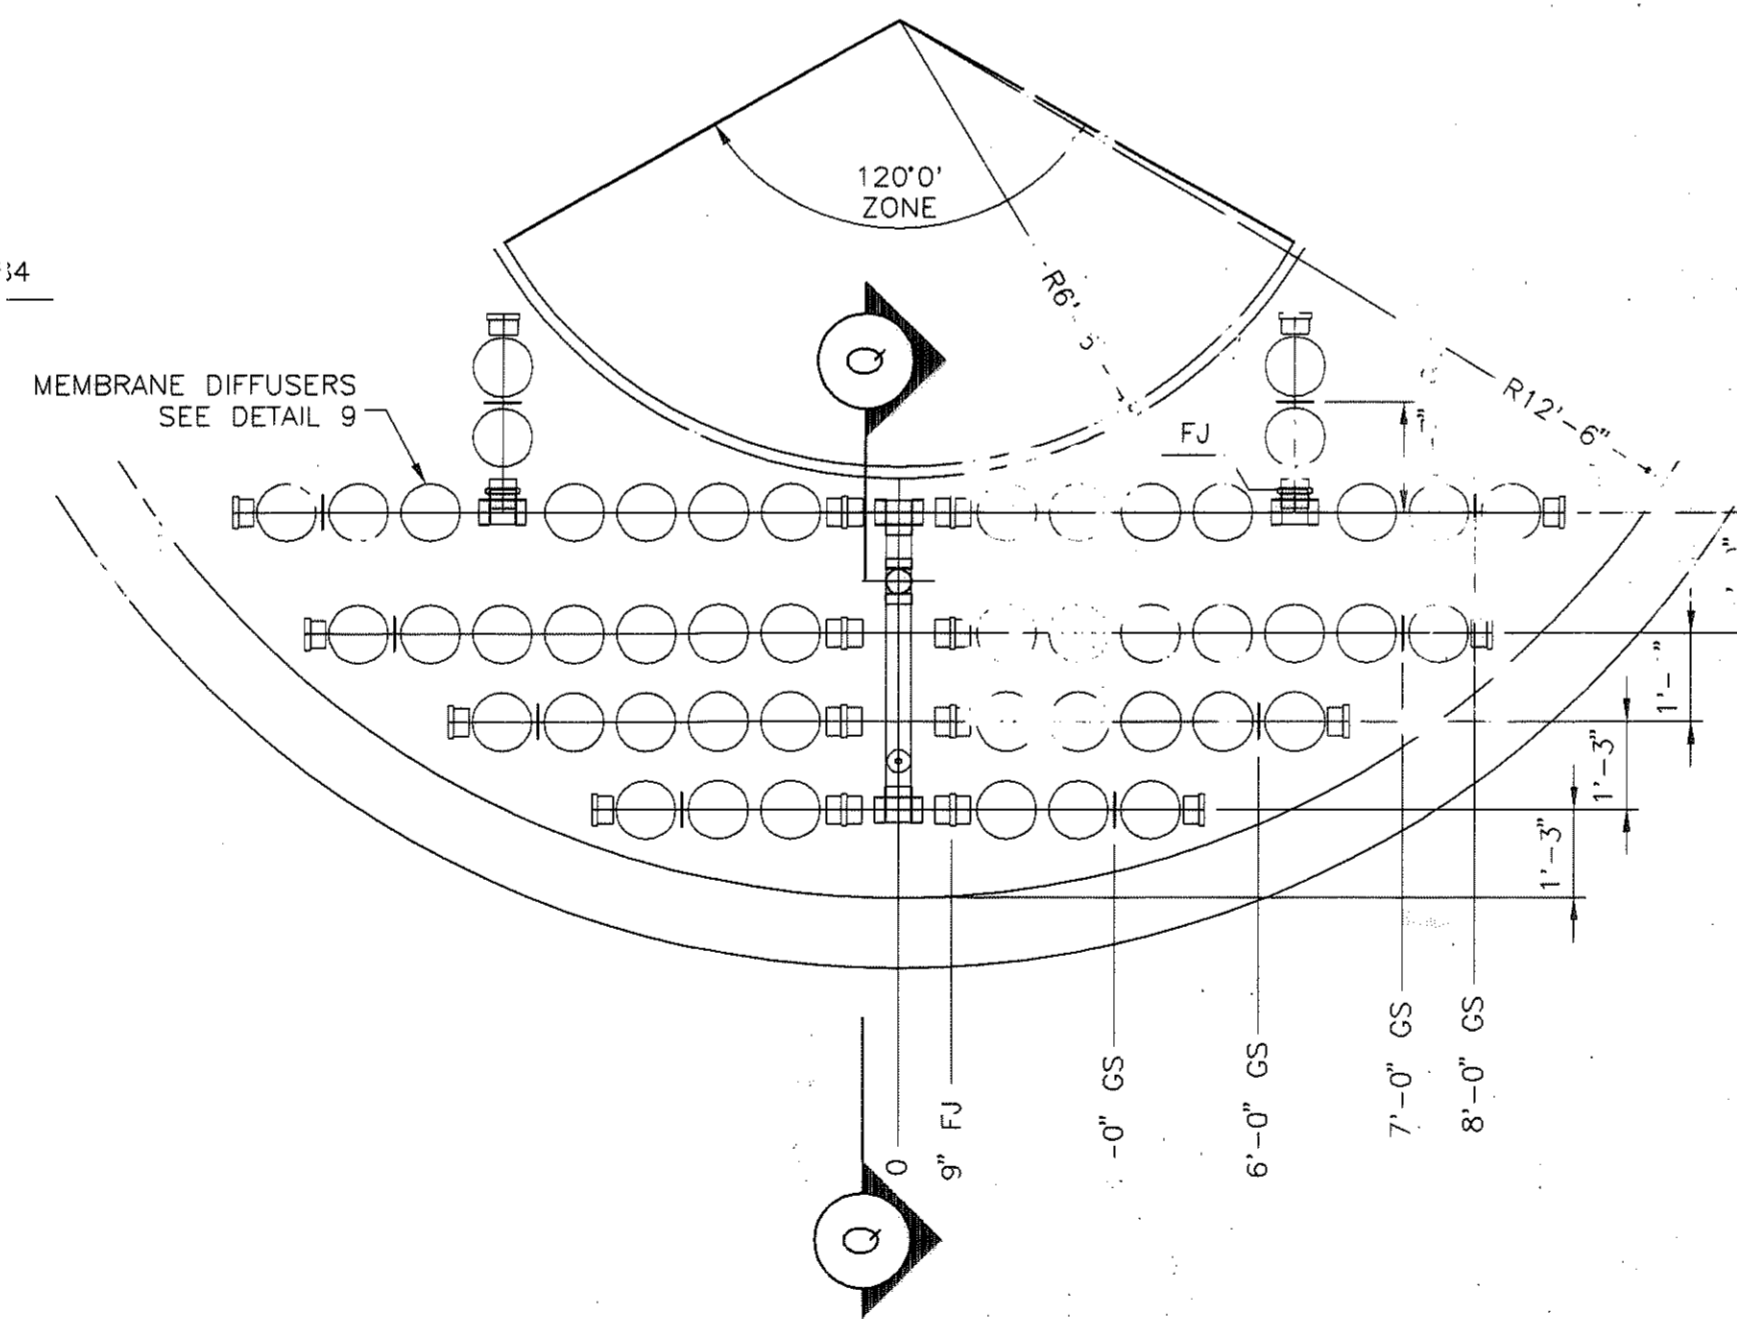


1 REQUIRED
SLUDGE HOLDING TANK PLAN VIEW
 SCALE: NTS

REVISED "AS-BUILT" DRAWING

THIS DRAWING HAS BEEN REVISED IN ACCORDANCE WITH NOTES ON "RECORD DRAWINGS" FURNISHED BY THE CONTRACTOR AND WITH EXECUTED CHANGE ORDERS, TO THE BEST OF OUR KNOWLEDGE AND BELIEF, THIS DRAWING SHOWS ACTUAL "AS-BUILT" CONDITIONS.

COMMONWEALTH ENGINEERS, INC.


REVISED DATE: 10/06
 BY: JCW CK: BY: CWV

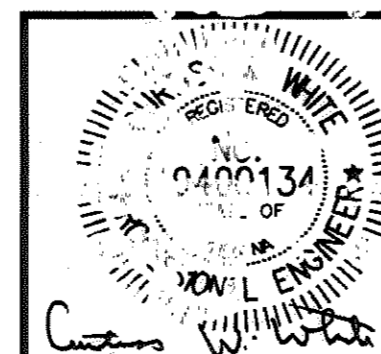

COMMONWEALTH ENGINEERS, INC.


DRAWN BY: CB
 DESIGNED BY: CWV
 CHECKED BY: CWV
 DATE: 12/03
 JOB NO: S02119-02
 SCALE: AS NOTED

SALAMONIE RESERVOIR
 WASTEWATER TREATMENT PLANT IMPROVEMENTS PROJECT
 PUBLIC WORKS PROJECT NO. E031410M
 TREATMENT PLANT PLAN AND SECTIONS

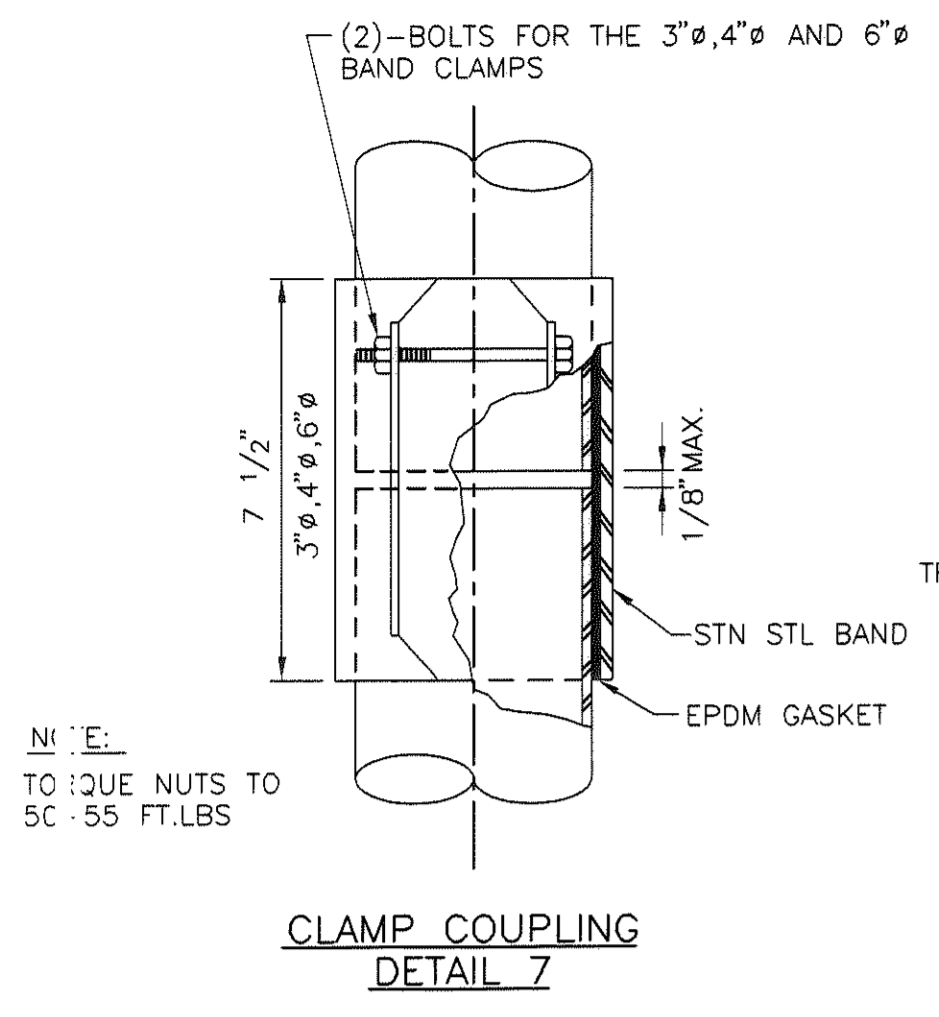


NOTE:
TO TIGHTEN NUTS TO
50-55 FT.LBS

**CLAMP COUPLING
DETAIL 7**

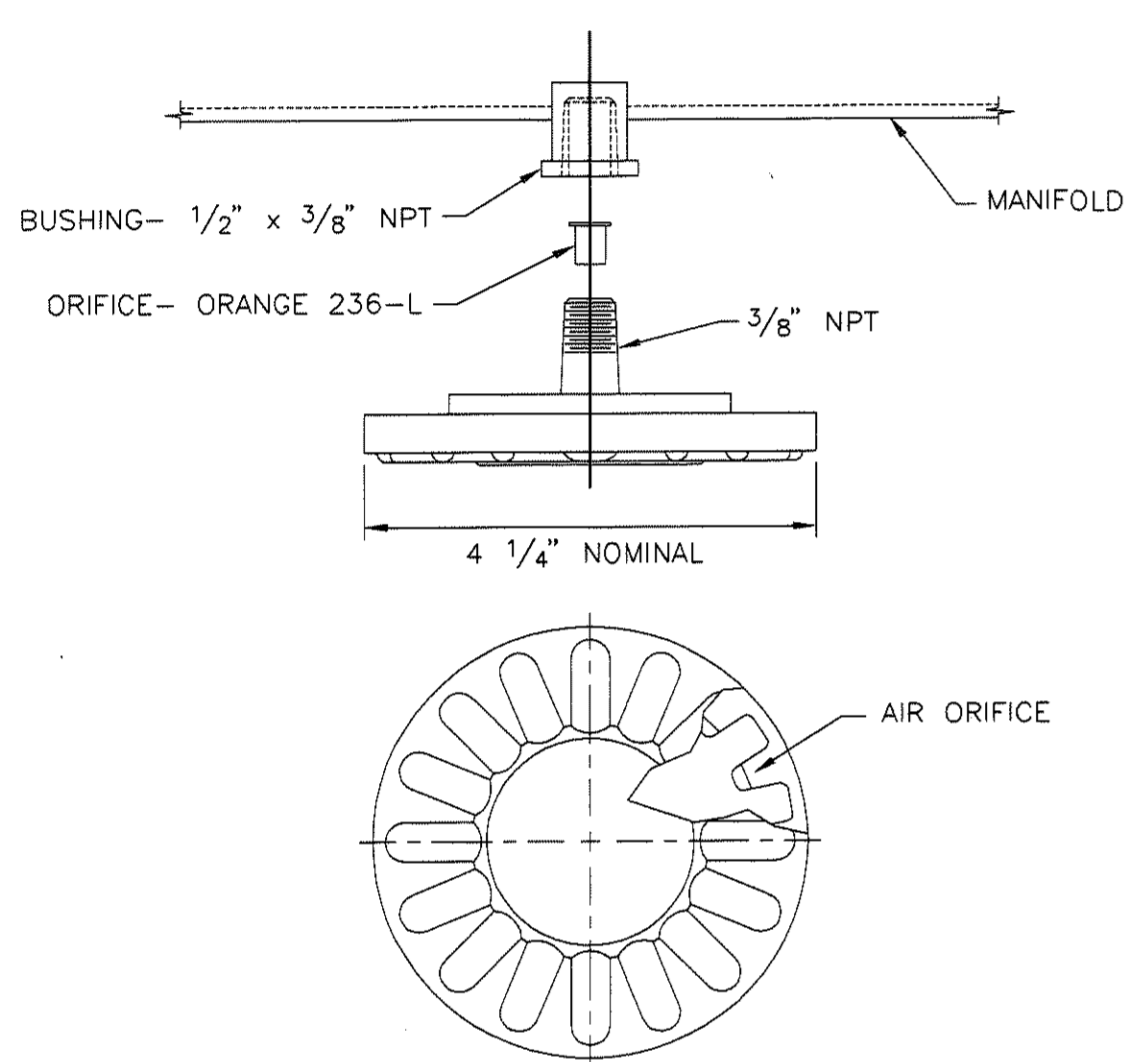


**CONTINUOUS PURGE- FLEXCAP DIFFUSER
DETAIL 5**

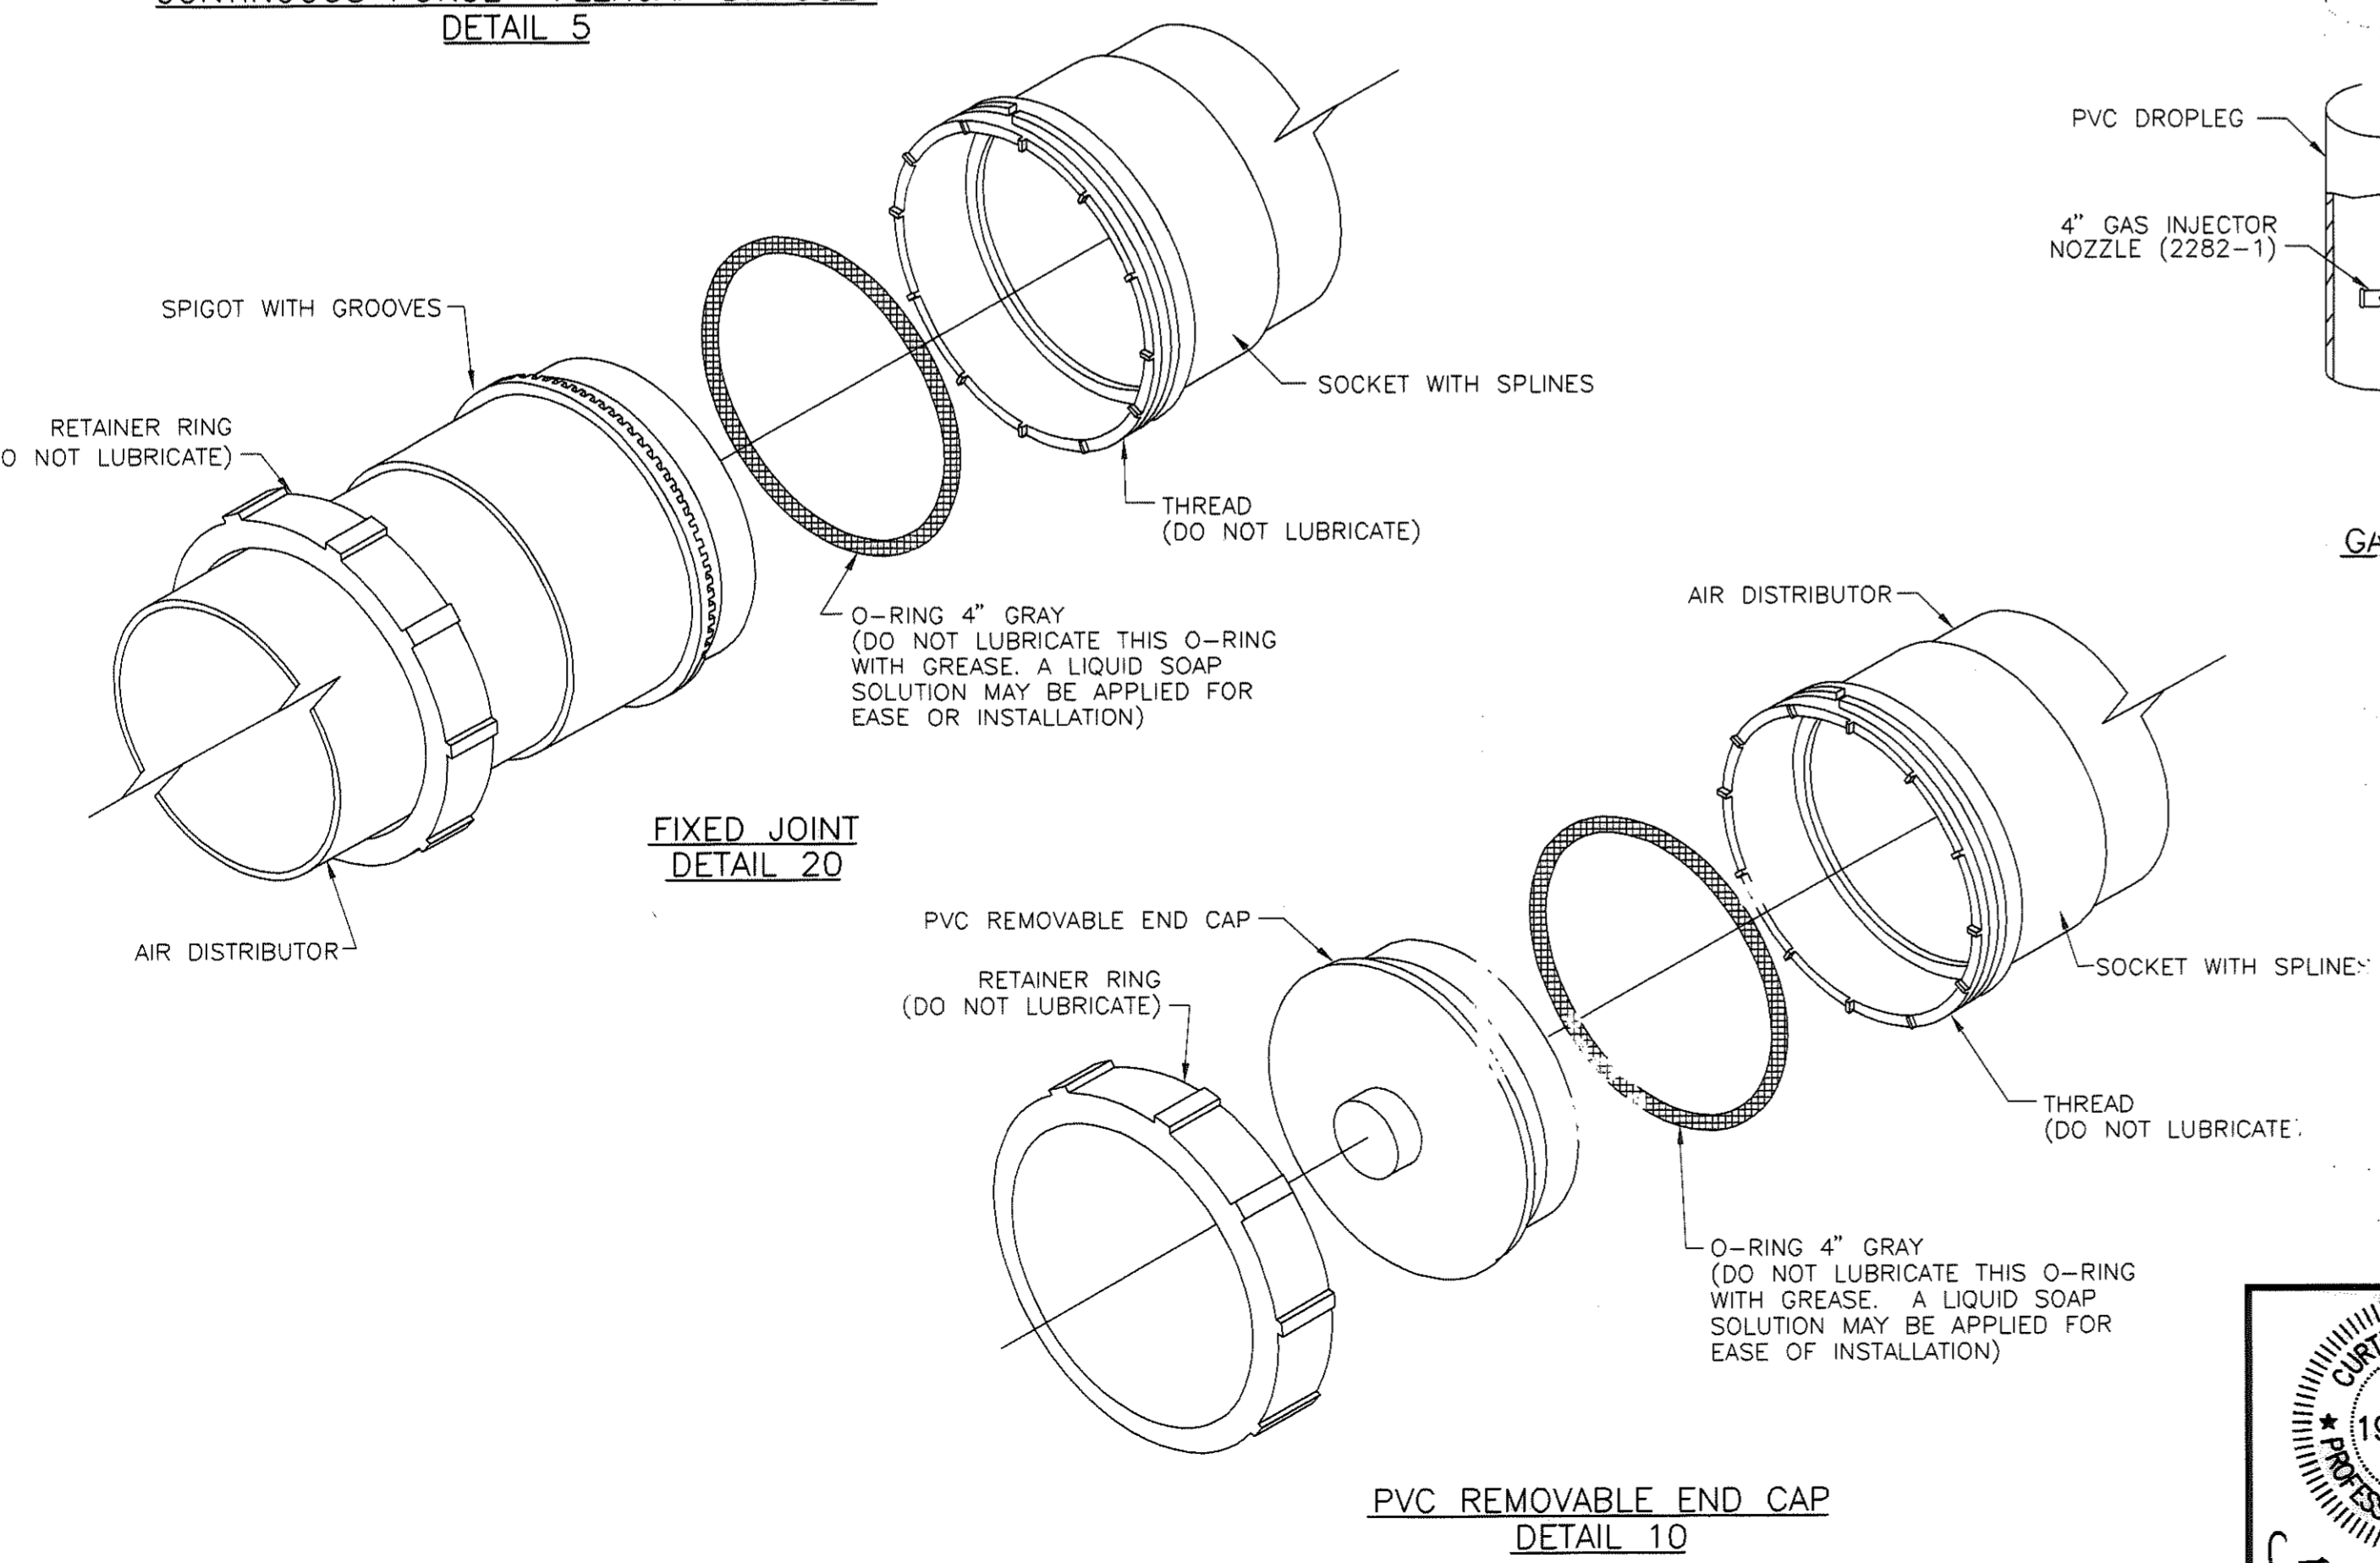


**FIXED JOINT
DETAIL 20**

**PVC REMOVABLE END CAP
DETAIL 10**

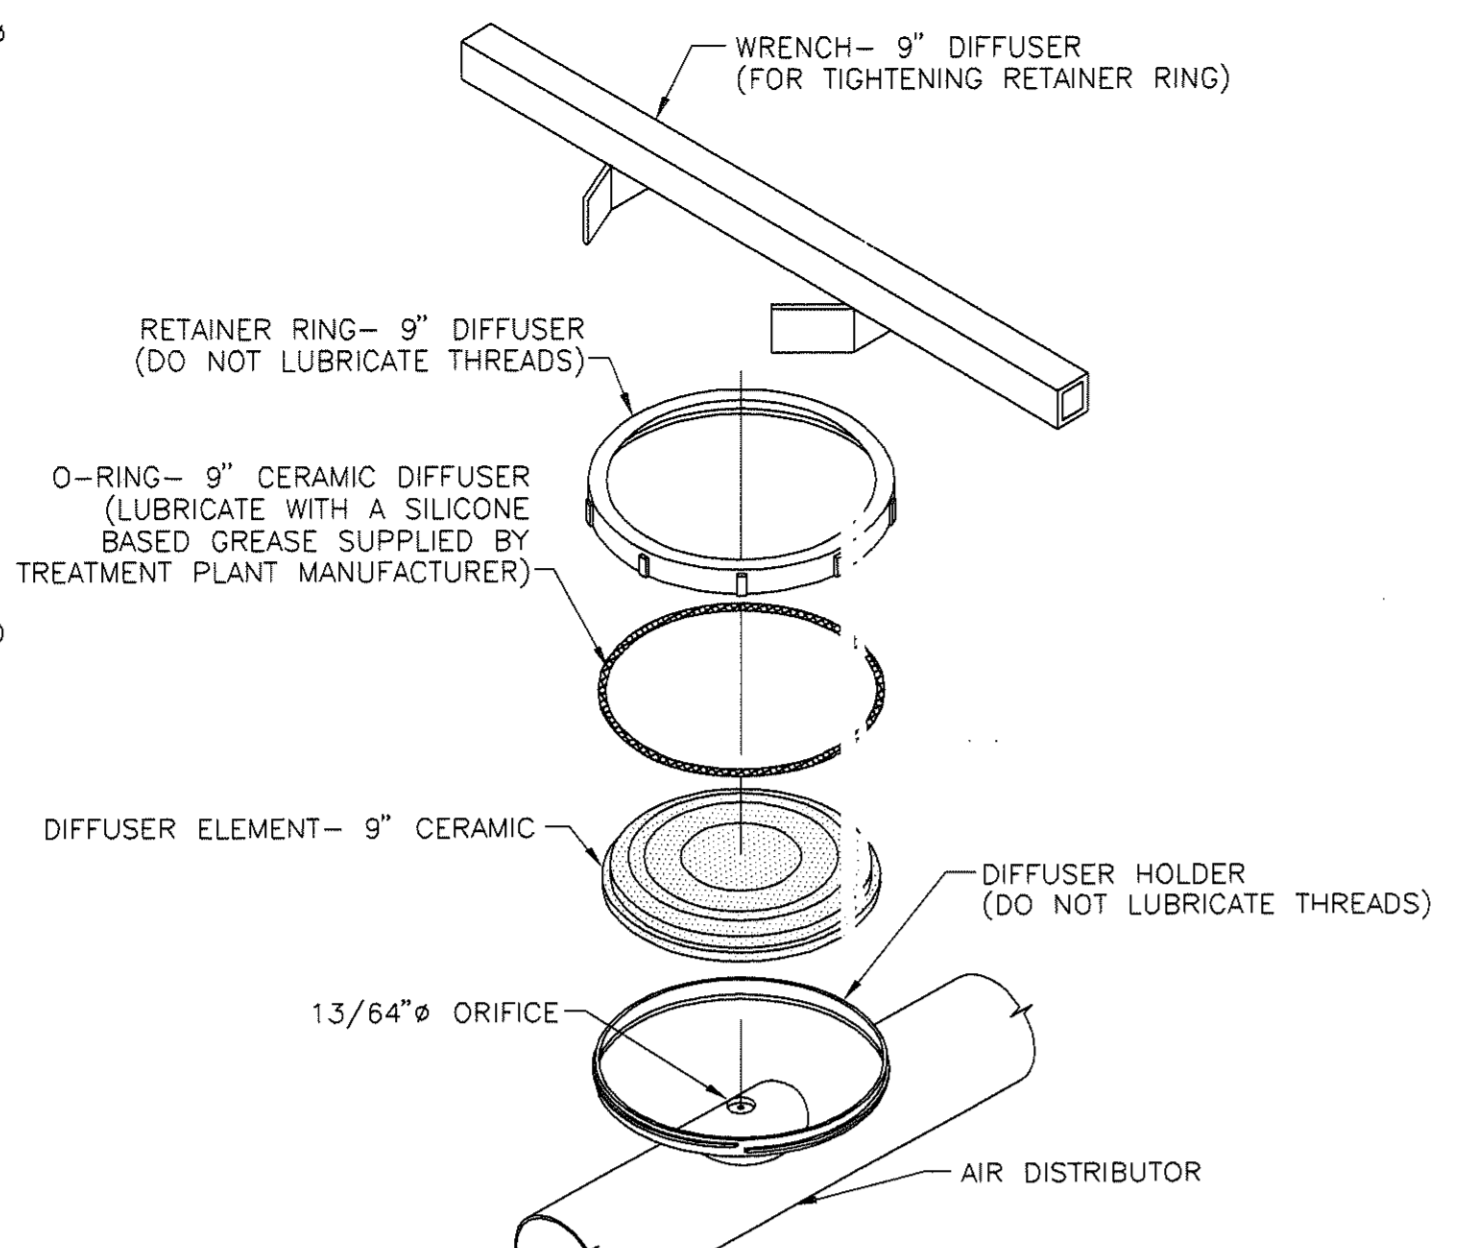


(9\"/>

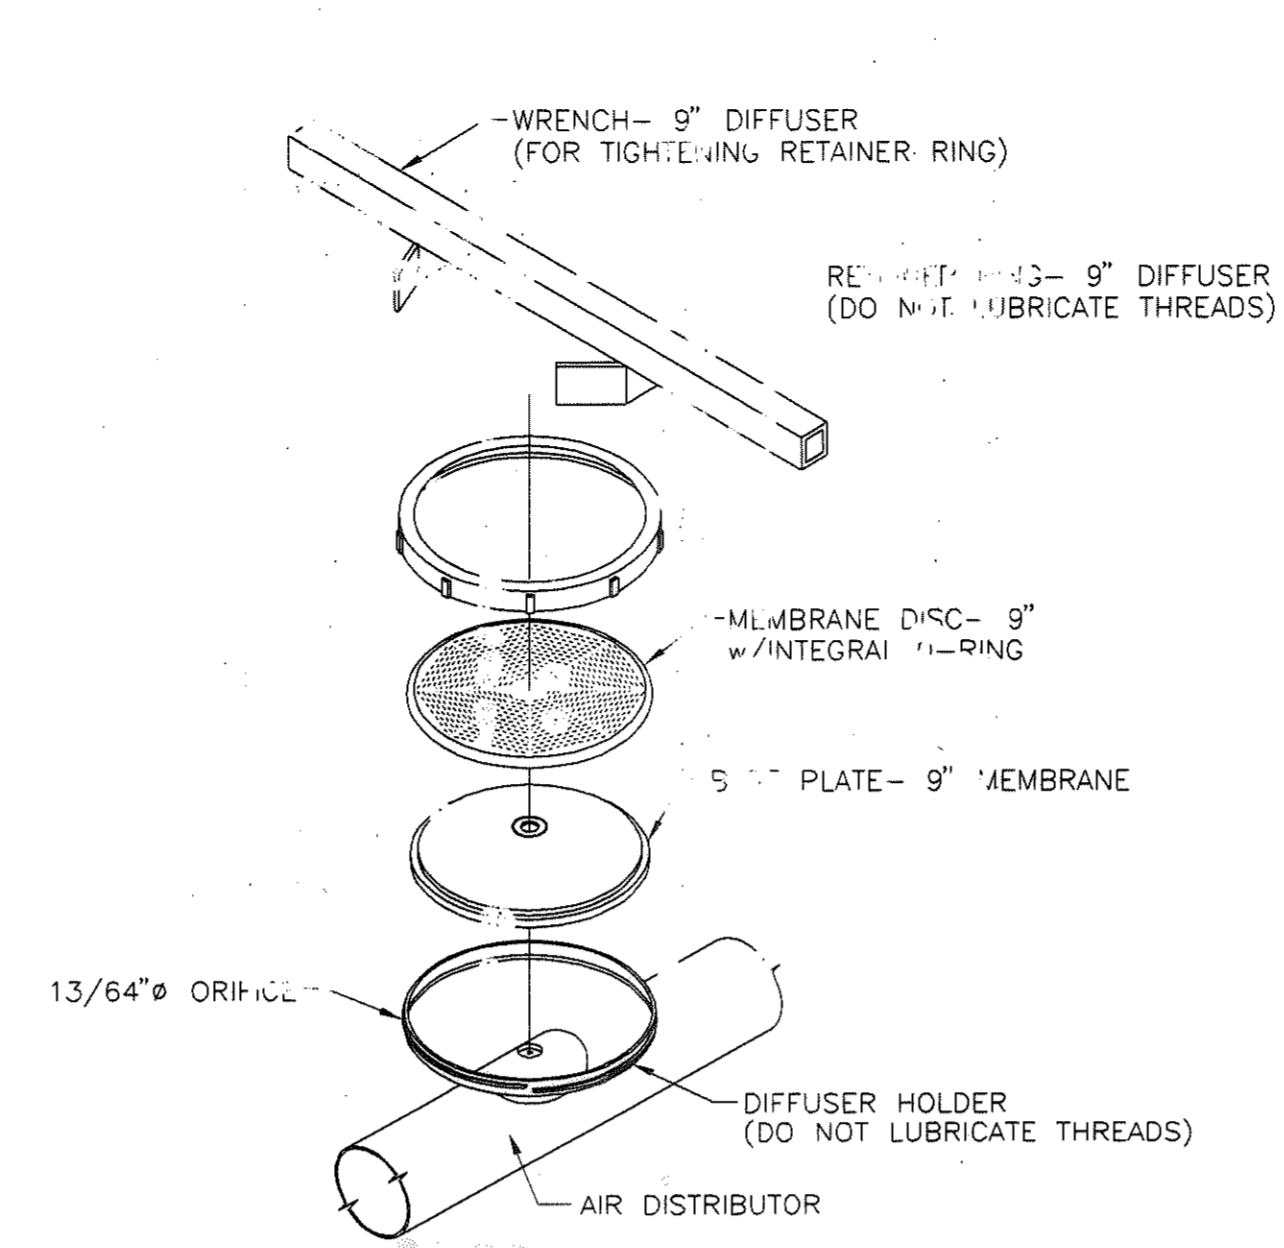


9\"/>


APPLY A VERY LIGHT COATING OF
SILICONE BASED GREASE (SUPPLIED BY
TREATMENT PLANT MANUFACTURER)
TO THE UNDERSIDE OF THE TOP
SEALING SURFACE OF THE RETAINING RING.

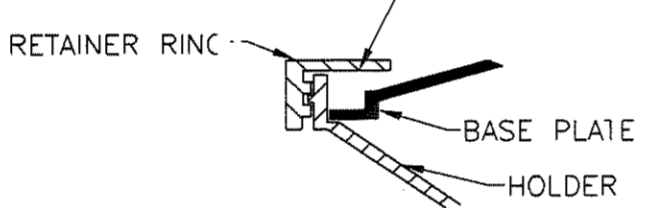


LUBRICATION DETAIL

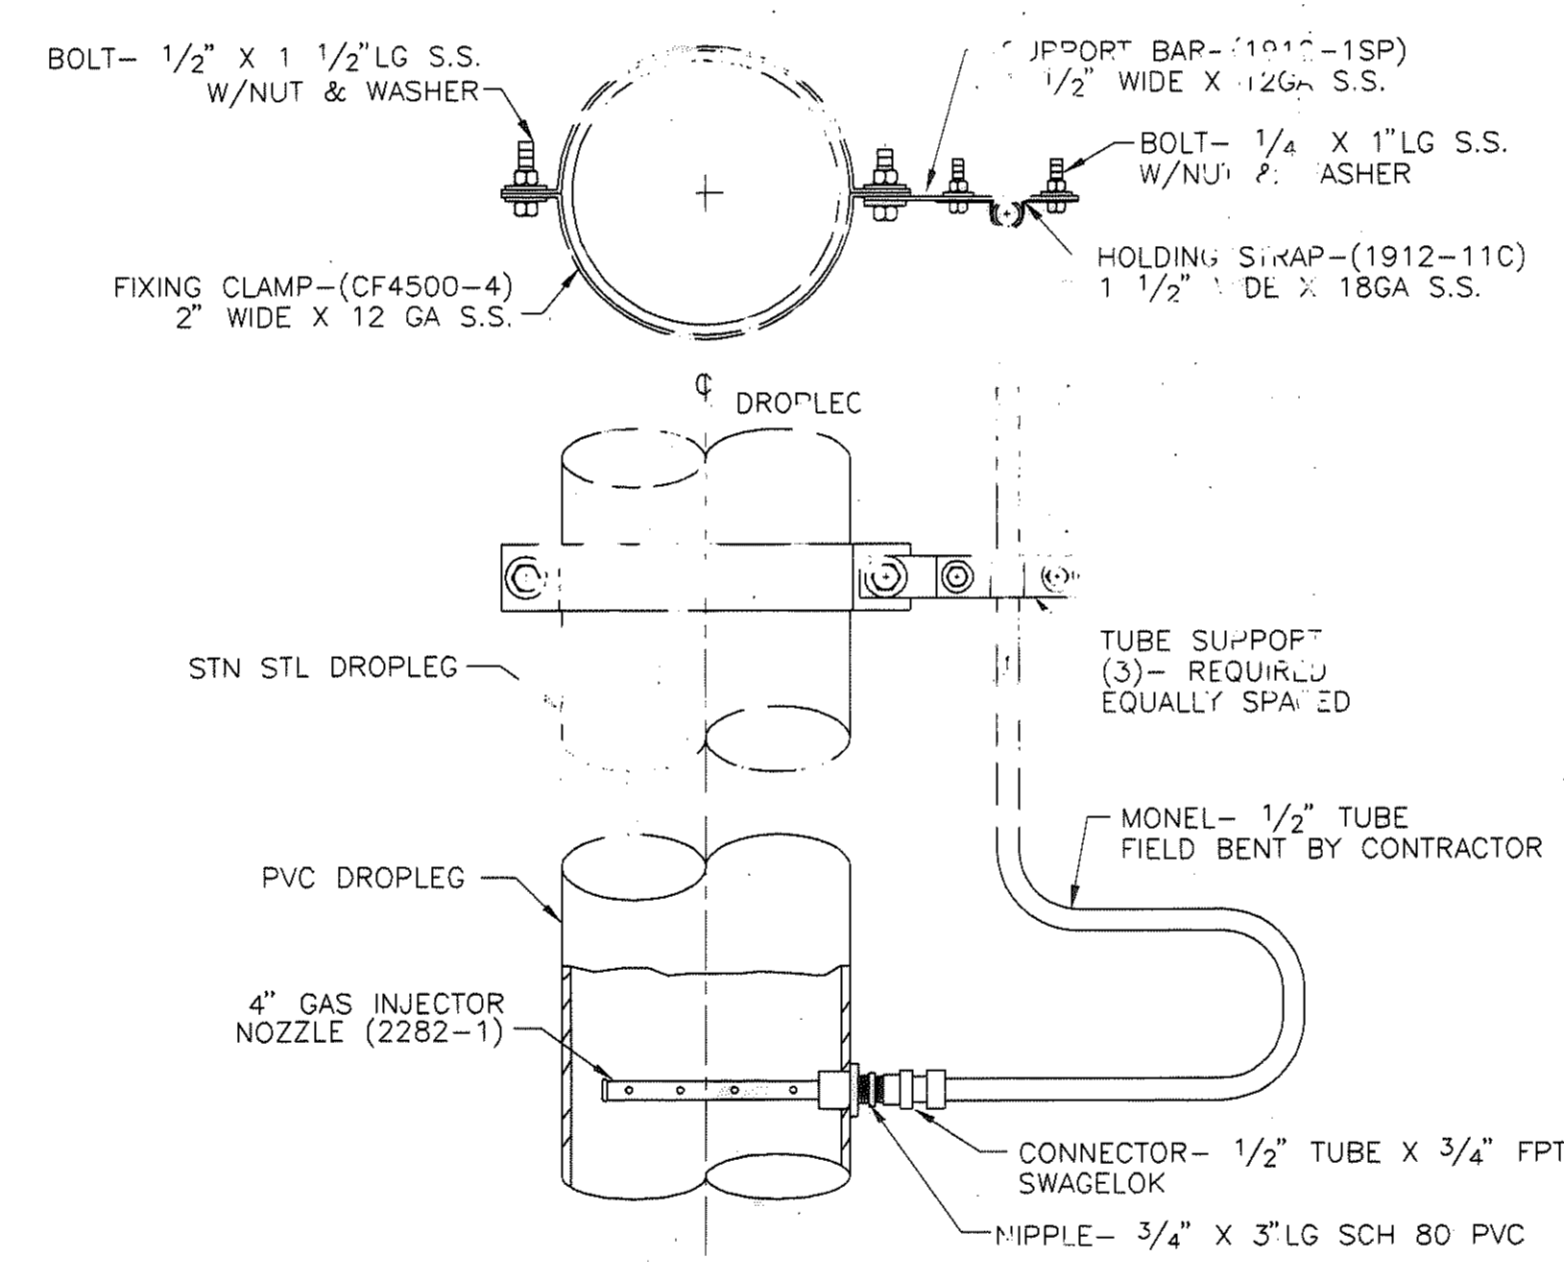


**GAS INJECTOR ASSEMBLY
DETAIL 6**

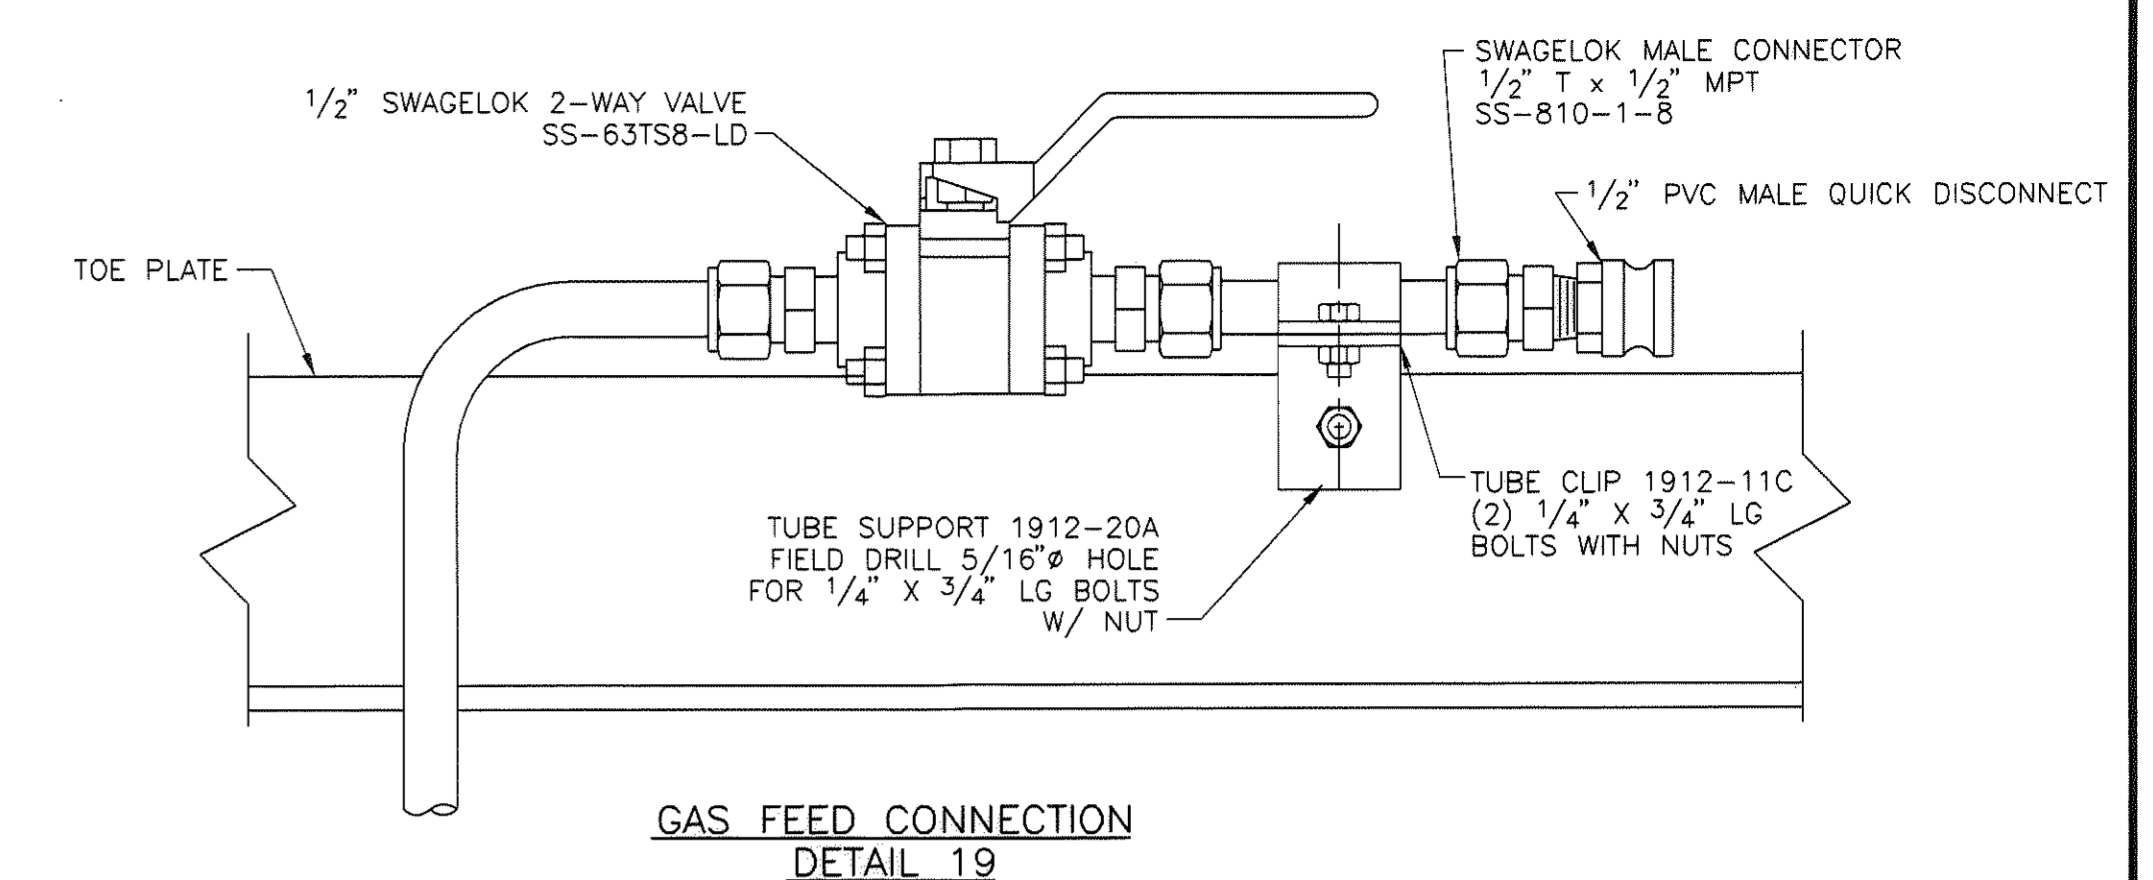


**GAS FEED CONNECTION
DETAIL 19**

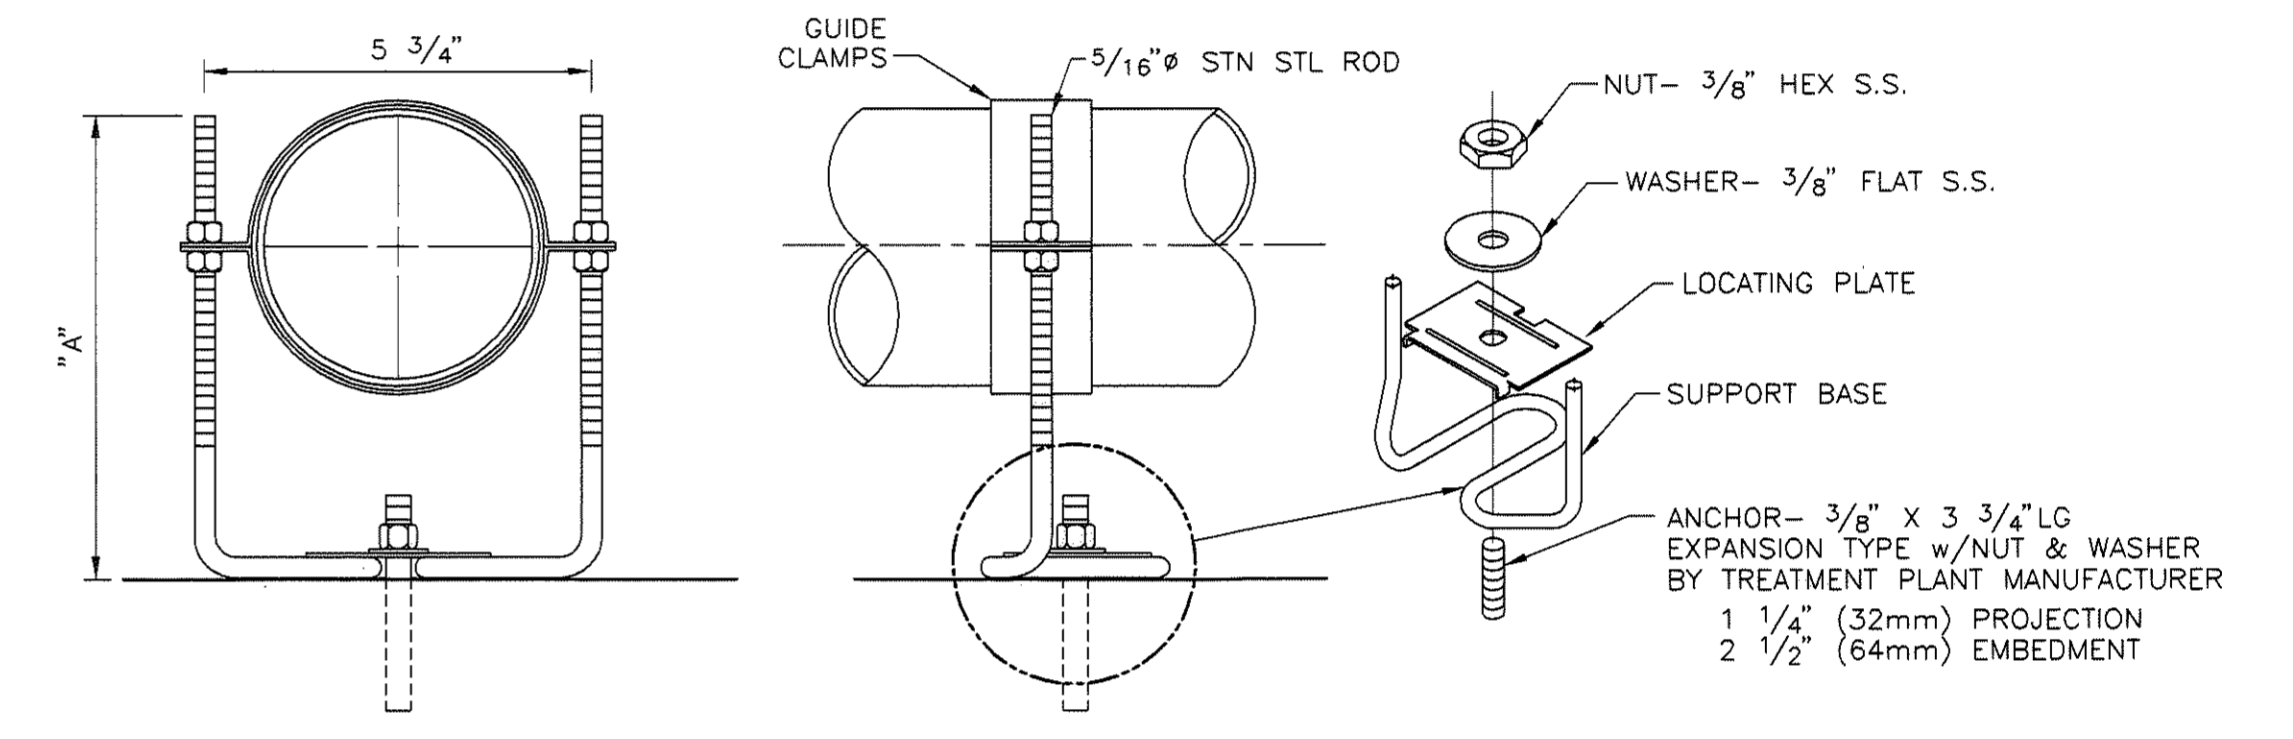

**GUIDE SUPPORT
DETAIL 16
2346-2SP**

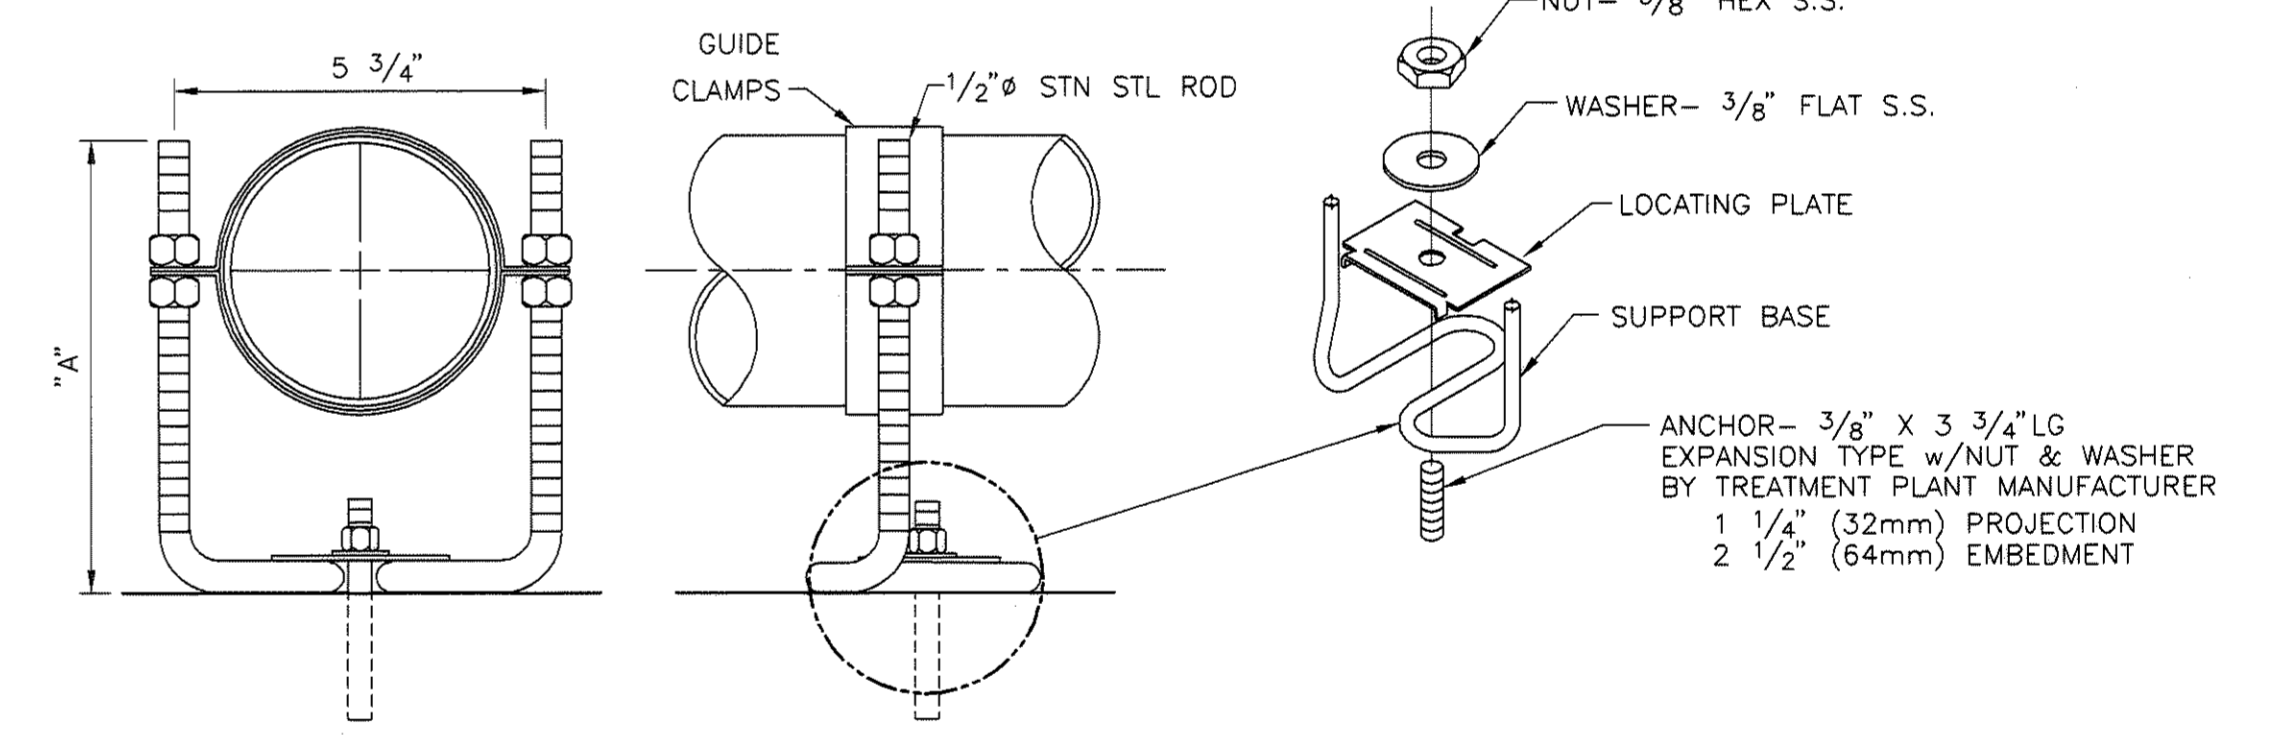


**GUIDE SUPPORT
DETAIL 17
2354-2SP**

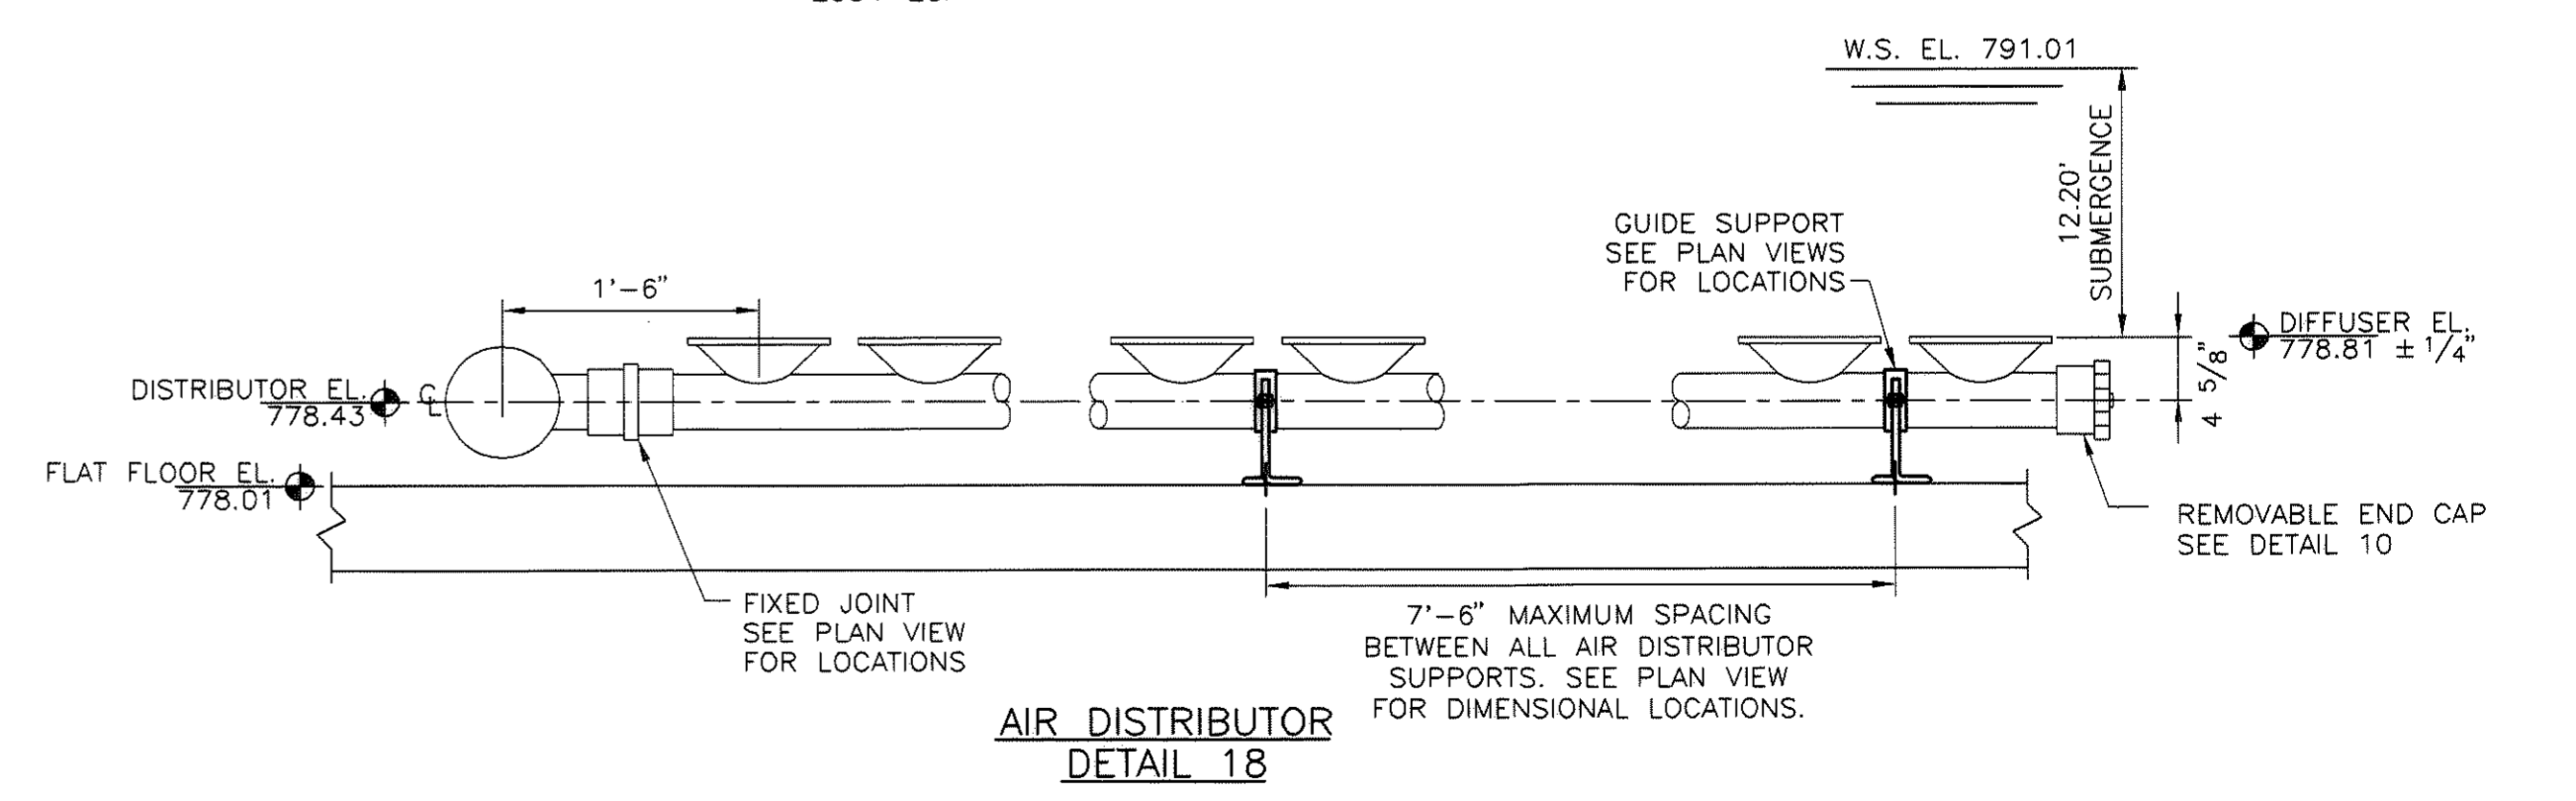

**AIR DISTRIBUTOR
DETAIL 18**

REVISIONS - BUILT DRAWING
THIS DRAWING IS IN REVISION ACCORDANCE
WITH NOTES ON RECORD DRAWINGS FURNISHED BY
THE CONTRACTOR WITH EXCEPTED CHANGE
ORDERS TO THE BEST OF OUR KNOWLEDGE AND
BELIEF THIS DRAWING SHOWS ALL BUILT
CONDITIONS.
COMMONWEALTH
ENGINEERS, INC.
REVISED DATE: 3/06
BY: JCW, UK, BY: CWW

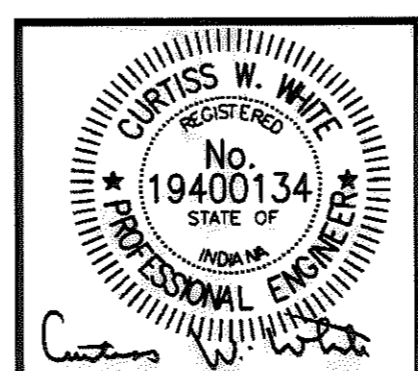


**COMMONWEALTH
ENGINEERS, INC.**

DRAWN BY: CB
DESIGNED BY: CWW
CHECKED BY: CWW
DATE: 12/03
JOB NO: S02119-02
SCALE: AS NOTED

SALAMONIE RESERVOIR
WASTEWATER TREATMENT PLANT IMPROVEMENTS PROJECT
PUBLIC WORKS PROJECT NO. E031410M
TREATMENT PLANT PLAN AND SECTIONS


DRAWING NO.
9
9 OF 52

CONNECTING BOX PART NO. 1902-1
 FOR ASSEMBLY OF MOUNTING BRACKET
 SEE DETAIL 12

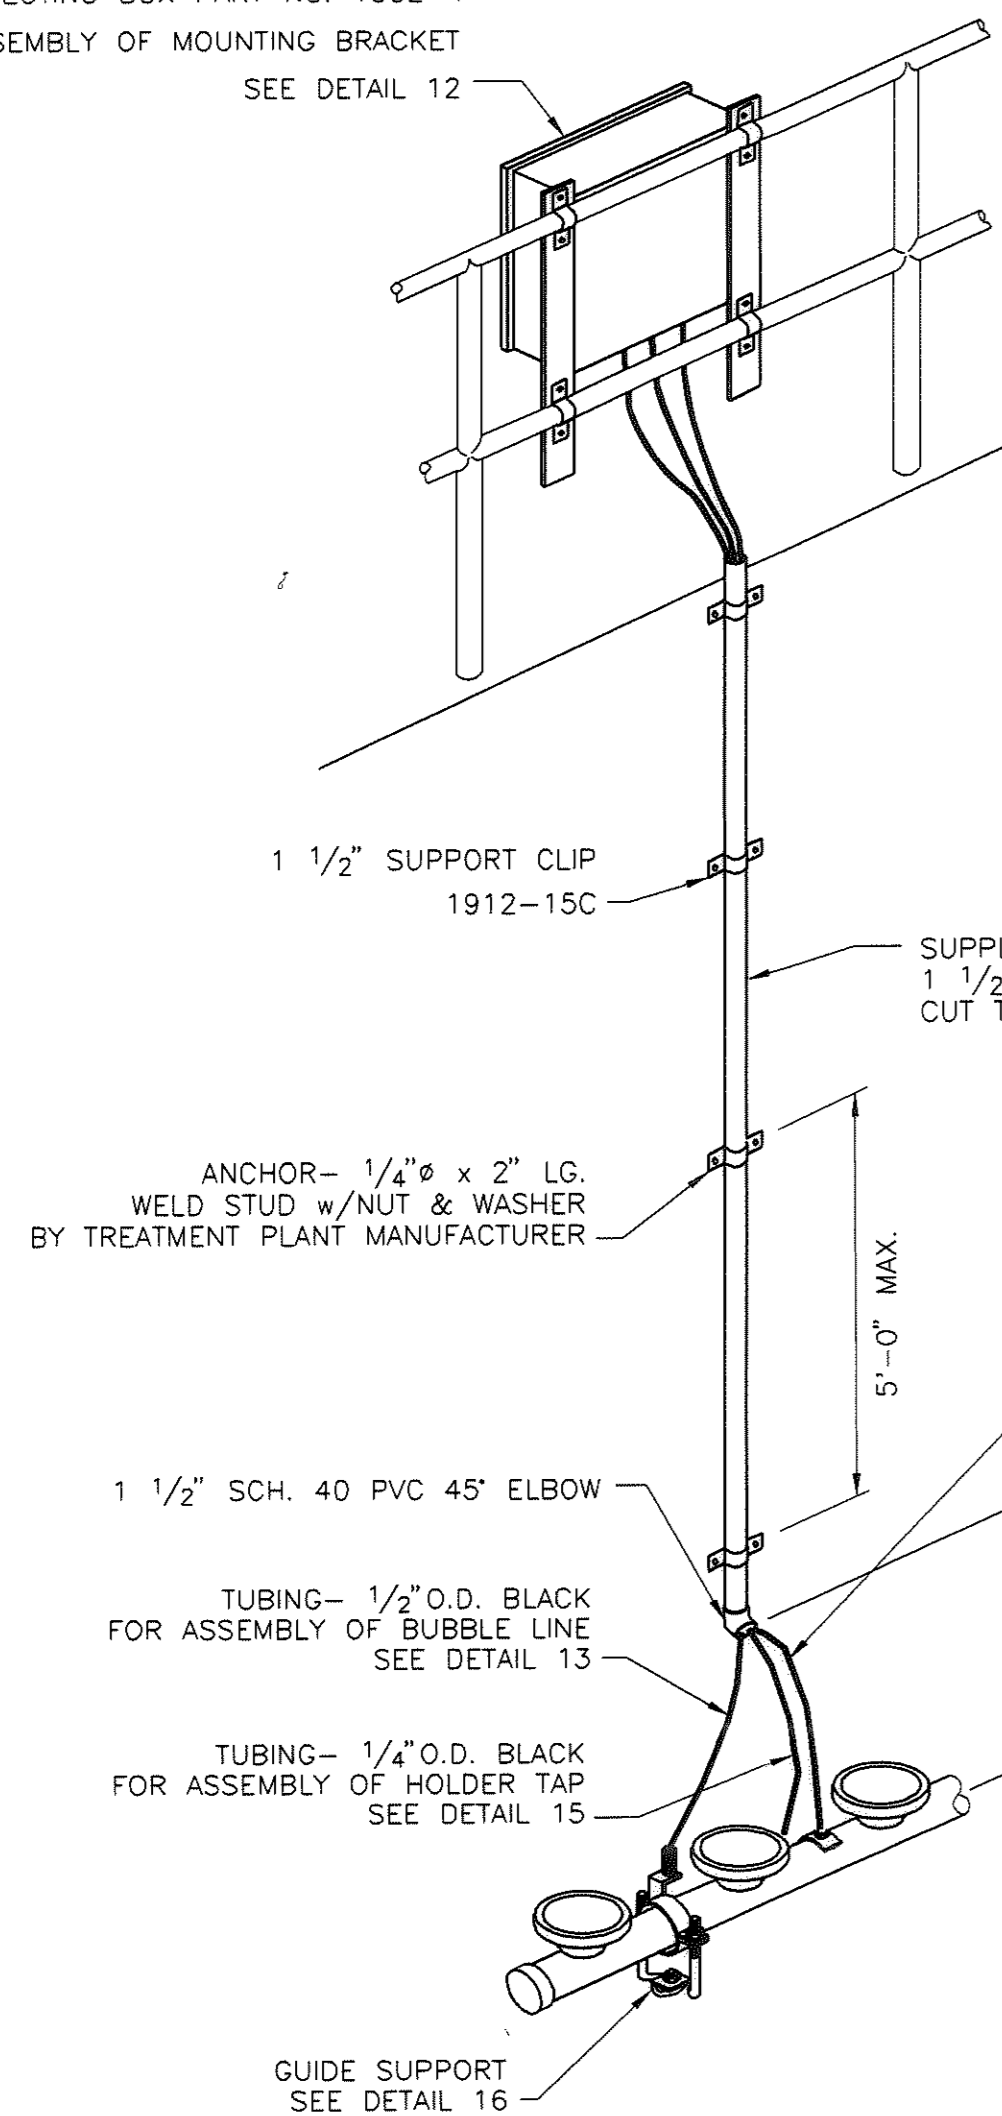


**PRESSURE MONITORING ASSEMBLY
 DETAIL 11**


ORIENTATION SHOWN IS A GENERAL REPRESENTATION OF EQUIPMENT SUPPLIED BY TREATMENT PLANT MANUFACTURER. ACTUAL ORIENTATION OF AIR DISTRIBUTORS AND MANIFOLDS MAY VARY.

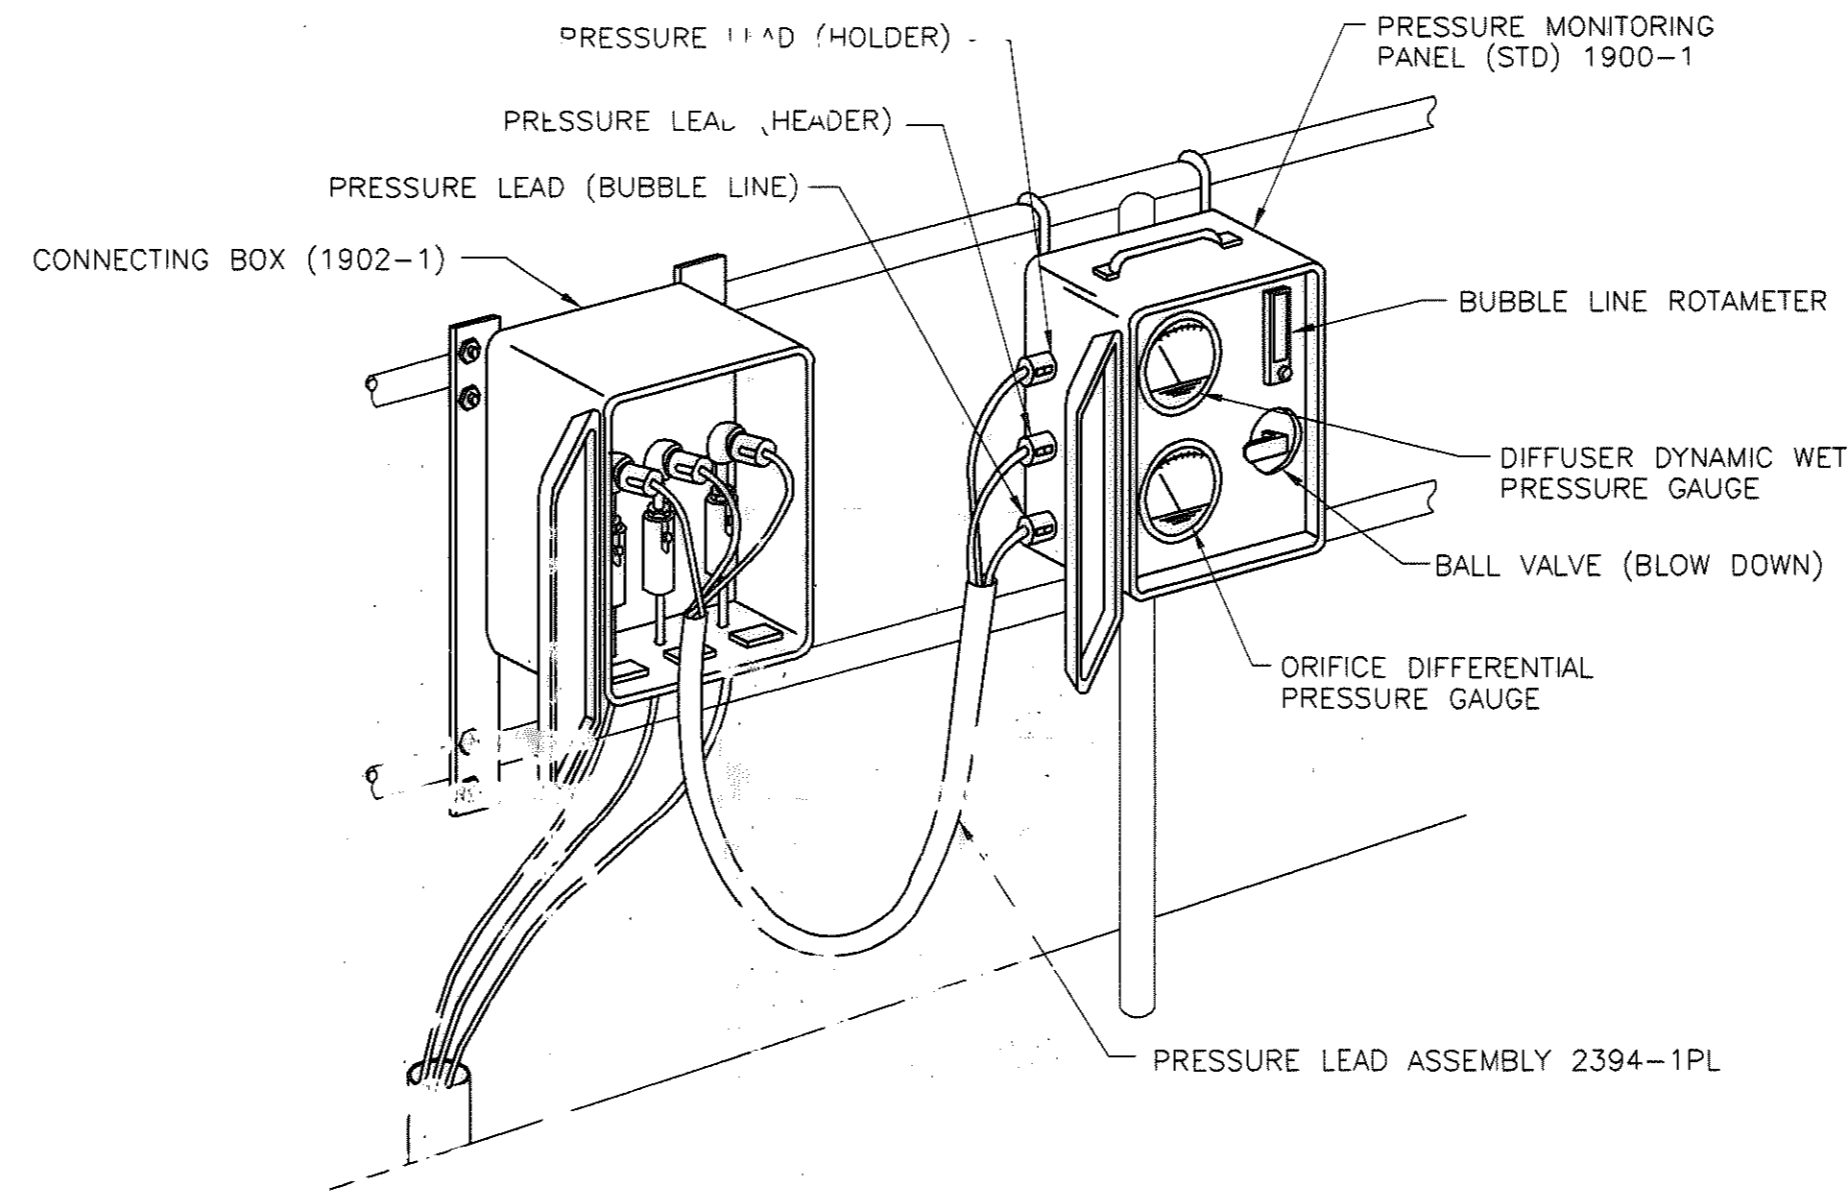


**PRESSURE MONITORING PANEL (STD) CONNECTION
 DETAIL 3**

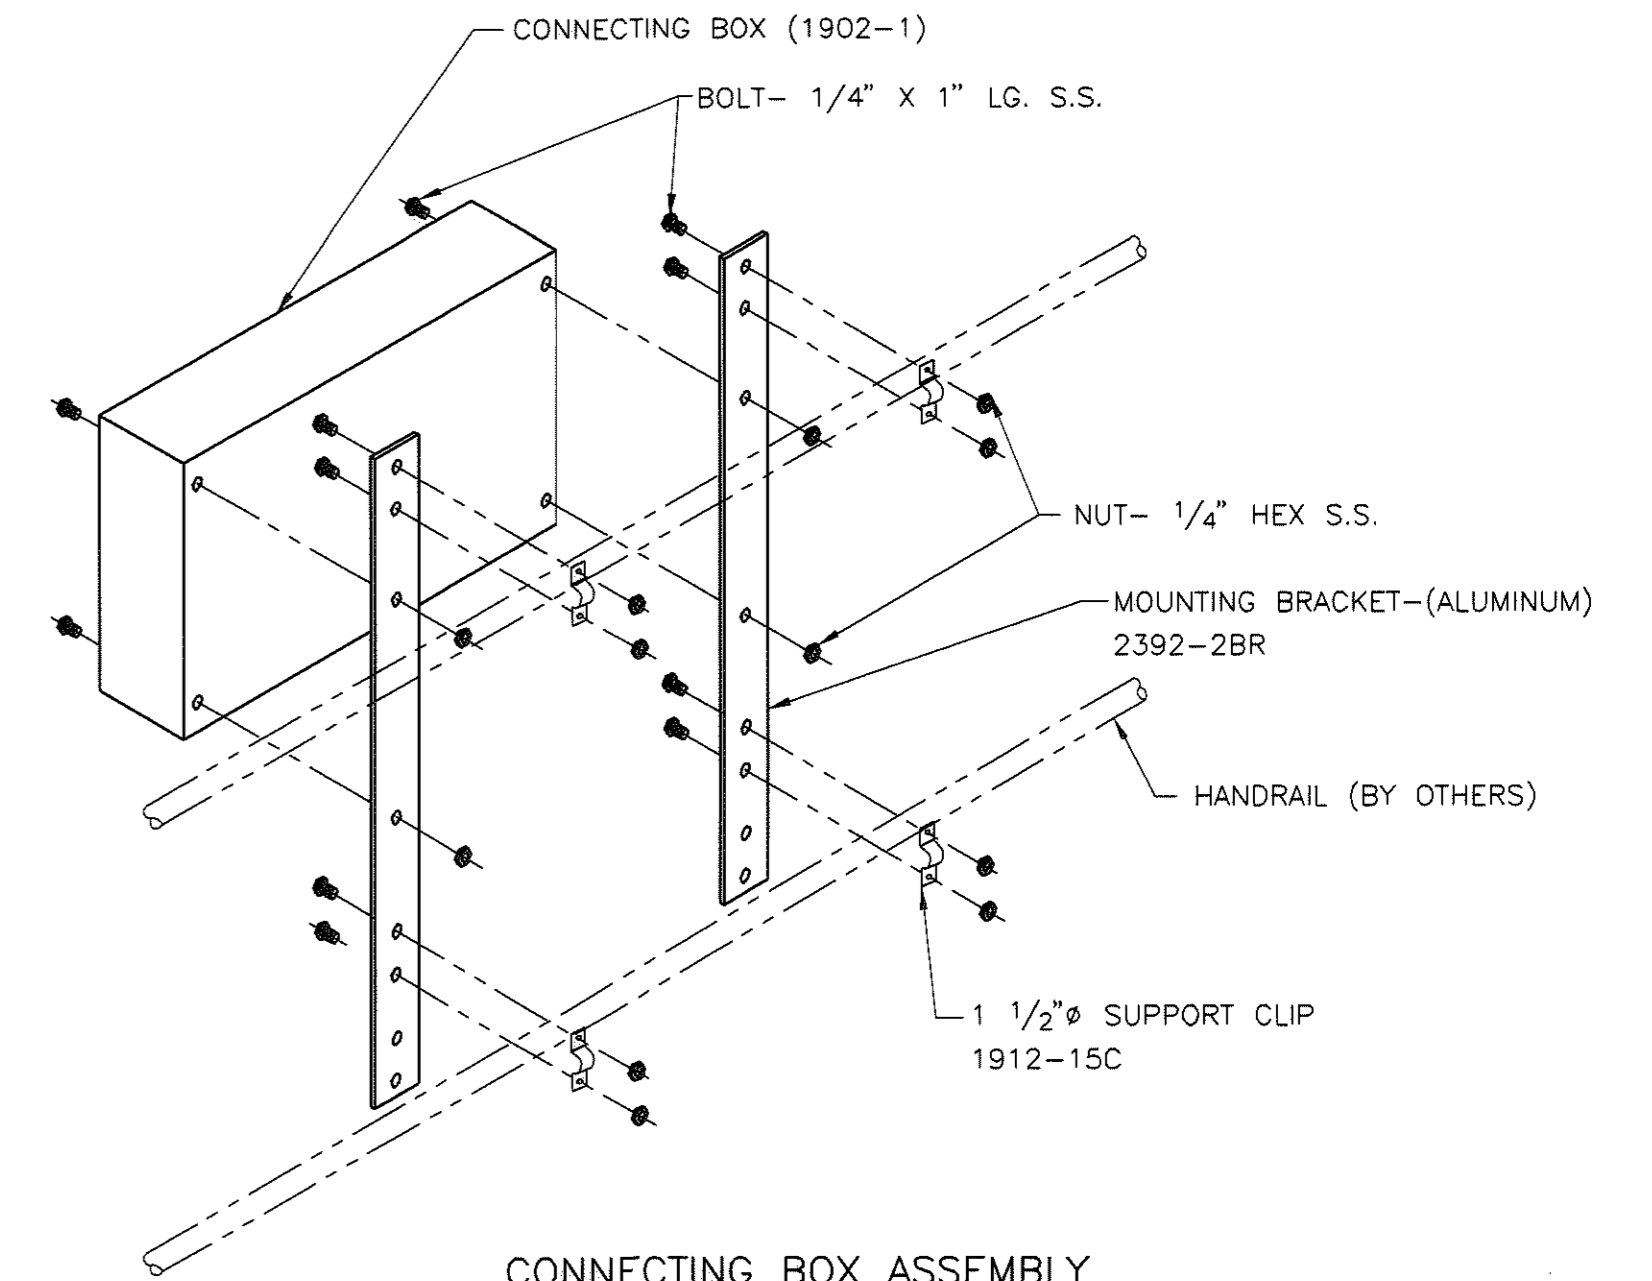


**CONNECTING BOX ASSEMBLY
 DETAIL 12**

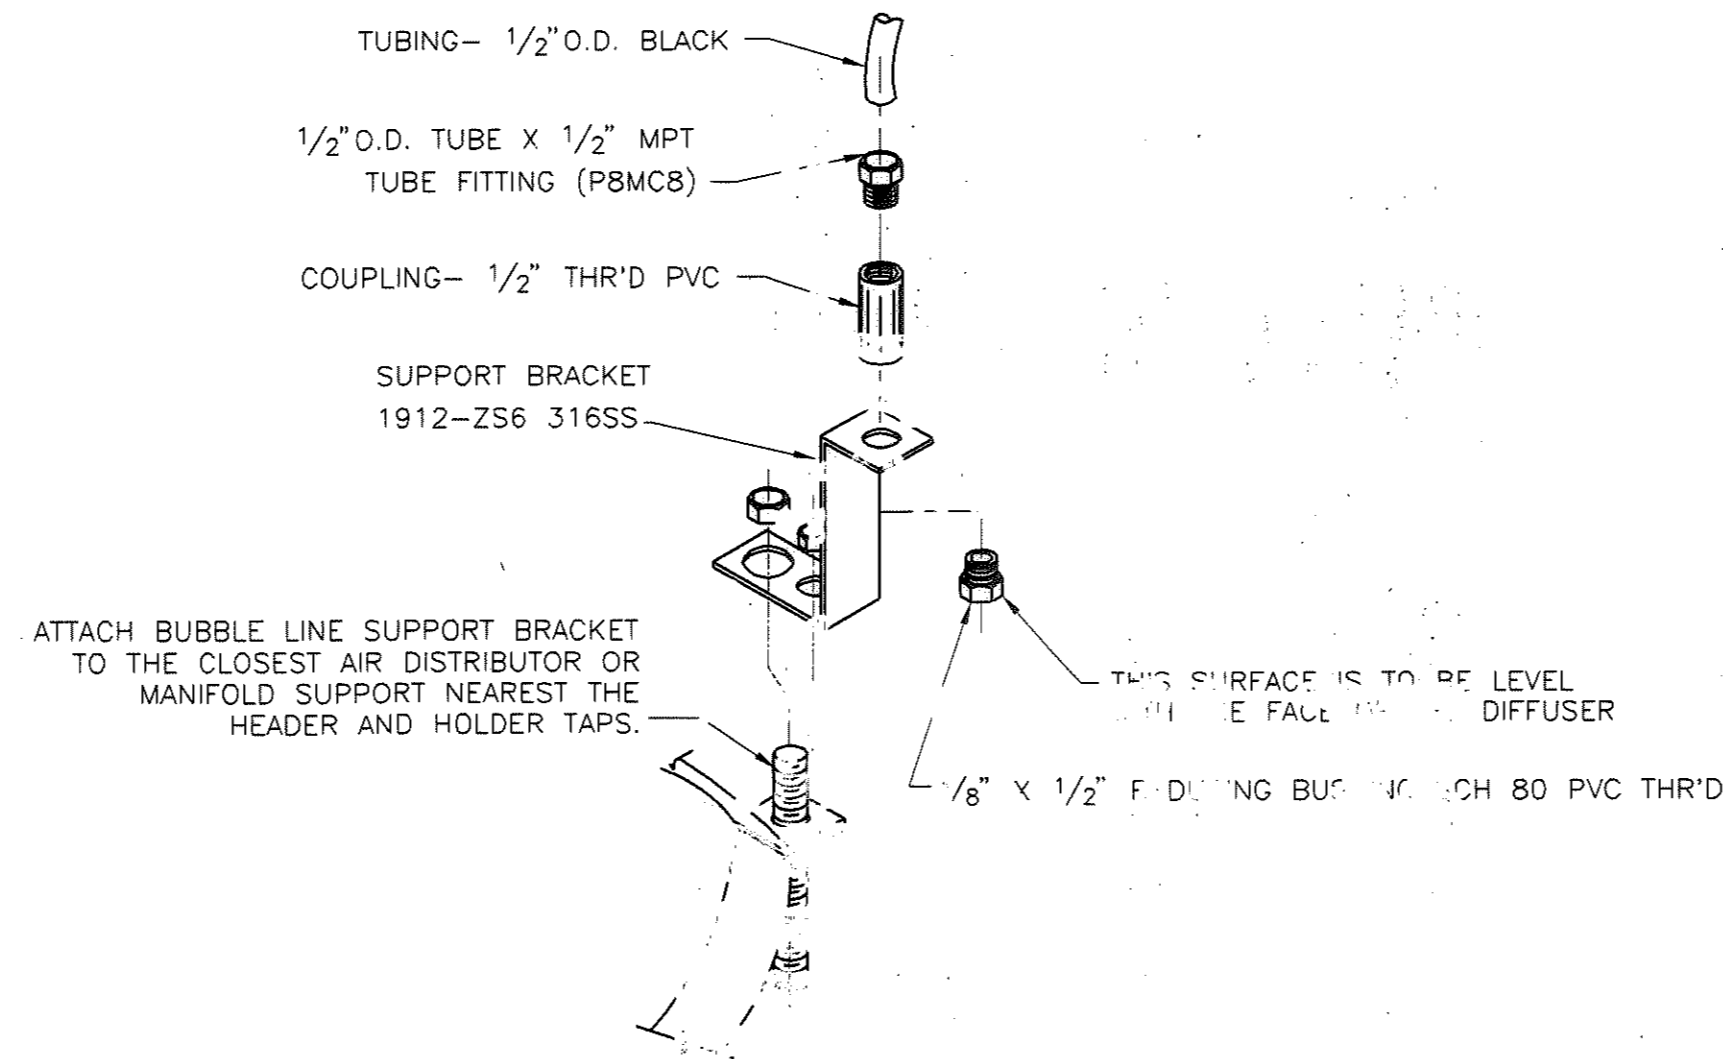

**BUBBLE LINE ASSEMBLY
 DETAIL 13**

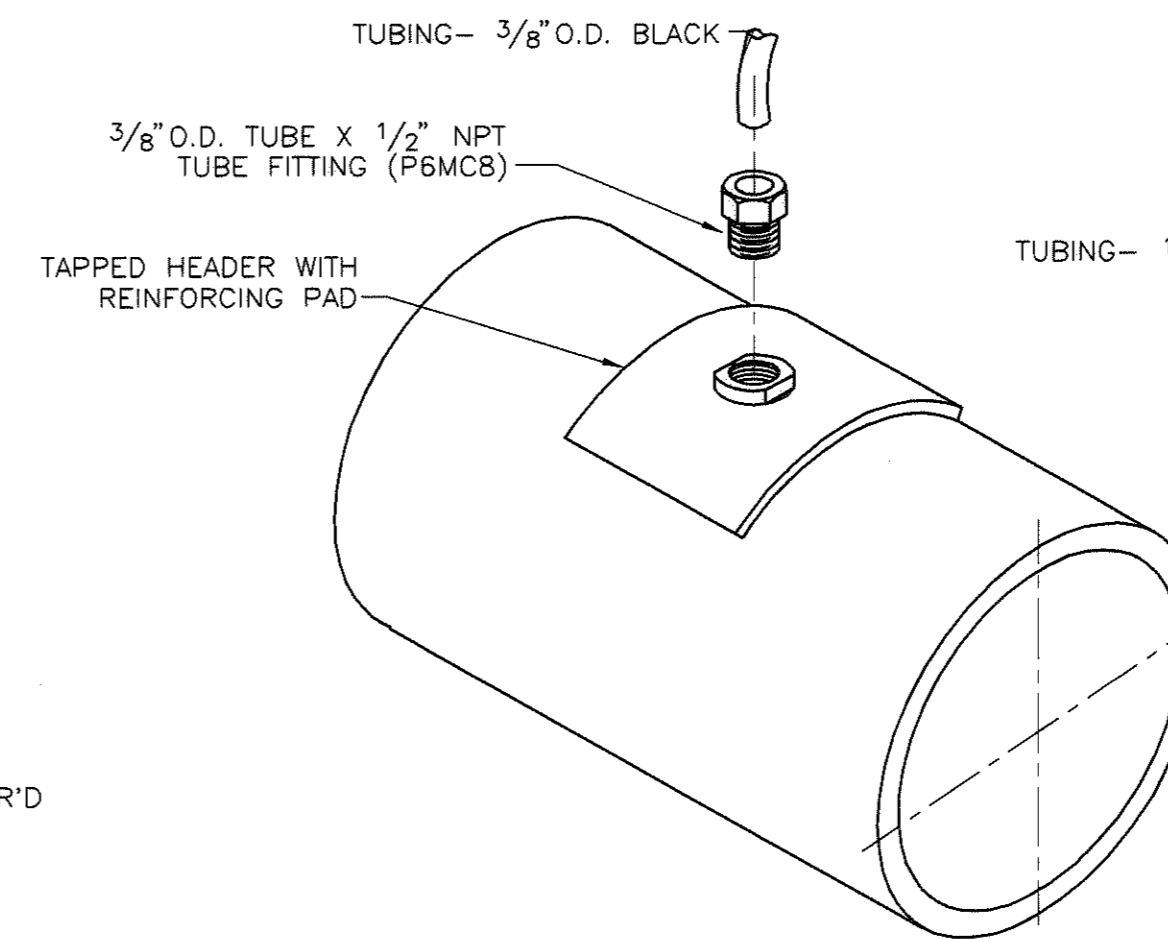


**HEADER TAP ASSEMBLY
 DETAIL 14**

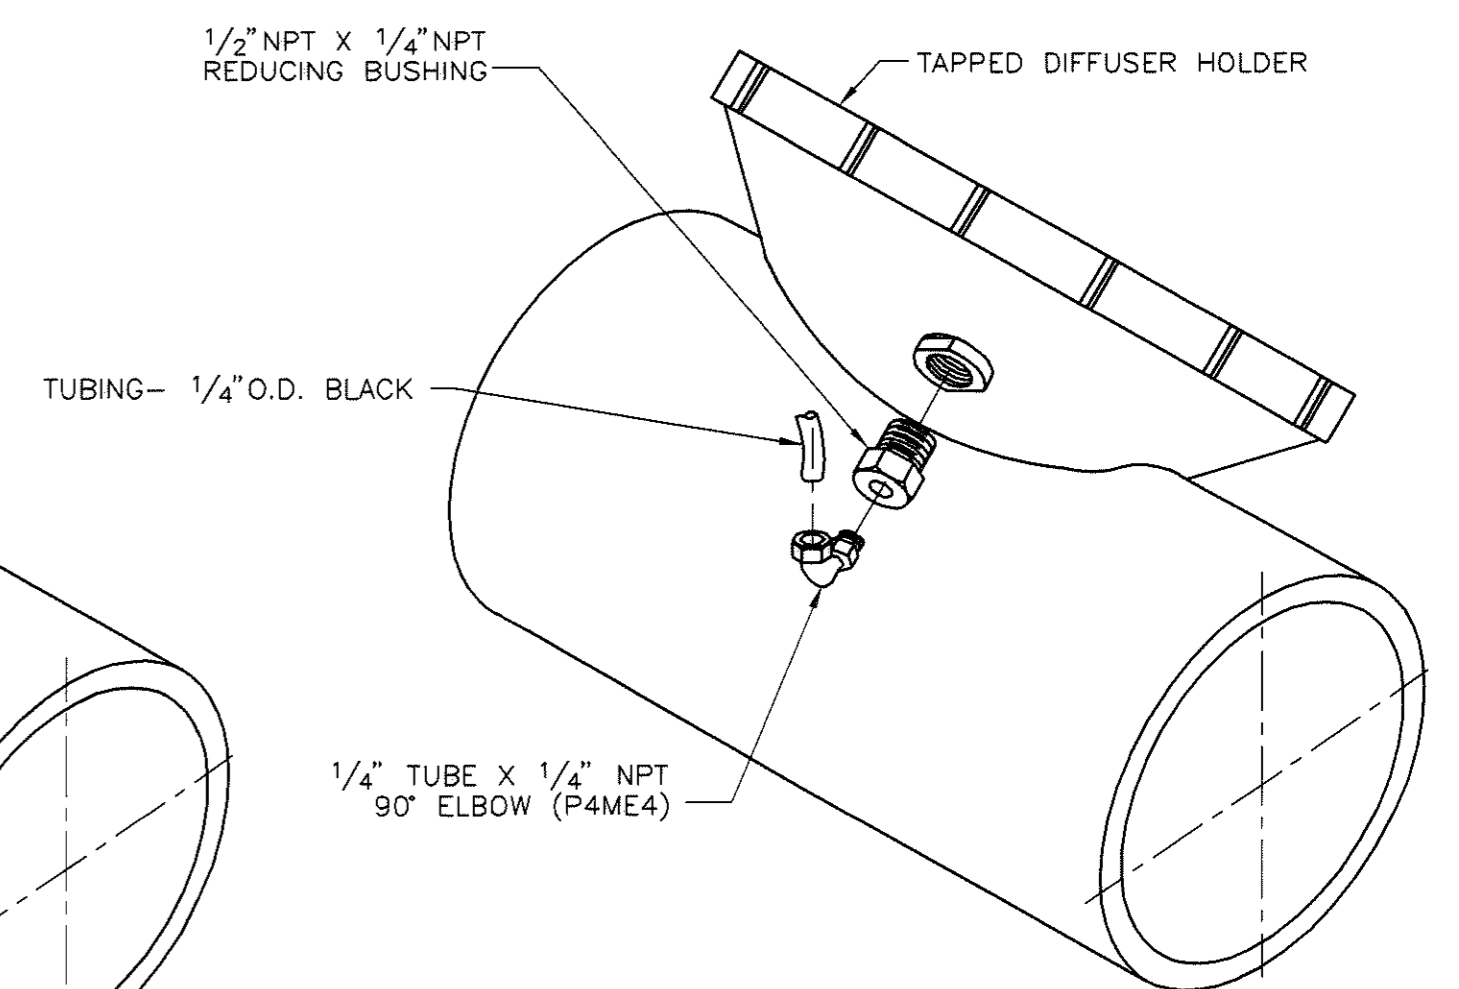

**HOLDER TAP ASSEMBLY
 DETAIL 15**

REVISED "AS-BUILT" DRAWING
 THIS DRAWING HAS BEEN REVISED IN ACCORDANCE WITH NOTES ON "RECORD DRAWINGS" FURNISHED BY THE CONTRACTOR AND WITH EXECUTED CHANGE ORDERS. TO THE BEST OF OUR KNOWLEDGE AND BELIEF, THIS DRAWING SHOWS ACTUAL "AS-BUILT" CONDITIONS.
 COMMONWEALTH ENGINEERS, INC.
 REVISED DATE: 10/06
 BY: JCW, CK, BY: CWW

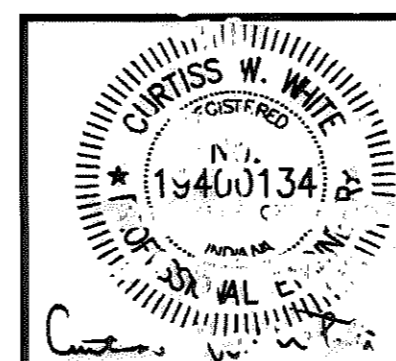


COMMONWEALTH ENGINEERS, INC.


DRAWN BY: CB
 DESIGNED BY: CWW
 CHECKED BY: CWW
 DATE: 12/03
 JOB NO: S02119-02
 SCALE: AS NOTED

SALAMONIE RESERVOIR
 WASTEWATER TREATMENT PLANT IMPROVEMENTS PROJECT
 PUBLIC WORKS PROJECT NO. E031410M
 TREATMENT PLANT PLAN AND SECTIONS


DRAWING NO.
10
 10 OF 52

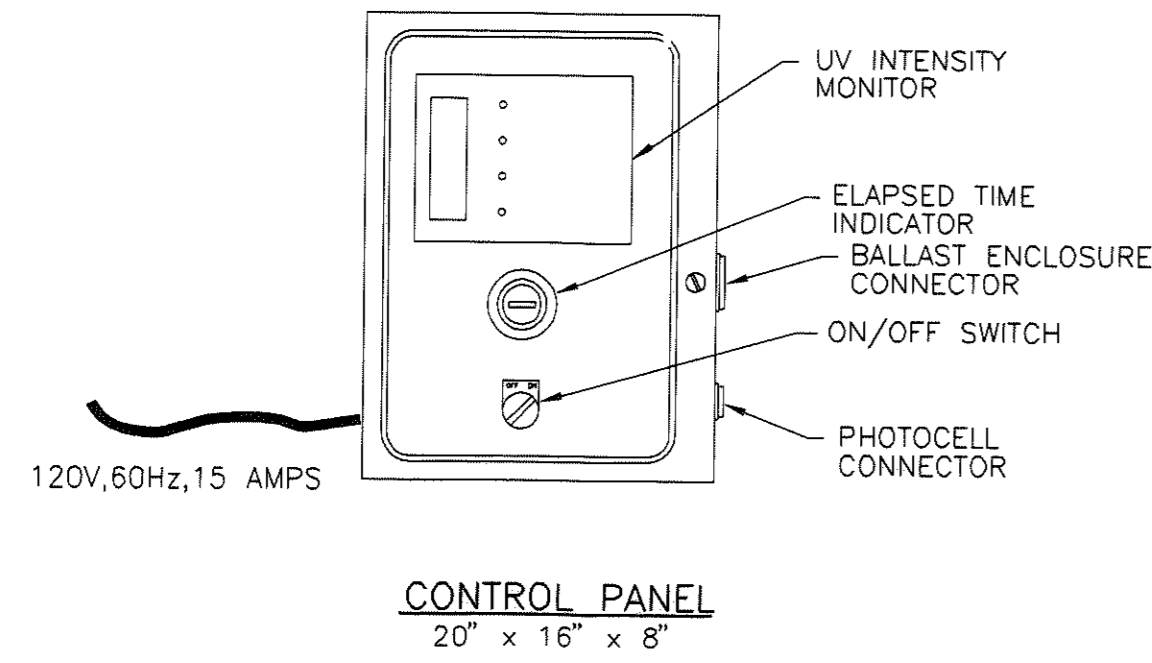


CONTROL PANEL
 20" x 16" x 8"

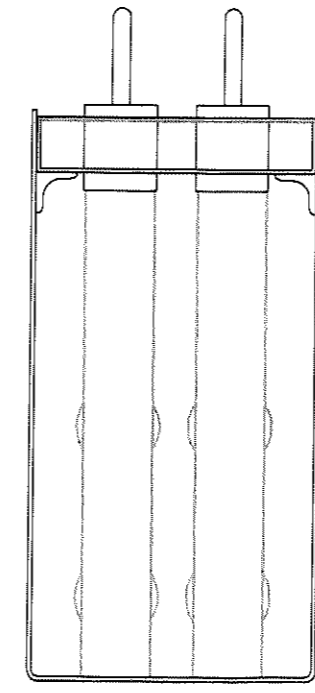


SECTION B-B
 SCALE: 1/2" = 1'-0"

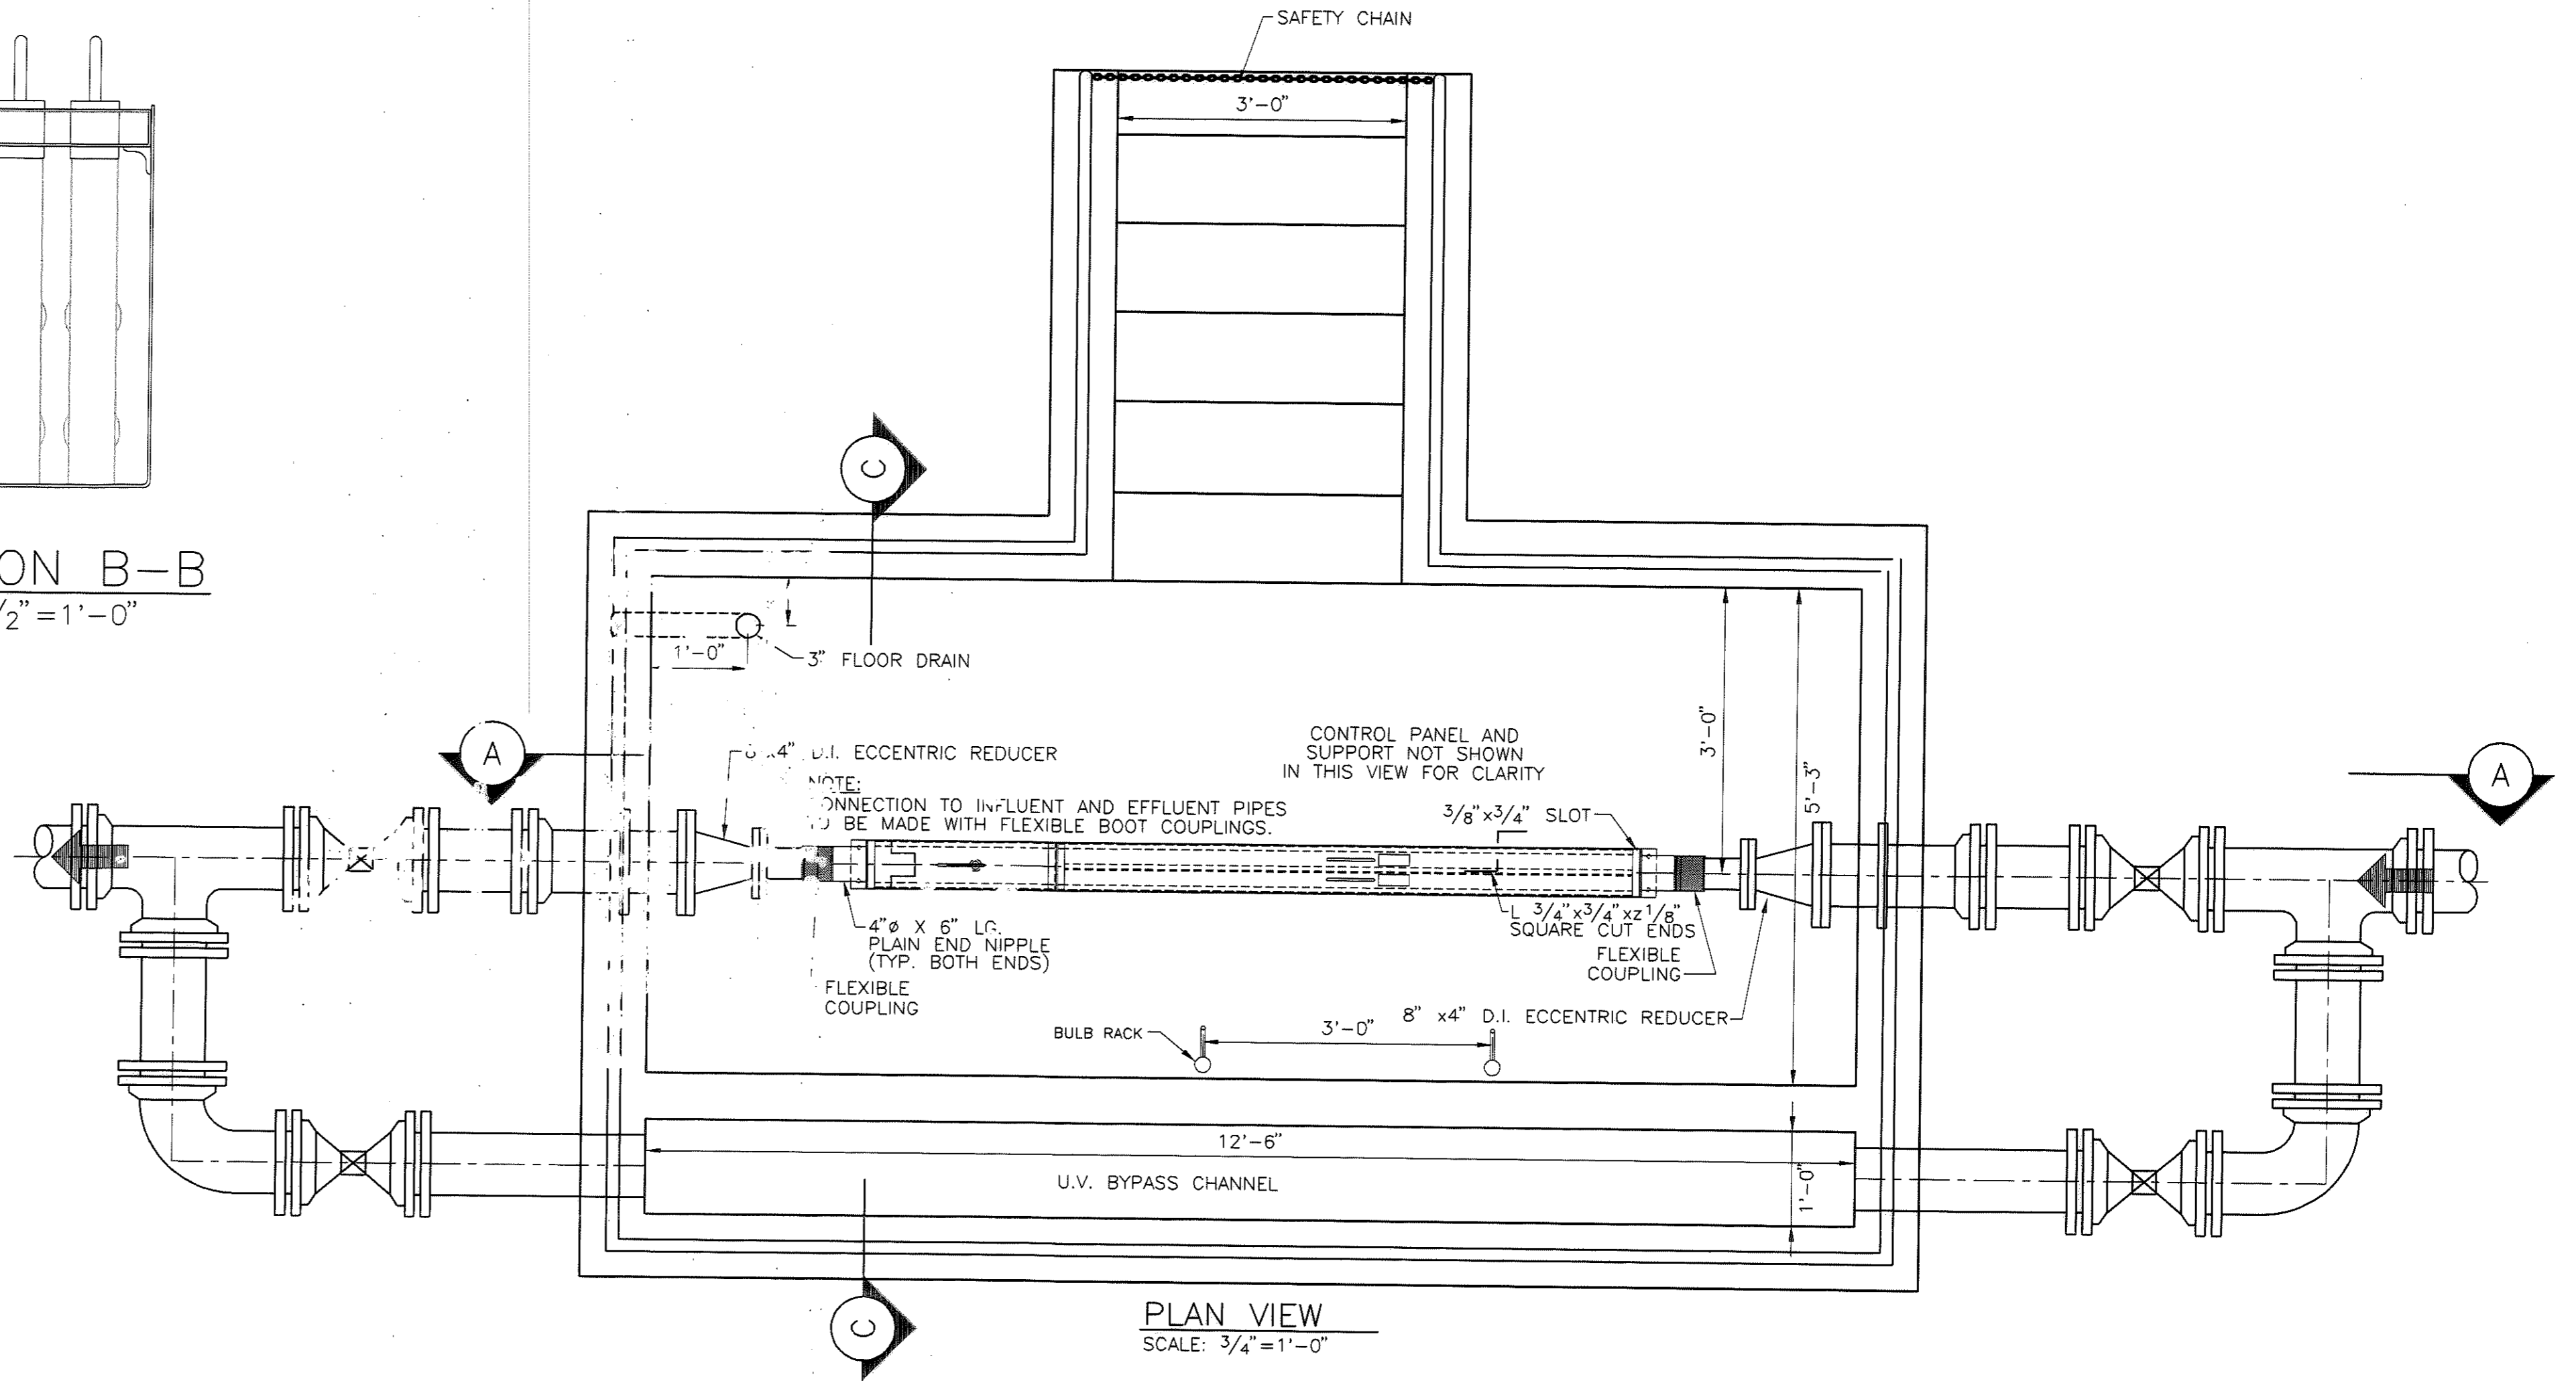

PLAN VIEW
 SCALE: 3/4" = 1'-0"

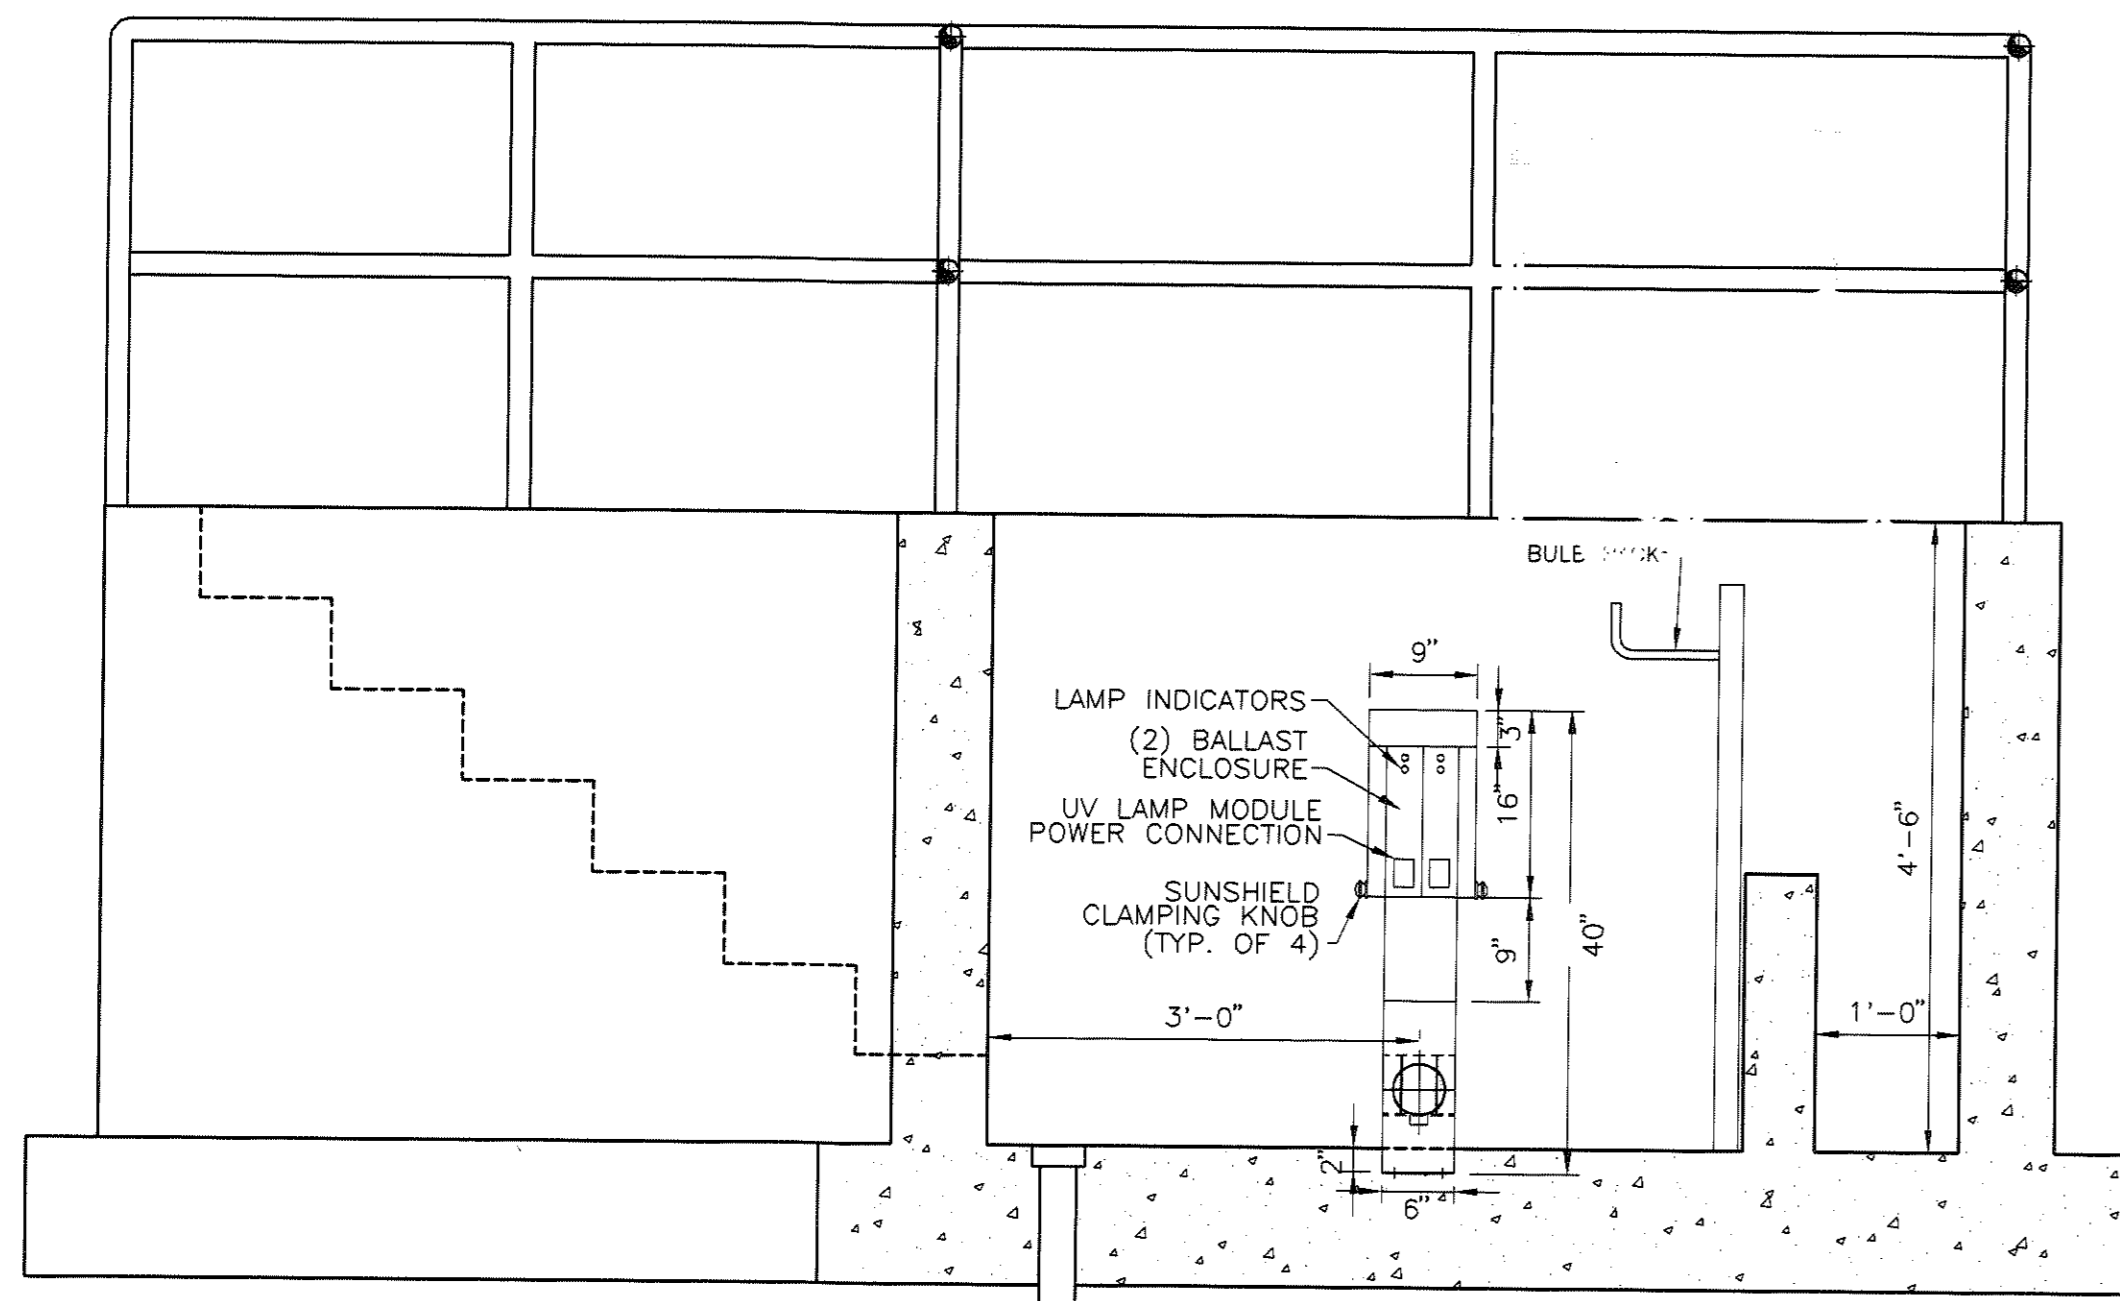


SECTION C-C
 SCALE: 3/4" = 1'-0"

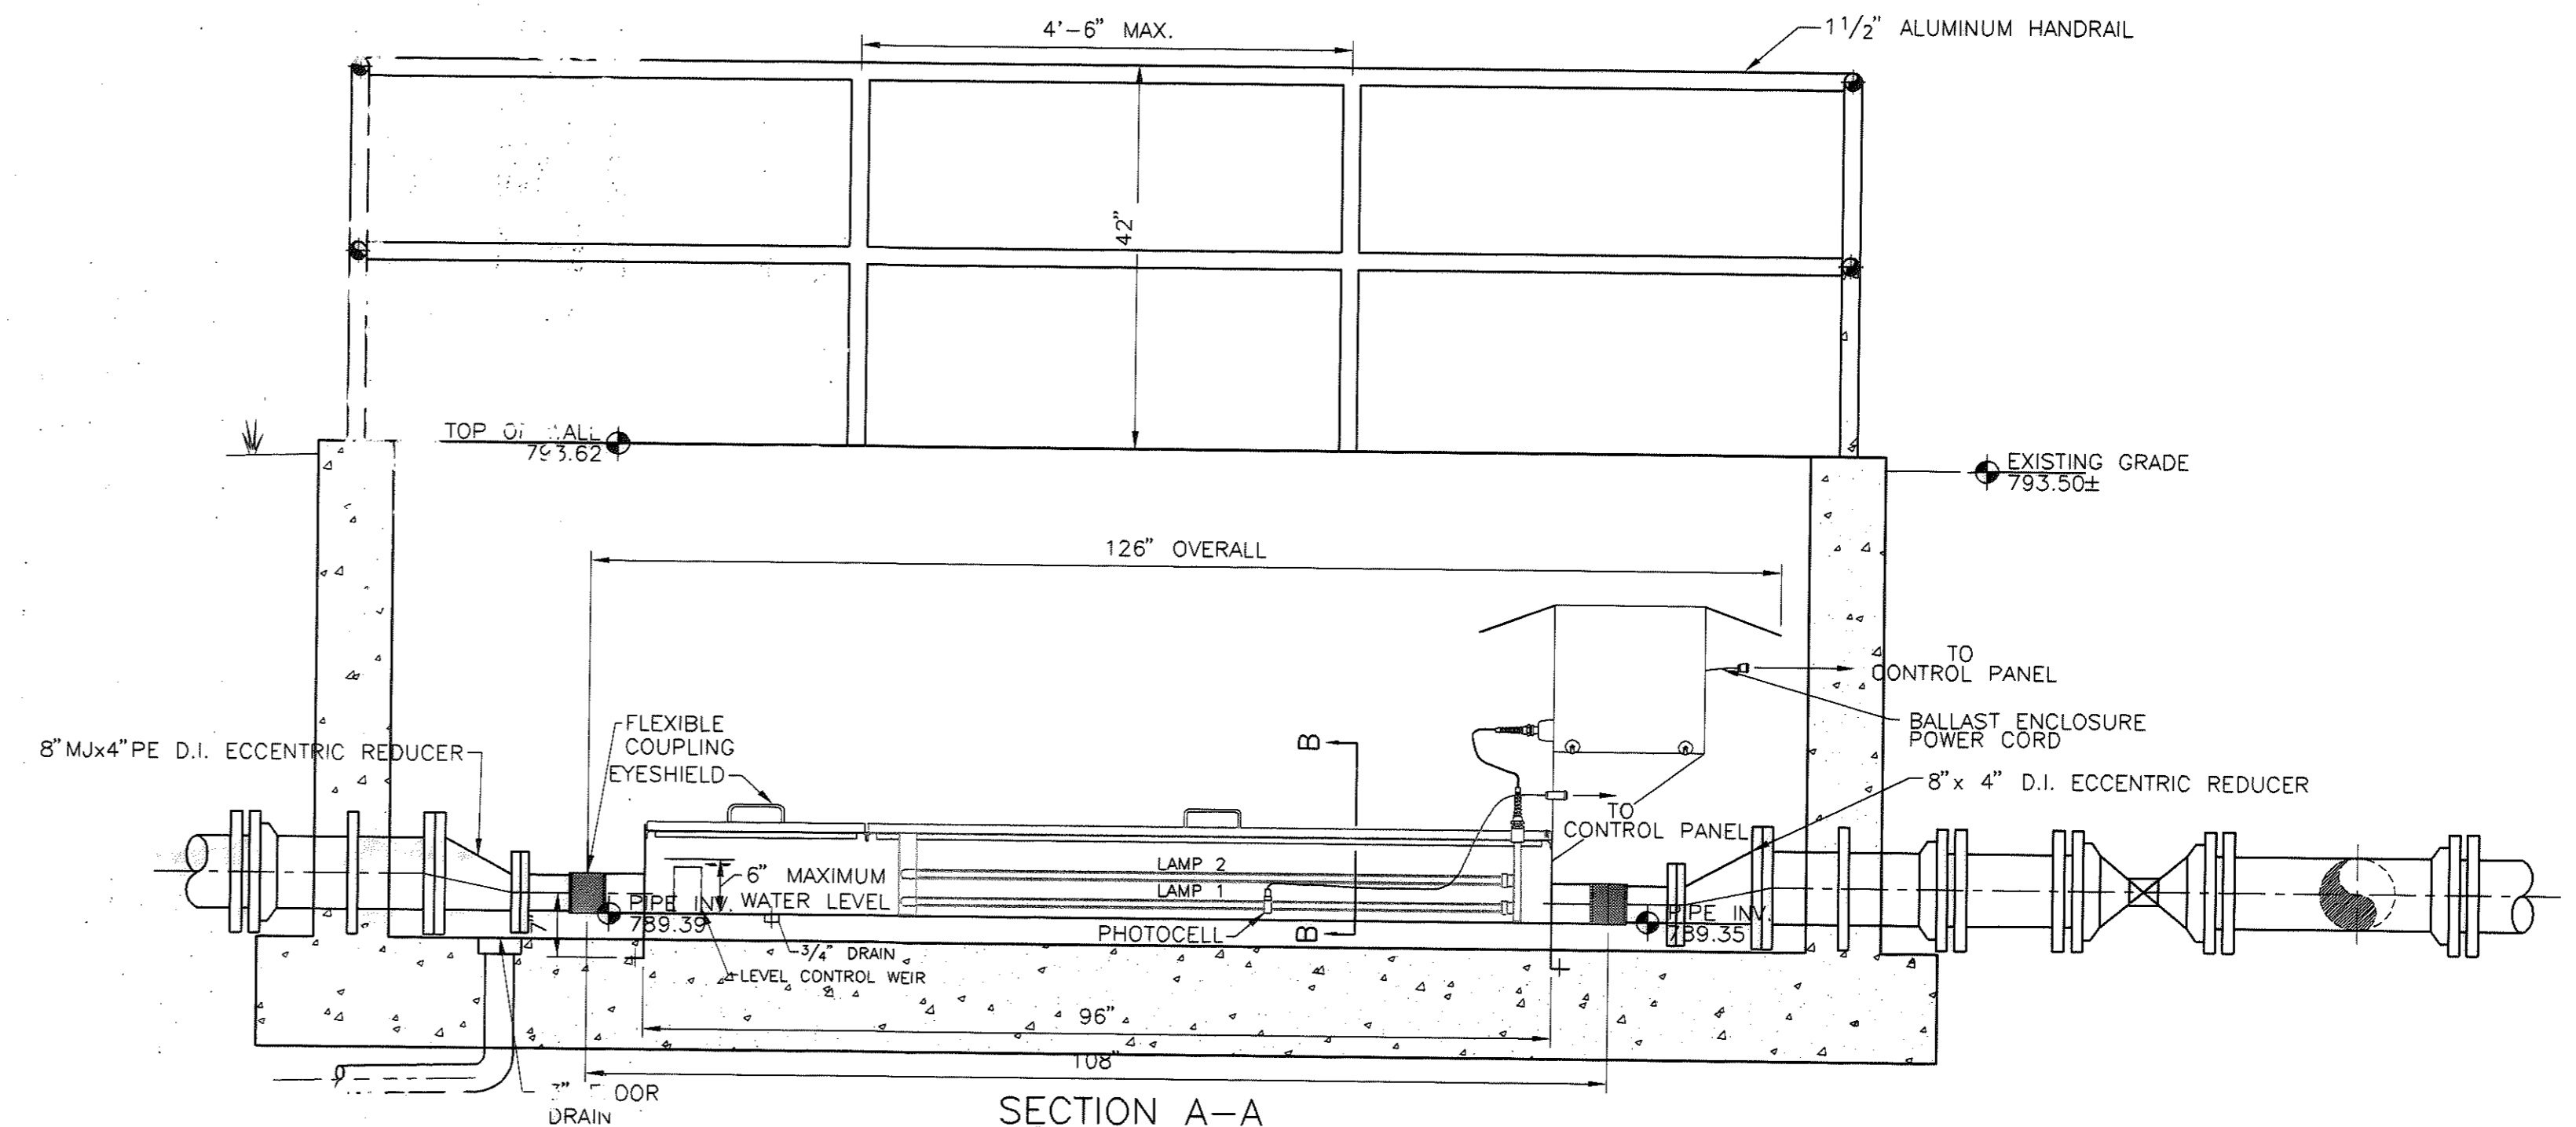

SECTION A-A
 SCALE: 3/4" = 1'-0"

REVISED "AS-BUILT" DRAWING
 THIS DRAWING HAS BEEN REVISED IN ACCORDANCE WITH NOTES ON "RECORD DRAWINGS" FURNISHED BY THE CONTRACTOR AND WITH EXECUTED CHANGE ORDERS TO THE BEST OF OUR KNOWLEDGE AND BELIEF. THIS DRAWING SHOWS ACTUAL "AS-BUILT" CONDITIONS.
COMMONWEALTH ENGINEERS, INC.
 REVISED: DATE 10/06
 BY JCW, CK, BY CWV

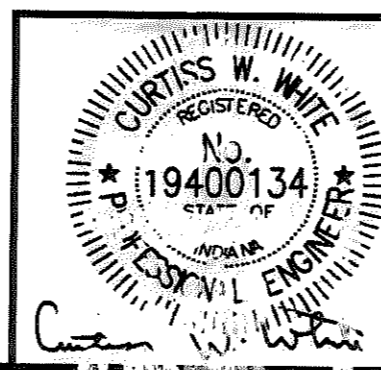


COMMONWEALTH ENGINEERS, INC.




DRAWN BY: CB
 DESIGNED BY: CWV
 CHECKED BY: CWV
 DATE: 4/04
 JOB NO: S02119-02
 SCALE: AS NOTED

SALAMONIE RESERVOIR
 WASTEWATER TREATMENT PLANT IMPROVEMENTS PROJECT
 PUBLIC WORKS PROJECT NO. E031410M
 ULTRAVIOLET STRUCTURE

11-UV STRUCTURE.DWG 16
 DRAWING NO. **11**
 11 OF 52

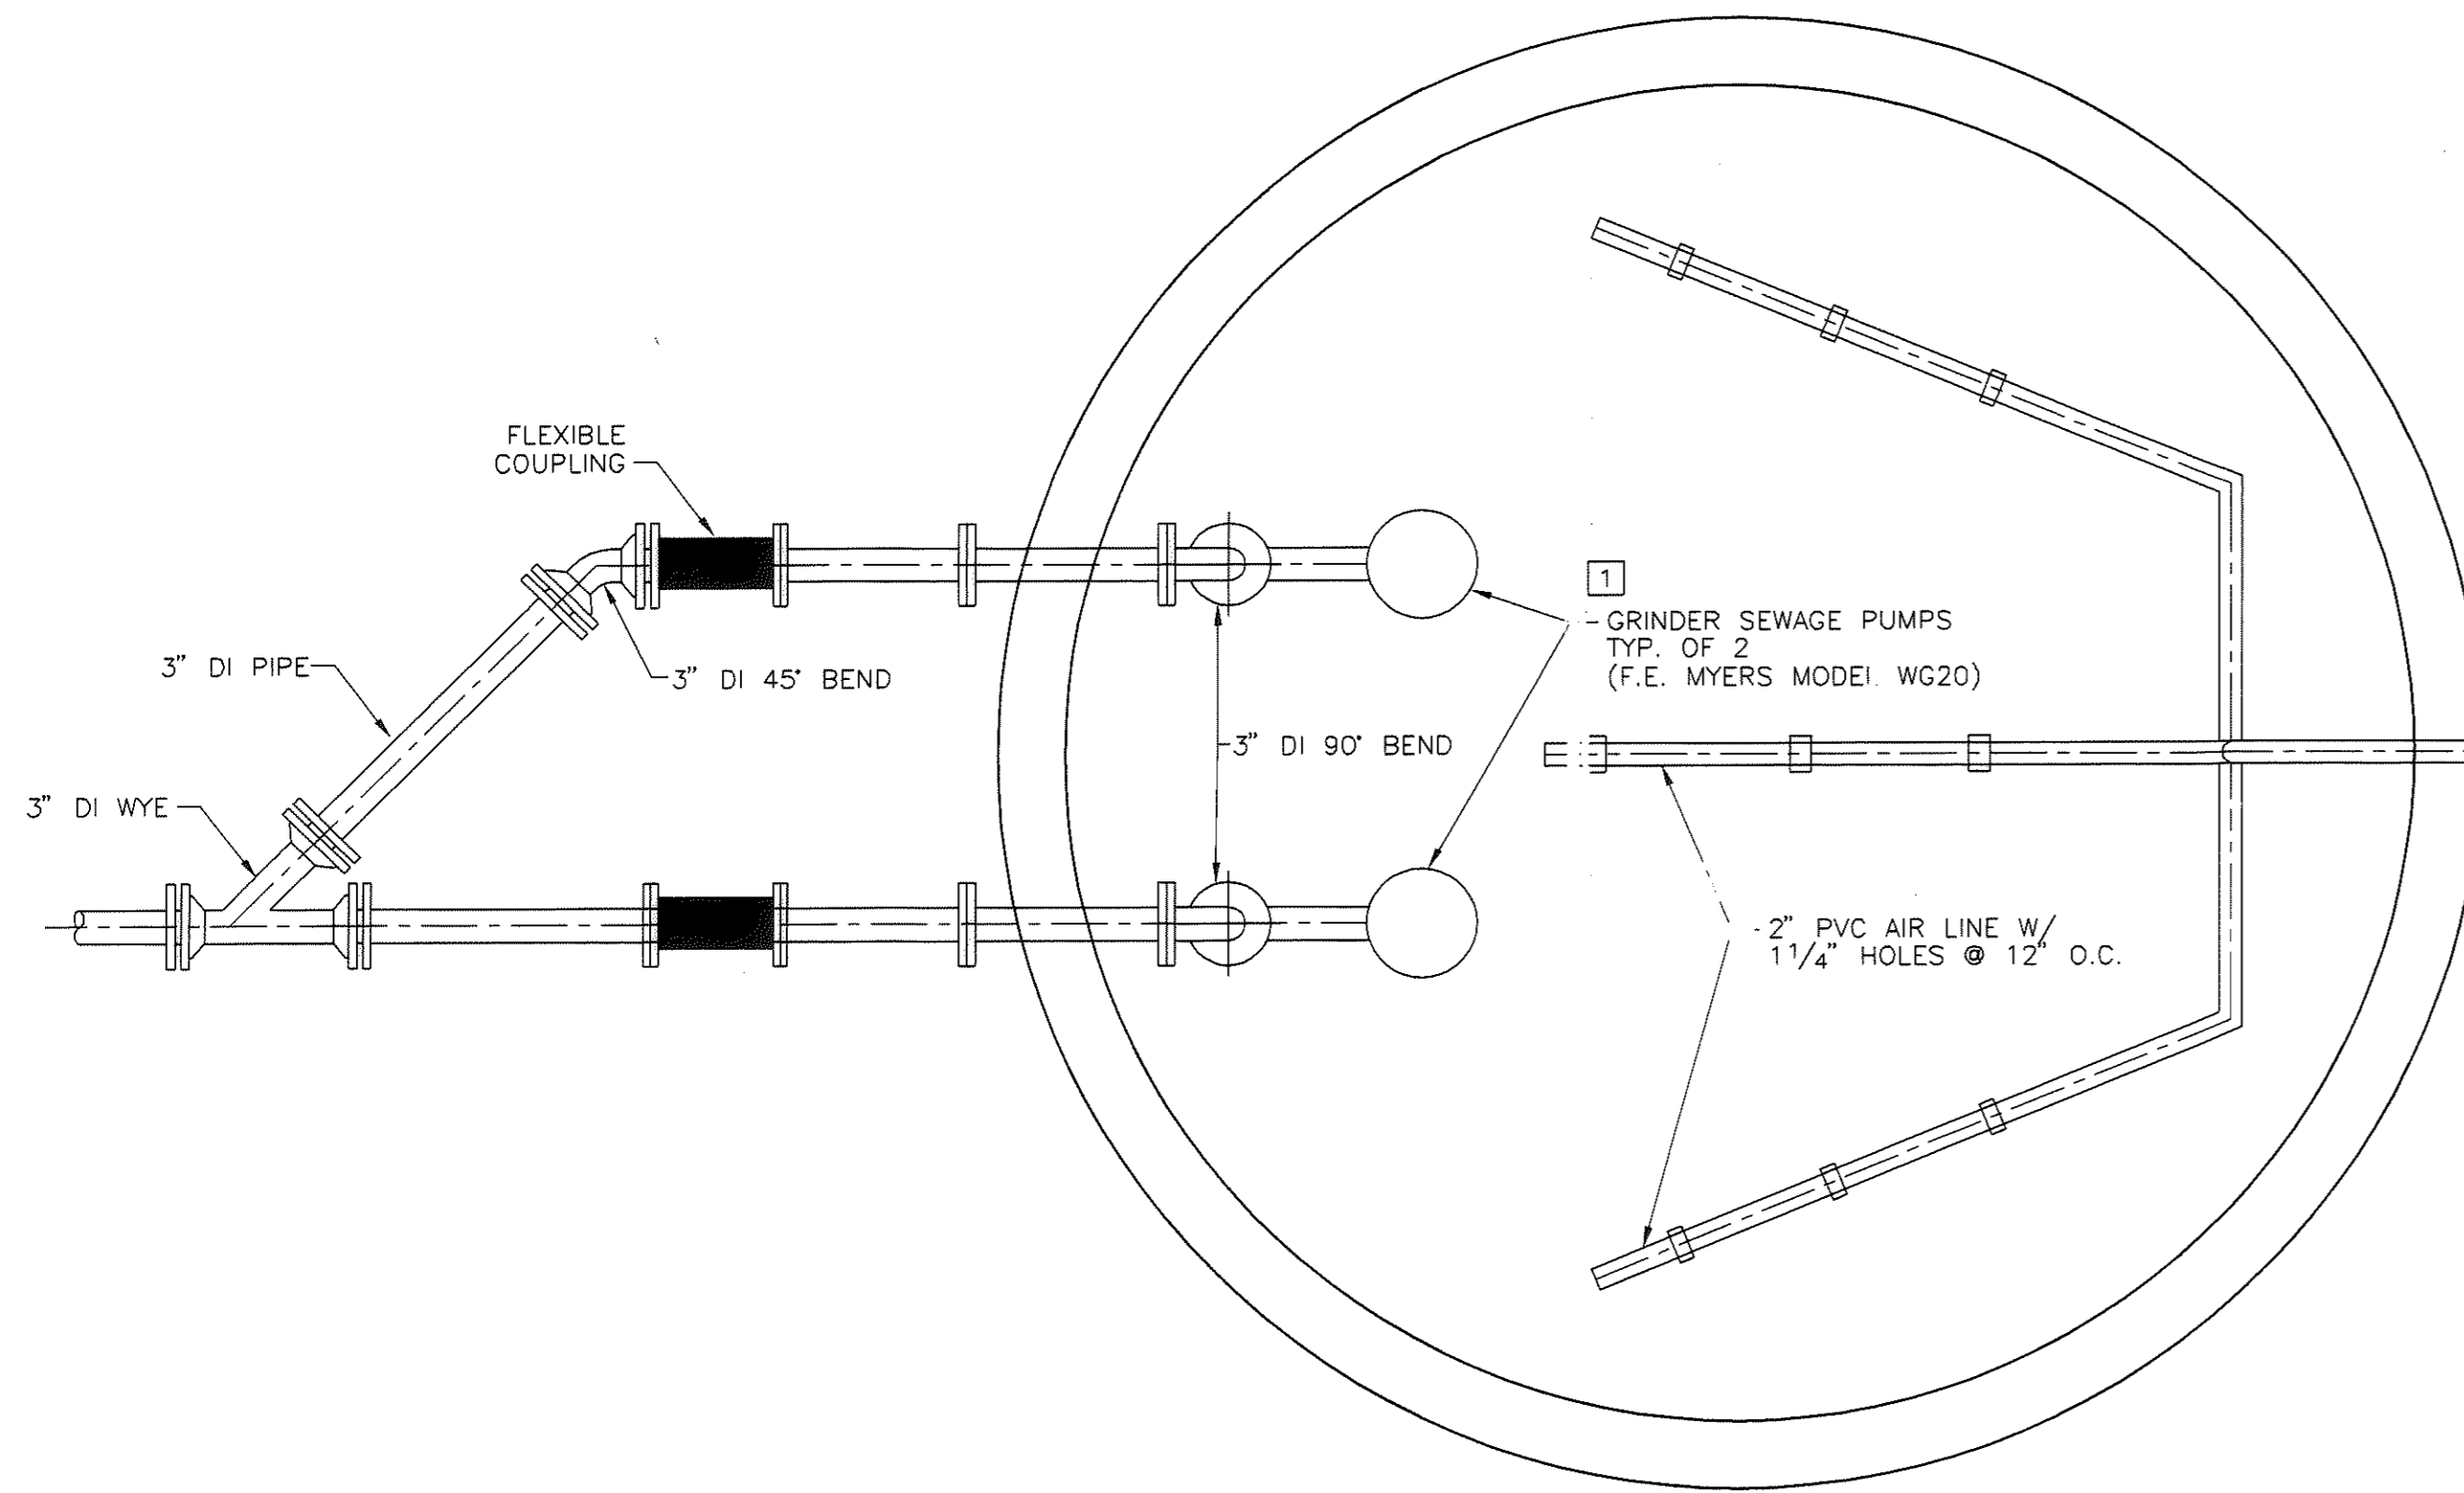

EQUALIZATION TANK-PLAN
SCALE: 3/4" = 1'-0"

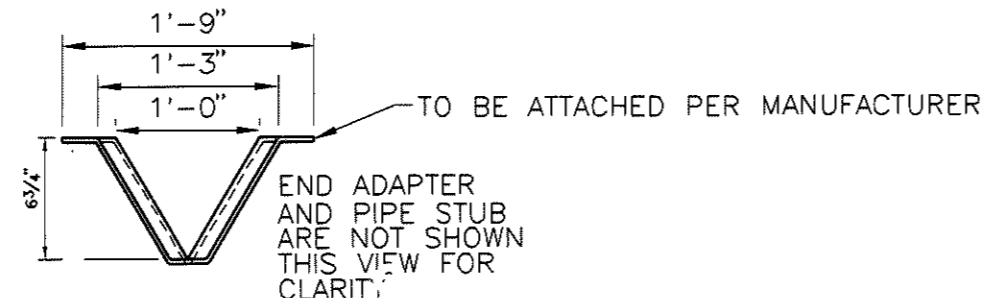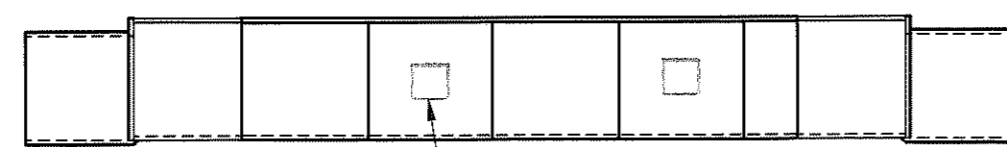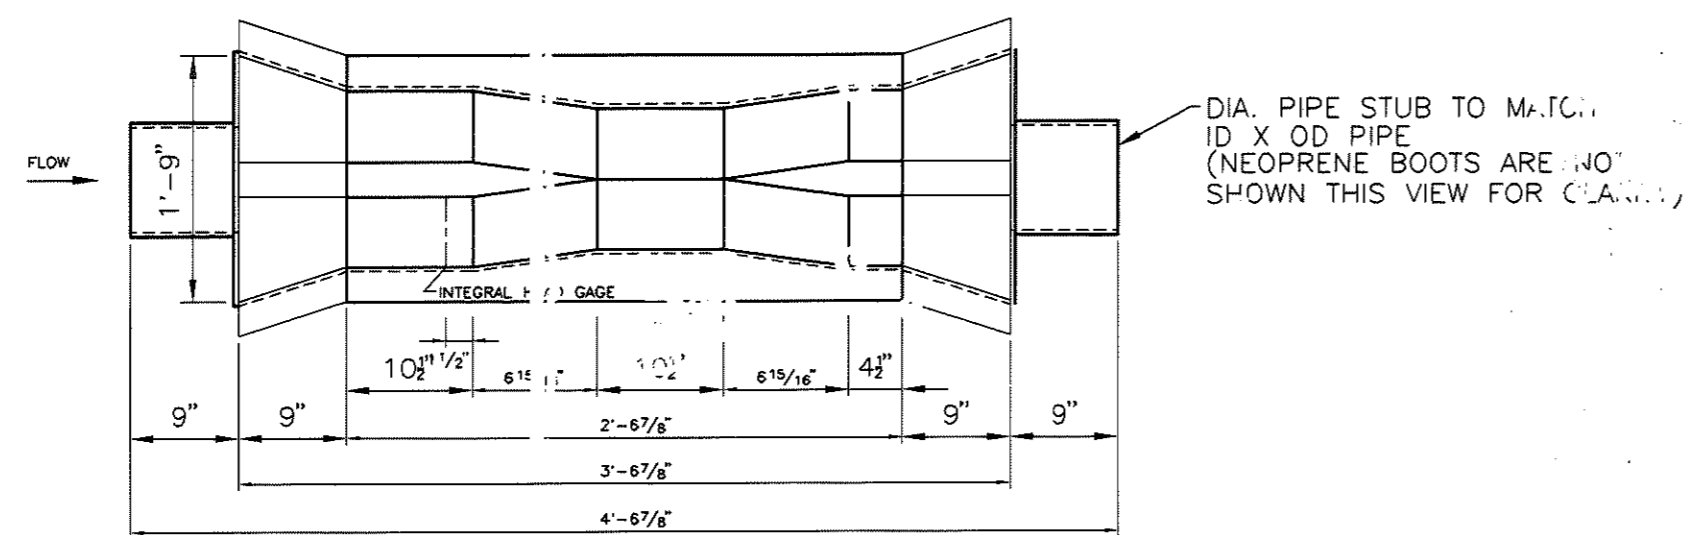


NOTE:
FLUME TO BE INSTALLED IN A NEW PRECAST MANHOLE.

- NOTES:
 1. THE MINIMUM THICKNESS IS 1/4" FRP (FIBERGLASS REINFORCED POLYESTER).
 2. THE INSIDE SURFACES ARE SMOOTH WHITE GEL COAT.
 3. THE MINIMUM GLASS CONTENT IS 30% EXCLUSIVE OF RESIN RICH SURFACES.
 4. THE HEAD GAGE IS MOLDED INTO THE SIDE OF THE FLUME.

LARGE V TRIPARTIDAL FLUME
SCALE: 3/4" = 1'-0"


- ADDENDUM NO. 1 REVISED 5/18/04
- ADDENDUM NO. 2 REVISED 7/19/04
- CHANGE ORDER NO. 1 REVISED 9/1/04

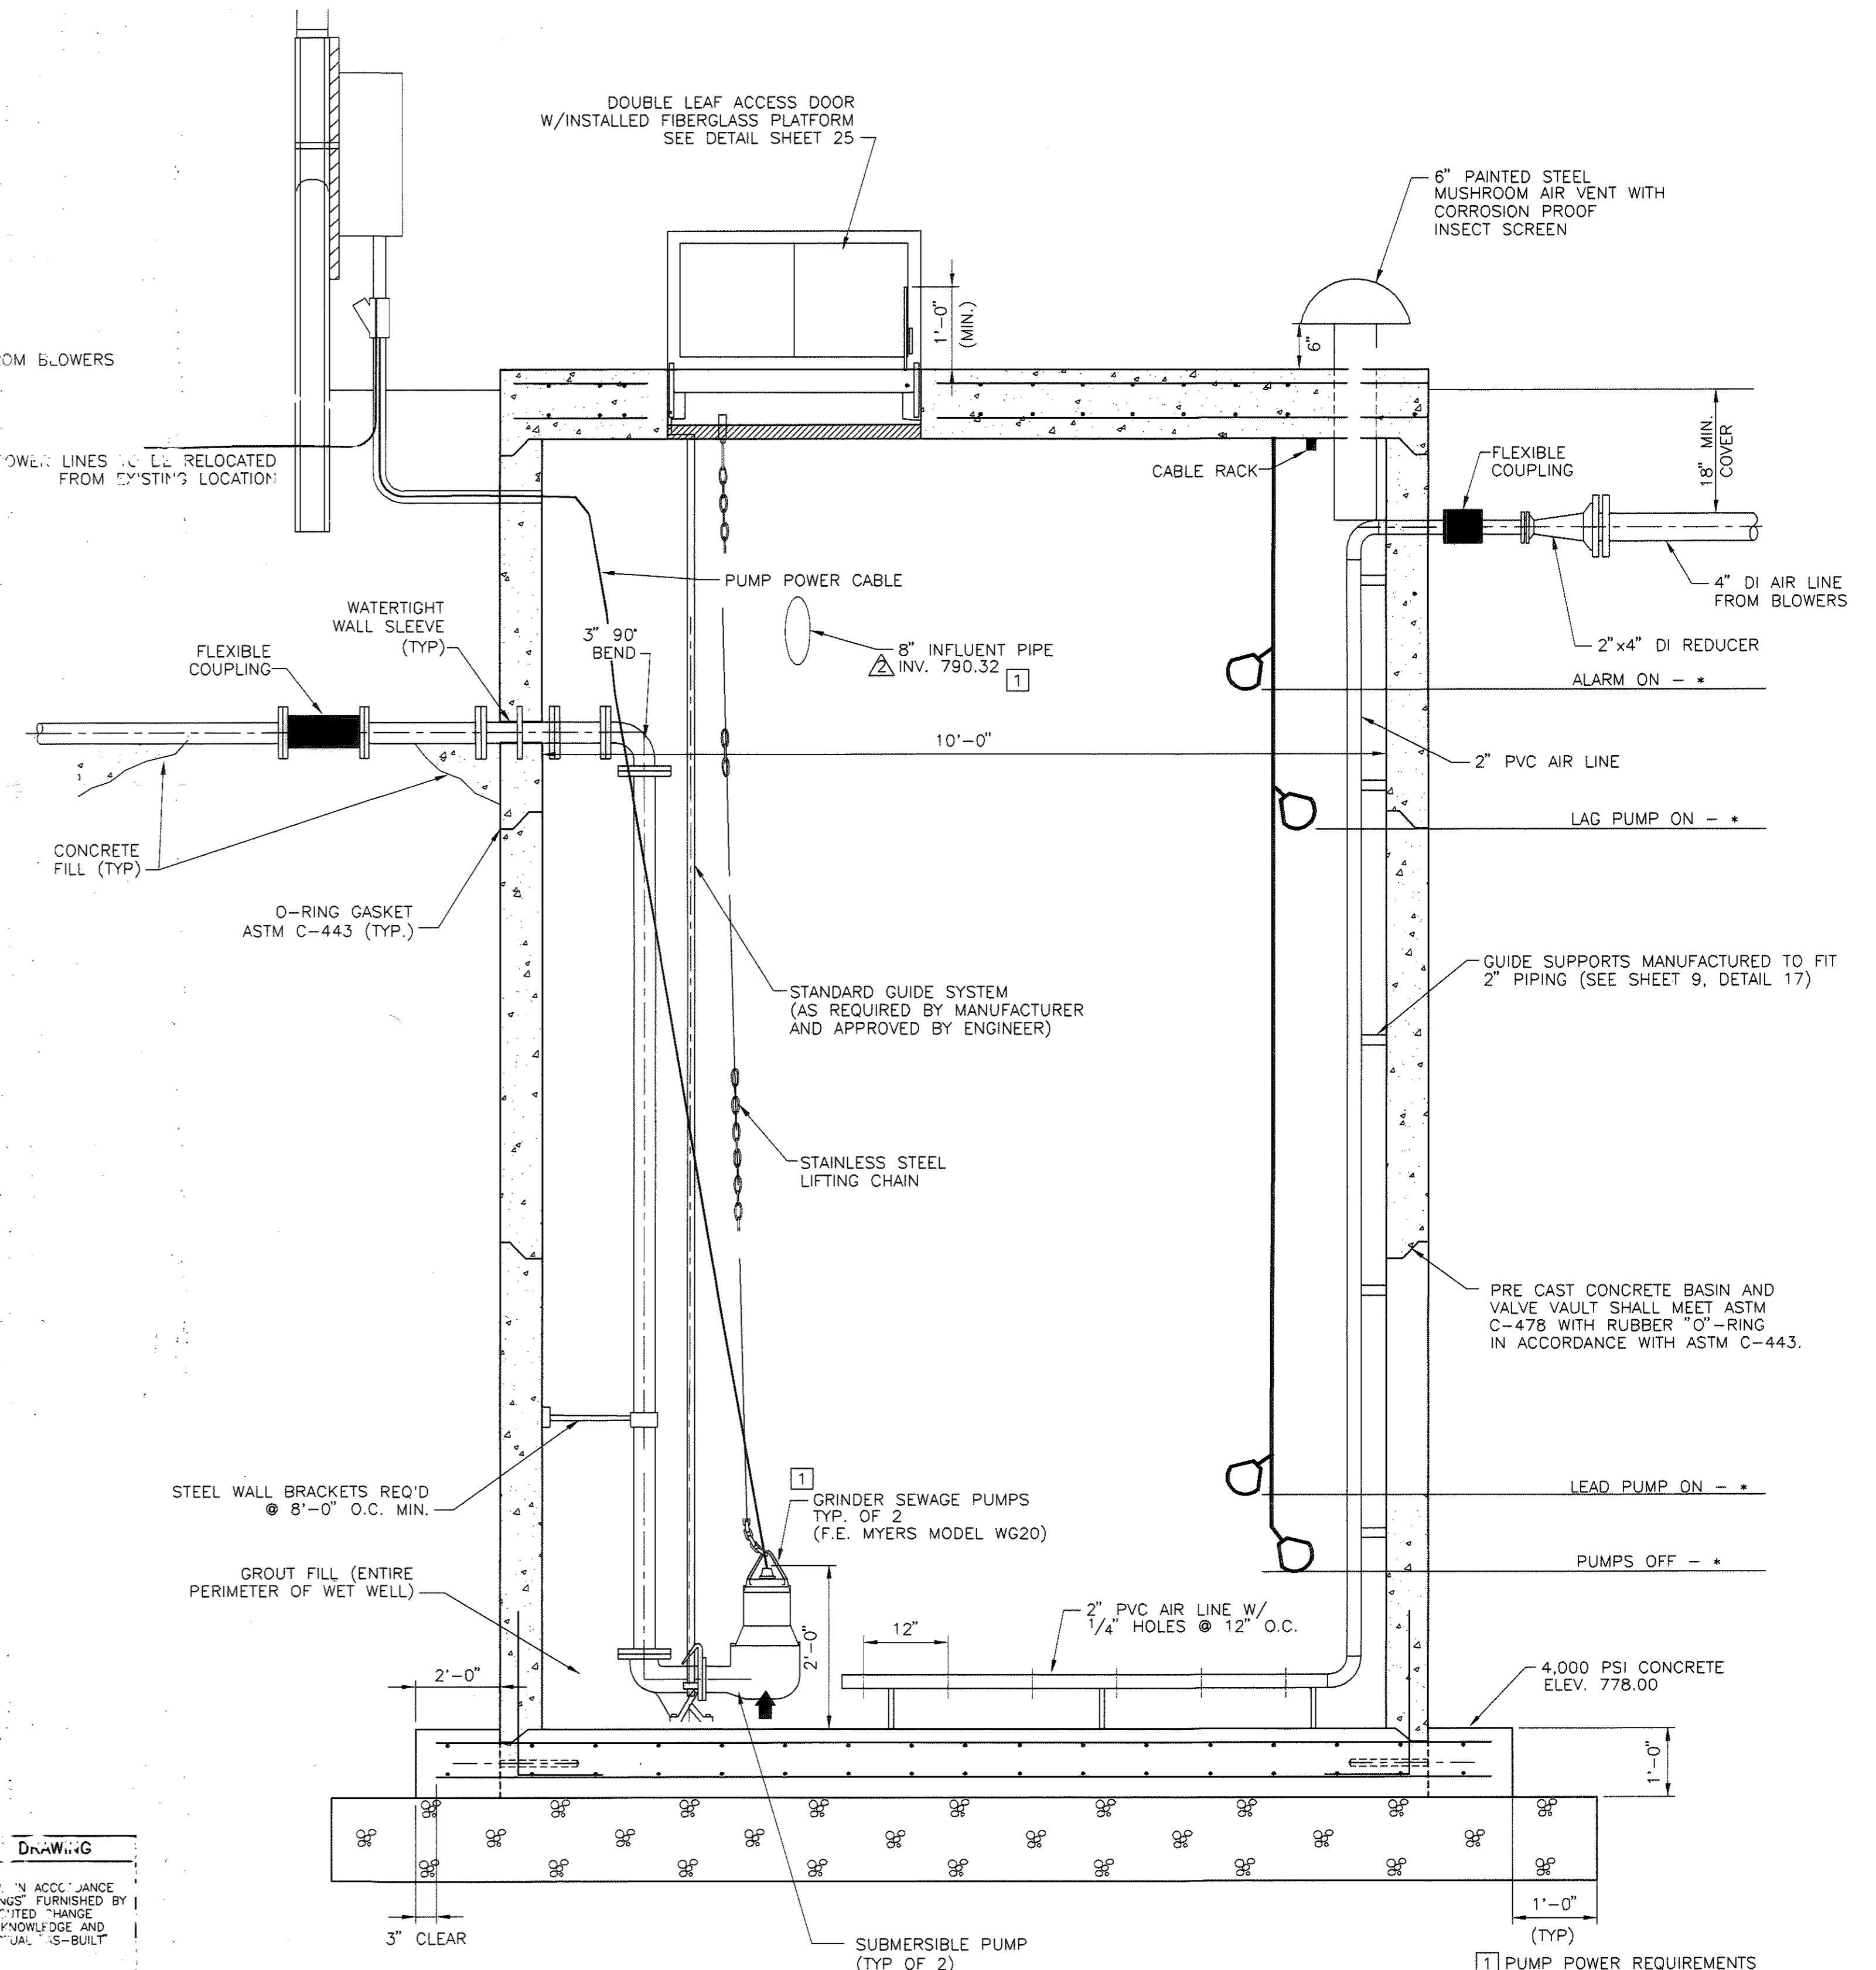

EQUALIZATION TANK-SECTION
SCALE: 3/4" = 1'-0"

- 1] PUMP POWER REQUIREMENTS
 2 HP. -230VOLT-SINGLE PHASE
 ELECTRICAL PANEL LA-CIRCUIT LA 30
 2 POLE 20 AMP CIRCUIT BREAKER
 RUN TO 2-#12 WIRES, #12 GROUND
 3/4" CONDUIT TO EQ. PUMP PANEL
 PUMP STARTER TO BE IN CONTROL PANEL

REVISED AS-BUILT DRAWING
 THIS DRAWING HAS BEEN REVISED IN ACCORDANCE WITH NOTES ON RECORD DRAWINGS FURNISHED BY THE CONTRACTOR AND WITH EXPLICIT CHANGE ORDERS TO THE BEST OF OUR KNOWLEDGE AND BELIEF. THIS DRAWING SHOWS ACTUAL AS-BUILT CONDITIONS.
 COMMONWEALTH ENGINEERS, INC.
 REVISION DATE: 10/06
 BY: JUC, CK. BY: CWW

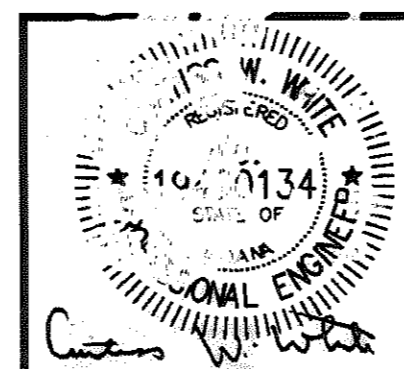

COMMONWEALTH ENGINEERS, INC.


DRAWN BY:	CB
DESIGNED BY:	CWW
CHECKED BY:	CWW
DATE:	12/03
JOB NO.:	SD2119-02
SCALE:	AS NOTED

SALOMIE RESERVOIR
 WASTEWATER TREATMENT PLANT IMPROVEMENTS PROJECT
 PUBLIC WORKS PROJECT NO. E031410M
 FLUME STRUCTURE/ EQUALIZATION TANK

DRAWING NO.

12

12 OF 52


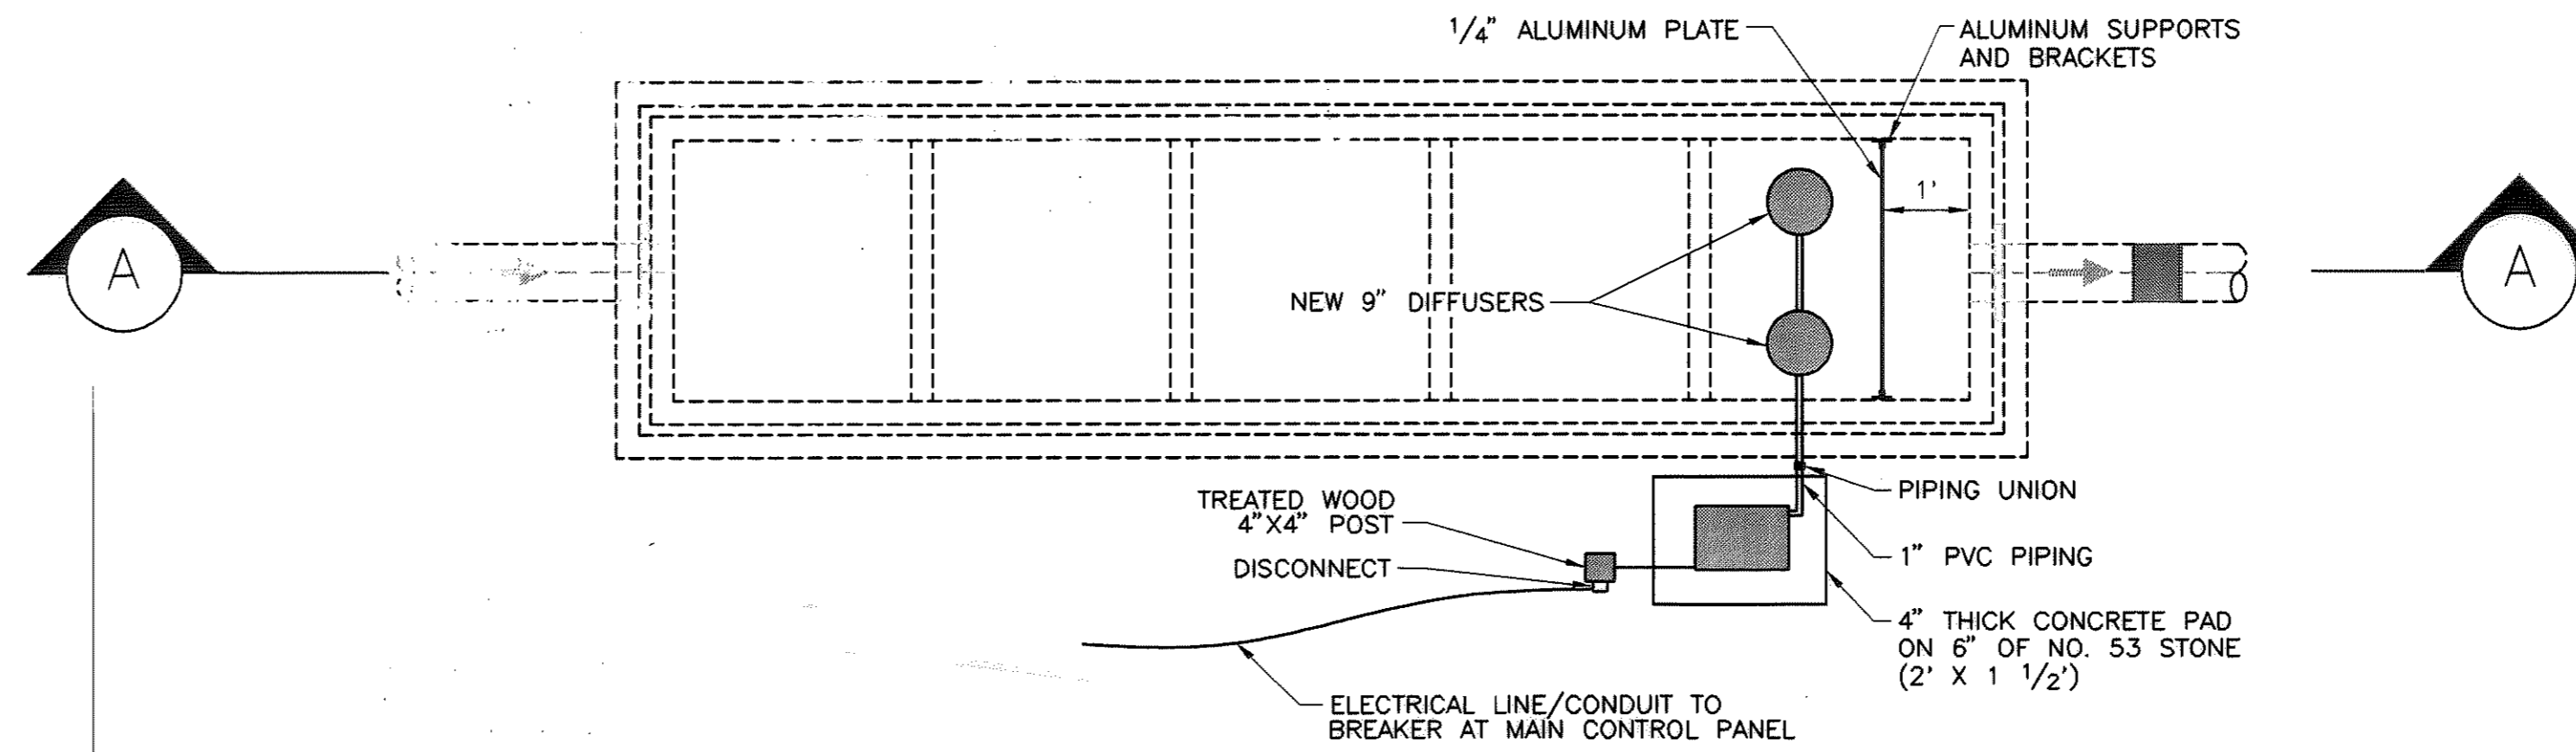


NEW CASCADE AERATION STRUCTURE

SCALE: 1/2" = 1'-0"

NOTES:


- ① PVC PIPING TO BE SECURE FASTENED TO SIDED CASCADE STRUCTURE
- ② DIFFUSER HEATER TO BE SECURELY ANCHORED TO FLOOR OF CASCADE STRUCTURE
- ③ ELECTRICAL LINE AND CONDUIT TO BE INSTALLED. POWER SUPPLY TO BE ACCESSED AT MAIN CONTROL PANEL IN LABORATORY BUILDING WITH DEDICATED BREAKER PER IEC.
- ④ ELECTRICAL DISCONNECT TO BE MOUNTED ON A TREATED WOOD 4"x4" POST.
- ⑤ ALUMINUM PLATE TO BE 1/4" AND SECURELY ANCHORED IN PLACE.
- ⑥ ALL BRACKETS AND HARDWARE SHALL BE STAINLESS STEEL OR ALUMINUM

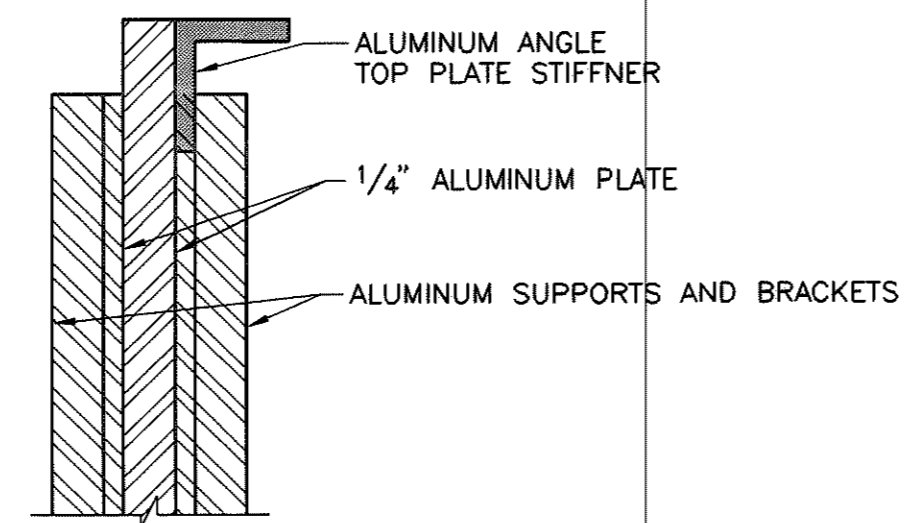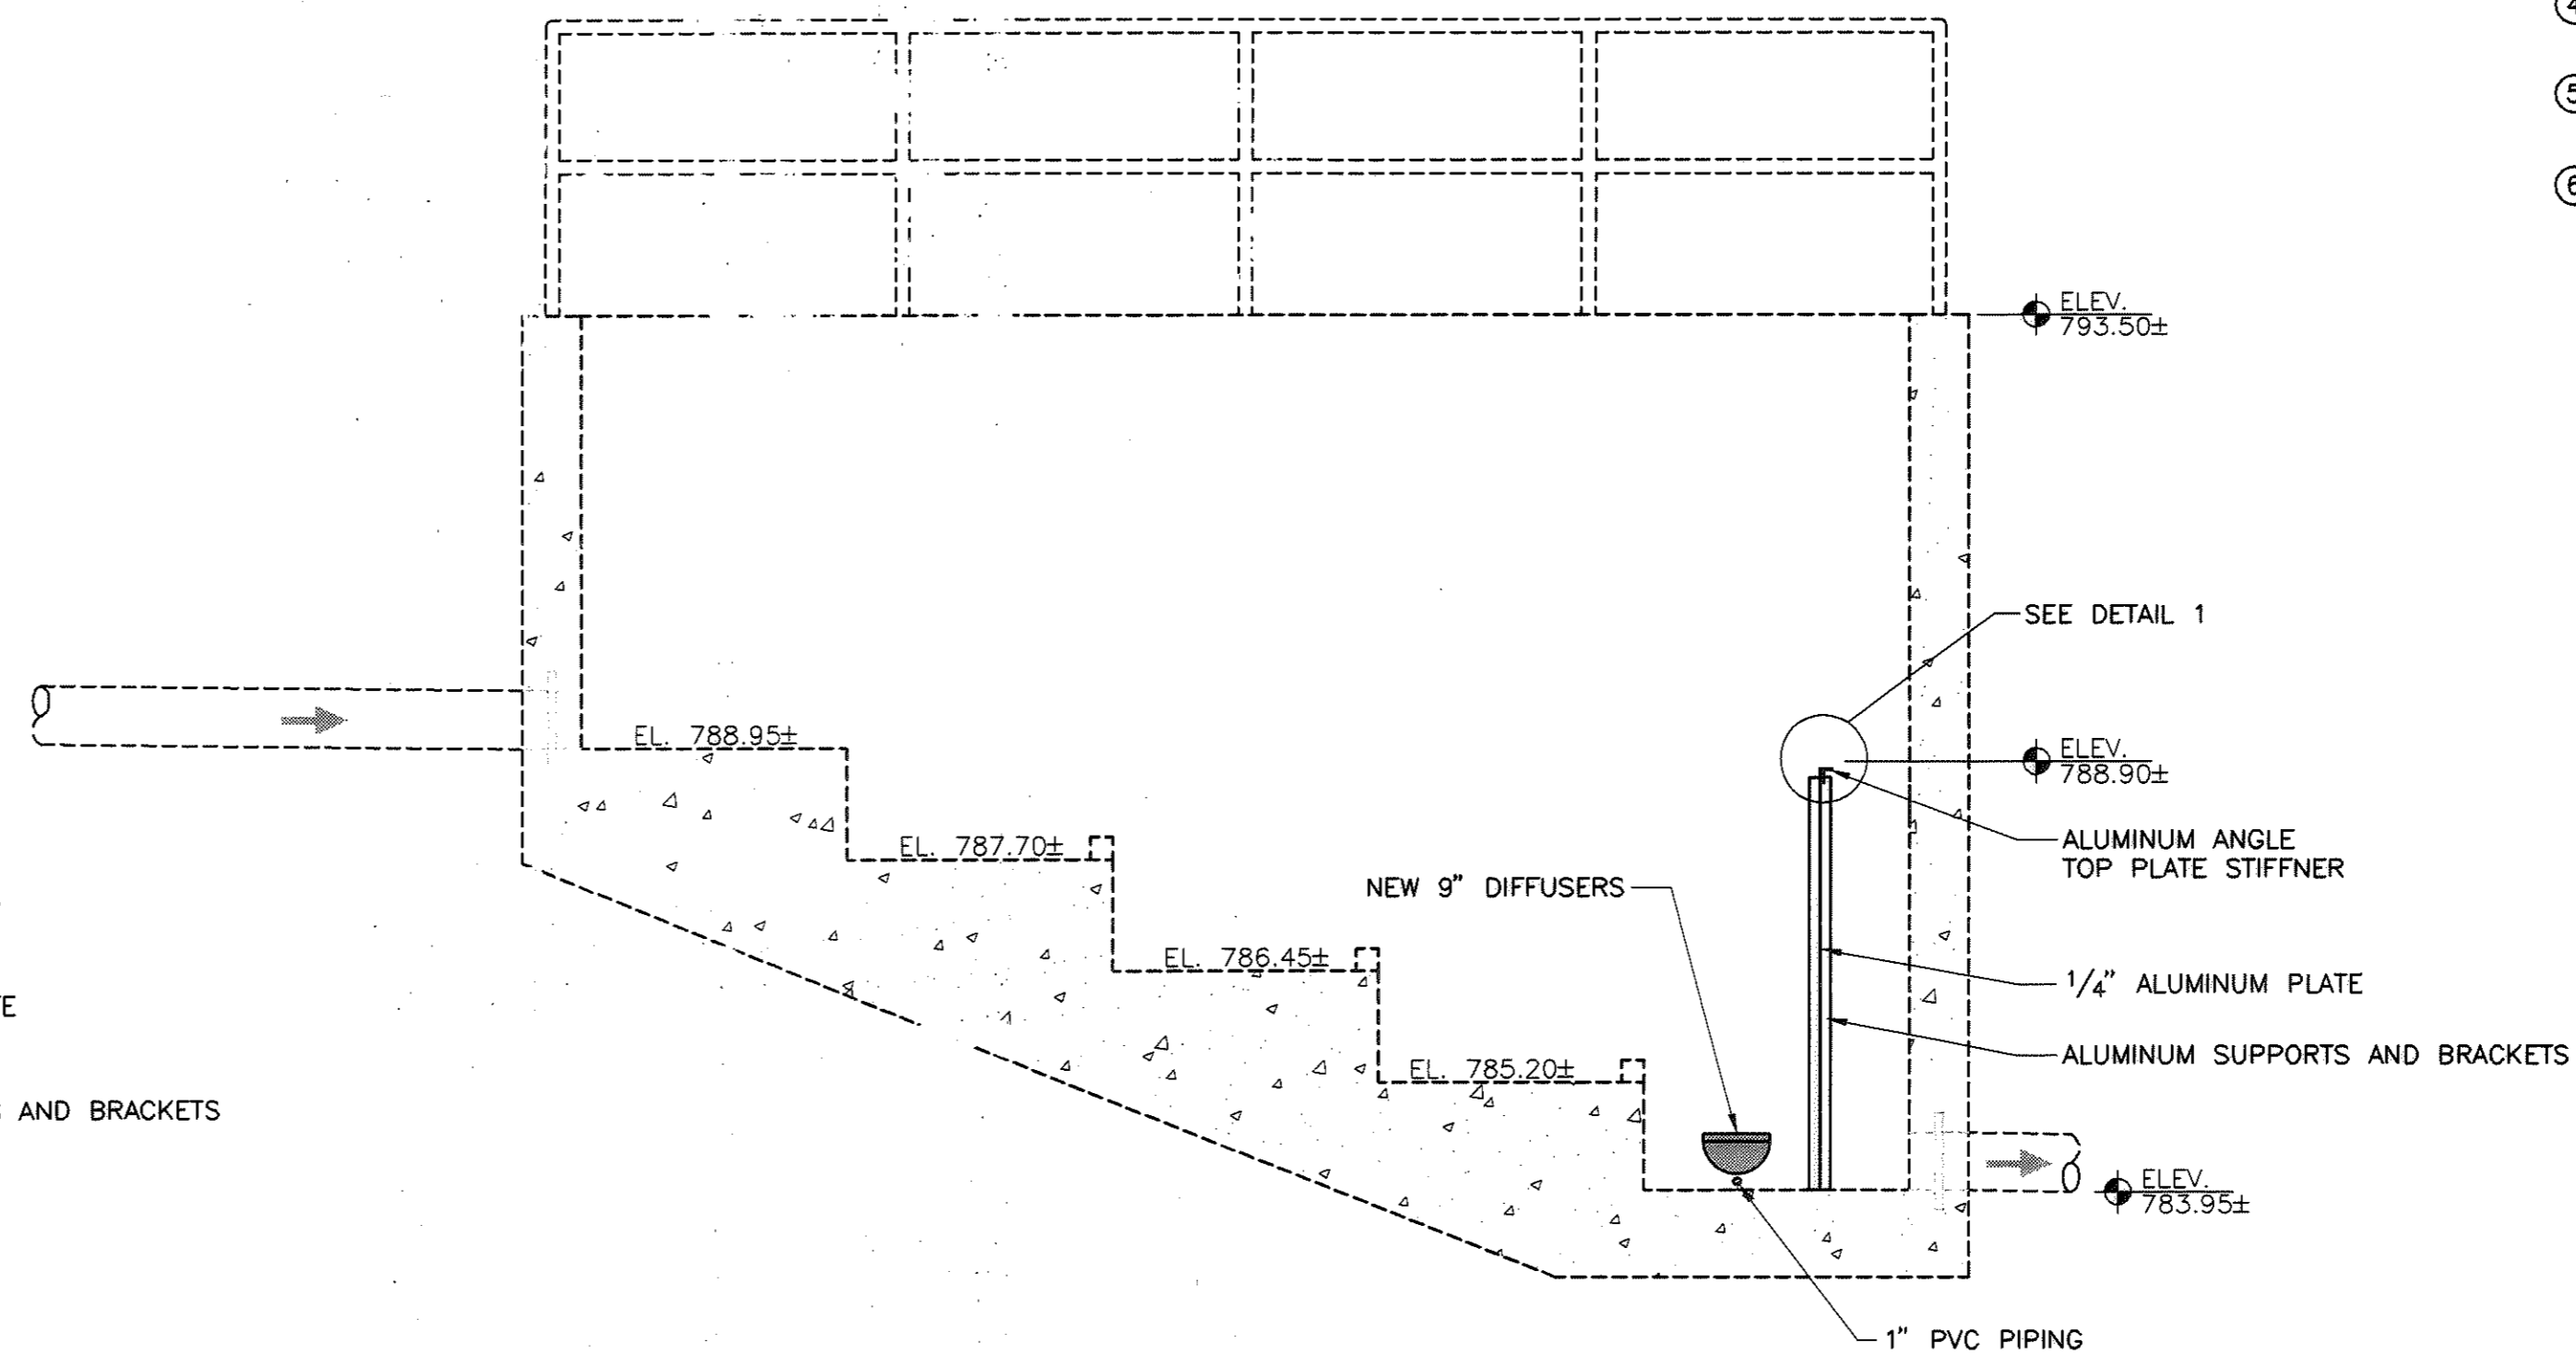

DETAIL 1
NOT TO SCALE

SECTION A
SCALE: 1/2" = 1'-0"

REVISED "AS-BUILT" DRAWING
THIS DRAWING HAS BEEN REVISED IN ACCORDANCE WITH NOTES ON "RECORD DRAWINGS" FURNISHED BY THE CONTRACTOR AND WITH EXECUTED CHANGE ORDERS, TO THE BEST OF OUR KNOWLEDGE AND BELIEF, THIS DRAWING SHOWS ACTUAL "AS-BUILT" CONDITIONS.
COMMONWEALTH ENGINEERS, INC.
REVISED DATE: 10/06
BY: JCW, CK, BY: CWW

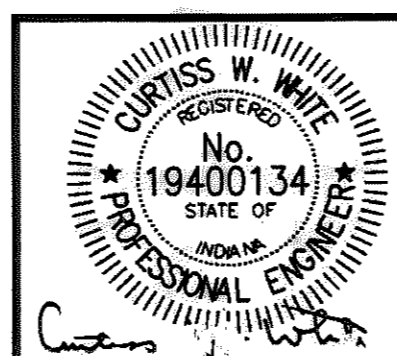


COMMONWEALTH ENGINEERS, INC.


DRAWN BY: BAK
DESIGNED BY: CWW
CHECKED BY: CWW
DATE: 9/05
JOB NO: S02119-02
SCALE: AS NOTED

SALAMONIE RESERVOIR
WASTEWATER TREATMENT PLANT IMPROVEMENTS PROJECT
PUBLIC WORKS PROJECT NO. E031410M
POST AERATION CONVERSION


DRAWING NO.
143
143 OF 52

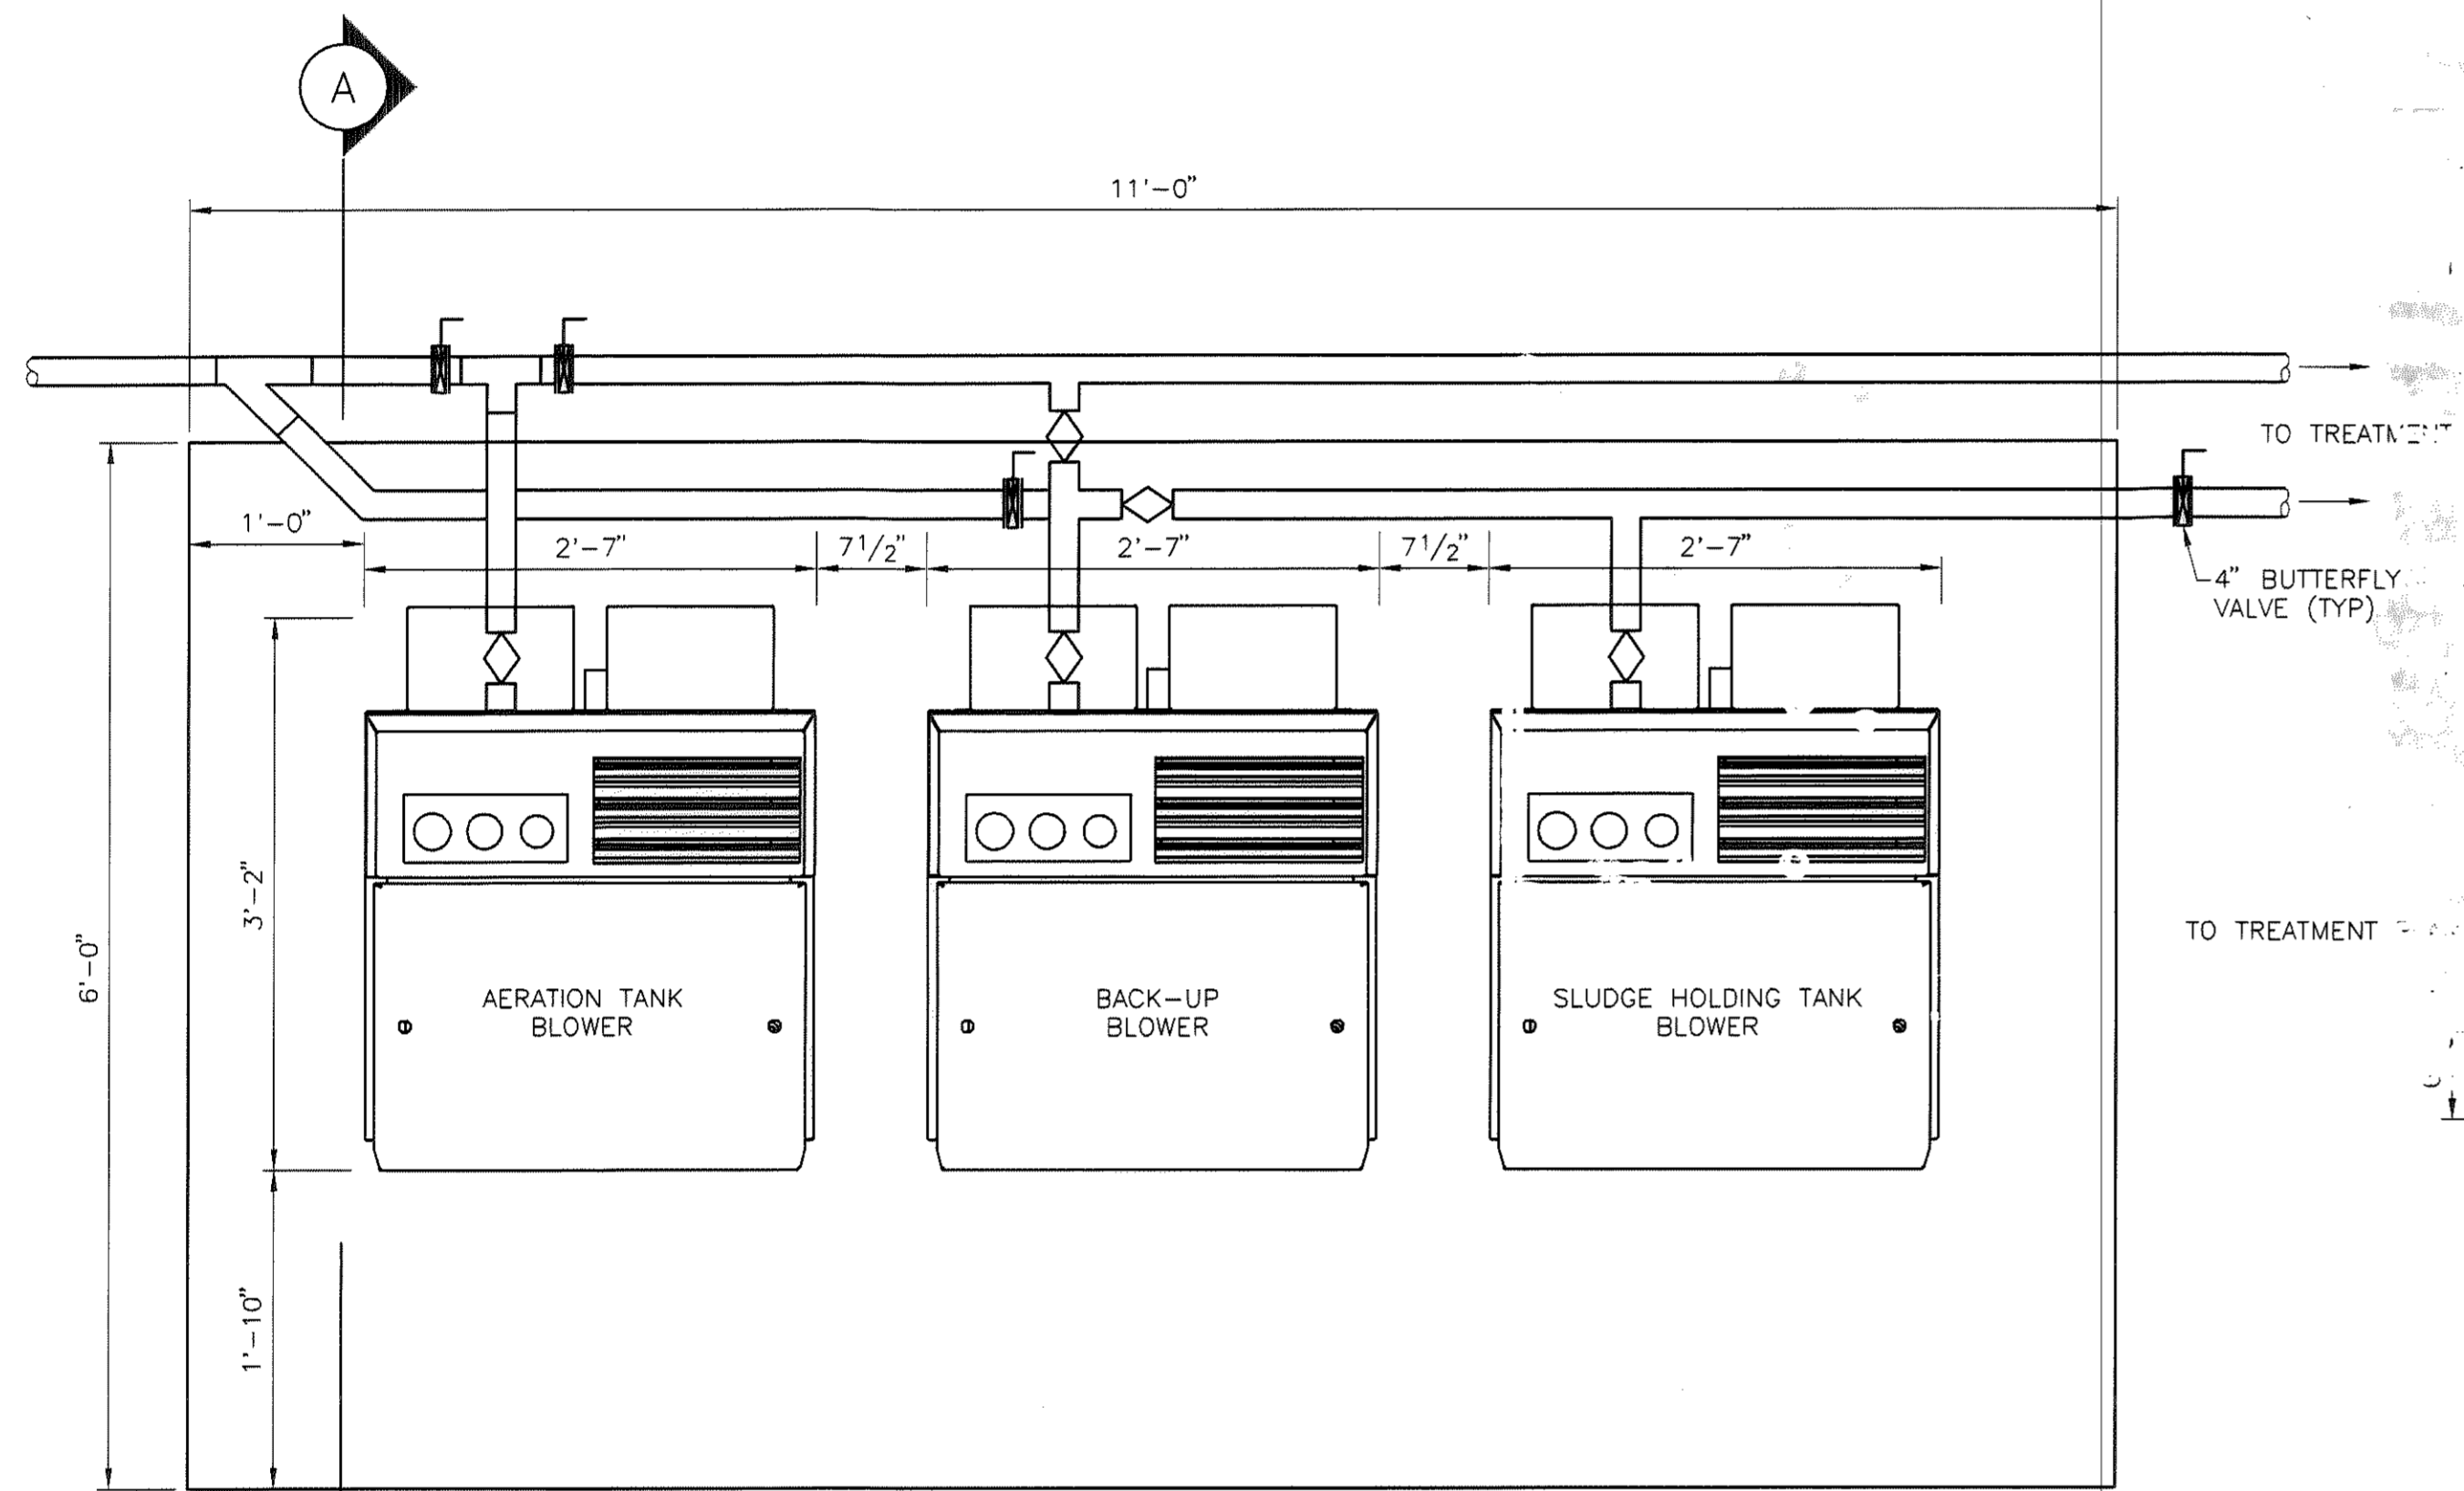

BLOWER PAD PLAN VIEW
 SCALE: 1"=1'-0"

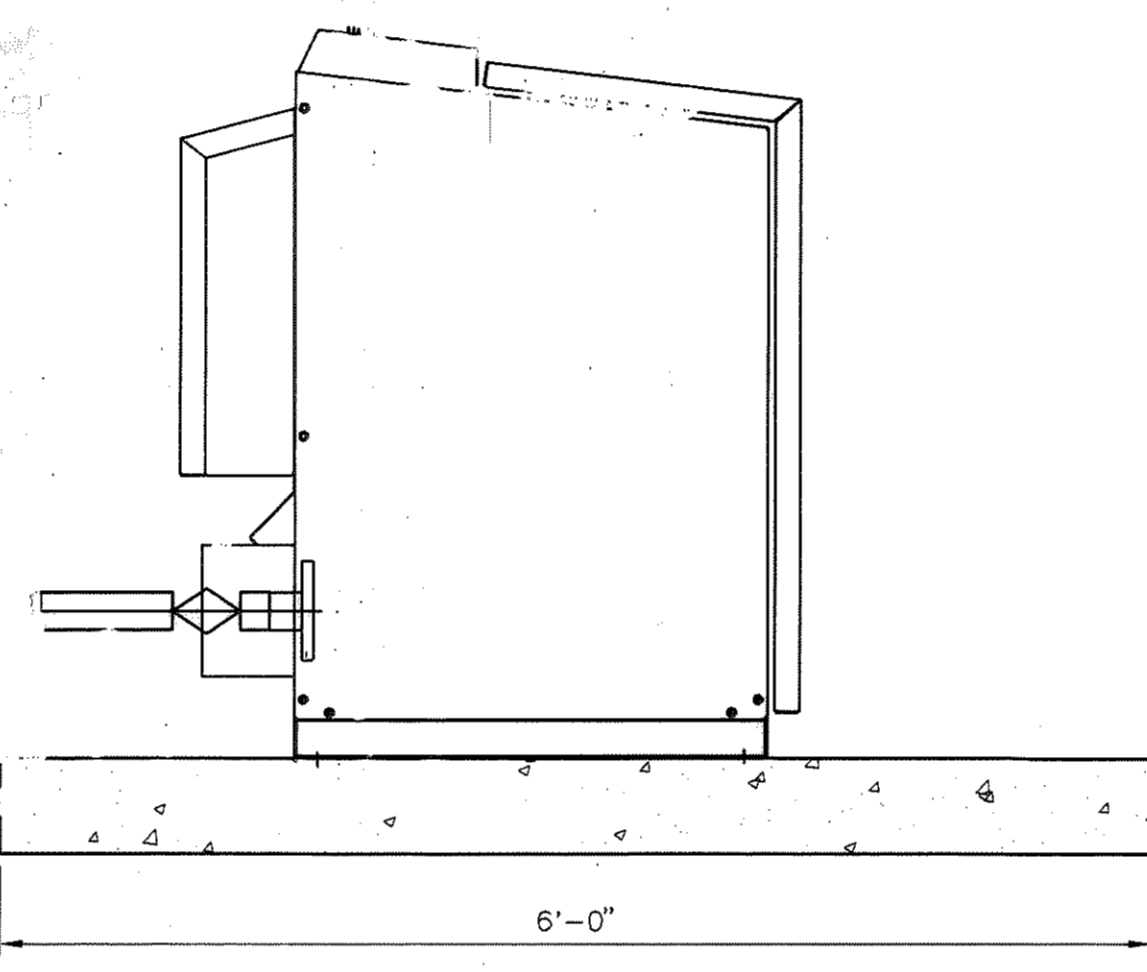

SECTION A-A
 SCALE: 1"=1'-0"

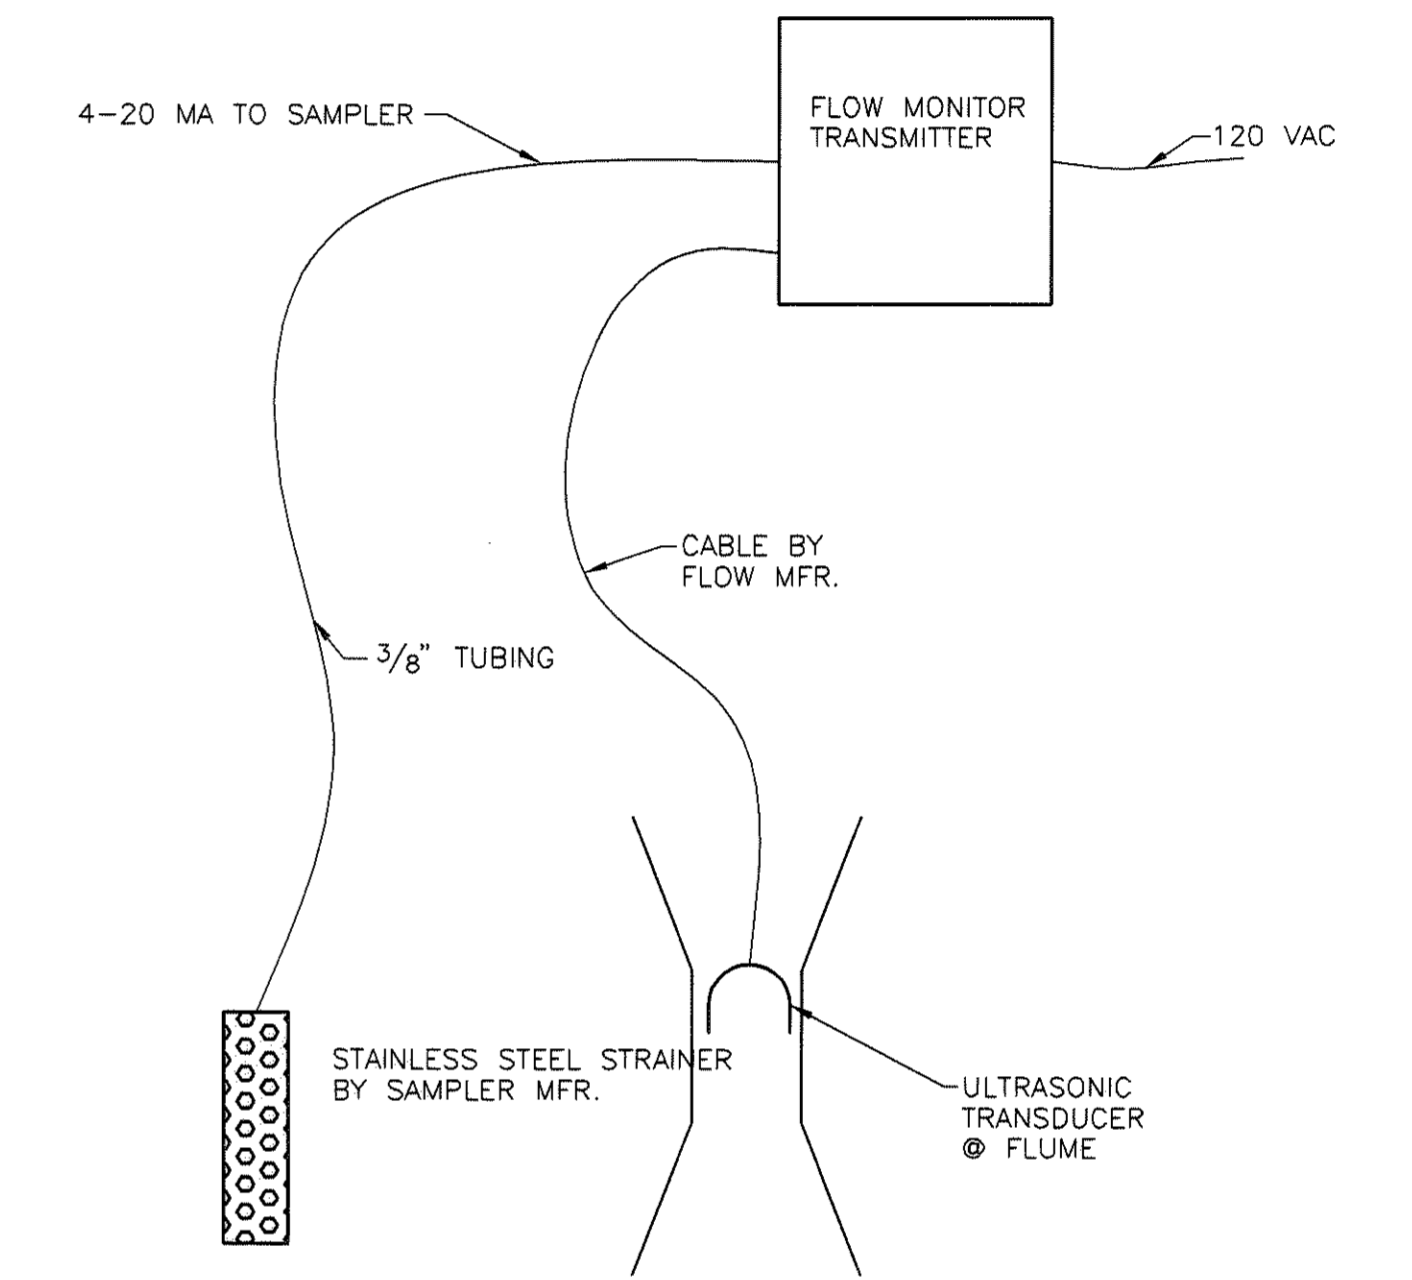


METERING/SAMPLING CONTROLS DIAGRAM

REVISED "AS-BUILT" DRAWING

THIS DRAWING HAS BEEN REVISED IN ACCORDANCE WITH NOTES ON "RECORD DRAWINGS" FURNISHED BY THE CONTRACTOR AND WITH EXECUTED CHANGE ORDERS. TO THE BEST OF OUR KNOWLEDGE AND BELIEF, THIS DRAWING SHOWS ACTUAL "AS-BUILT" CONDITIONS.

COMMONWEALTH ENGINEERS, INC.

REVISED DATE: 10/06
 BY: JCW, CK, BY: CWW

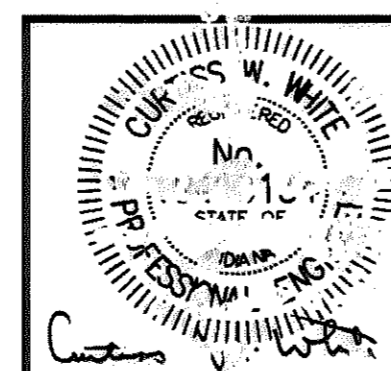

COMMONWEALTH ENGINEERS, INC.


DRAWN BY: CB
 DESIGNED BY: CWW
 CHECKED BY: CWW
 DATE: 12/03
 JOB NO: S02119-02
 SCALE: AS NOTED

SALAMONIE RESERVOIR
 WASTEWATER TREATMENT PLANT IMPROVEMENTS PROJECT
 PUBLIC WORKS PROJECT NO. E031410M
 BLOWER AND CONTROL DETAIL

DRAWING NO.

14

14 OF 52

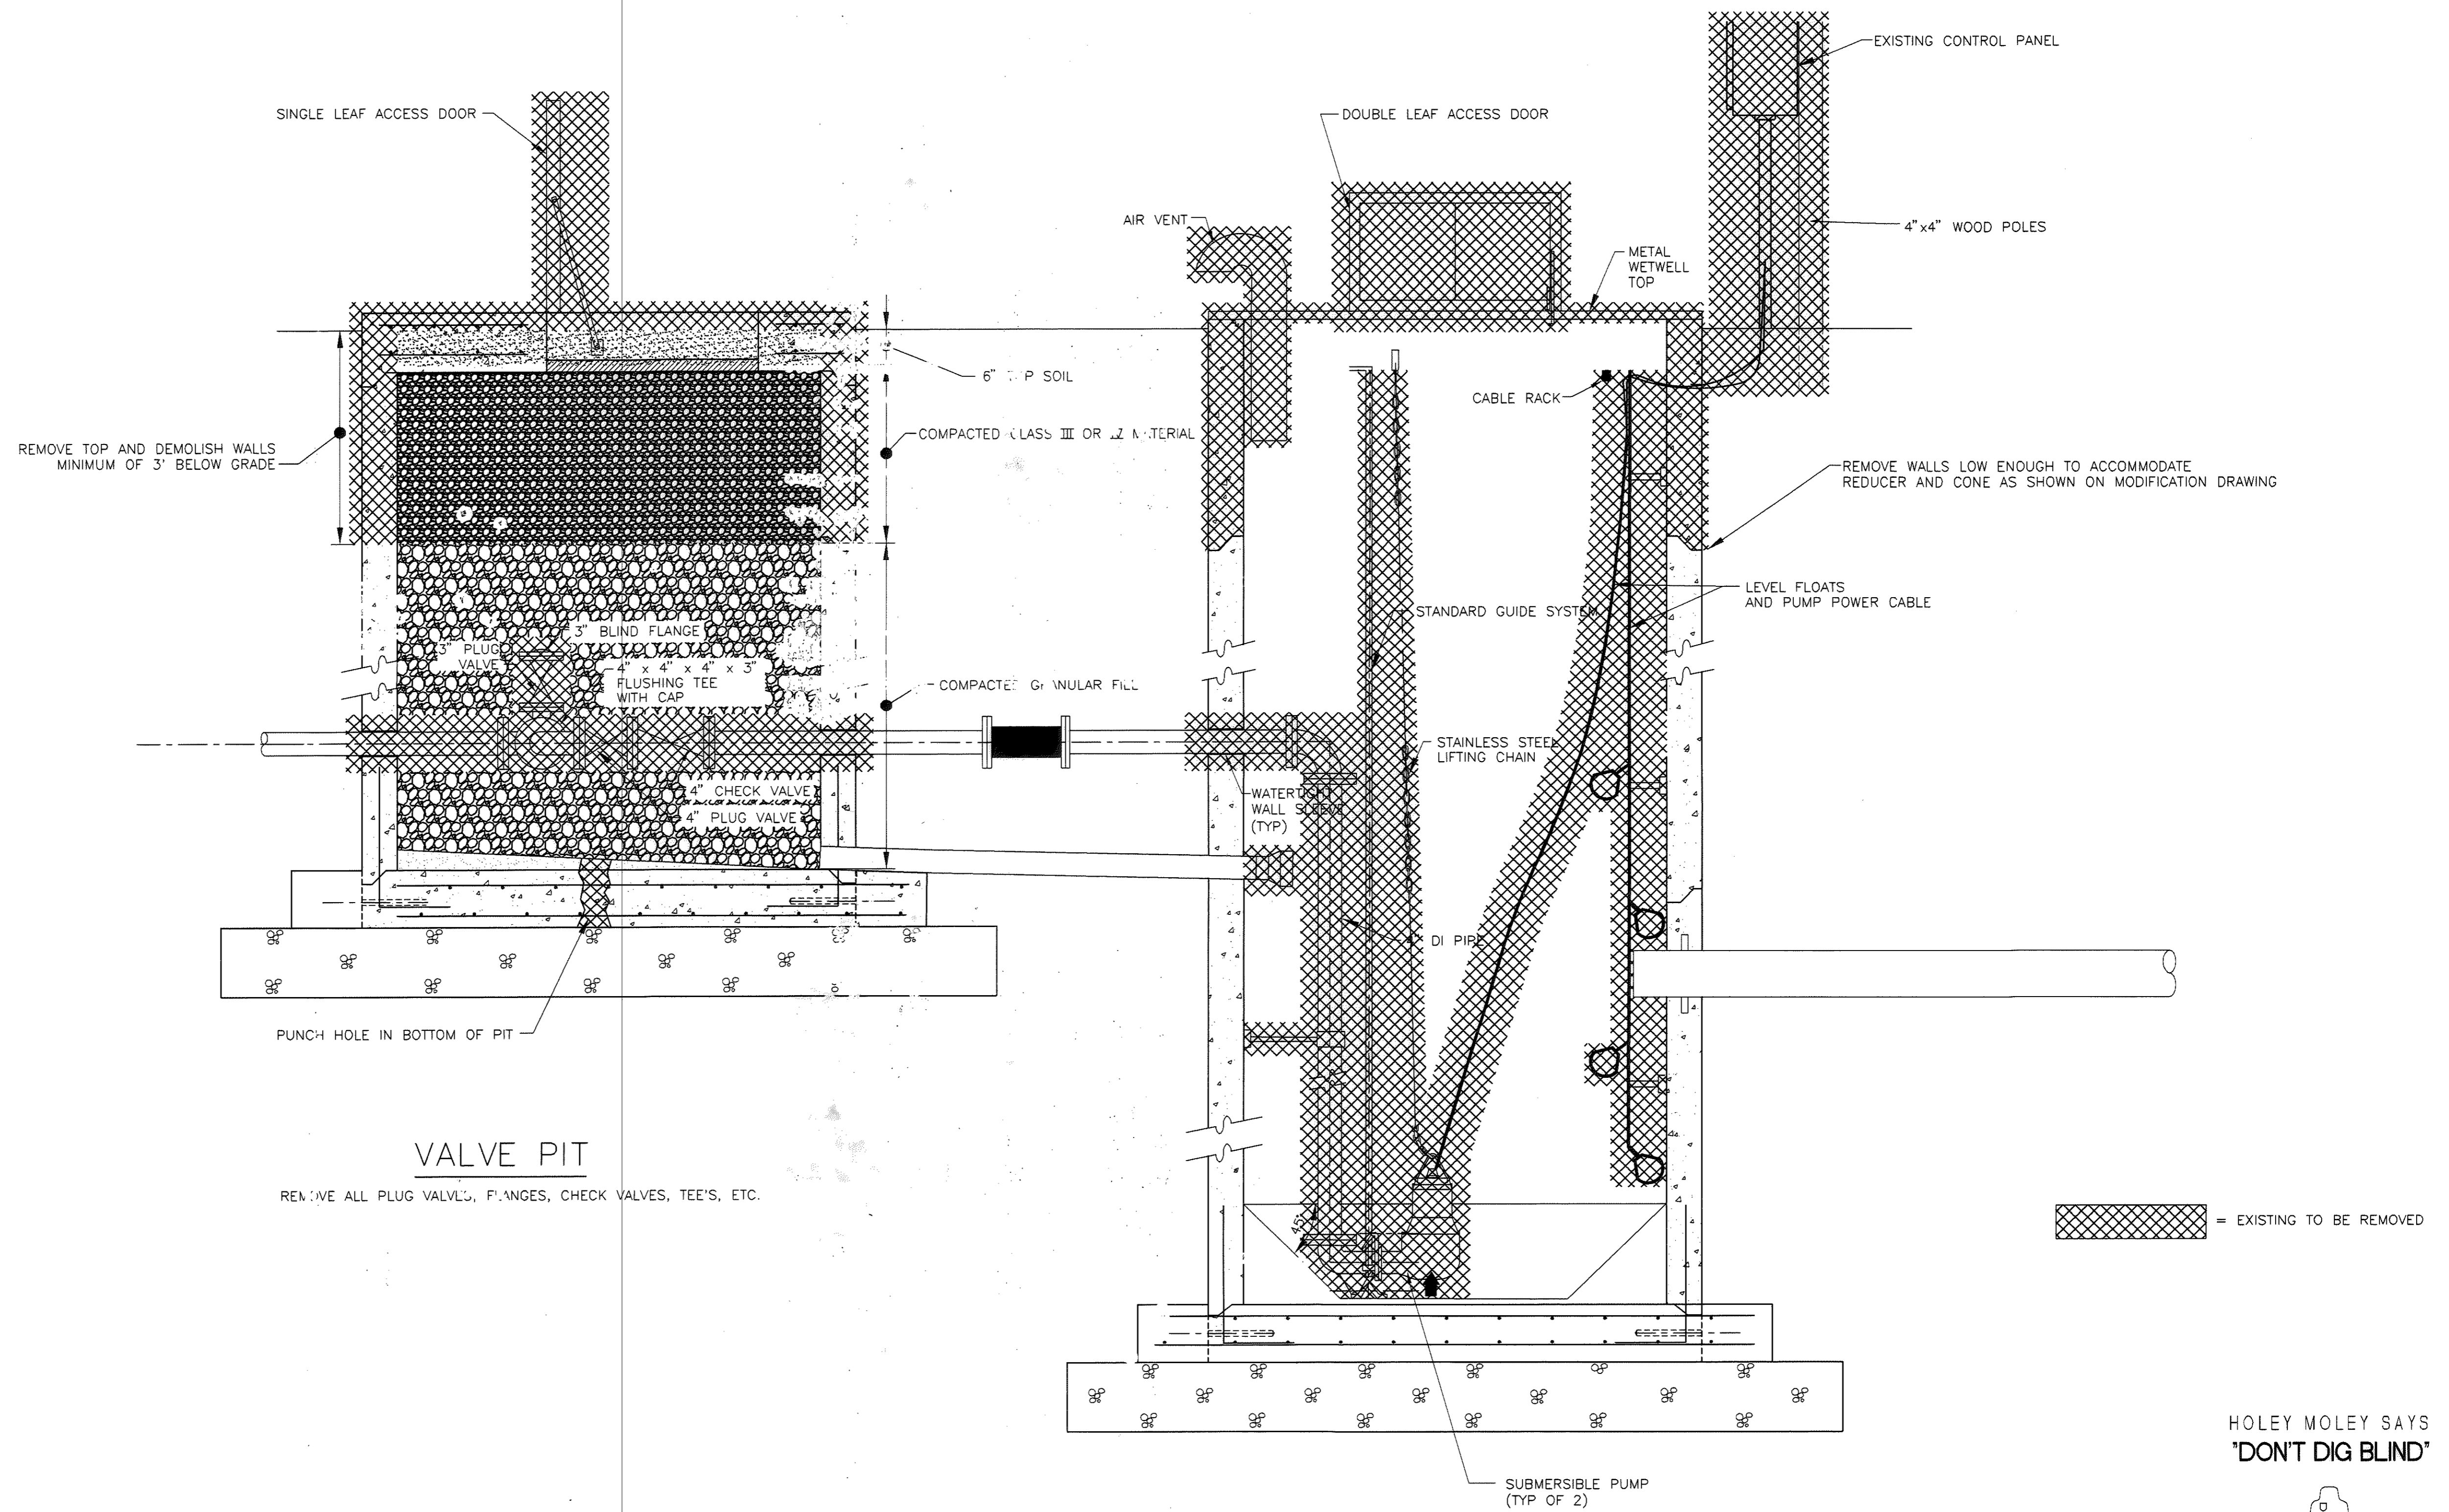

VALVE PIT
 REMOVE ALL PLUG VALVES, FLANGES, CHECK VALVES, TEE'S, ETC.

WET WELL
 1. REMOVE ALL PUMPS, ELECTRICAL LINES, CHAINS, CHECK VALVE SUPPORTS, FLOATS, PIPING, GUIDE RAILS, ETC.
 2. CLEAN WETWELL OF ALL DEBRIS.
 3. REMOVE ALL CONTROL PANELS, DISCONNECTS, JUNCTION BOXES, ETC.


= EXISTING TO BE REMOVED

HOLEY MOLEY SAYS
 "DON'T DIG BLIND"



CALL 2 WORKING DAYS BEFORE YOU DIG
 1-800-382-5544
 (IT'S THE LAW)

REVISED "AS-BUILT" DRAWING
 THIS DRAWING HAS BEEN REVISED IN ACCORDANCE WITH NOTES ON "RECORD DRAWINGS" FURNISHED BY THE CONTRACTOR AND WITH EXECUTED CHANGE ORDERS. TO THE BEST OF OUR KNOWLEDGE AND BELIEF, THIS DRAWING SHOWS ACTUAL "AS-BUILT" CONDITIONS.
 COL. COMMONWEALTH ENGINEERS, INC.
 REVISED: DATE 10/06
 BY JCW, CK BY CWW

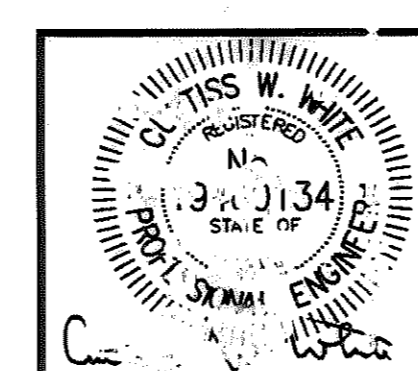


COMMONWEALTH ENGINEERS, INC.

DRAWN BY: CB
 DESIGNED BY: CWW
 CHECKED BY: CWW
 DATE: 1/04
 JOB NO: SO2119-02
 SCALE: AS NOTED

SALAMONIE RESERVOIR
 LOST BRIDGE WEST SRA
 PUBLIC WORKS PROJECT NO. E031410M
 CAMPGROUND LIFT STATION DEMO

DRAWING NO.
15
 15 OF 52

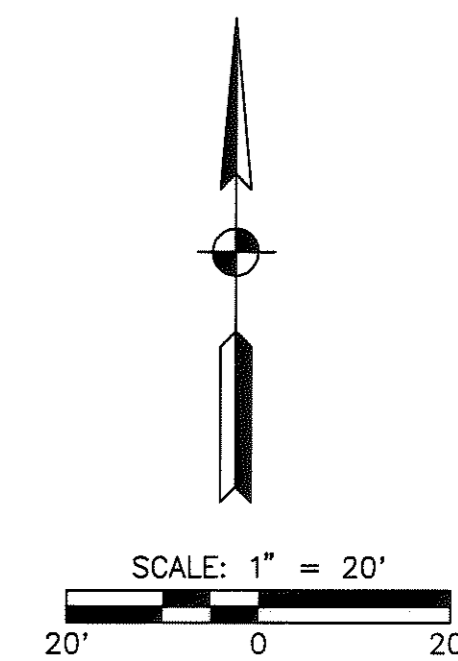

HOLEY MOLEY SAYS
 'DON'T DIG BLIND'




CALL 2 WORKING DAYS BEFORE YOU DIG
 1-800-382-5544
 (IT'S THE LAW)

REVISED "AS-BUILT" DRAWING

THIS DRAWING HAS BEEN REVISED IN ACCORDANCE WITH NOTES ON "RECORD DRAWINGS" FURNISHED BY THE CONTRACTOR AND WITH EXECUTED CHANGE ORDERS. TO THE BEST OF OUR KNOWLEDGE AND BELIEF, THIS DRAWING SHOWS ACTUAL "AS-BUILT" CONDITIONS.

COMMONWEALTH ENGINEERS, INC.
 REVISOR: DATE 10/06
 BY JCW, CK BY CWW


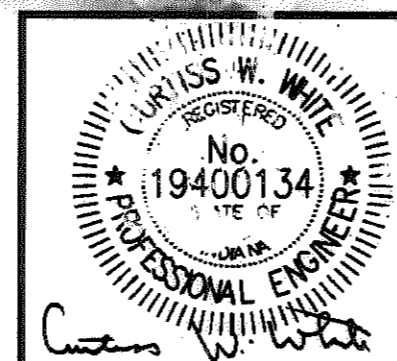


COMMONWEALTH ENGINEERS, INC.

DRAWN BY: CB
 DESIGNED BY: CWW
 CHECKED BY: CWW
 DATE: 1/04
 JOB NO: SO2119-02
 SCALE: AS NOTED

SALAMONIE RESERVOIR
 WASTEWATER TREATMENT PLANT IMPROVEMENTS PROJECT
 PUBLIC WORKS PROJECT NO. E031410M
 CAMPGROUND LIFT STATION

16-CAMPLIFT STA PLAN.dwg 20
 DRAWING NO.
16
 16 OF 52

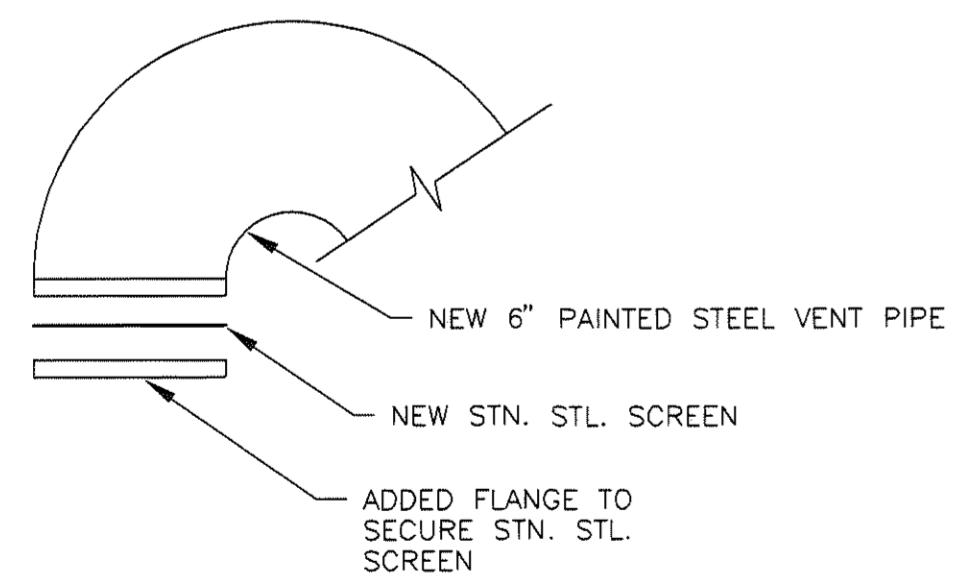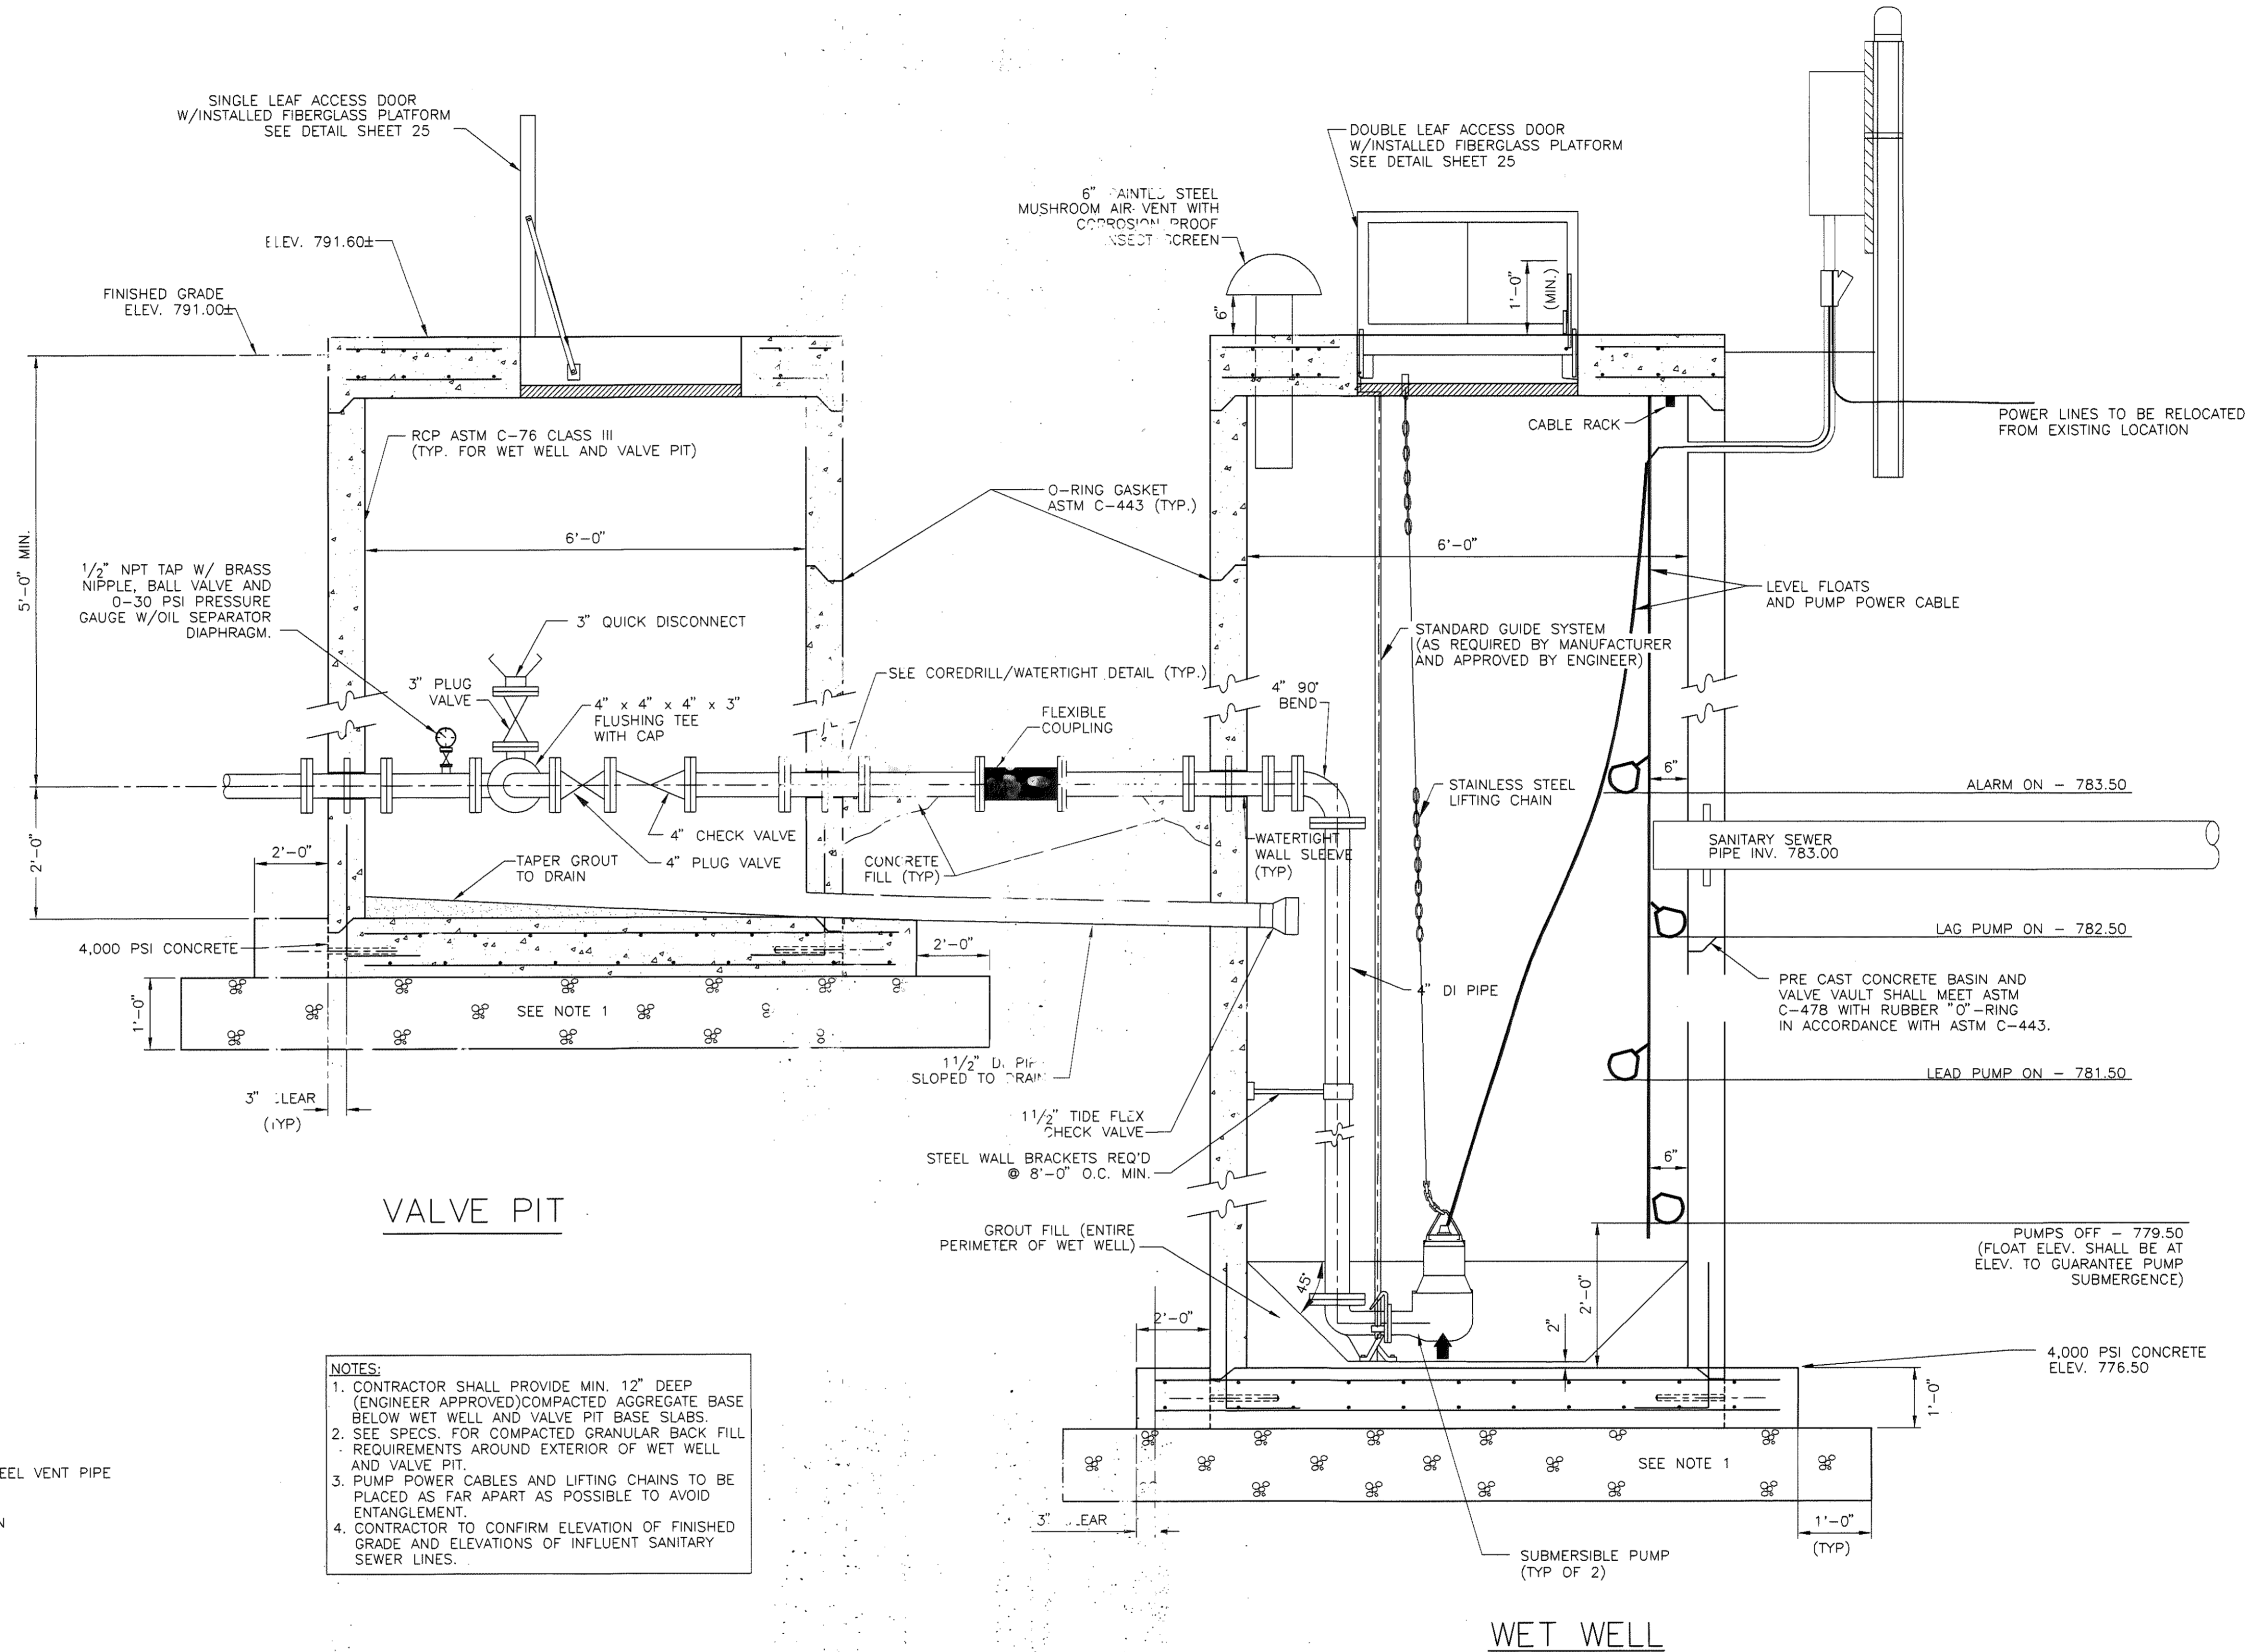

DETAIL "A"
SCALE: NONE


- NOTES:
1. CONTRACTOR SHALL PROVIDE MIN. 12" DEEP (ENGINEER APPROVED) COMPACTED AGGREGATE BASE BELOW WET WELL AND VALVE PIT BASE SLABS.
 2. SEE SPECS. FOR COMPACTED GRANULAR BACK FILL REQUIREMENTS AROUND EXTERIOR OF WET WELL AND VALVE PIT.
 3. PUMP POWER CABLES AND LIFTING CHAINS TO BE PLACED AS FAR APART AS POSSIBLE TO AVOID ENTANGLEMENT.
 4. CONTRACTOR TO CONFIRM ELEVATION OF FINISHED GRADE AND ELEVATIONS OF INFLUENT SANITARY SEWER LINES.

REVISED "AS-BUILT" DRAWING

THIS DRAWING HAS BEEN REVISED IN ACCORDANCE WITH NOTES ON "RECORD DRAWINGS" FURNISHED BY THE CONTRACTOR AND WITH EXECUTED CHANGE ORDERS. TO THE BEST OF OUR KNOWLEDGE AND BELIEF, THIS DRAWING SHOWS ACTUAL "AS-BUILT" CONDITIONS.

COMMONWEALTH ENGINEERS, INC.

REVISED: DATE 10/06
BY JCW, CK. BY CWW

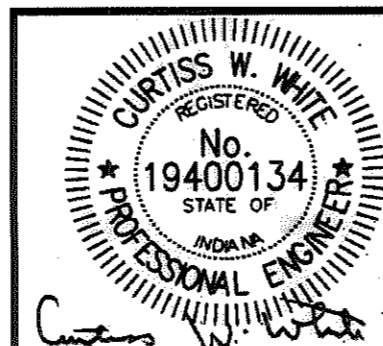

COMMONWEALTH ENGINEERS, INC.

DRAWN BY: CB
DESIGNED BY: CWW
CHECKED BY: CWW
DATE: 1/04
JOB NO: S02119-02
SCALE: AS NOTED


SALAMONIE RESERVOIR
LOST BRIDGE WEST SRA
PUBLIC WORKS PROJECT NO. E031410M
LIFT STATION SECTION AND DETAILS
CAMPGROUND LIFT STATION

DRAWING NO.
17
17 OF 52


HOLEY MOLEY SAYS
"DON'T DIG BLIND"




CALL 2 WORKING DAYS BEFORE YOU DIG
1-800-382-5544
(IT'S THE LAW)

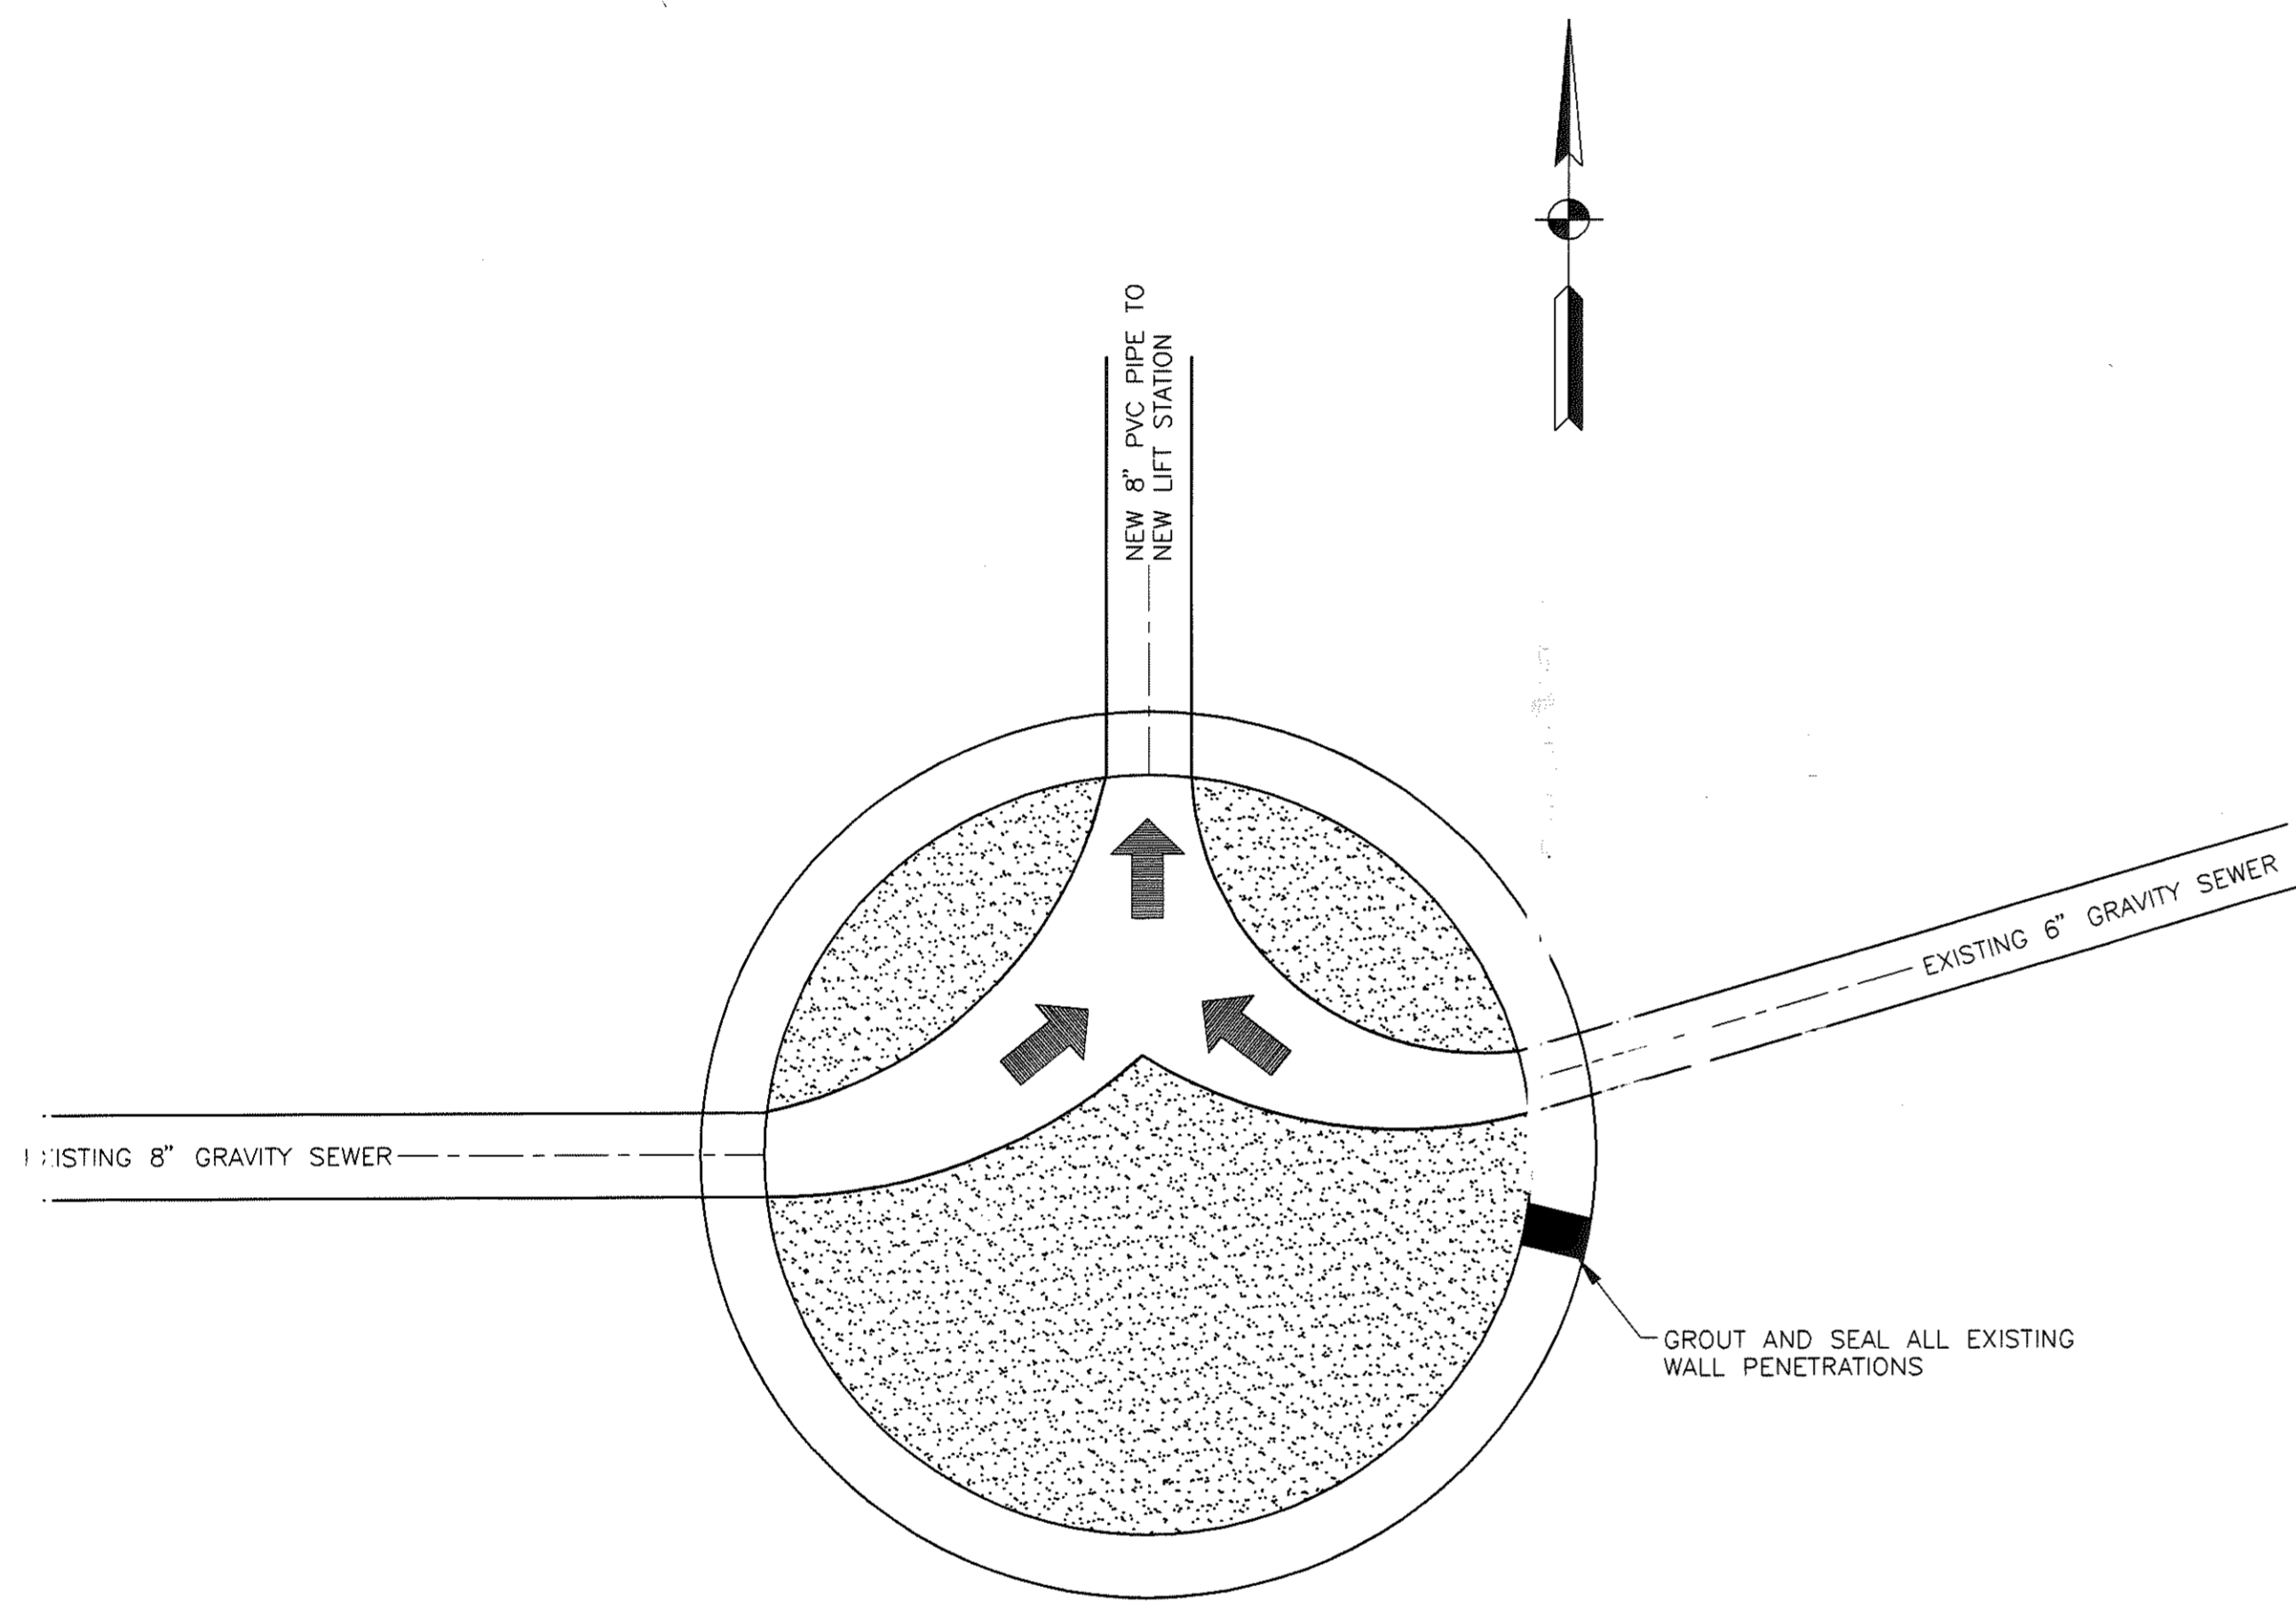

MODIFIED WETWELL BENCH LAYOUT
SCALE: 3/4" = 1'-0"

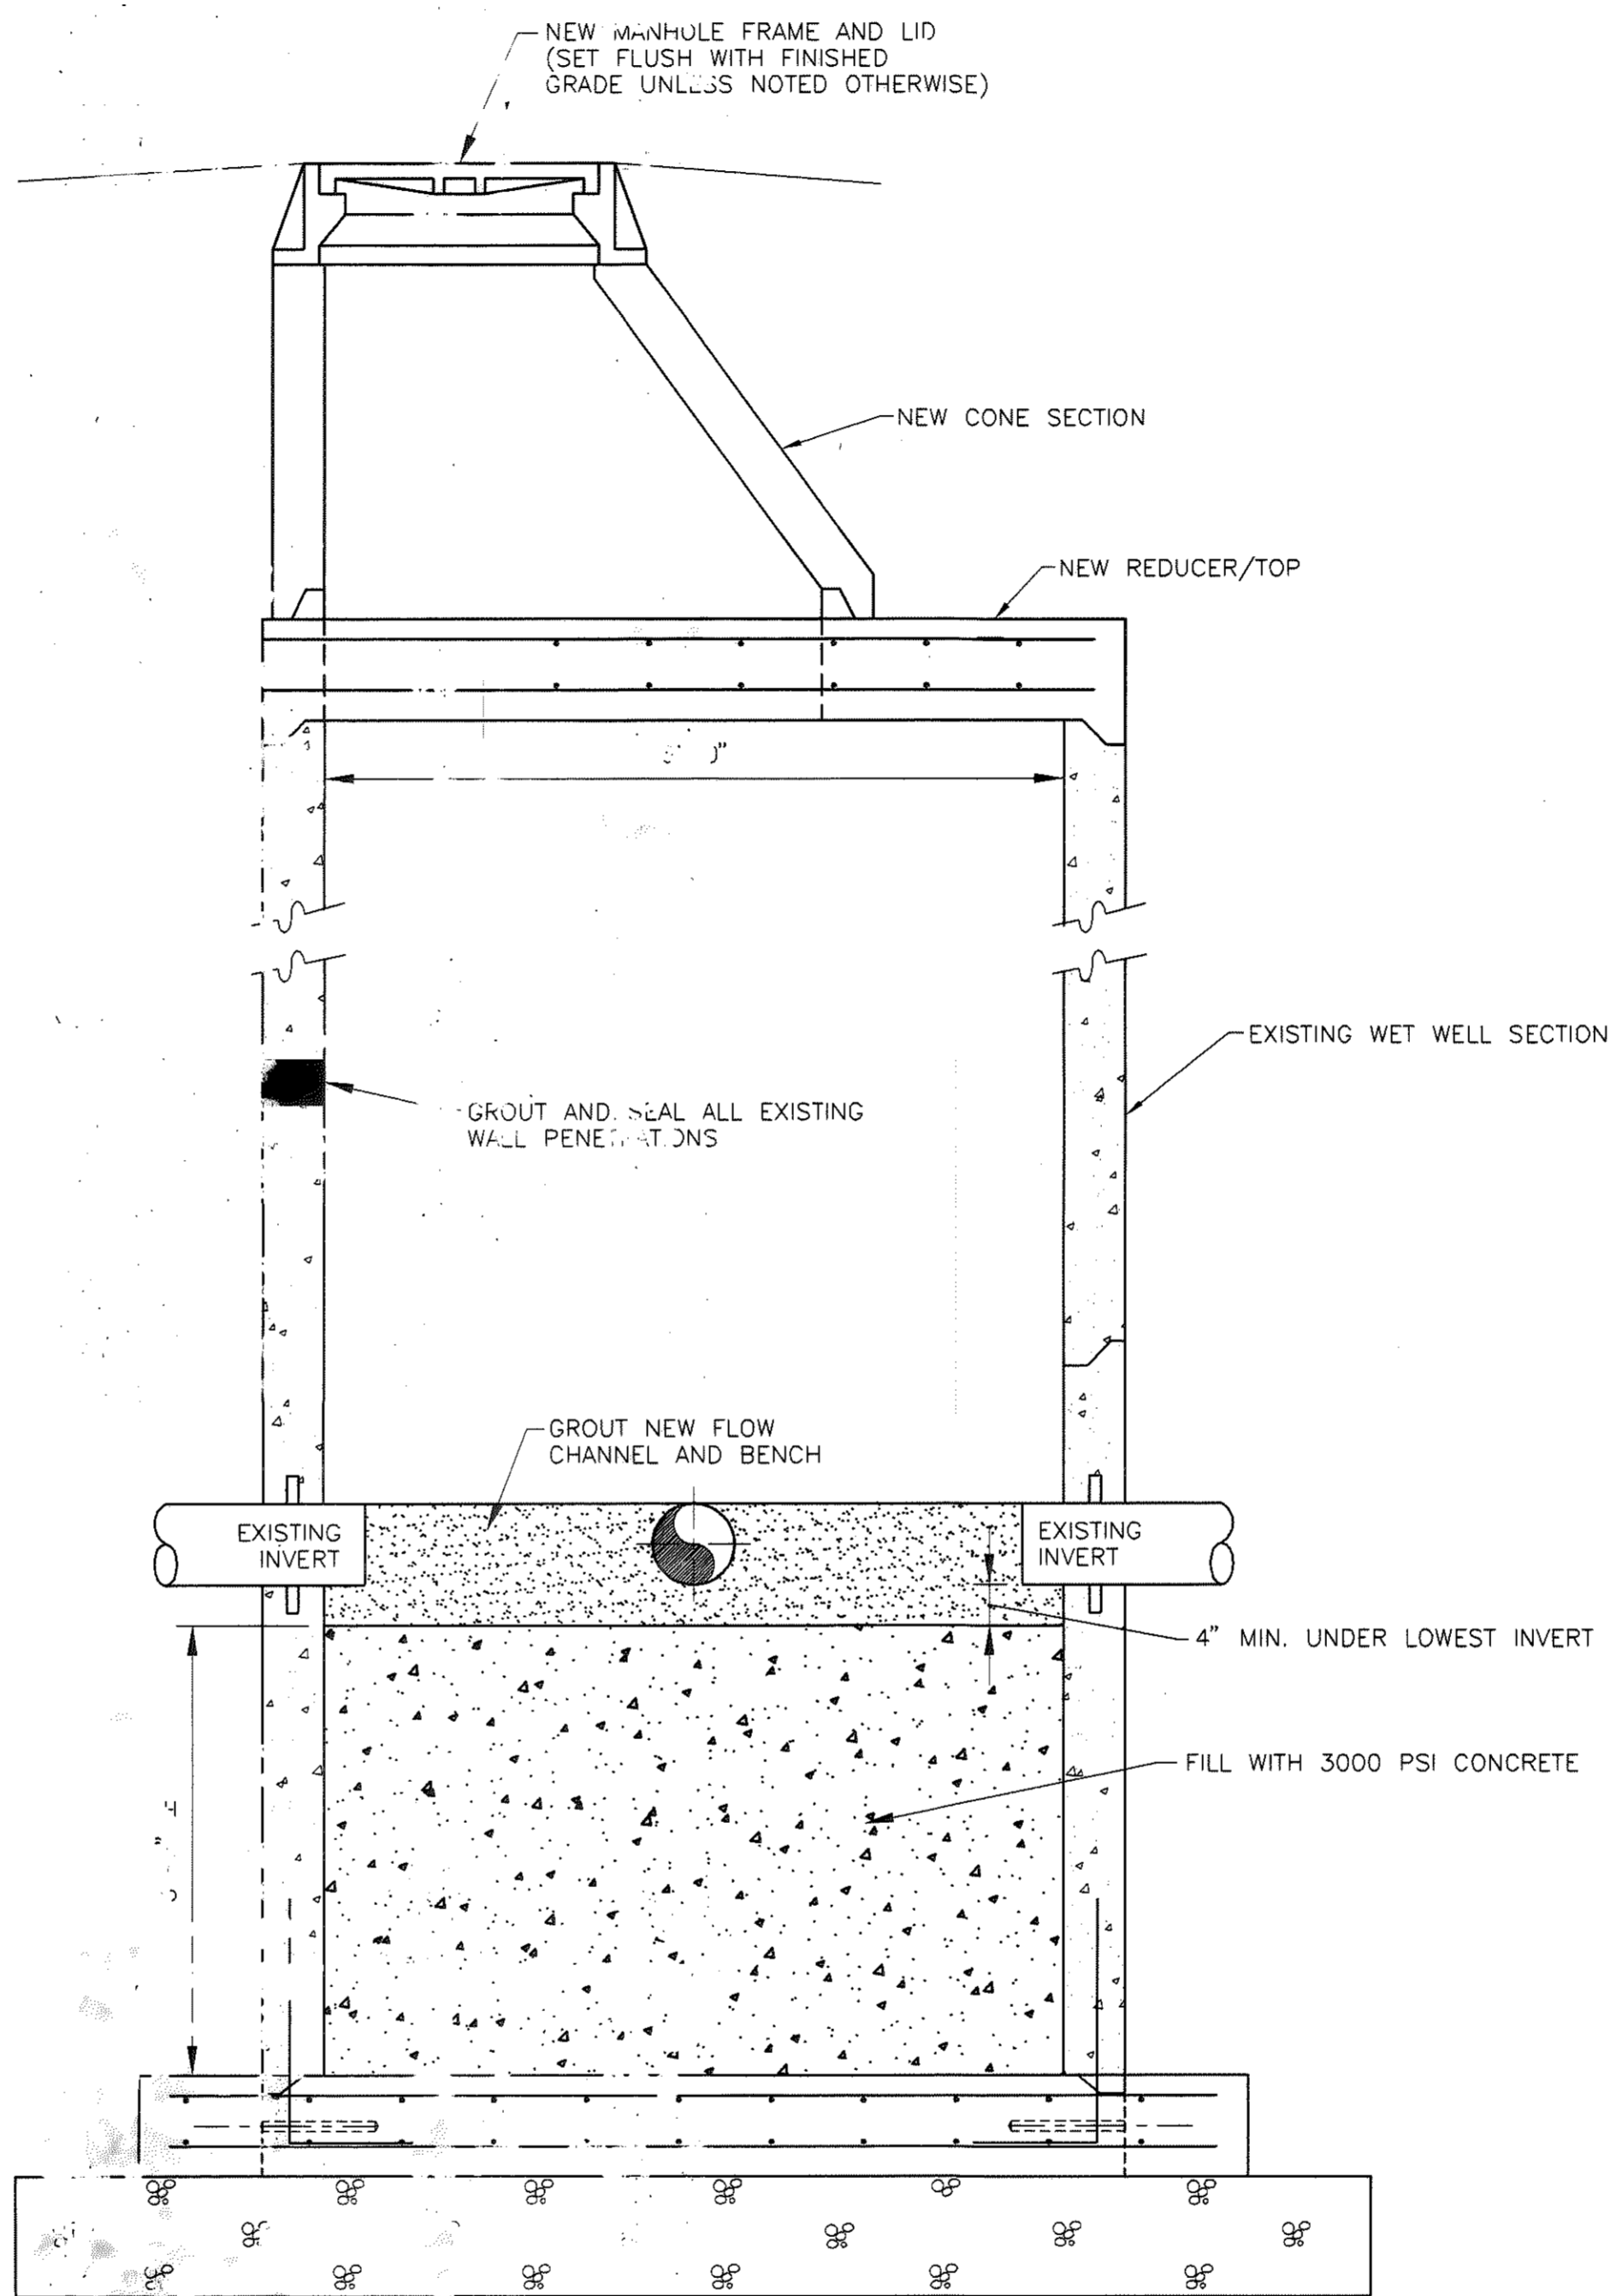

MODIFICATION OF EXISTING WET WELL
SCALE: 3/4" = 1'-0"

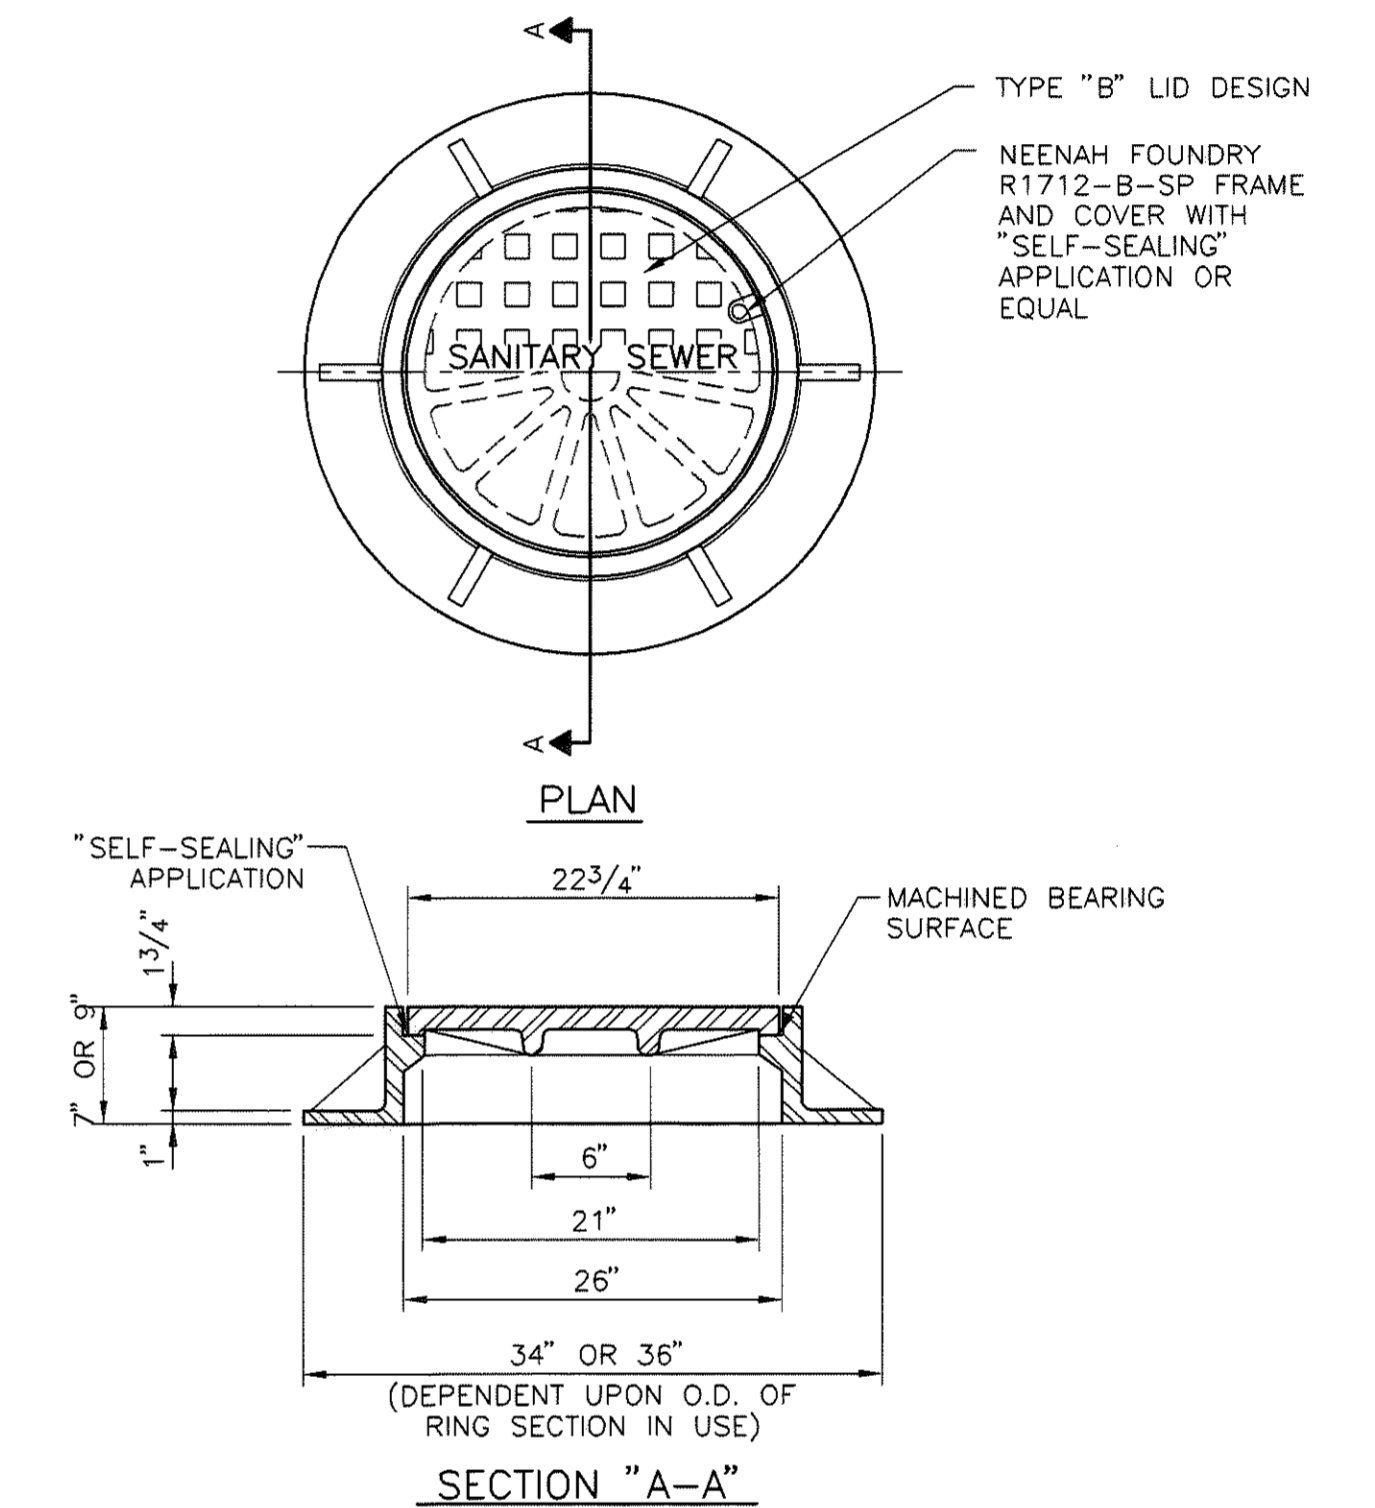

SANITARY SEWER MANHOLE
FRAME AND COVER - STANDARD MANHOLE
SCALE: NTS


HOLEY MOLEY SAYS
'DON'T DIG BLIND'



CALL 2 WORKING DAYS BEFORE YOU DIG
1-800-382-5544
(IT'S THE LAW)

18-EX. WET WELL MOD.dwg 18

REVISED "AS-BUILT" DRAWING
THIS DRAWING HAS BEEN REVISED IN ACCORDANCE WITH NOTES ON "RECORD DRAWINGS" FURNISHED BY THE CONTRACTOR AND WITH EXECUTED CHANGE ORDERS. TO THE BEST OF OUR KNOWLEDGE AND BELIEF, THIS DRAWING SHOWS ACTUAL "AS-BUILT" CONDITIONS.
COMMONWEALTH ENGINEERS, INC.
REVISED DATE: 10/06
BY: JCW, CK, BY: CWW

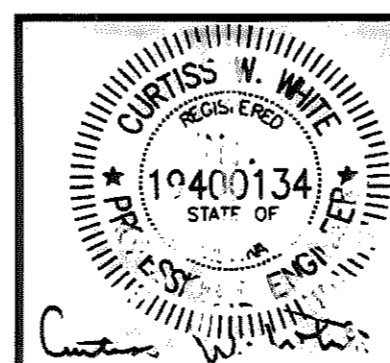


COMMONWEALTH ENGINEERS, INC.


DRAWN BY: CB
DESIGNED BY: CWW
CHECKED BY: CWW
DATE: 1/04
JOB NO: S02119-02
SCALE: AS NOTED

SALAMONIE RESERVOIR
WASTEWATER TREATMENT PLANT IMPROVEMENTS PROJECT
PUBLIC WORKS PROJECT NO. E031410M
MODIFICATION OF EXISTING WET WELL


DRAWING NO.
18
18 OF 52

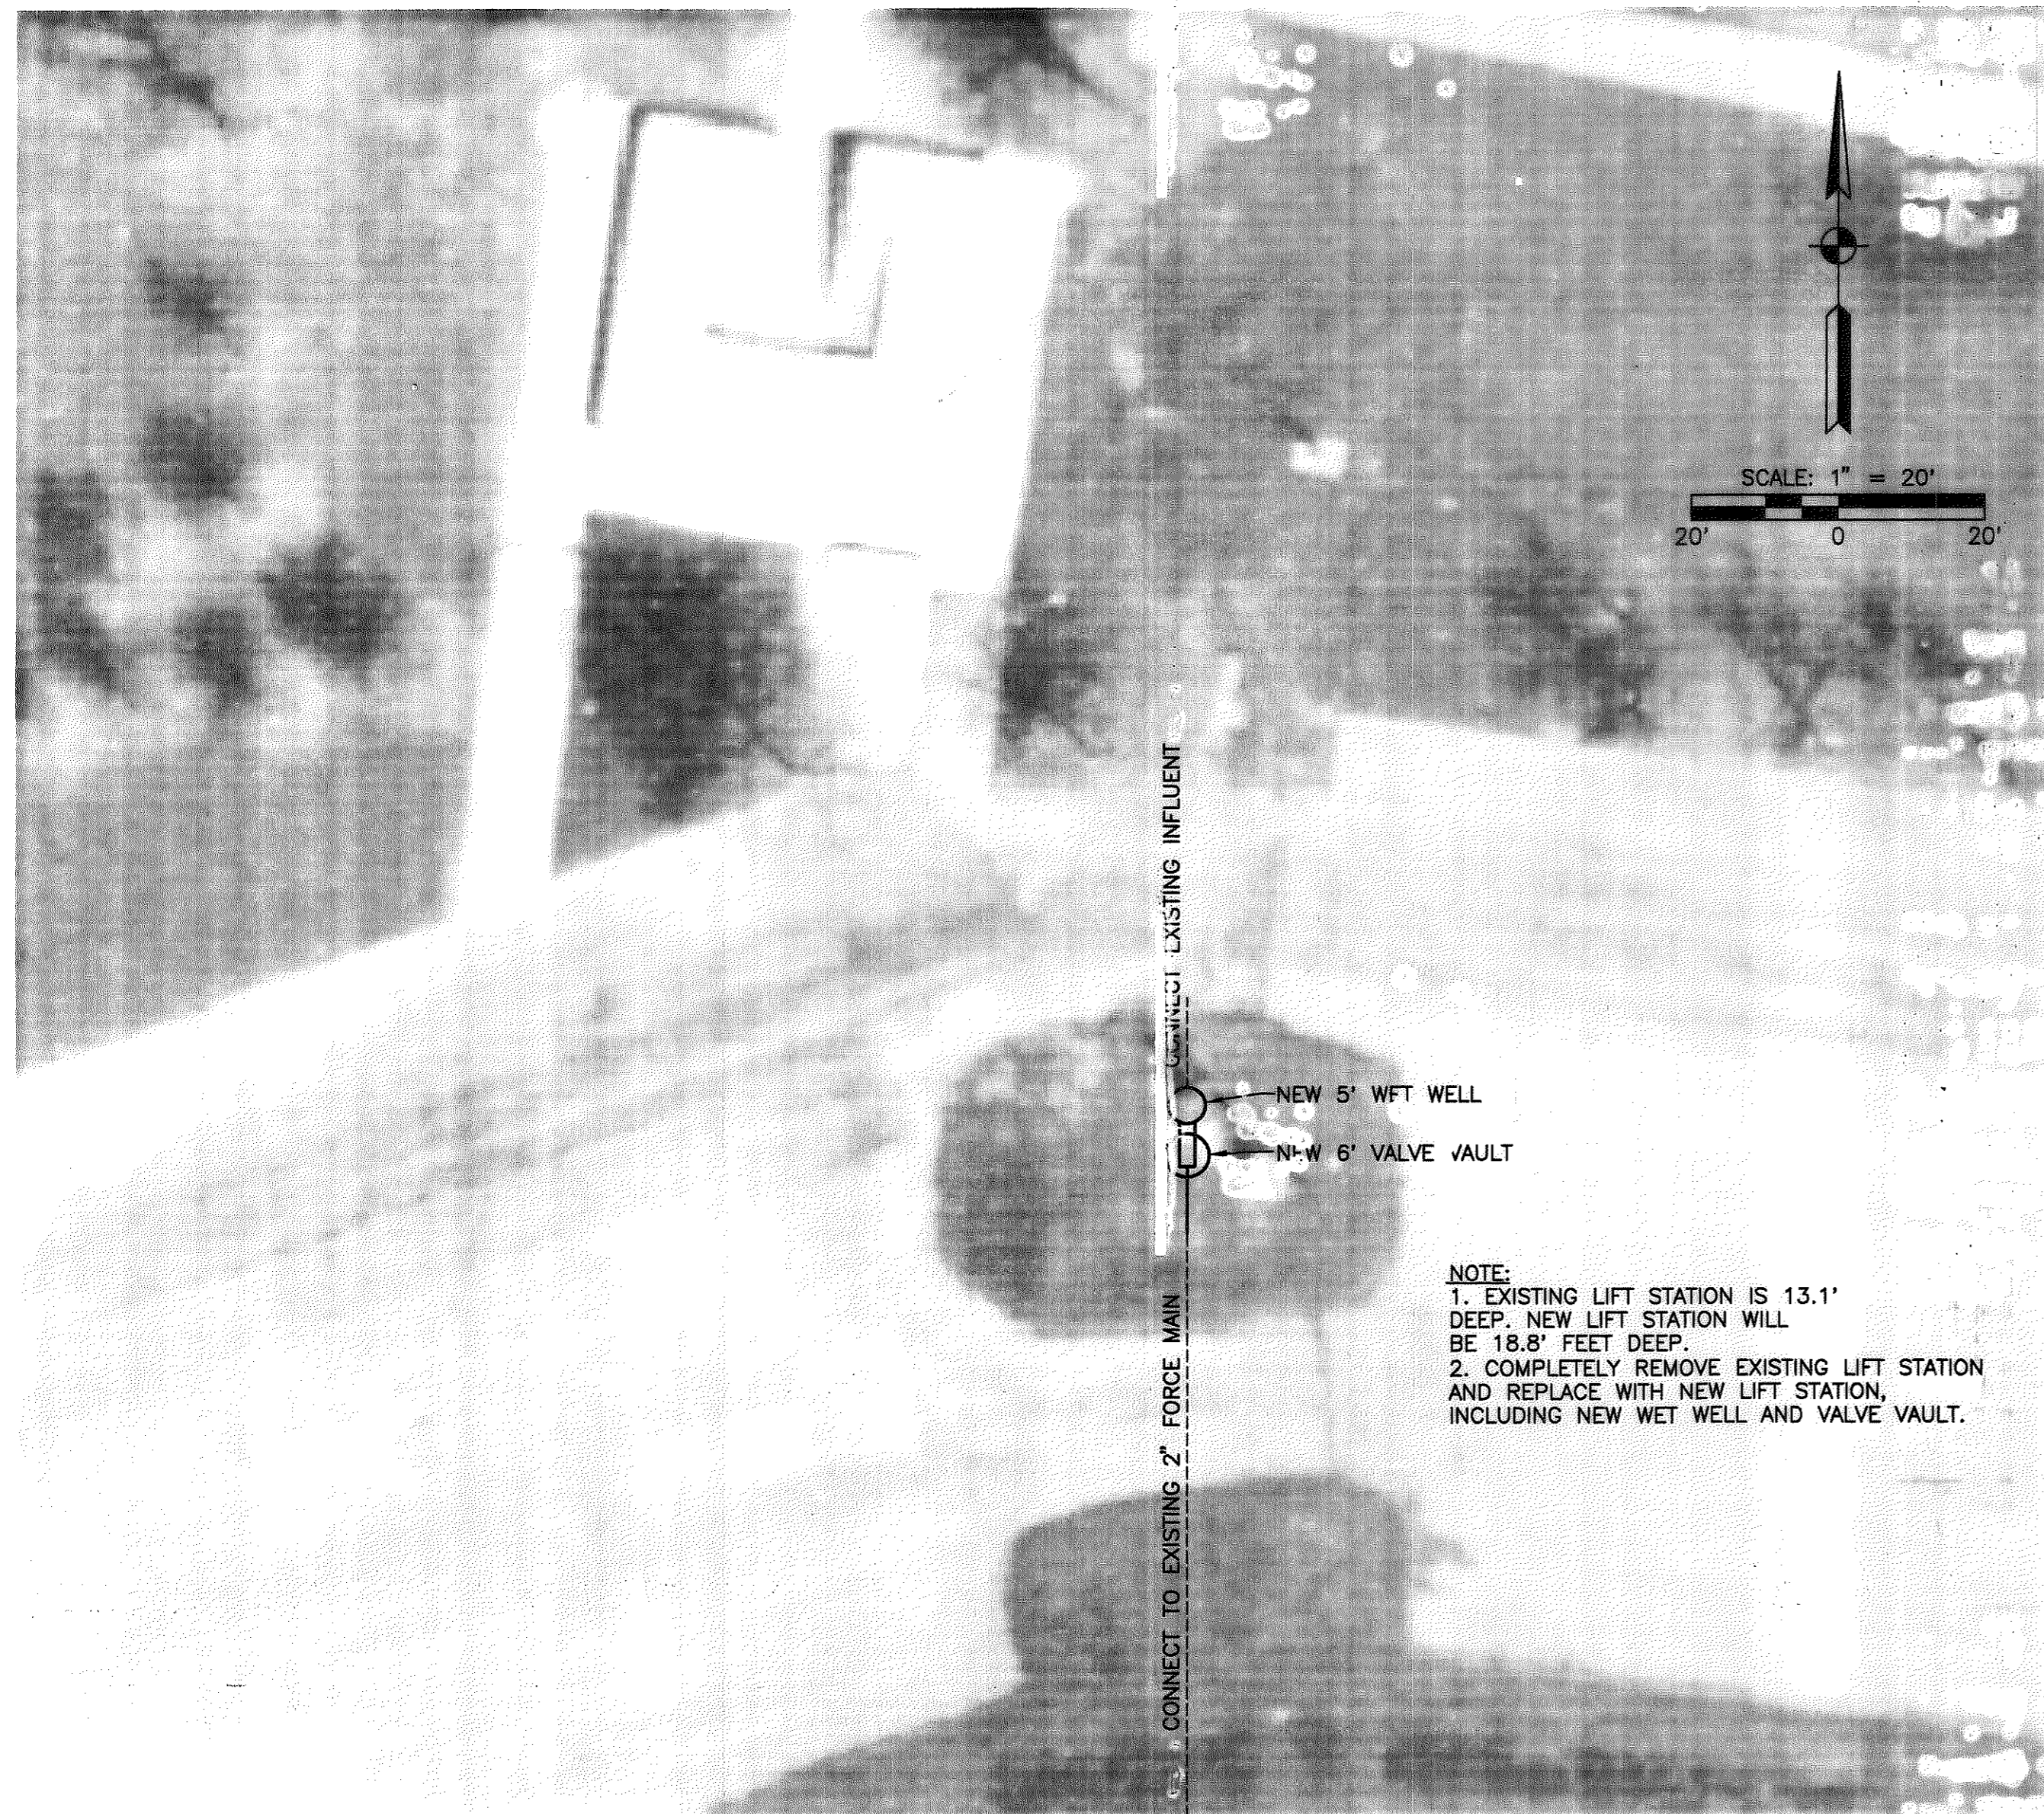

NEW SITE PLAN

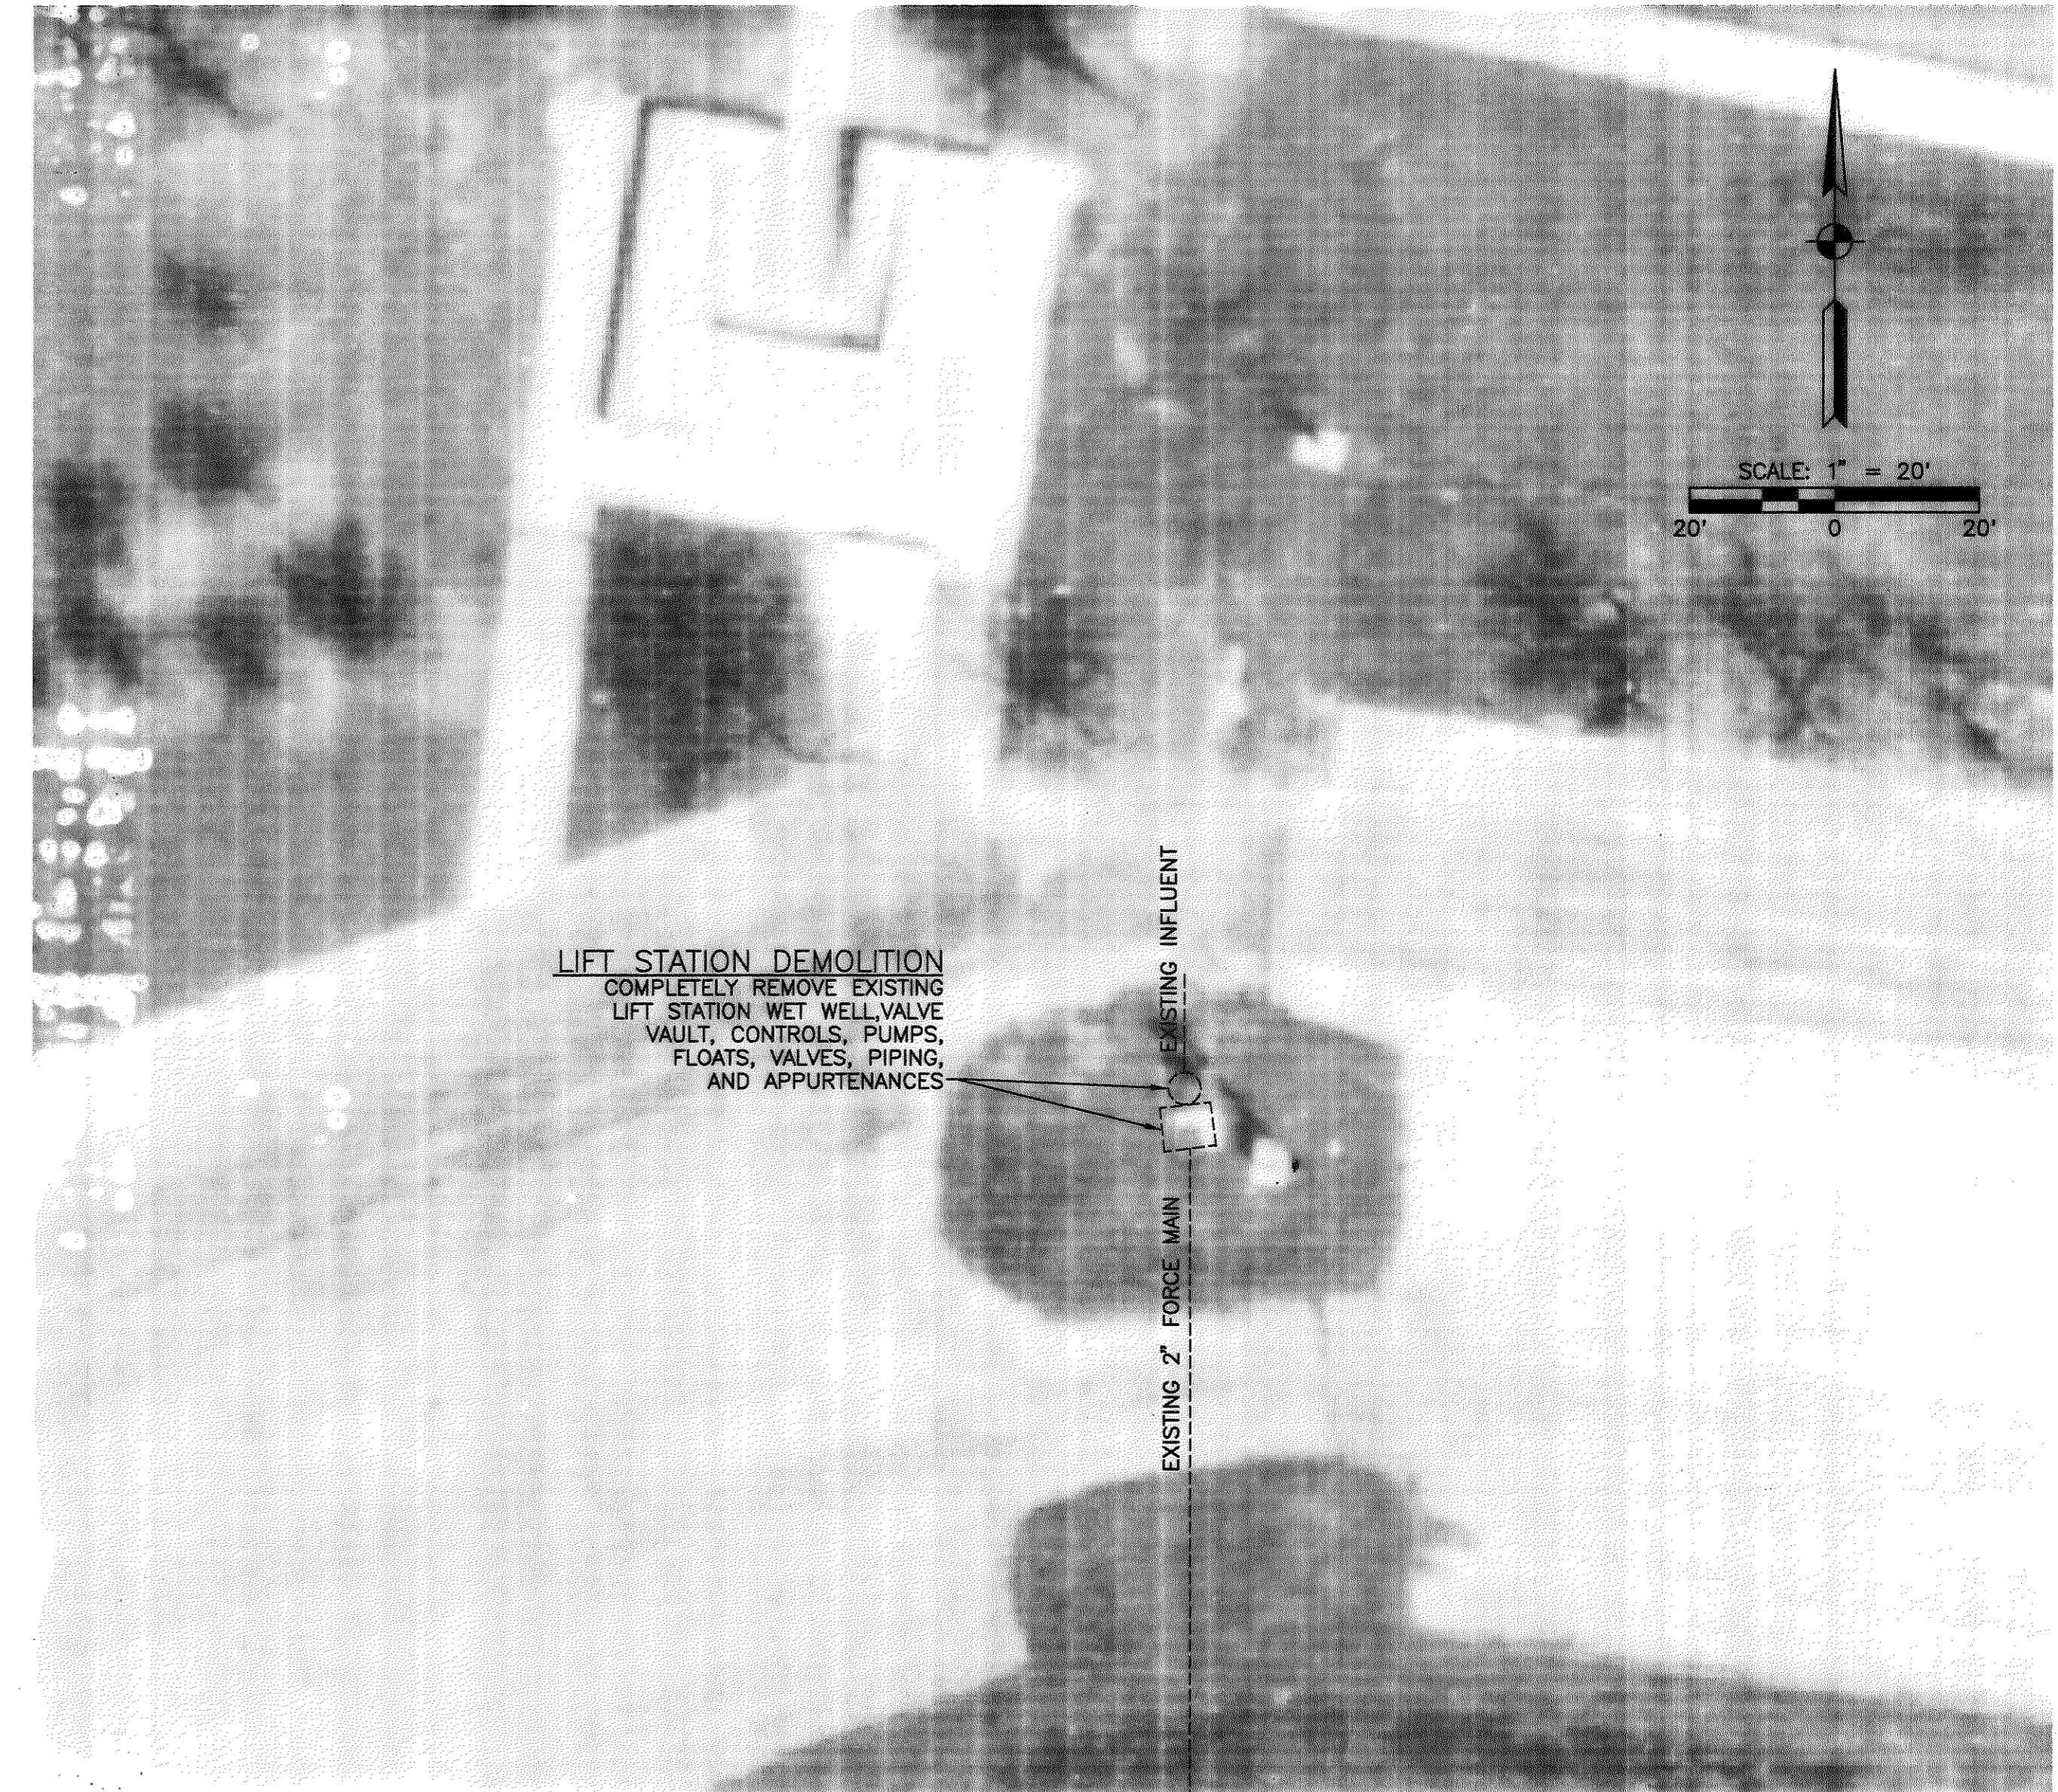

EXISTING SITE PLAN

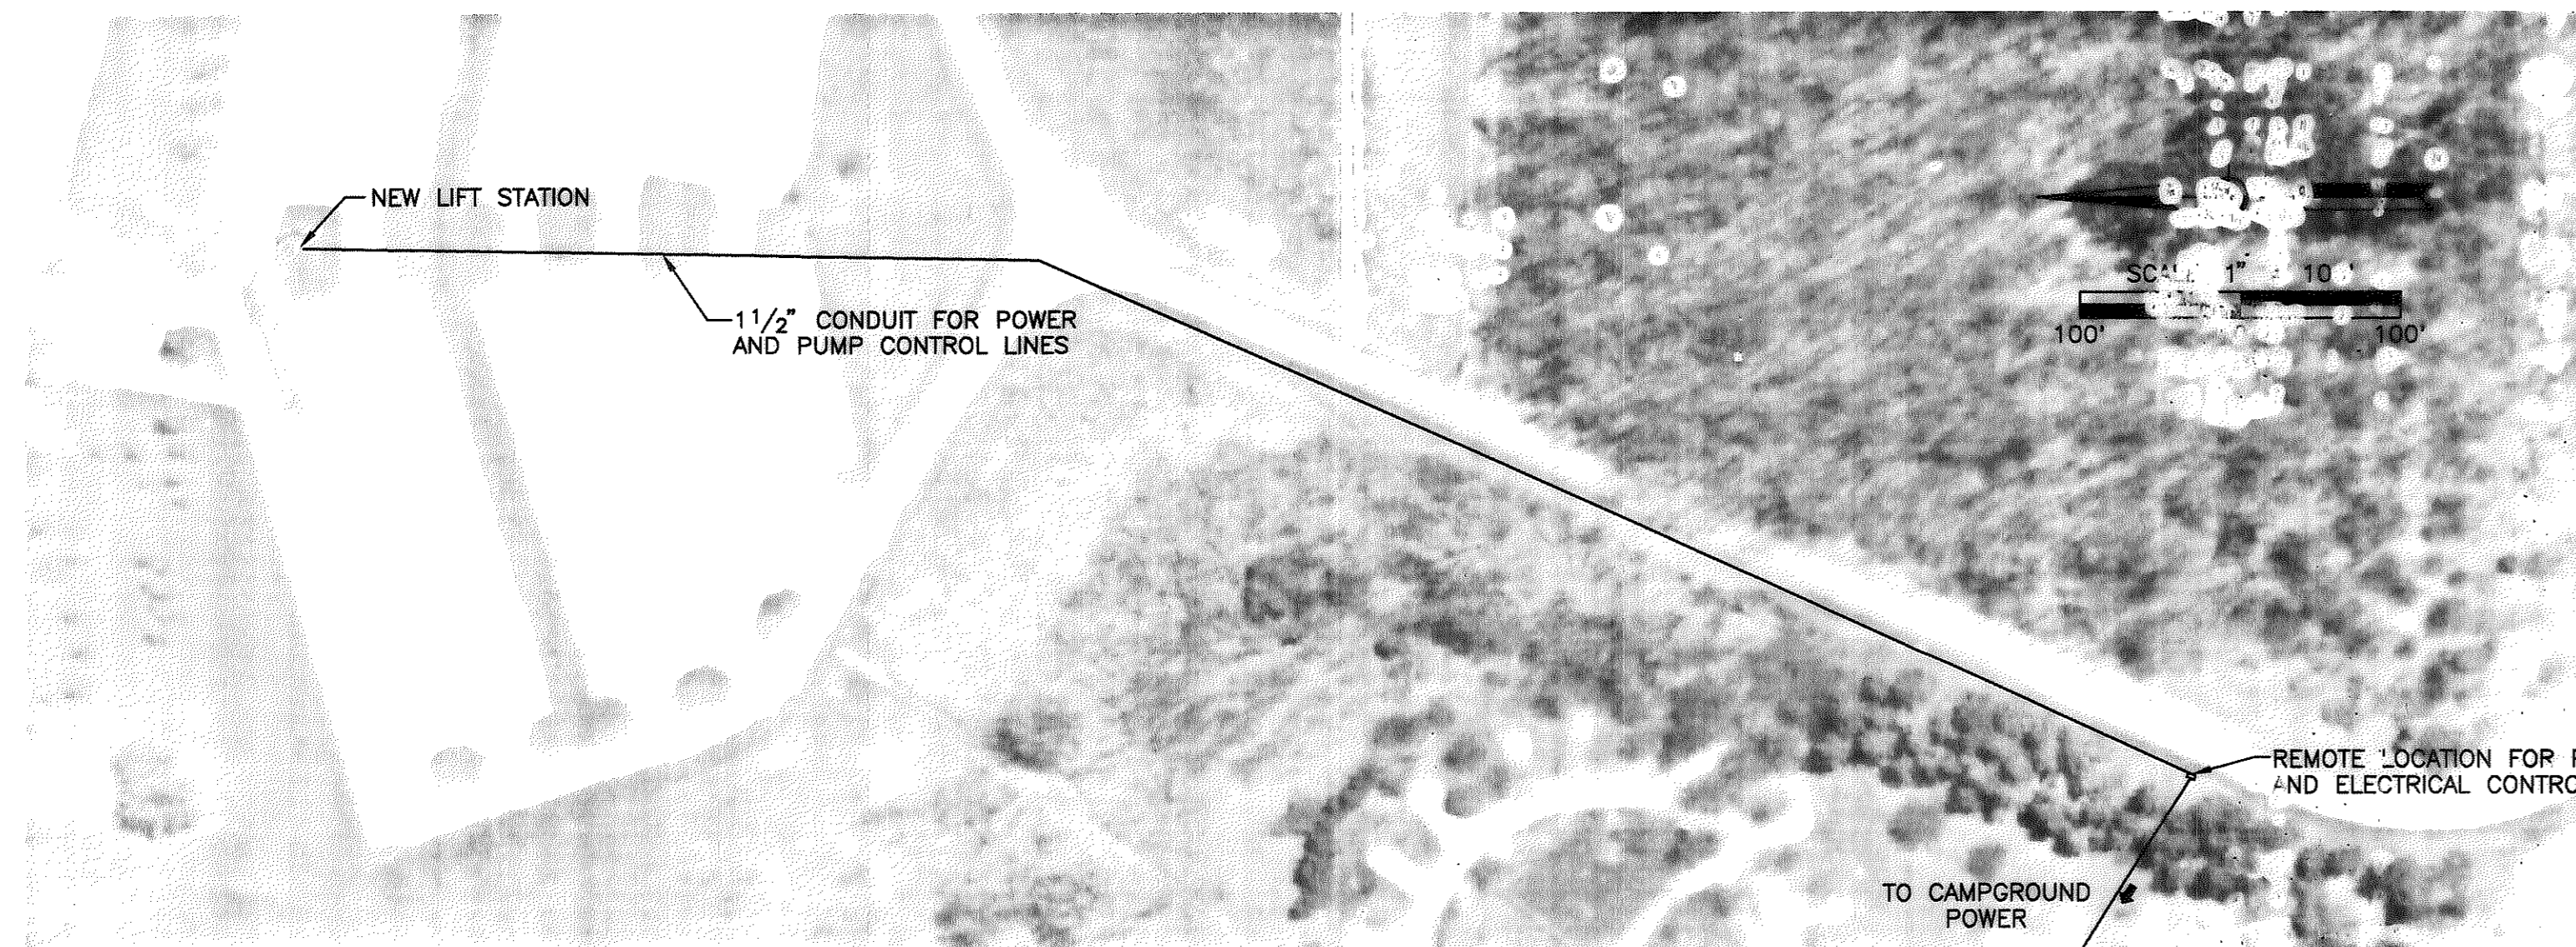

NEW UNDERGROUND ELECTRIC ROUTE

REVISED "AS-BUILT" DRAWING

THIS DRAWING HAS BEEN REVISED IN ACCORDANCE WITH NOTES ON "RECORD DRAWINGS" FURNISHED BY THE CONTRACTOR AND WITH EXECUTED CHANGE ORDERS. TO THE BEST OF OUR KNOWLEDGE AND BELIEF, THIS DRAWING SHOWS ACTUAL "AS-BUILT" CONDITIONS.


COMMONWEALTH ENGINEERS, INC.
 REVISED: DATE 10/06
 BY JCW, CK BY CWW

HOLEY MOLEY SAYS
 'DON'T DIG BLIND'



CALL 2 WORKING DAYS BEFORE YOU DIG
 1-800-382-5544
 (IT'S THE LAW)


19-BEACH-LIFTSTATION.dwg 20

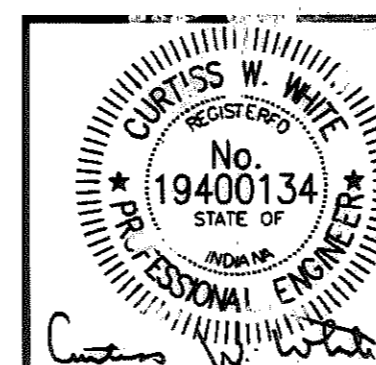

COMMONWEALTH ENGINEERS, INC.

DRAWN BY: CB	SALAMONIE RESERVOIR	DRAWING NO.
DESIGNED BY: CWW	WASTEWATER TREATMENT PLANT IMPROVEMENTS PROJECT	19
CHECKED BY: CWW	PUBLIC WORKS PROJECT NO. E031410M	
DATE: 1/04	BEACH LIFT STATION	19 OF 52
JOB NO: S02119-02		
SCALE: AS NOTED		

301-63

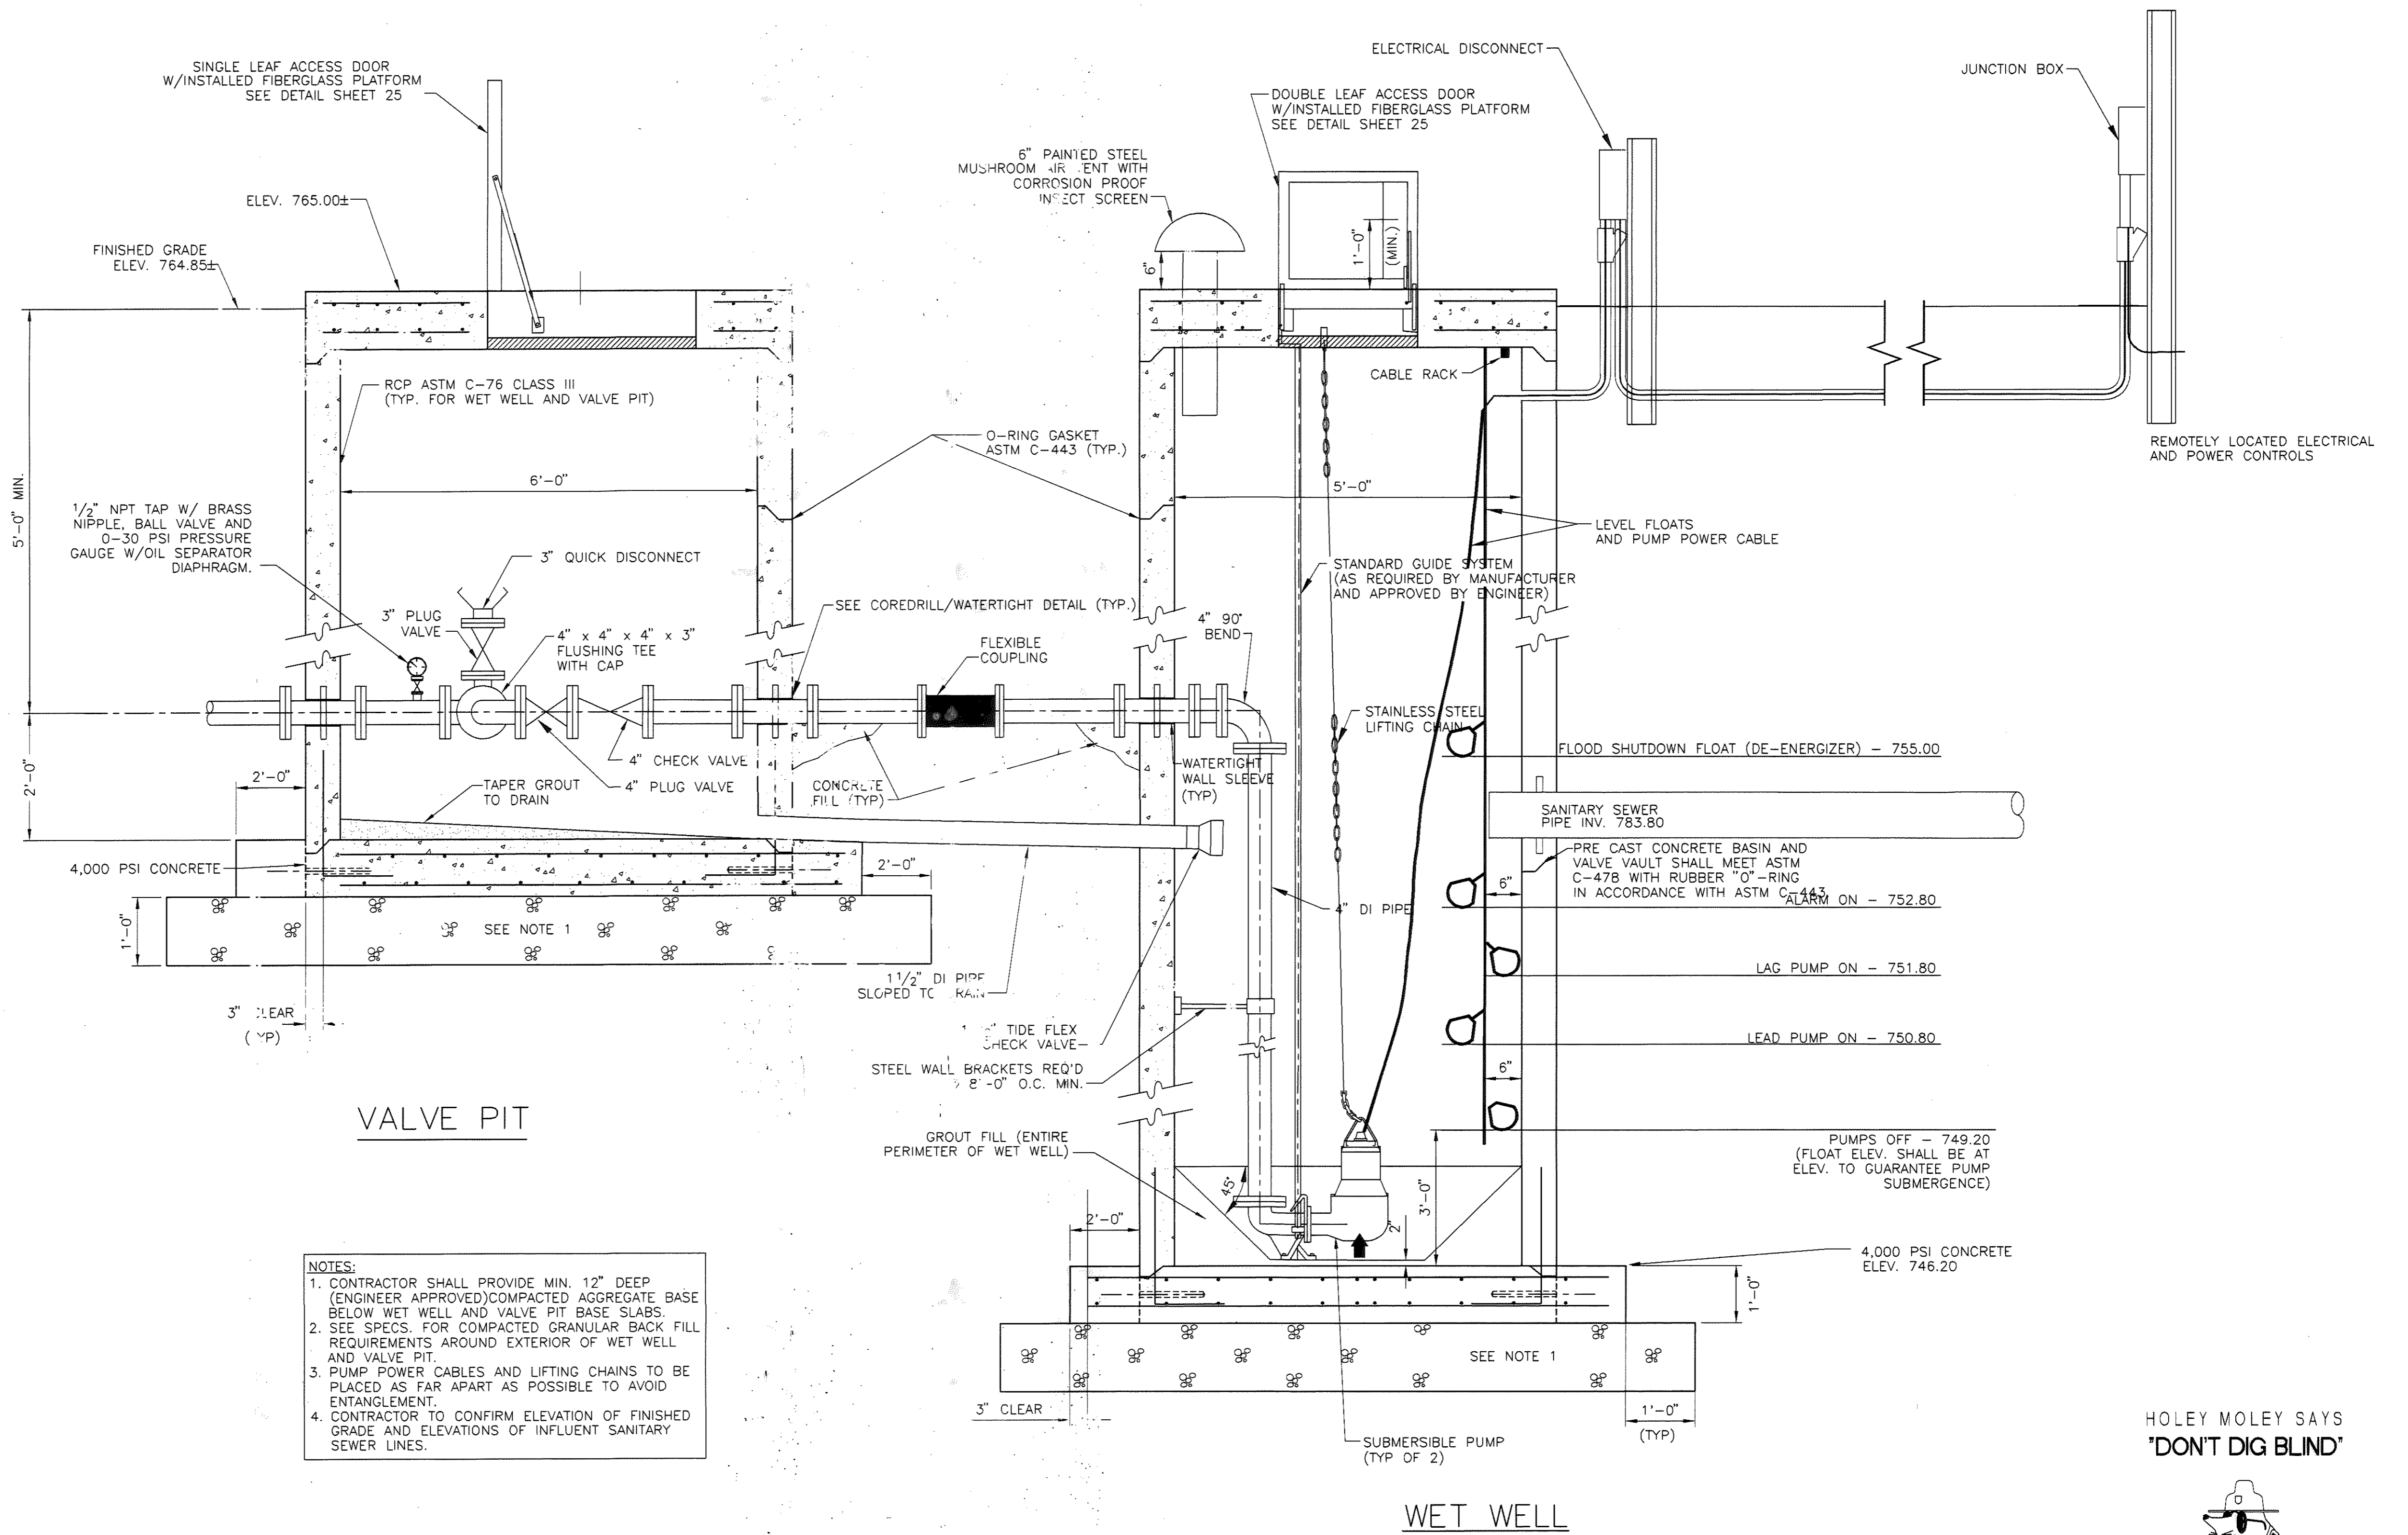


- NOTES:**
1. CONTRACTOR SHALL PROVIDE MIN. 12" DEEP (ENGINEER APPROVED) COMPACTED AGGREGATE BASE BELOW WET WELL AND VALVE PIT BASE SLABS.
 2. SEE SPECS. FOR COMPACTED GRANULAR BACK FILL REQUIREMENTS AROUND EXTERIOR OF WET WELL AND VALVE PIT.
 3. PUMP POWER CABLES AND LIFTING CHAINS TO BE PLACED AS FAR APART AS POSSIBLE TO AVOID ENTANGLEMENT.
 4. CONTRACTOR TO CONFIRM ELEVATION OF FINISHED GRADE AND ELEVATIONS OF INFLUENT SANITARY SEWER LINES.

HOLEY MOLEY SAYS
 "DON'T DIG BLIND"



CALL 2 WORKING DAYS BEFORE YOU DIG
 1-800-382-5544
 (IT'S THE LAW)

REVISED "AS-BUILT" DRAWING
 THIS DRAWING HAS BEEN REVISED IN ACCORDANCE WITH NOTES ON "RECORD DRAWINGS" FURNISHED BY THE CONTRACTOR AND WITH EXECUTED CHANGE ORDERS. TO THE BEST OF OUR KNOWLEDGE AND BELIEF, THIS DRAWING SHOWS ACTUAL "AS-BUILT" CONDITIONS.
 COMMONWEALTH ENGINEERS, INC.
 REVISED DATE: 10/06
 BY J.C.W., CK. BY C.W.W.


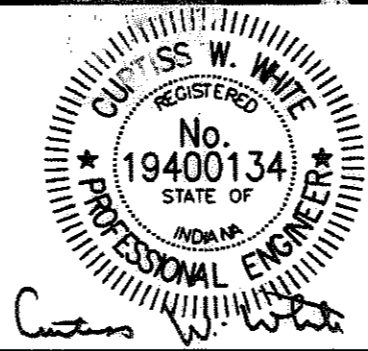


COMMONWEALTH ENGINEERS, INC.

DRAWN BY: CB
 DESIGNED BY: CWW
 CHECKED BY: CWW
 DATE: 1/04
 JOB NO: S02119-02
 SCALE: AS NOTED


SALAMONIE RESERVOIR
 LOST BRIDGE WEST SRA
 PUBLIC WORKS PROJECT NO. E031410M
 LIFT STATION SECTION AND DETAILS
 BEACH LIFT STATION

DRAWING NO.
20
 20 OF 52

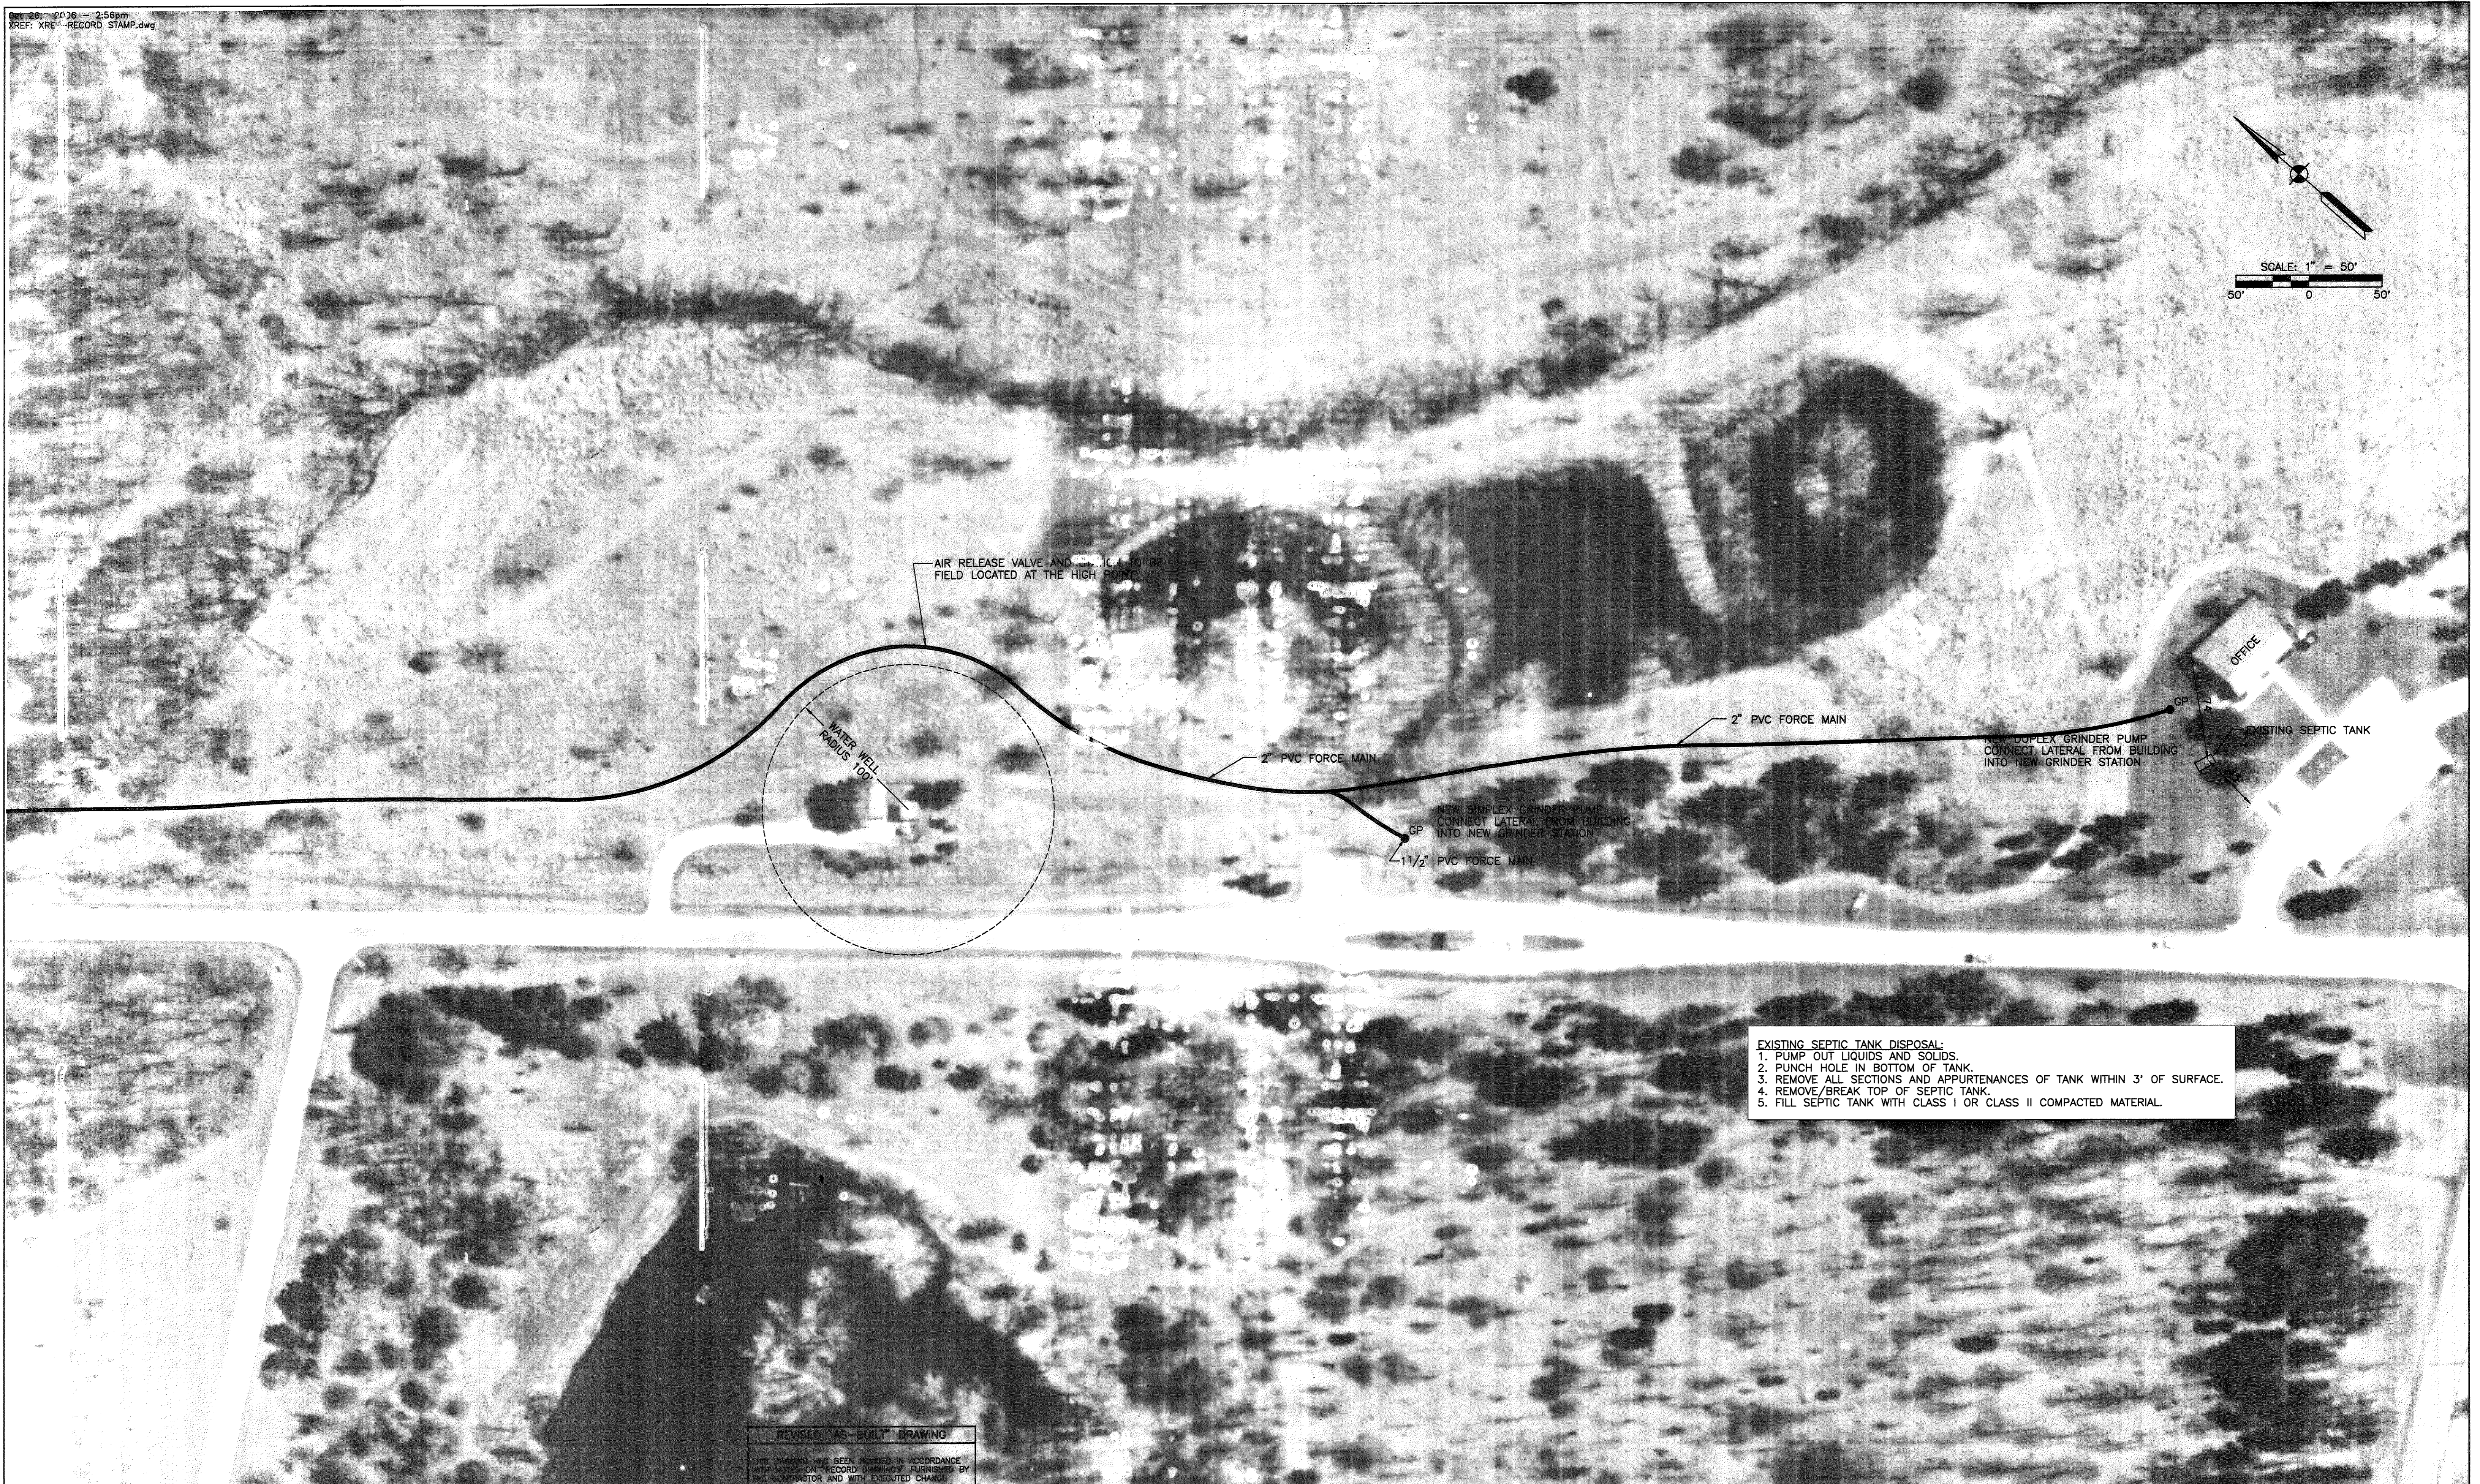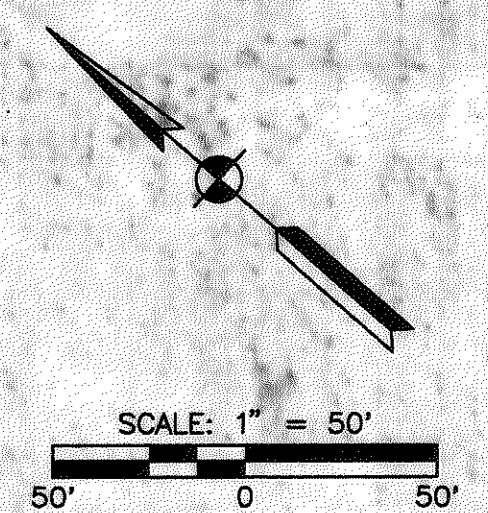

EXISTING SEPTIC TANK DISPOSAL:
 1. PUMP OUT LIQUIDS AND SOLIDS.
 2. PUNCH HOLE IN BOTTOM OF TANK.
 3. REMOVE ALL SECTIONS AND APPURTENANCES OF TANK WITHIN 3' OF SURFACE.
 4. REMOVE/BREAK TOP OF SEPTIC TANK.
 5. FILL SEPTIC TANK WITH CLASS I OR CLASS II COMPACTED MATERIAL.

REVISED "AS-BUILT" DRAWING
 THIS DRAWING HAS BEEN REVISED IN ACCORDANCE WITH NOTES ON RECORD DRAWINGS FURNISHED BY THE CONTRACTOR AND WITH EXECUTED CHANGE ORDERS TO THE BEST OF OUR KNOWLEDGE AND BELIEF THIS DRAWING SHOWS ACTUAL "AS-BUILT" CONDITIONS.
 COMMONWEALTH ENGINEERS, INC.
 REVISED DATE: 10/06
 BY: J.C.W. CK: C.W.W.

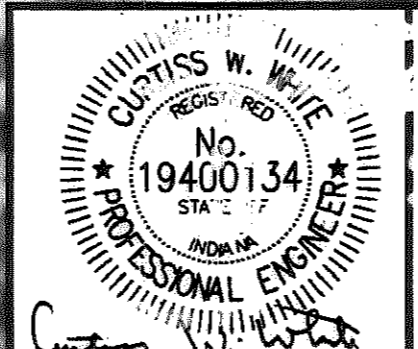


COMMONWEALTH ENGINEERS, INC.

DRAWN BY: CB
 DESIGNED BY: CWW
 CHECKED BY: CWW
 DATE: 1/04
 JOB NO: S02119-02
 SCALE: AS NOTED

SALAMONIE RESERVOIR
 WASTEWATER TREATMENT PLANT IMPROVEMENTS PROJECT
 PUBLIC WORKS PROJECT NO. E031410M
 VISITOR CENTER GRINDER STATION AND FORCEMAIN


DRAWING NO.
21
 21 OF 52

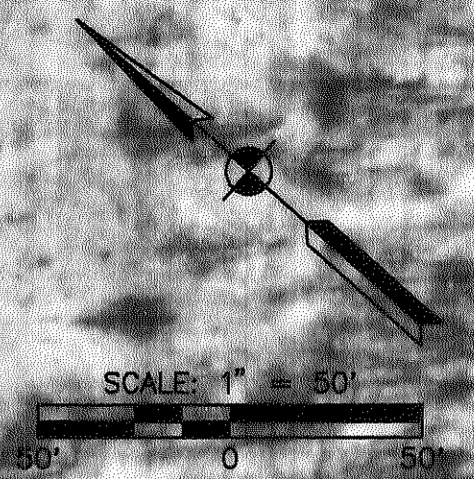

DISCHARGE INTO EXISTING MANHOLE

2" PVC FORCE MAIN

REVISED "AS-BUILT" DRAWING
 THIS DRAWING HAS BEEN REVISED IN ACCORDANCE WITH NOTES ON "RECORD DRAWINGS" FURNISHED BY THE CONTRACTOR AND WITH EXECUTED CHANGE ORDERS. TO THE BEST OF OUR KNOWLEDGE AND BELIEF, THIS DRAWING SHOWS ACTUAL "AS-BUILT" CONDITIONS.
 COMMONWEALTH ENGINEERS, INC.
 REVISED DATE: 10/06
 BY: JCH, CK: CWV

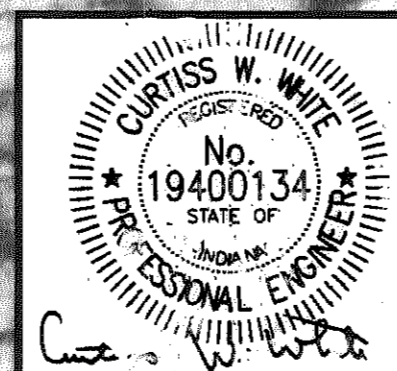

COMMONWEALTH ENGINEERS, INC.

DRAWN BY: CB
 DESIGNED BY: CWV
 CHECKED BY: CWV
 DATE: 1/04
 JOB NO: S02119-02
 SCALE: AS NOTED


SALAMONIE RESERVOIR
 WASTEWATER TREATMENT PLANT IMPROVEMENTS PROJECT
 PUBLIC WORKS PROJECT NO. E031410M
 VISITOR CENTER GRINDER STATION AND FORCEMAIN

22-PUMP STATION2.dwg 600


DRAWING NO.

22


22 OF 52

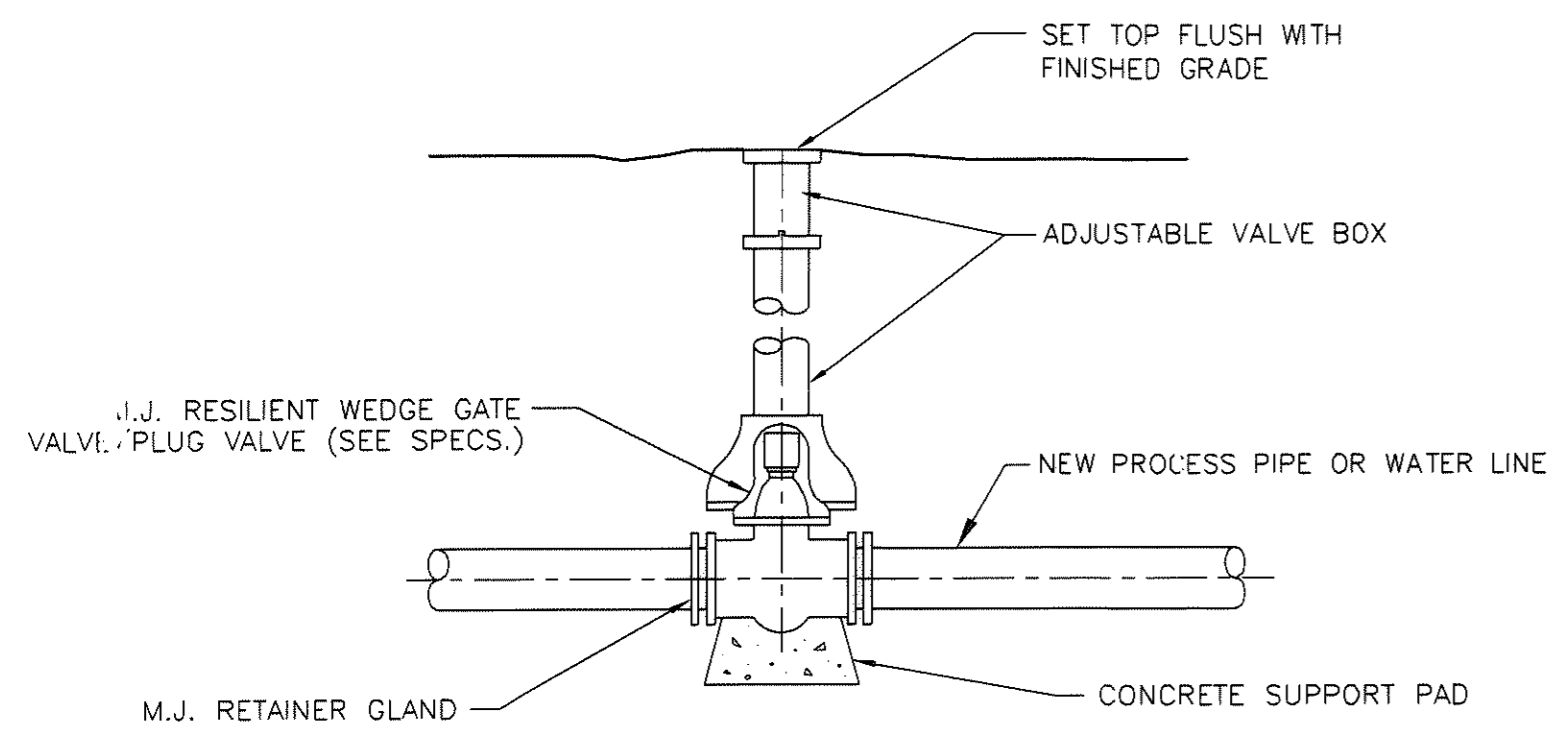


BURIED PLUG/GATE VALVE AND BOX DETAIL
NO SCALE

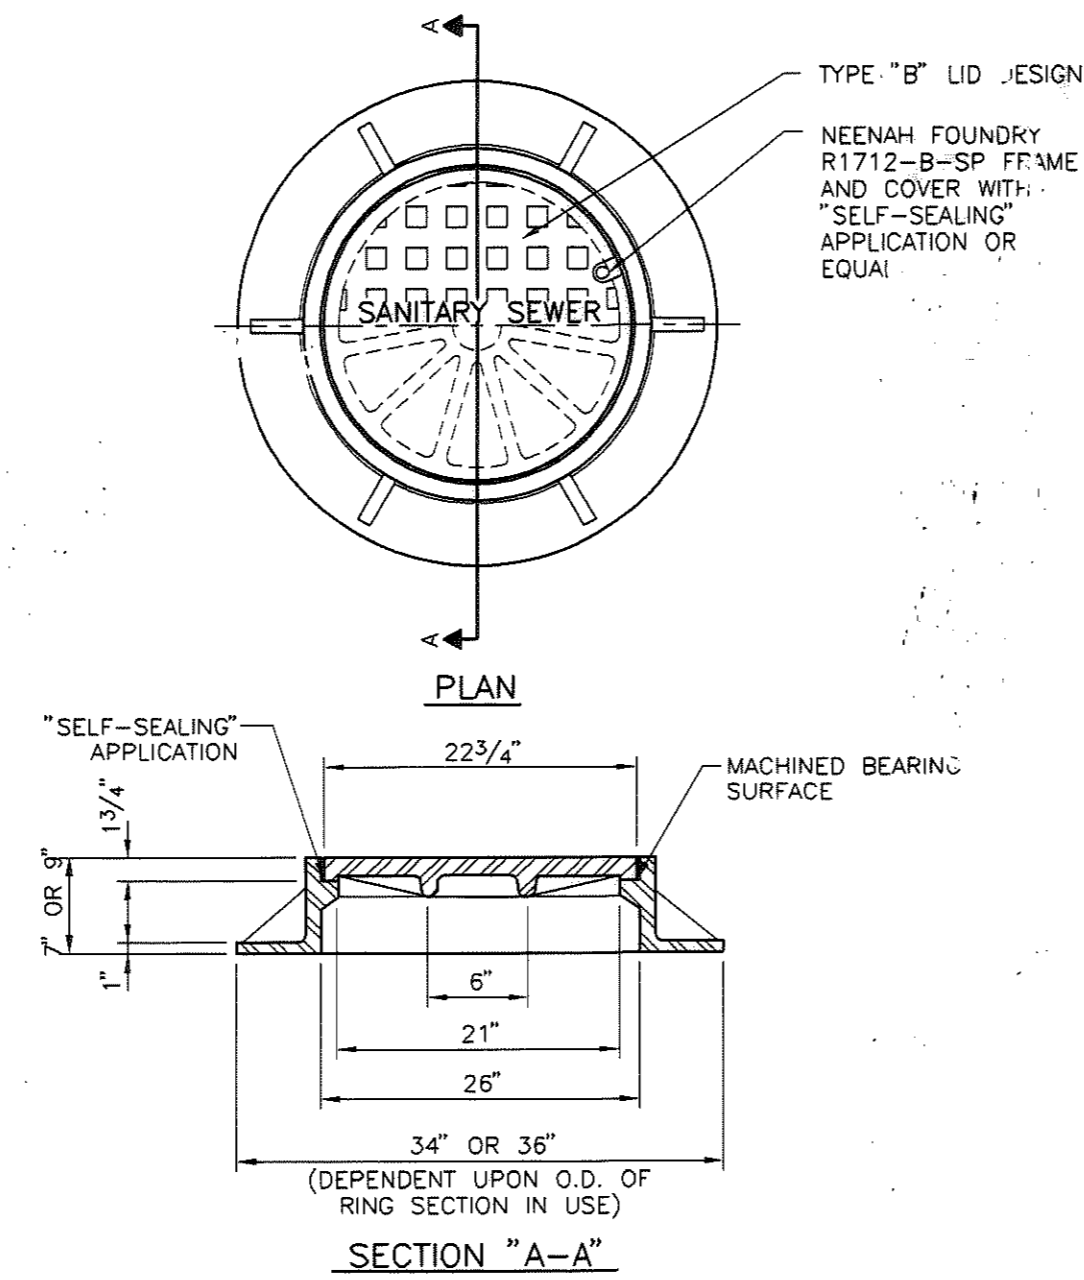


SANITARY SEWER MANHOLE FRAME AND COVER - STANDARD MANHOLE
SCALE: 1"=1'-0"

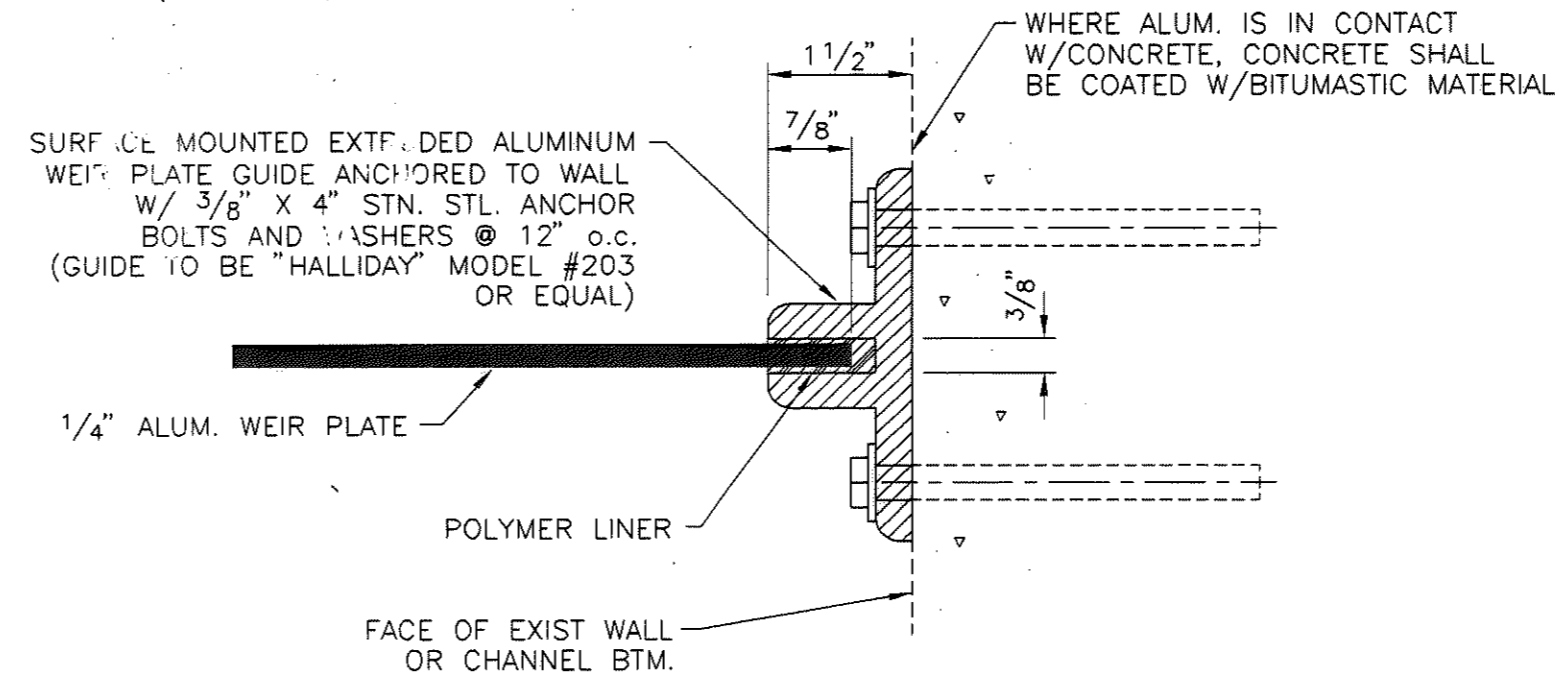

TYPE "B" WEIR PLATE GUIDE DETAIL
NO SCALE

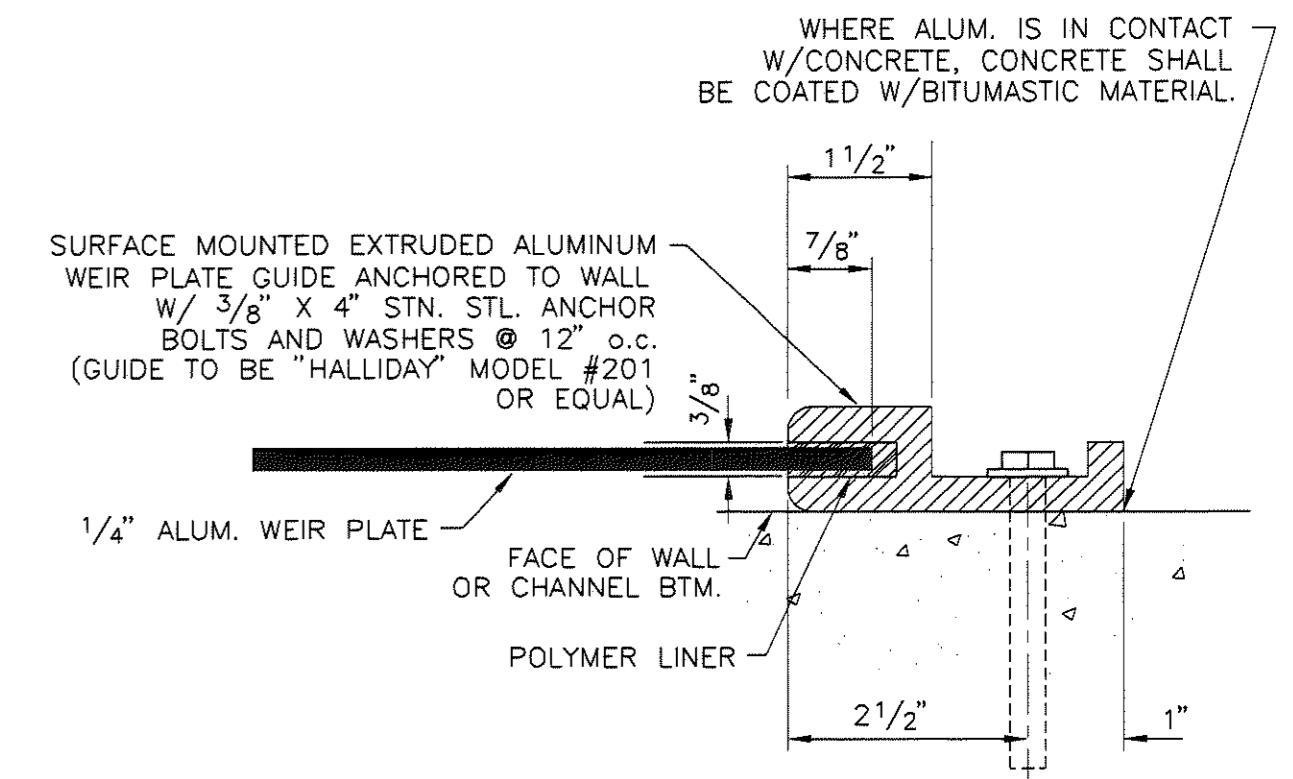


TYPE "A" WEIR PLATE GUIDE DETAIL
NO SCALE

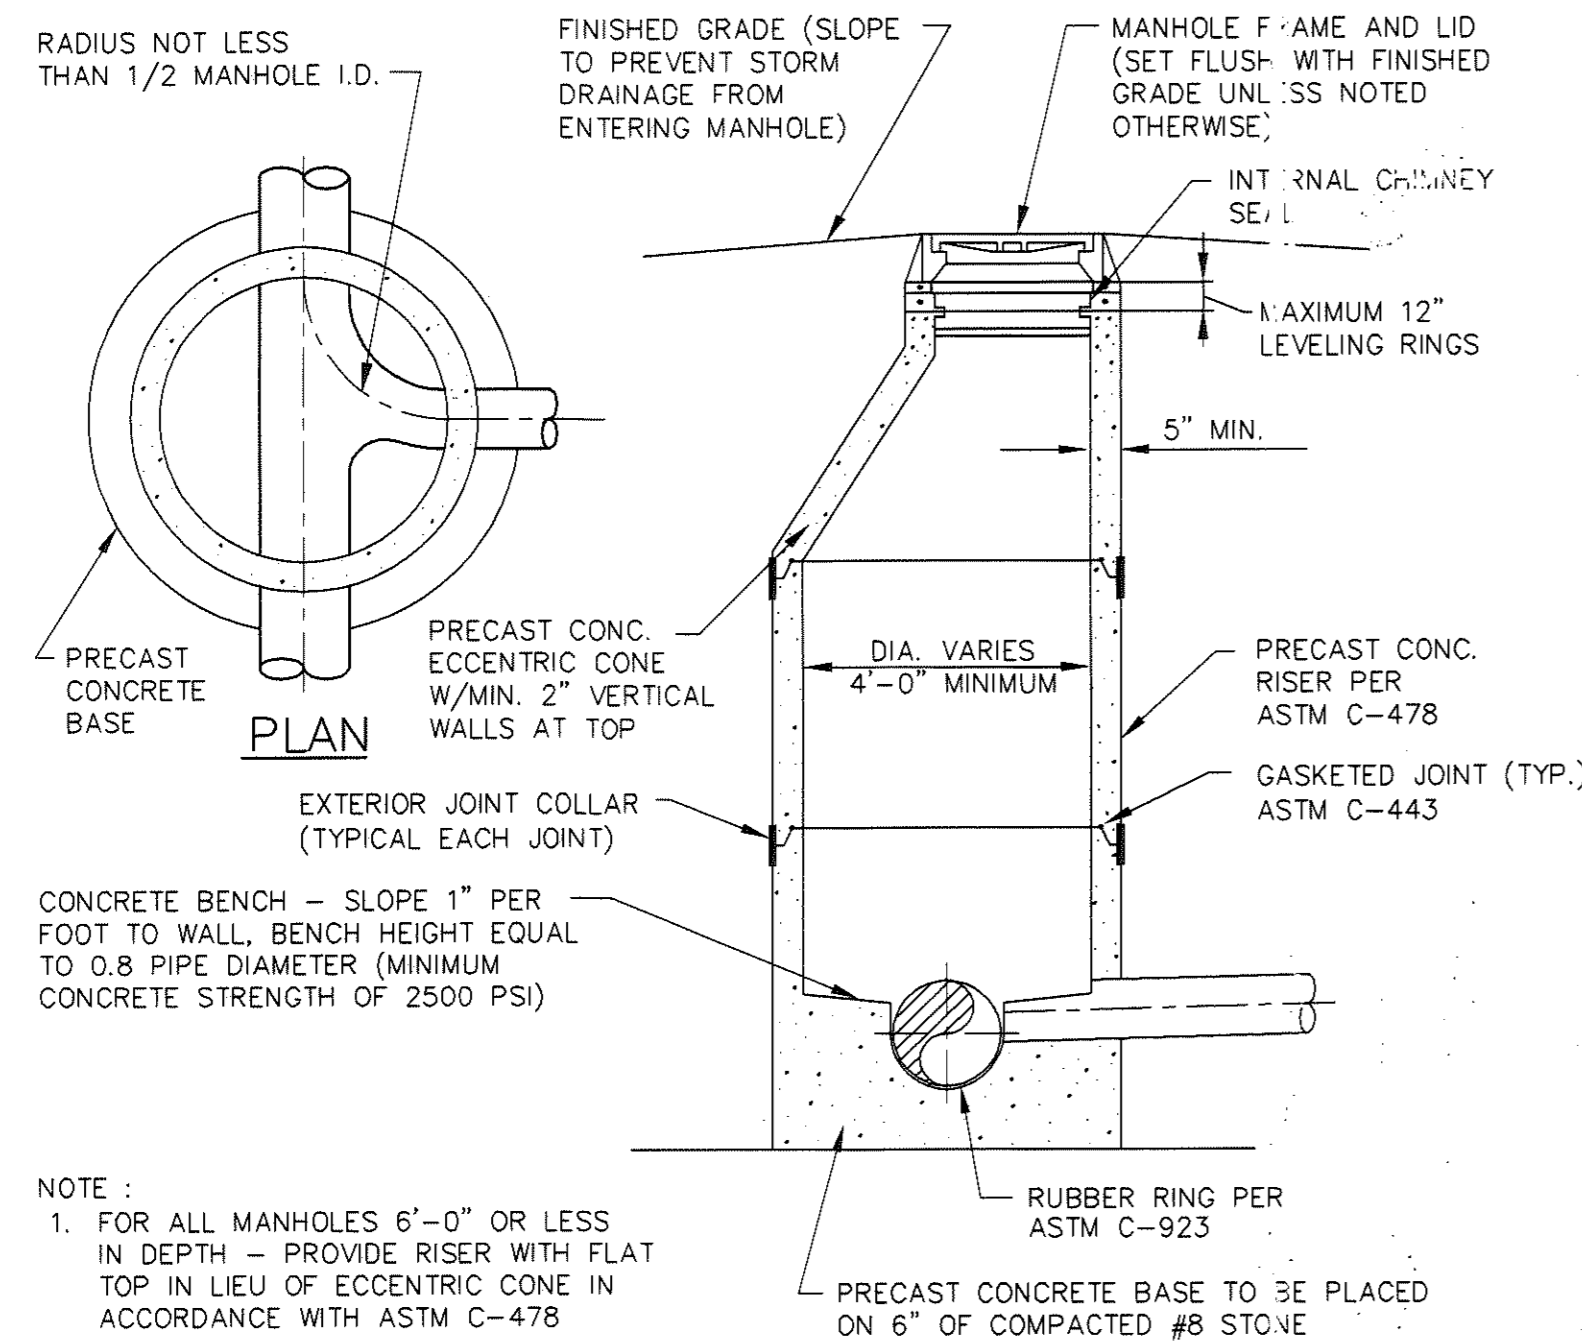

- NOTE:
- FOR ALL MANHOLES 6'-0" OR LESS IN DEPTH - PROVIDE RISER WITH FLAT TOP IN LIEU OF ECCENTRIC CONE IN ACCORDANCE WITH ASTM C-478
 - THE CROWN OF THE INFLUENT PIPE SHALL BE AT OR ABOVE THE CROWN OF THE OUTLET PIPE
 - DROP MANHOLES SHALL BE USED WHENEVER THE DISTANCE FROM THE INVERT OF THE INCOMING LINE AND BOTTOM OF MANHOLE IS GREATER THAN TWO FEET.


STANDARD SANITARY MANHOLE DETAIL
NO SCALE

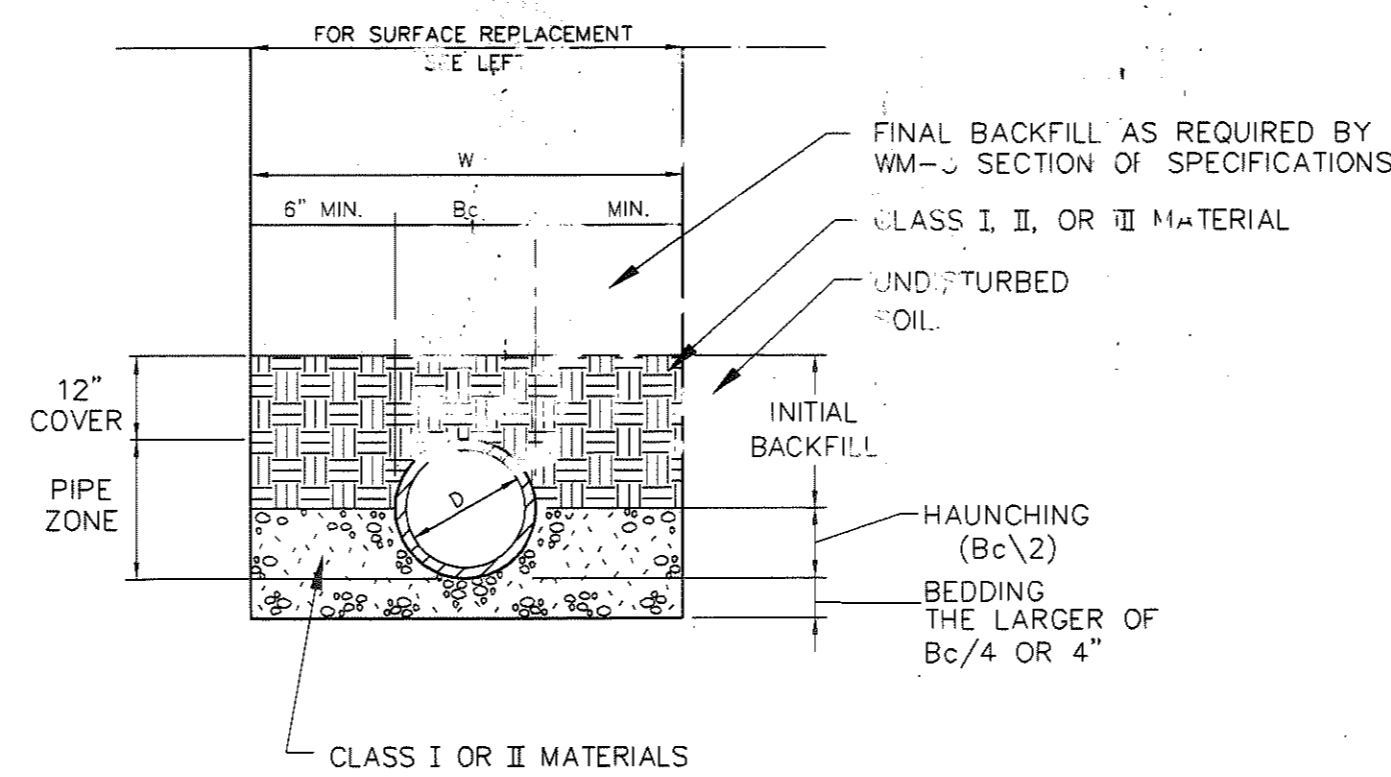

W = MAXIMUM ALLOWABLE TRENCH WIDTH FOR PIPE AS PER ASTM NOT TO EXCEED FOUR (4) FEET FOR 6" THROUGH 24" PIPE NOR SIX (6) FEET FOR 27" THROUGH 48" PIPE
D = PIPE DIAMETER (INTERNAL)
Bc = PIPE DIAMETER (EXTERNAL)

- NOTES:
- COMPACTED BEDDING SHOULD BE AT SPRING-LINE OF THE PIPE. BACKFILLING ABOVE THIS POINT SHALL BE IN ACCORDANCE WITH THE SPECIFICATIONS AND AS REQUIRED HEREIN.
 - WHEN CLASS I MATERIAL IS USED FOR BEDDING, COMPACTION MAY BE ACCOMPLISHED BY HAND OR MECHANICAL TAMPING.
 - WHEN CLASS II MATERIAL IS USED FOR BEDDING, COMPACTION SHALL BE ACCOMPLISHED ONLY BY HAND OR MECHANICAL TAMPING TO A MINIMUM OF 95% STANDARD PROCTOR DENSITY.
 - WORK FALLING UNDER THE JURISDICTION OF THE INDIANA DEPARTMENT OF TRANSPORTATION (INDOT) SHALL UTILIZE COMPACTED GRANULAR BACKFILL MATERIAL FOR INITIAL AND FINAL BACKFILL ANYWHERE WITHIN 12 FEET OF THE EDGE OF PAVEMENT. FOR ALL OTHER NON-INDOT PAVEMENT AREAS (INCLUDING BOTH HARD SURFACED AND COMPACTED AGGREGATE), COMPACTED GRANULAR BACKFILL MATERIAL SHALL BE USED WITHIN 5 FEET OF THE EDGE OF THE PAVEMENT.


TRENCH DETAIL METHOD "A"
FOR RIGID CONDUITS (RCP AND DI) IN AREAS NOT SUBJECTED TO VEHICULAR TRAFFIC
NO SCALE

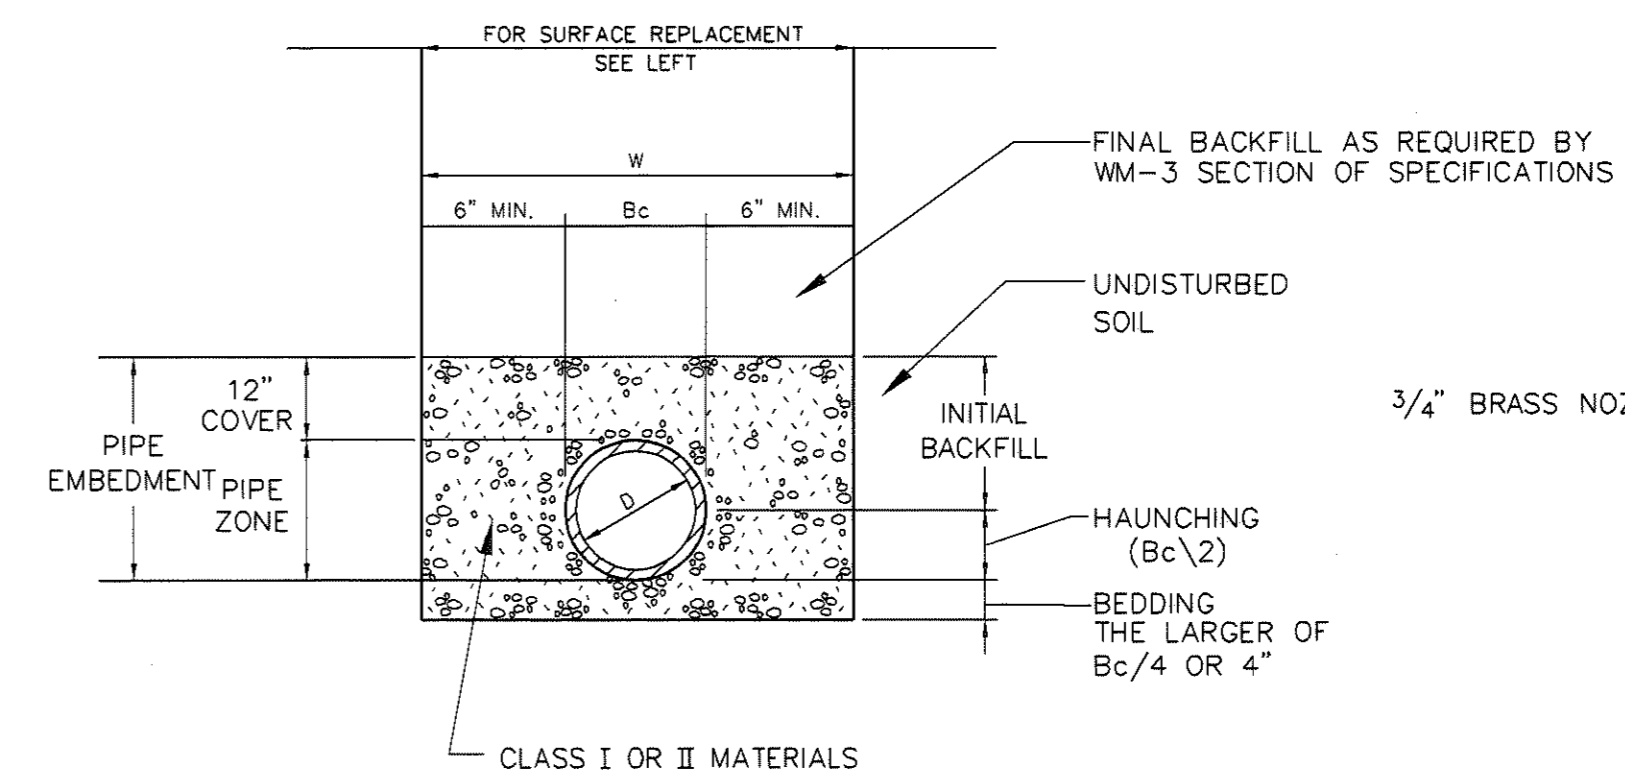

W = MAXIMUM ALLOWABLE TRENCH WIDTH FOR PIPE AS PER ASTM NOT TO EXCEED FOUR (4) FEET FOR 6" THROUGH 24" PIPE NOR SIX (6) FEET FOR 27" THROUGH 48" PIPE
D = PIPE DIAMETER (INTERNAL)
Bc = PIPE DIAMETER (EXTERNAL)


- NOTES:
- COMPACTED INITIAL BACKFILL SHALL EXTEND A MINIMUM OF 12" ABOVE THE TOP OF THE PIPE. FINAL BACKFILL ABOVE THIS POINT SHALL BE IN ACCORDANCE WITH THE SPECIFICATIONS AND AS REQUIRED HEREIN.
 - WHEN CLASS I MATERIAL IS USED FOR BEDDING, HAUNCHING, AND INITIAL BACKFILL COMPACTION MAY BE ACCOMPLISHED BY HAND OR MECHANICAL TAMPING TO A MINIMUM OF 95% STANDARD PROCTOR DENSITY.
 - WHEN CLASS II MATERIAL IS USED FOR BEDDING, HAUNCHING, AND INITIAL BACKFILL COMPACTION MAY BE ACCOMPLISHED BY HAND OR MECHANICAL TAMPING TO A MINIMUM OF 95% STANDARD PROCTOR DENSITY.
 - WORK FALLING UNDER THE JURISDICTION OF THE INDIANA DEPARTMENT OF TRANSPORTATION (INDOT) SHALL UTILIZE COMPACTED GRANULAR BACKFILL MATERIAL FOR INITIAL AND FINAL BACKFILL ANYWHERE WITHIN 12 FEET OF THE EDGE OF PAVEMENT. FOR ALL OTHER NON-INDOT PAVEMENT AREAS (INCLUDING BOTH HARD SURFACED AND COMPACTED AGGREGATE), COMPACTED GRANULAR BACKFILL MATERIAL SHALL BE USED WITHIN 5 FEET OF THE EDGE OF THE PAVEMENT.

TRENCH DETAIL METHOD B
FOR FLEXIBLE CONDUITS (PVC, RPVC, ABS AND HDPE) AND RIGID CONDUITS (RCP AND DI) IN AREAS SUBJECT TO VEHICULAR TRAFFIC
NO SCALE

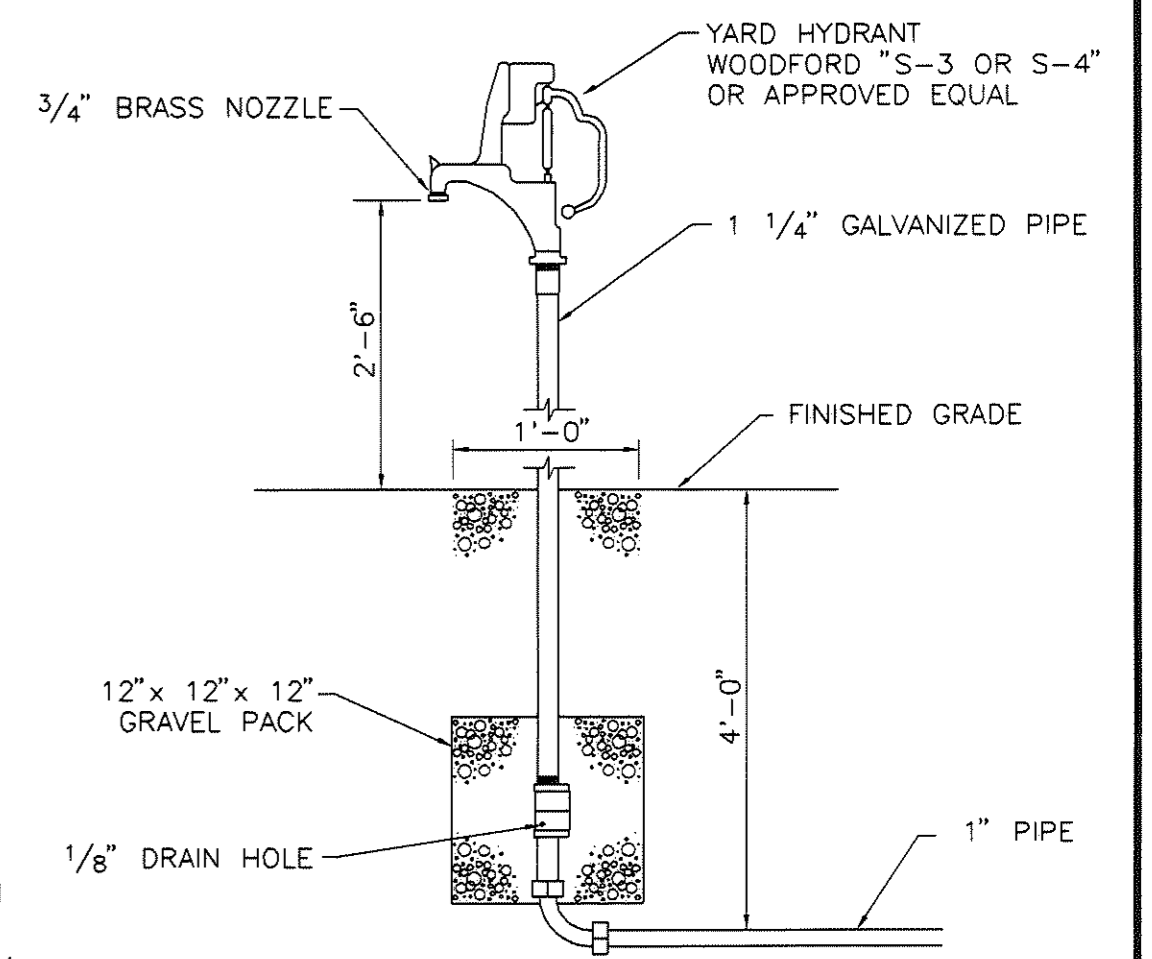

YARD HYDRANT DETAIL
NO SCALE

REVISED "AS-BUILT" DRAWING
THIS DRAWING HAS BEEN REVISED IN ACCORDANCE WITH NOTES ON "RECORD DRAWINGS" FURNISHED BY THE CONTRACTOR AND WITH EXECUTED CHANGE ORDERS. TO THE BEST OF OUR KNOWLEDGE AND BELIEF, THIS DRAWING SHOWS ACTUAL "AS-BUILT" CONDITIONS.
COMMONWEALTH ENGINEERS, INC.
REVISED DATE: 10/06
BY J.C.W., CK. BY C.W.W.

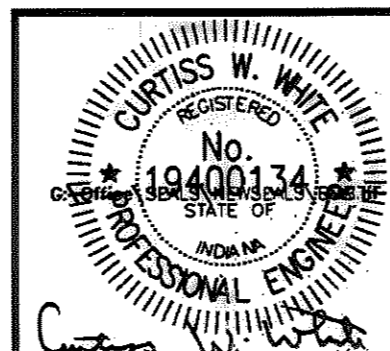


COMMONWEALTH ENGINEERS, INC.

DRAWN BY: CB
DESIGNED BY: CWW
CHECKED BY: CWW
DATE: 12/03
JOB NO: S02119-02
SCALE: AS NOTED


SALAMONIE RESERVOIR
WASTEWATER TREATMENT PLANT IMPROVEMENTS PROJECT
PUBLIC WORKS PROJECT NO. E031410M
MISCELLANEOUS DETAILS

DRAWING NO.
C-23
23 OF 52

CHANGE ORDER NO. 1 REVISED 9/1/04

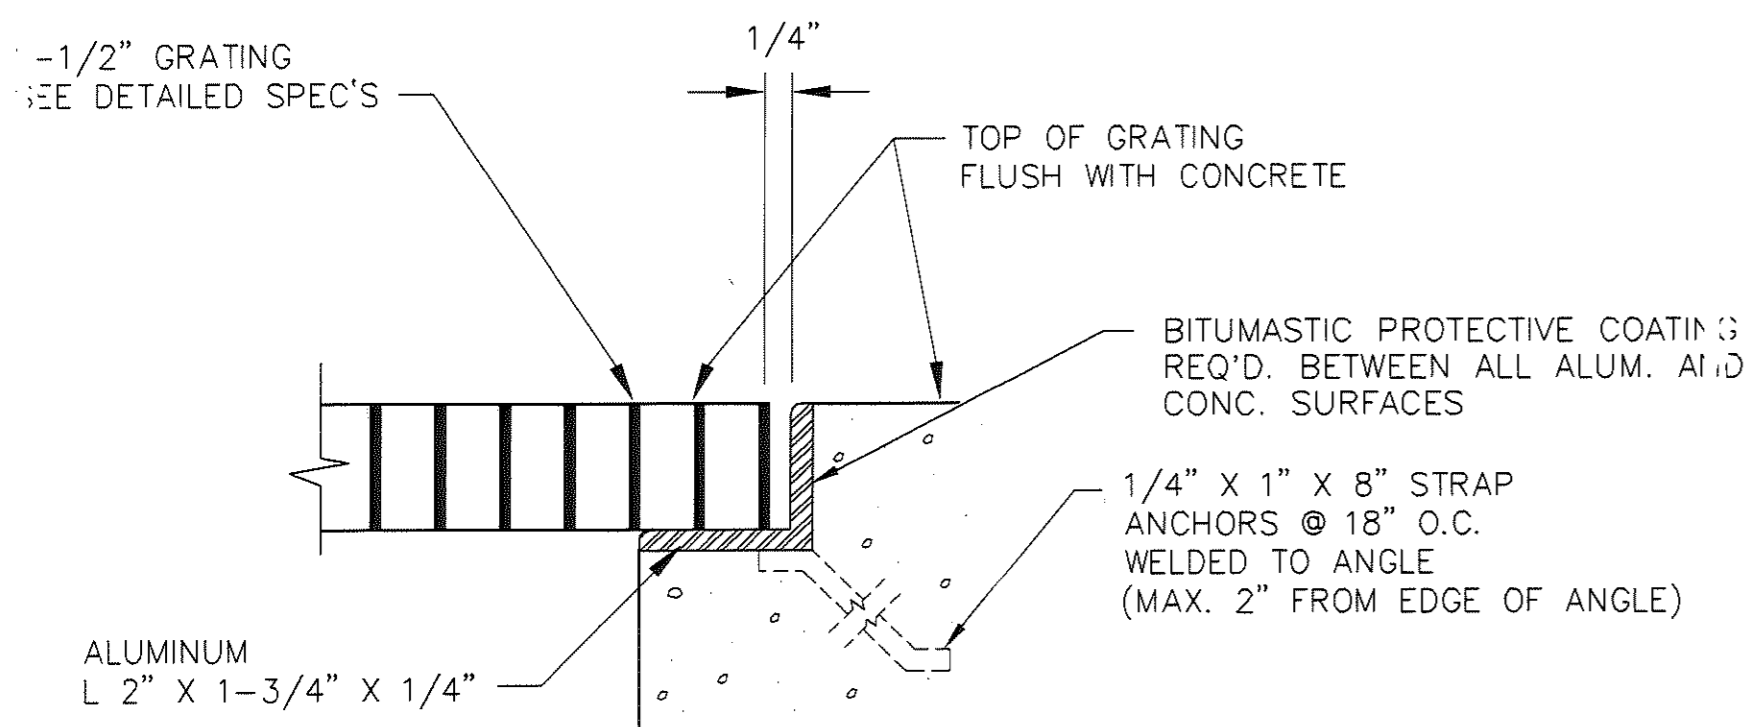


GRATING SUPPORT DETAIL - EMBEDDED GRATING

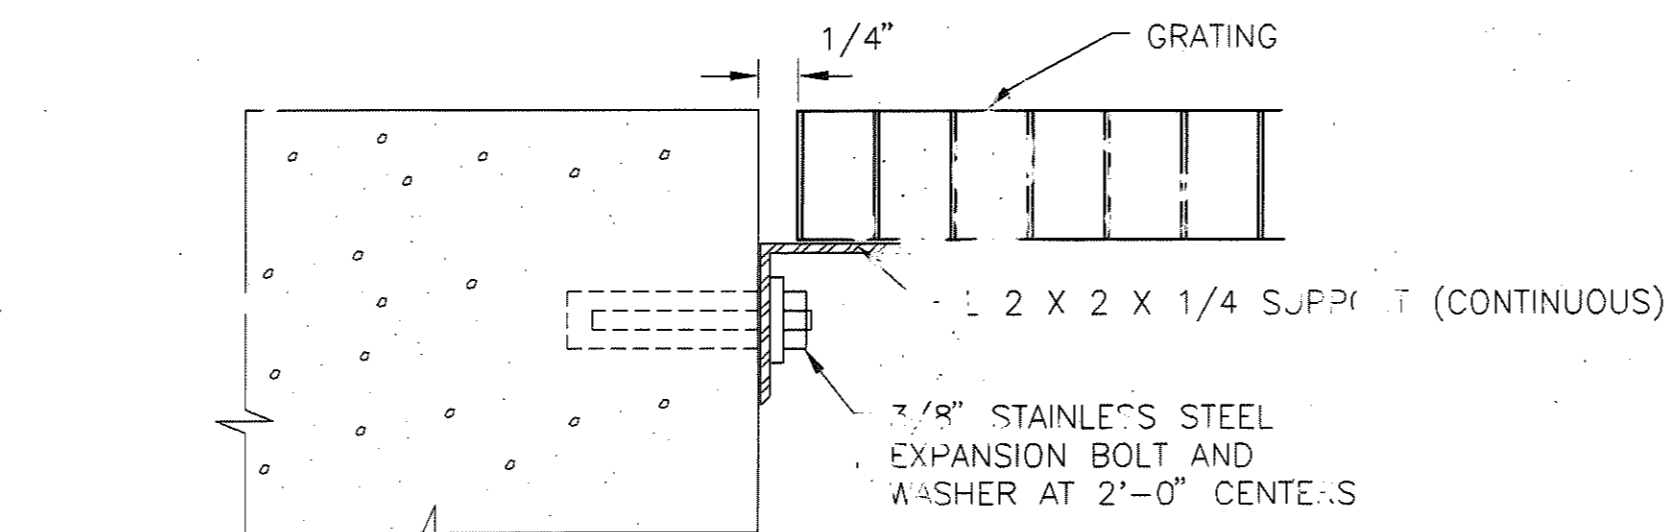


- NOTES:
1. GRATING SHALL BE OF THE MATERIAL AS SHOWN ELSEWHERE ON THE DRAWINGS. IF NOT SHOWN ELSEWHERE, GRATING SHALL BE ALUMINUM.
 2. GRATING SHALL CONFORM TO THE REQUIREMENTS OF THE DETAILED SPECIFICATIONS.
 3. SUPPORT SHALL BE ALUMINUM UNLESS STEEL GRATING IS USED. IF STEEL GRATING IS USED THE SUPPORT SHALL BE STEEL AND SHALL BE PAINTED AS DESCRIBED IN THE DETAILED SPECIFICATIONS.


GRATING SUPPORT DETAIL - FREE MOUNTED

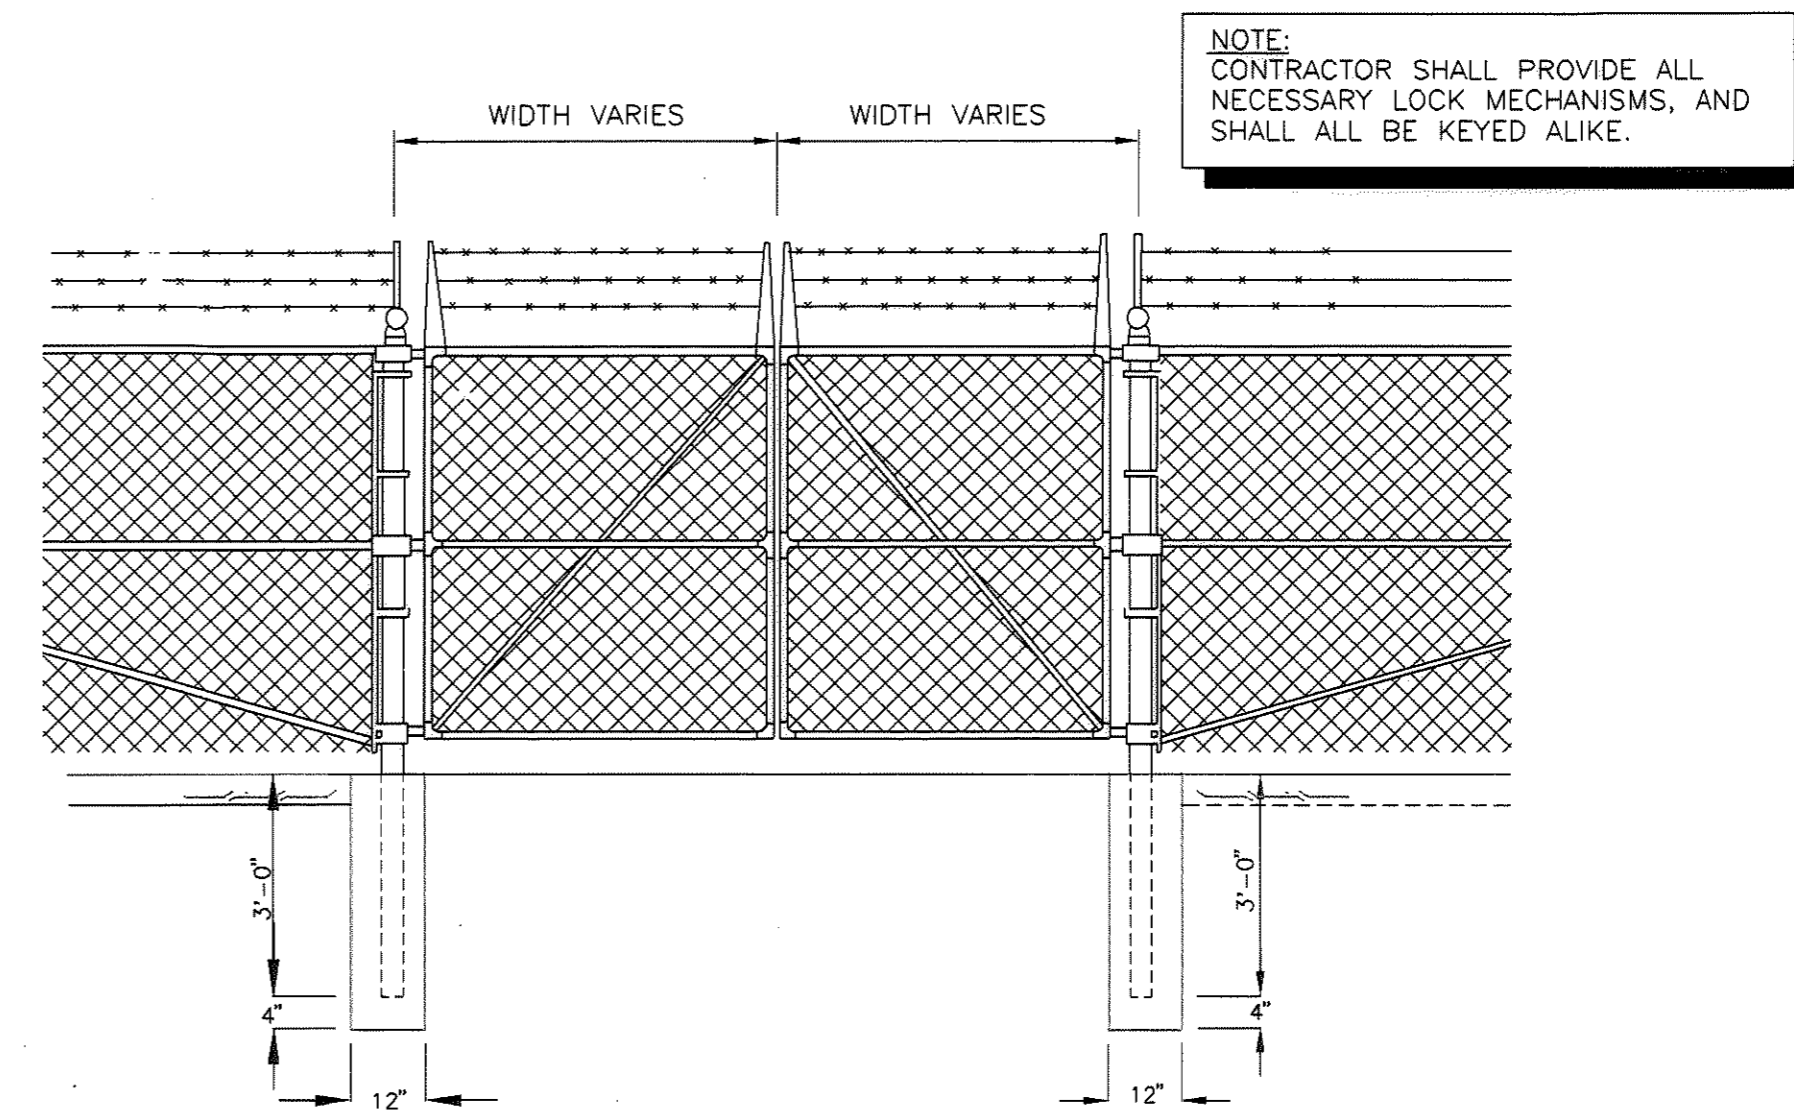

CHAIN LINK SWING GATE FENCE DETAIL
NO SCALE

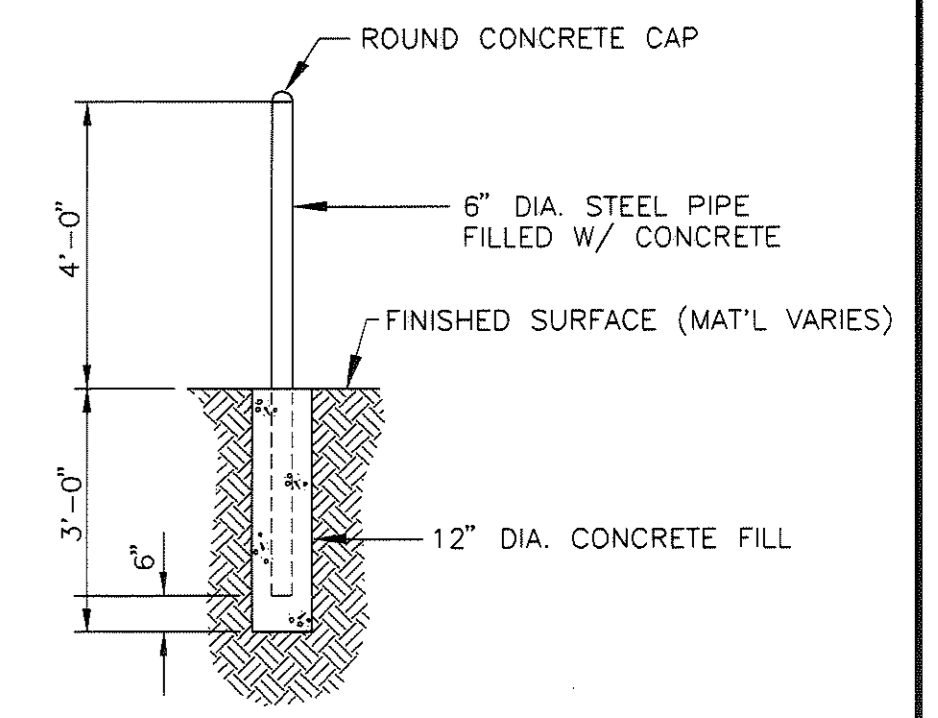


BOLLARD DETAIL
NO SCALE

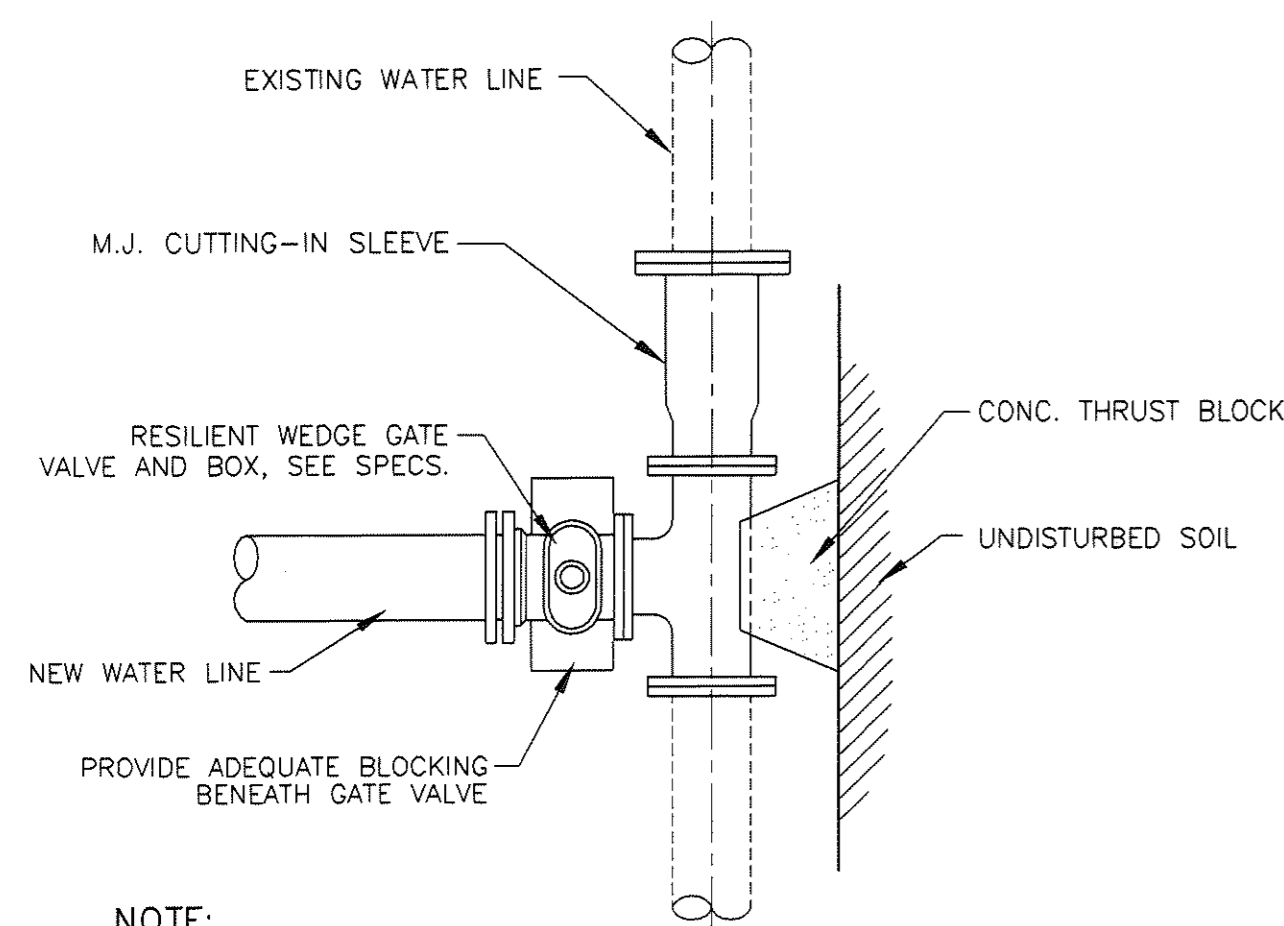


NOTE:
BENDS AND FITTINGS AS REQUIRED.


DRY CONNECTION TO EXISTING WATER MAIN
NO SCALE

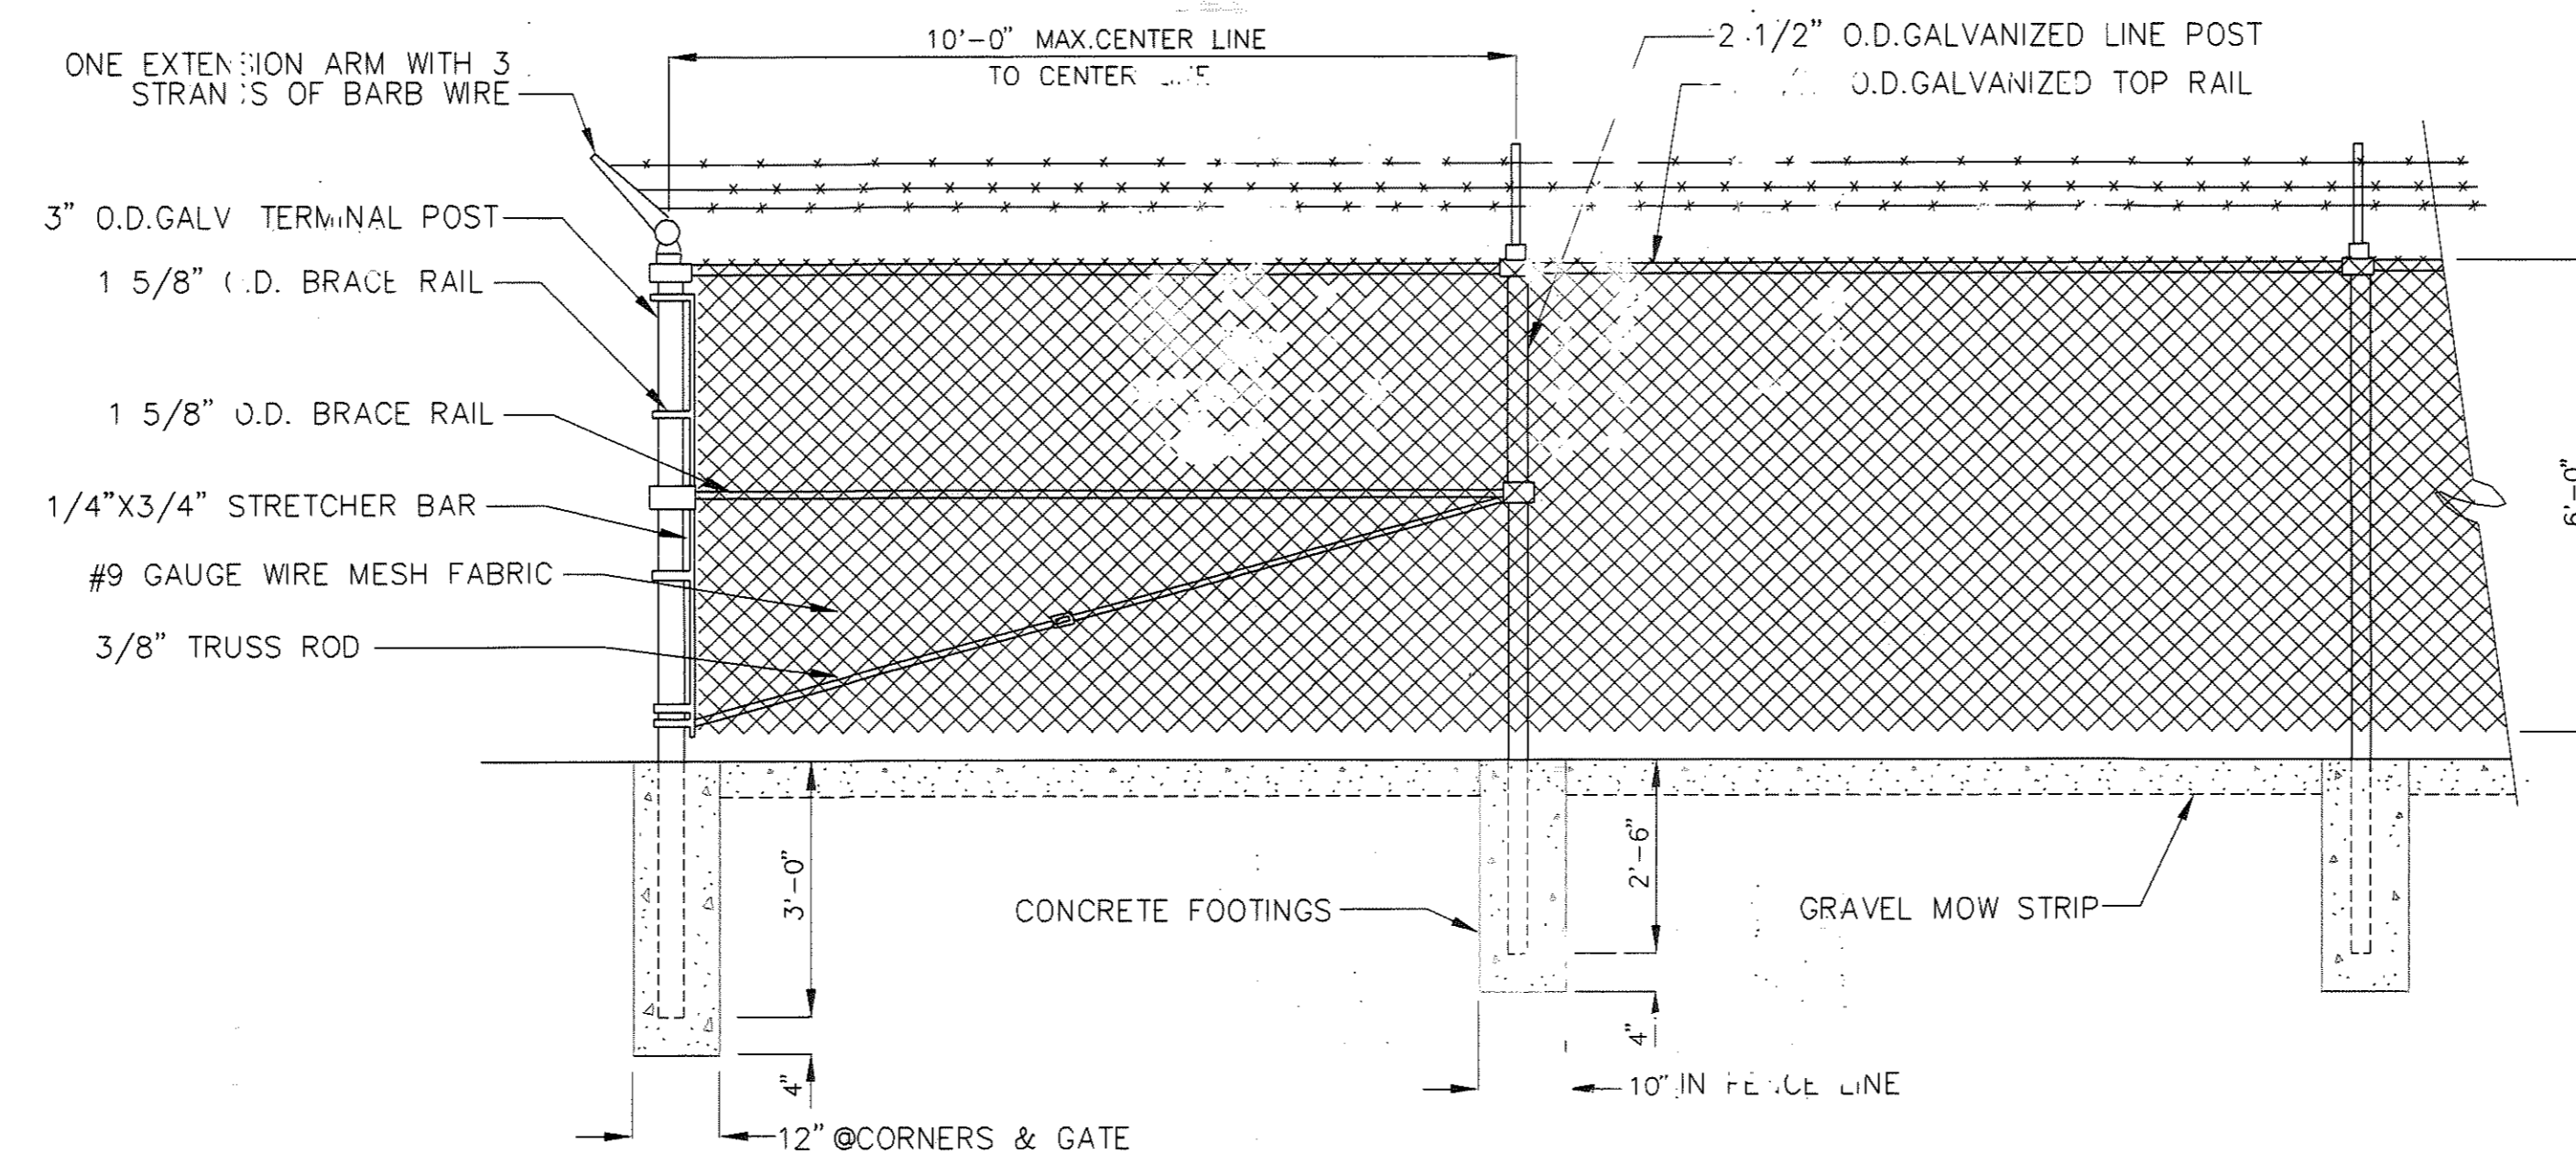


CHAIN LINK FENCE DETAIL
NO SCALE

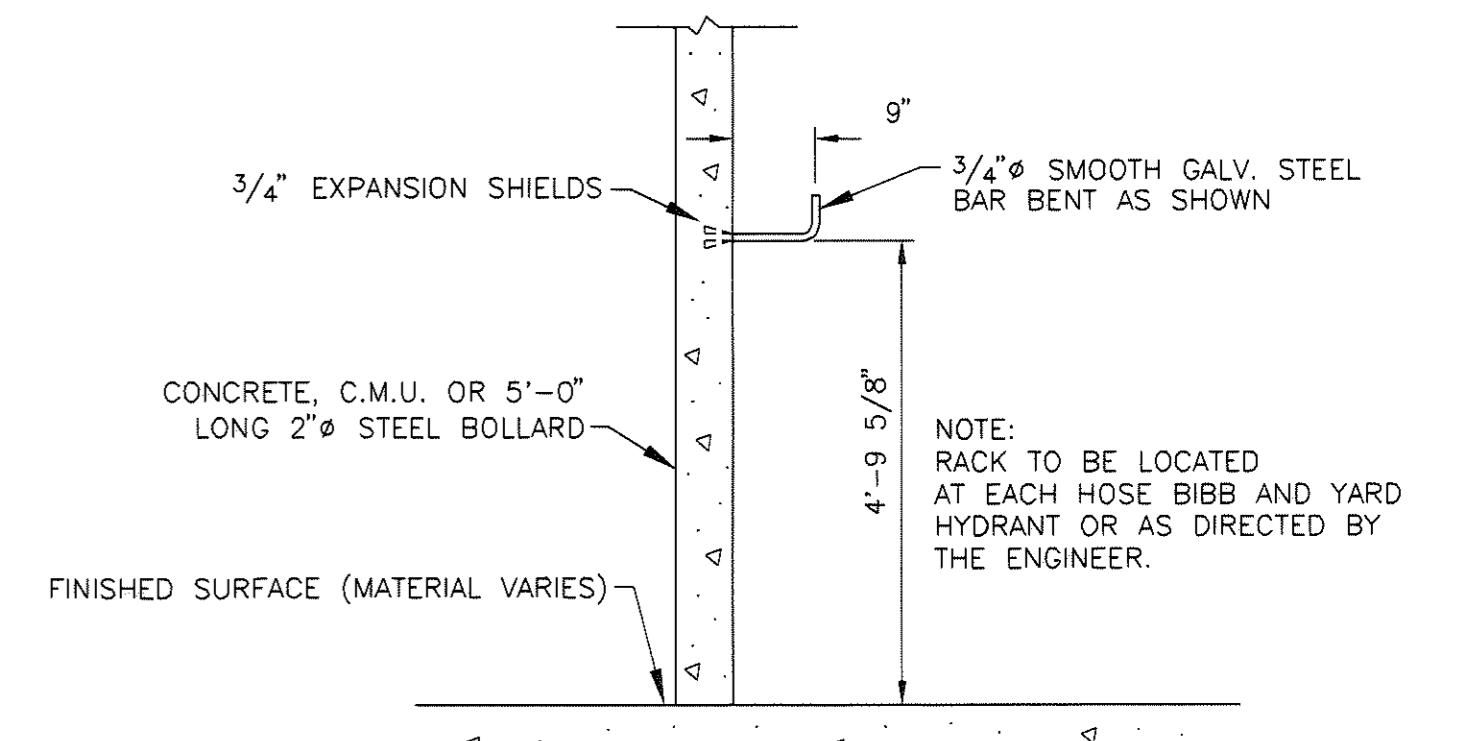


BULB RACK DETAIL
NO SCALE

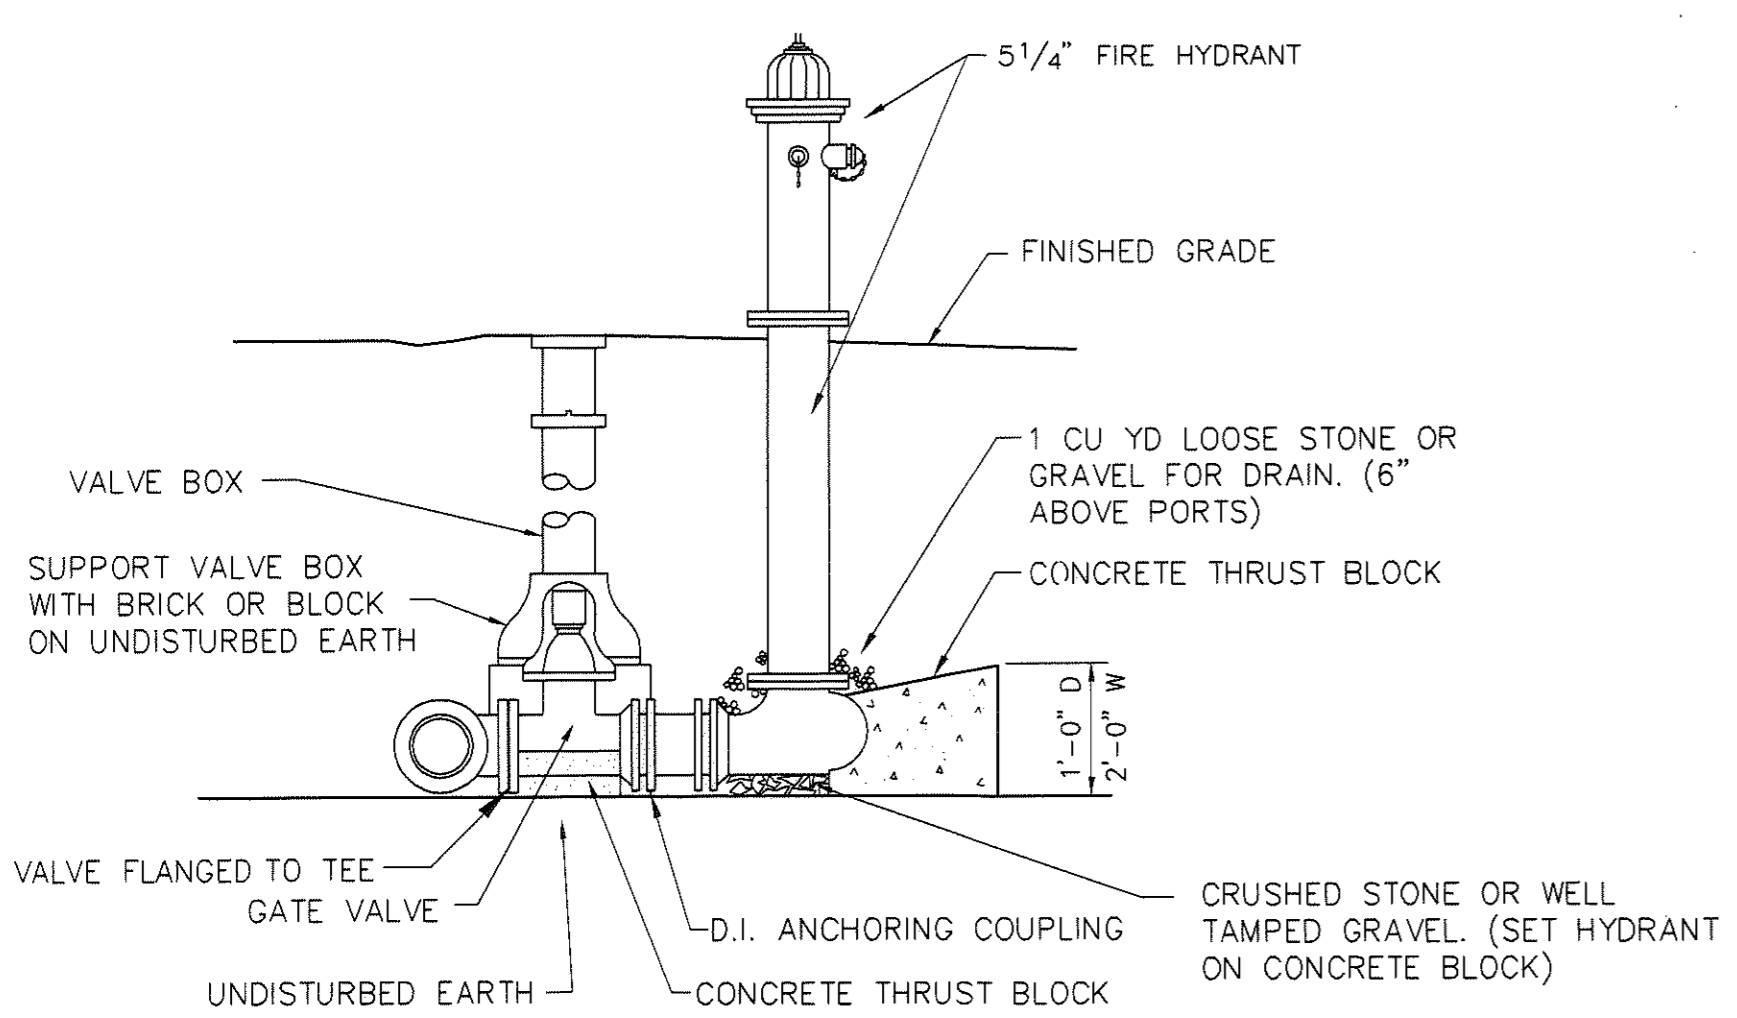

FIRE HYDRANT DETAIL
NO SCALE

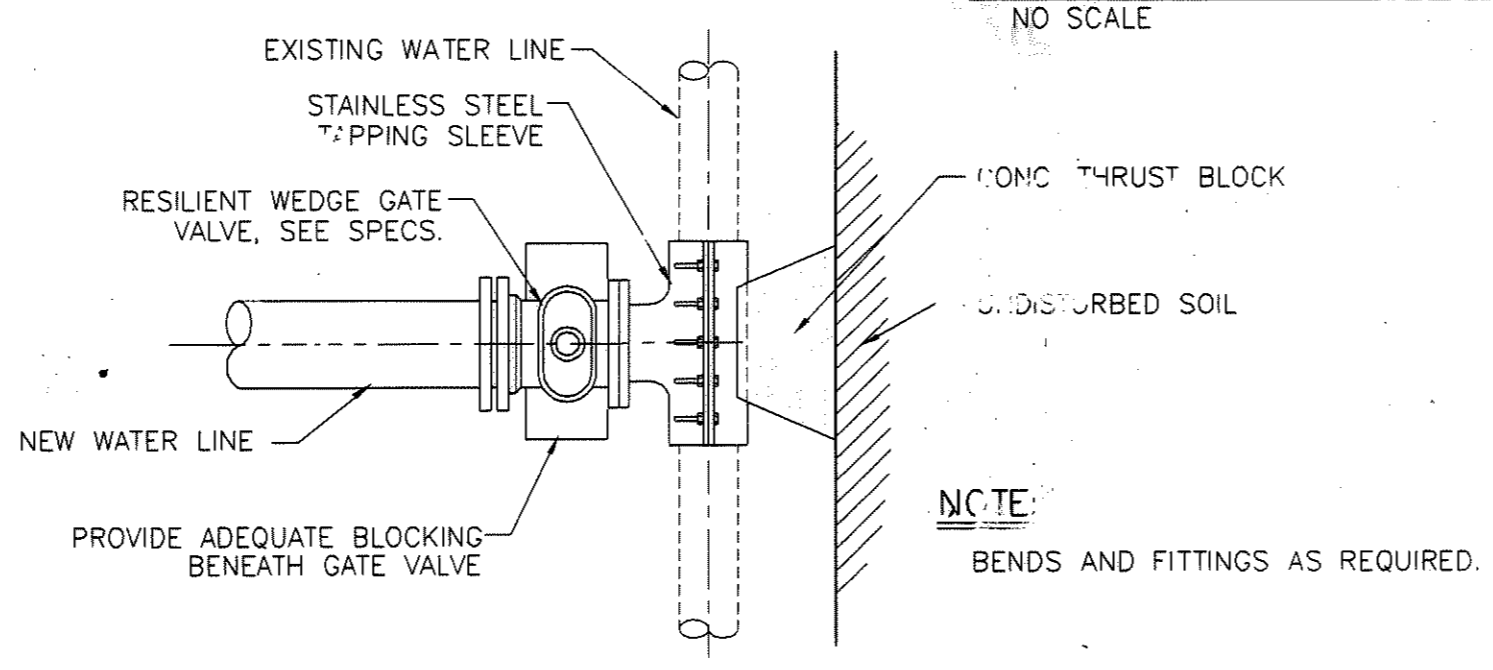


WET CONNECTION TO EXISTING WATER MAIN
NO SCALE

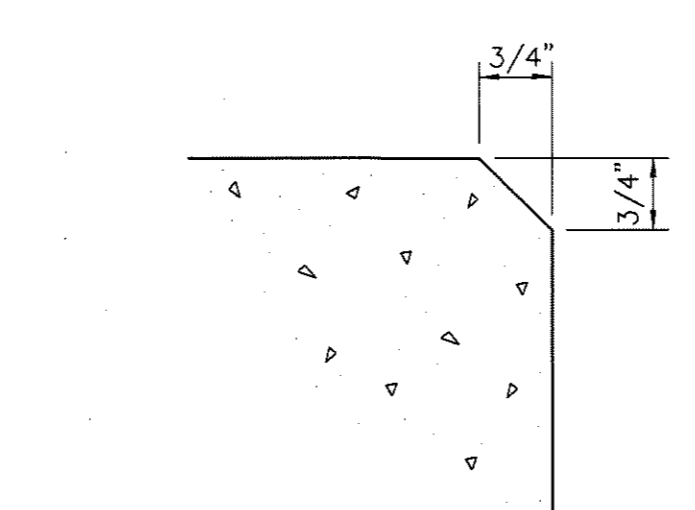


NOTE:
UNLESS OTHERWISE NOTED, CHAMFER SHALL BE PROVIDED ON ALL EXPOSED EDGES OF NEW CONCRETE. CHAMFER ON EXTERIOR VERTICAL EDGES SHALL EXTEND A MINIMUM OF SIX (6) INCHES BELOW FINISHED GRADE.

CONCRETE WALL CHAMFER DETAIL
NO SCALE

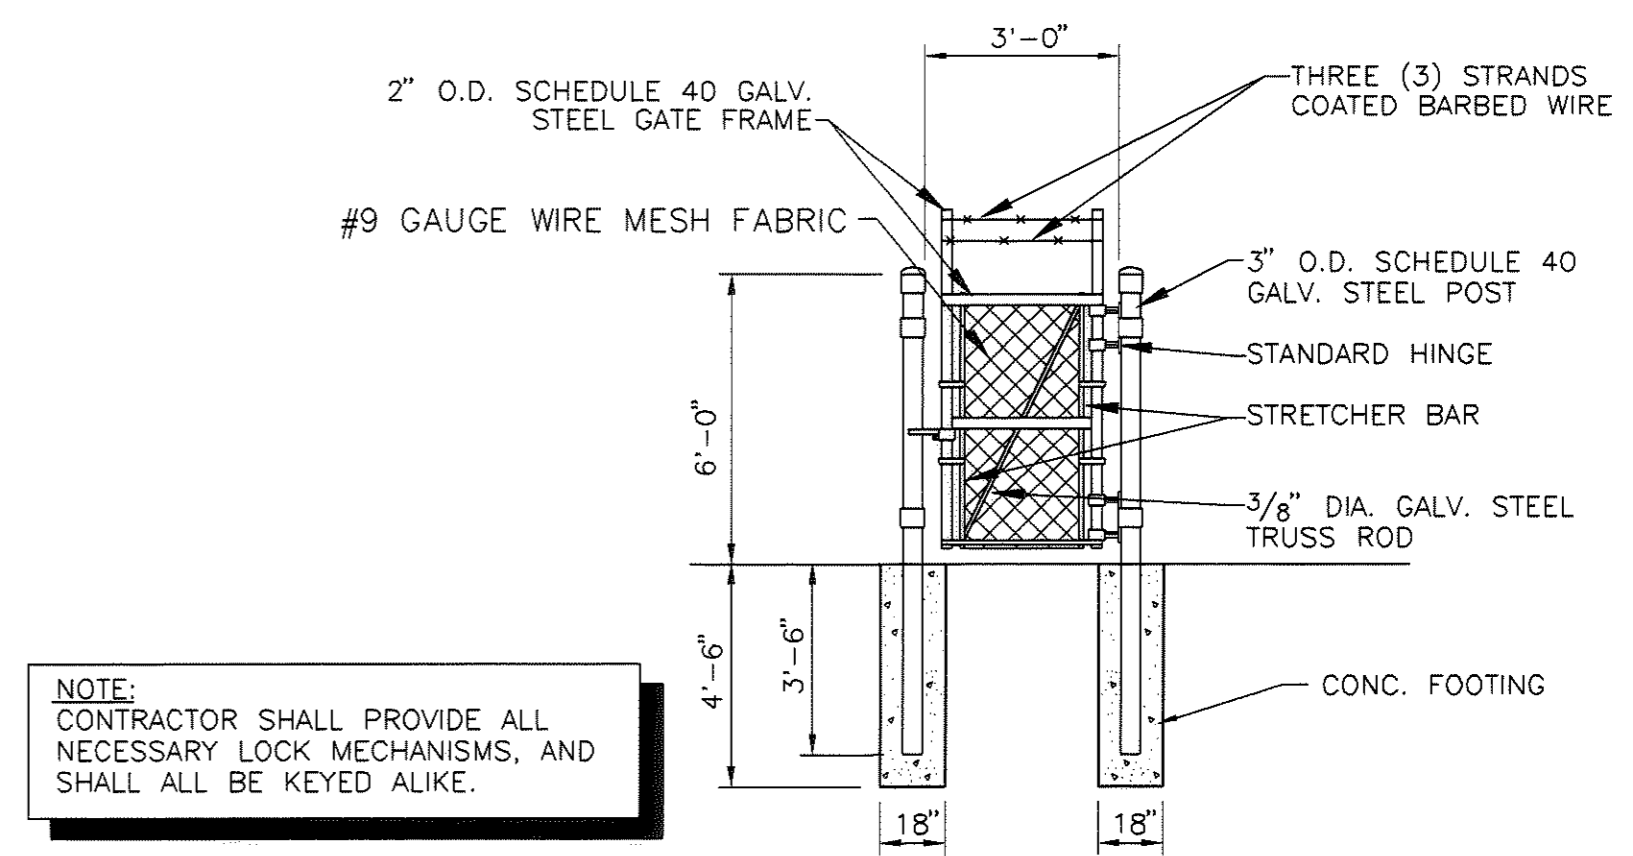


NOTE:
CONTRACTOR SHALL PROVIDE ALL NECESSARY LOCK MECHANISMS, AND SHALL ALL BE KEYPED ALIKE.

WOVEN WIRE PEDESTRIAN GATE DETAIL
NO SCALE

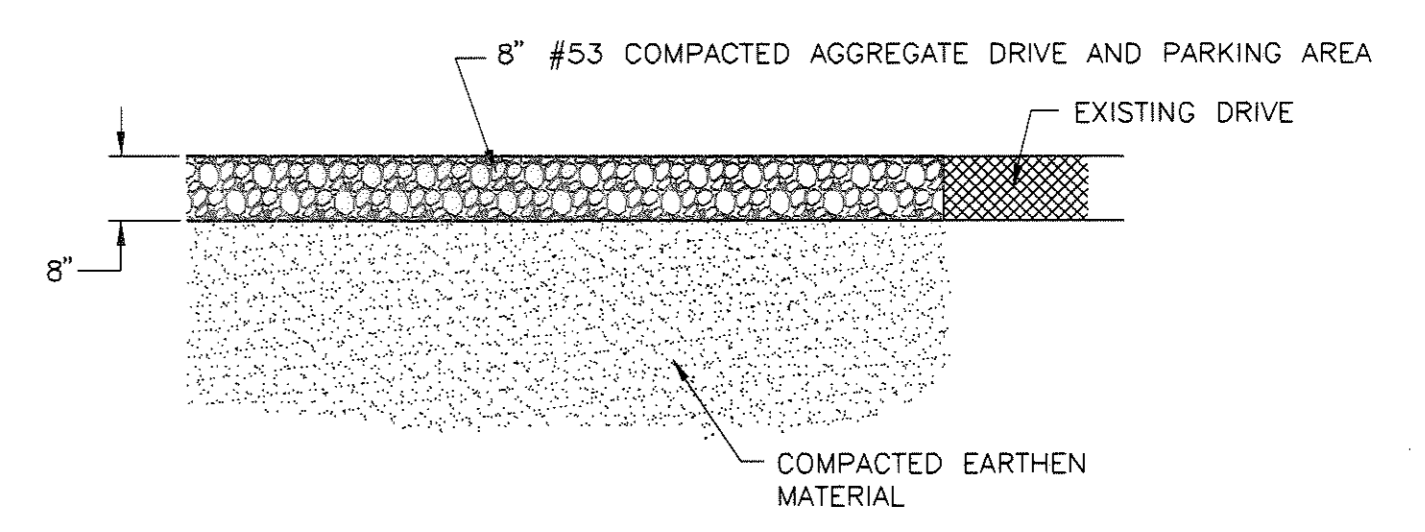

SECTION DETAIL FOR GRAVEL SURFACES
NO SCALE

REVISED "AS-BUILT" DRAWING
THIS DRAWING HAS BEEN REVISED IN ACCORDANCE WITH NOTES ON "RECORD DRAWINGS" FURNISHED BY THE CONTRACTOR AND WITH EXECUTED CHANGE ORDERS. TO THE BEST OF OUR KNOWLEDGE AND BELIEF, THIS DRAWING SHOWS ACTUAL "AS-BUILT" CONDITIONS.
COMMONWEALTH ENGINEERS, INC.
REVISED DATE: 10/06
By JCW, ck. BY CWV

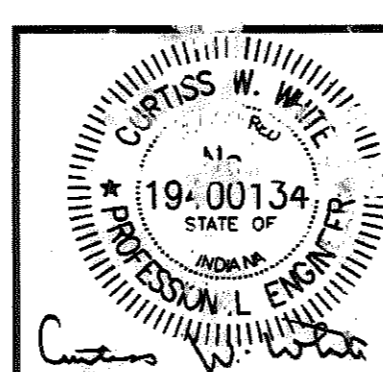


COMMONWEALTH ENGINEERS, INC.

DRAWN BY: CB
DESIGNED BY: CWV
CHECKED BY: CWV
DATE: 12/03
JOB NO: S02119-02
SCALE: AS NOTED

SALAMONIE RESERVOIR
WASTEWATER TREATMENT PLANT IMPROVEMENTS PROJECT
PUBLIC WORKS PROJECT NO. E031410M
MISCELLANEOUS DETAILS

DRAWING NO.
24
24 OF 52

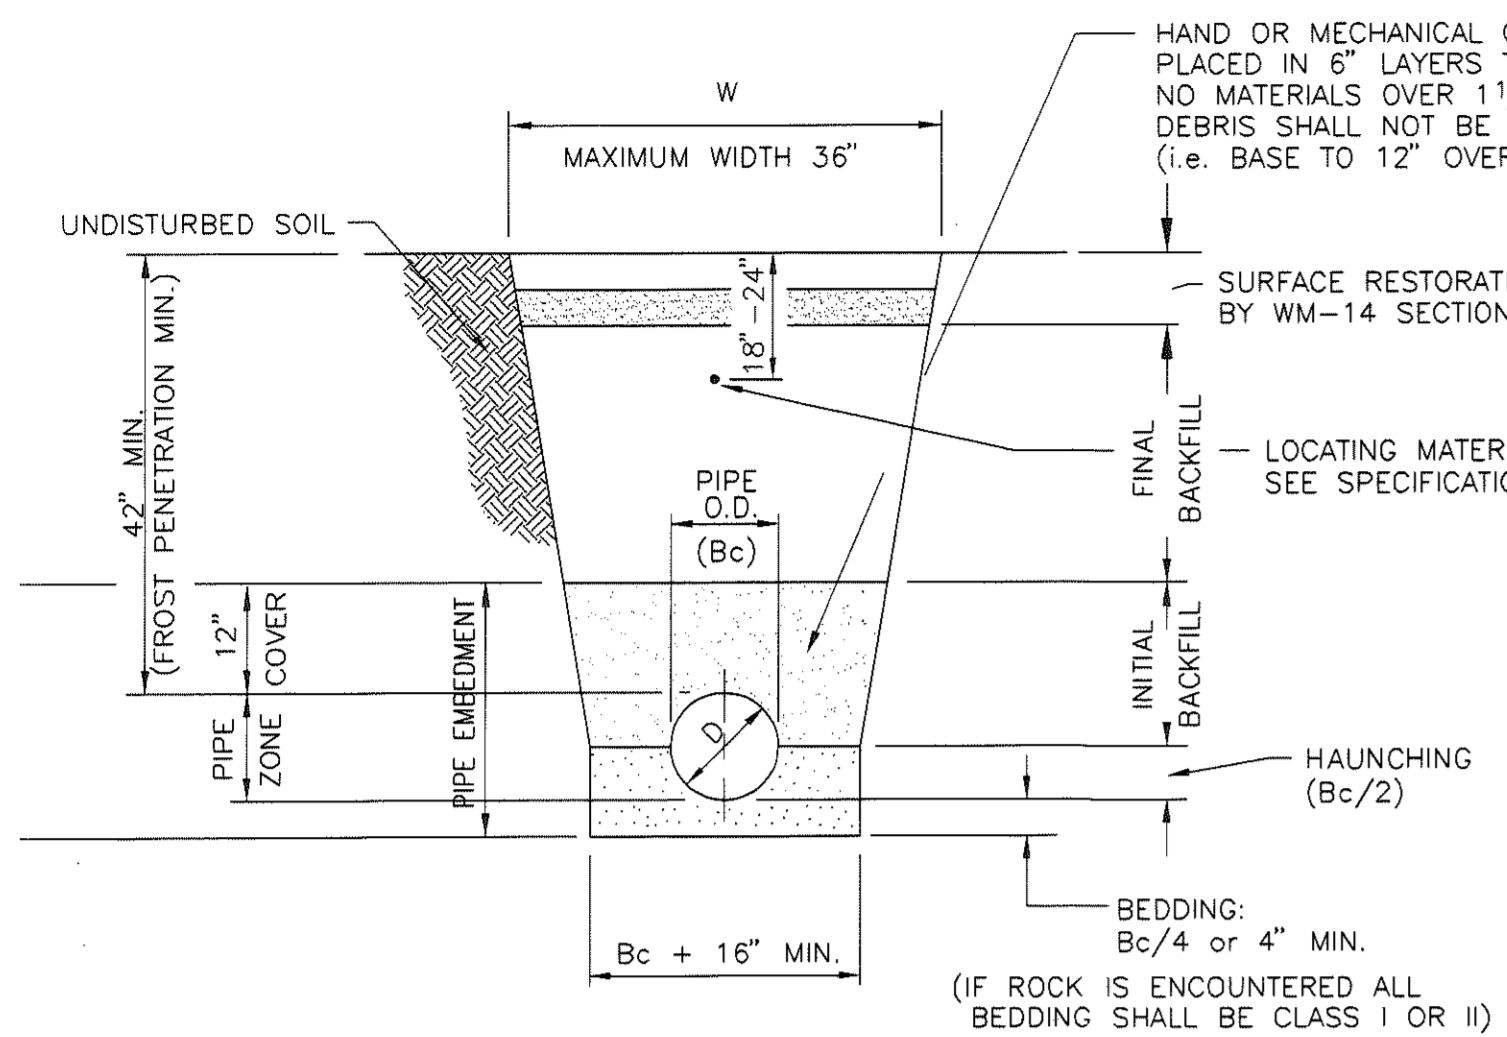


W = MAX. ALLOWABLE TRENCH WIDTH FOR PIPE SHALL NOT TO EXCEED 30 INCHES FOR 4" THROUGH 8" PIPE, 36" FOR 8" THROUGH 12" PIPE.
 D = PIPE DIAMETER (INTERNAL)
 BC = PIPE DIAMETER (EXTERNAL)


APPLICATION	BEDDING & HAUNCHING INITIAL BACKFILL	FINAL BACKFILL
GRASSY AREA OR NEW PAVED AREAS	CLASS I, II, OR III MATERIAL (REFER TO WORKMANSHIP & MATERIALS SPECIFICATIONS)	SELECTED EXCAVATED MATERIAL
PAVEMENT AREA OR ANY AREA SUBJECT TO VEHICULAR TRAFFIC	CLASS I OR II MATERIAL (REFER TO WORKMANSHIP & MATERIALS SPECIFICATIONS)	COMPACTED GRANULAR MATERIAL

- NOTES:**
- INITIAL BACKFILL STOPS AT A POINT 12" ABOVE THE TOP OF THE PIPE. BACKFILLING ABOVE THIS POINT SHALL BE IN ACCORDANCE WITH THE SPECIFICATIONS AND AS REQUIRED BY HEREIN.
 - BEDDING, HAUNCHING AND INITIAL BACKFILL SHALL BE CLASS I, II, OR III MATERIALS ACCORDING TO THE WORKMANSHIP AND MATERIALS SPECIFICATIONS.
 - WORK FALLING UNDER THE JURISDICTION OF THE INDIANA DEPARTMENT OF TRANSPORTATION (INDOT) SHALL UTILIZE COMPACTED GRANULAR BACKFILL MATERIAL FOR INITIAL AND FINAL BACKFILL ANYWHERE WITHIN 12 FEET OF THE EDGE OF PAVEMENT.
 - WORK NOT FALLING UNDER THE JURISDICTION OF IN. DEPT. OF TRANSPORTATION SHALL UTILIZE COMPACTED GRANULAR BACKFILL MATERIAL FOR INITIAL AND FINAL BACKFILL ANYWHERE WITHIN 5 FEET OF THE EDGE OF PAVEMENT.


TRENCH DETAIL METHOD C FOR WATER MAIN PIPE
 NO SCALE

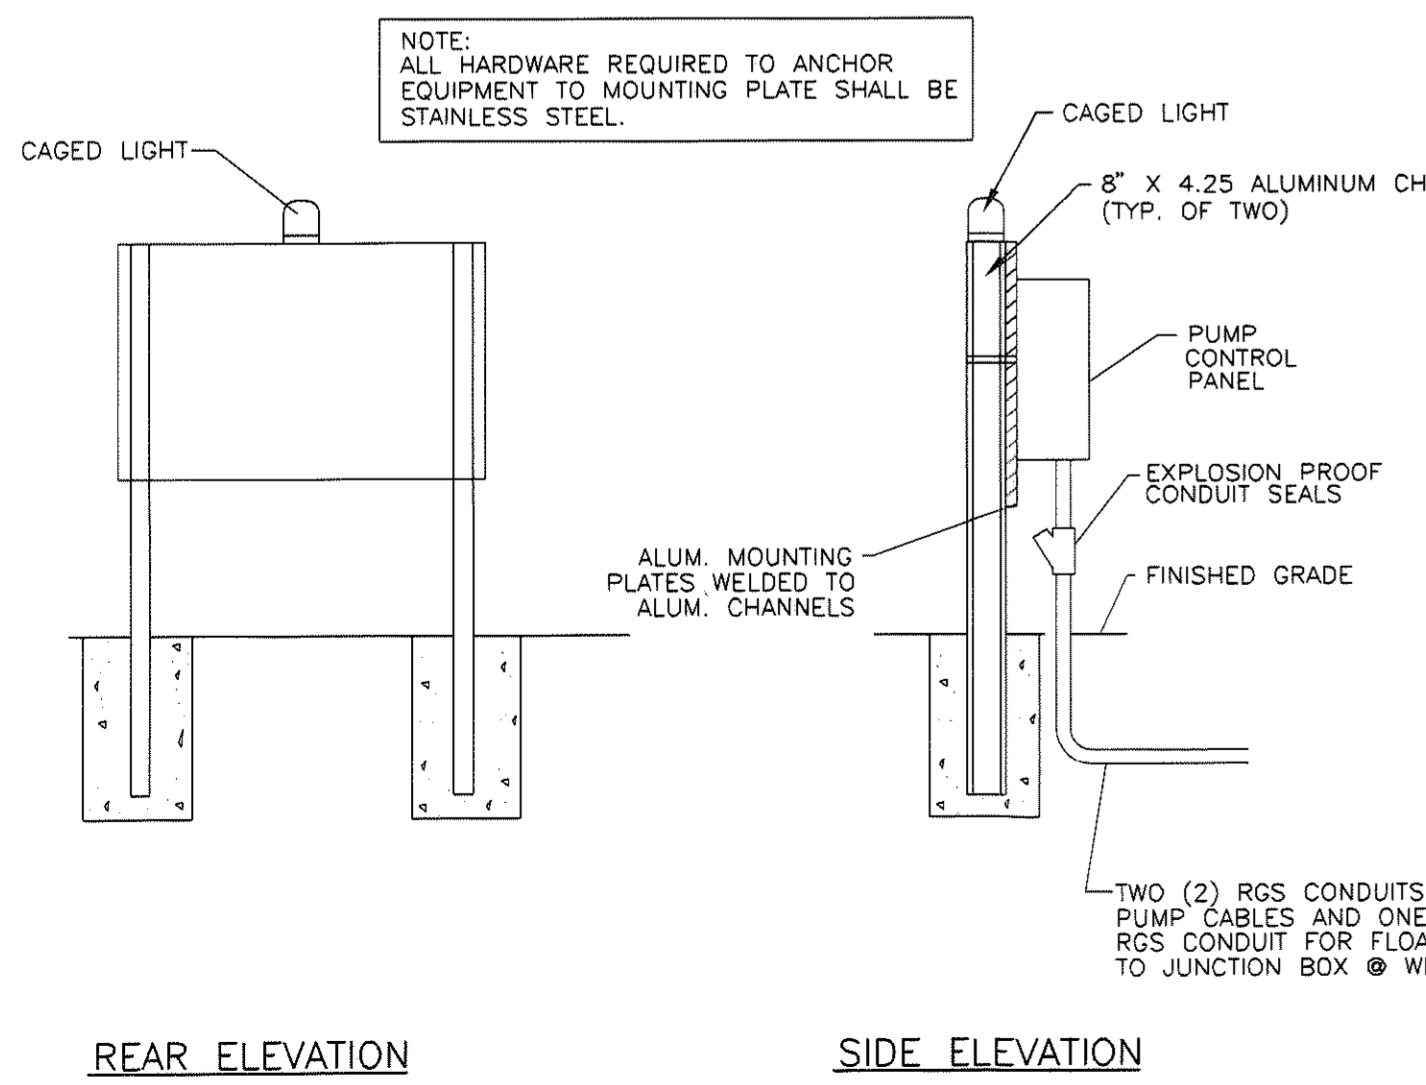

ELECTRICAL AND PUMP CONTROL MOUNTING DETAIL
 NO SCALE

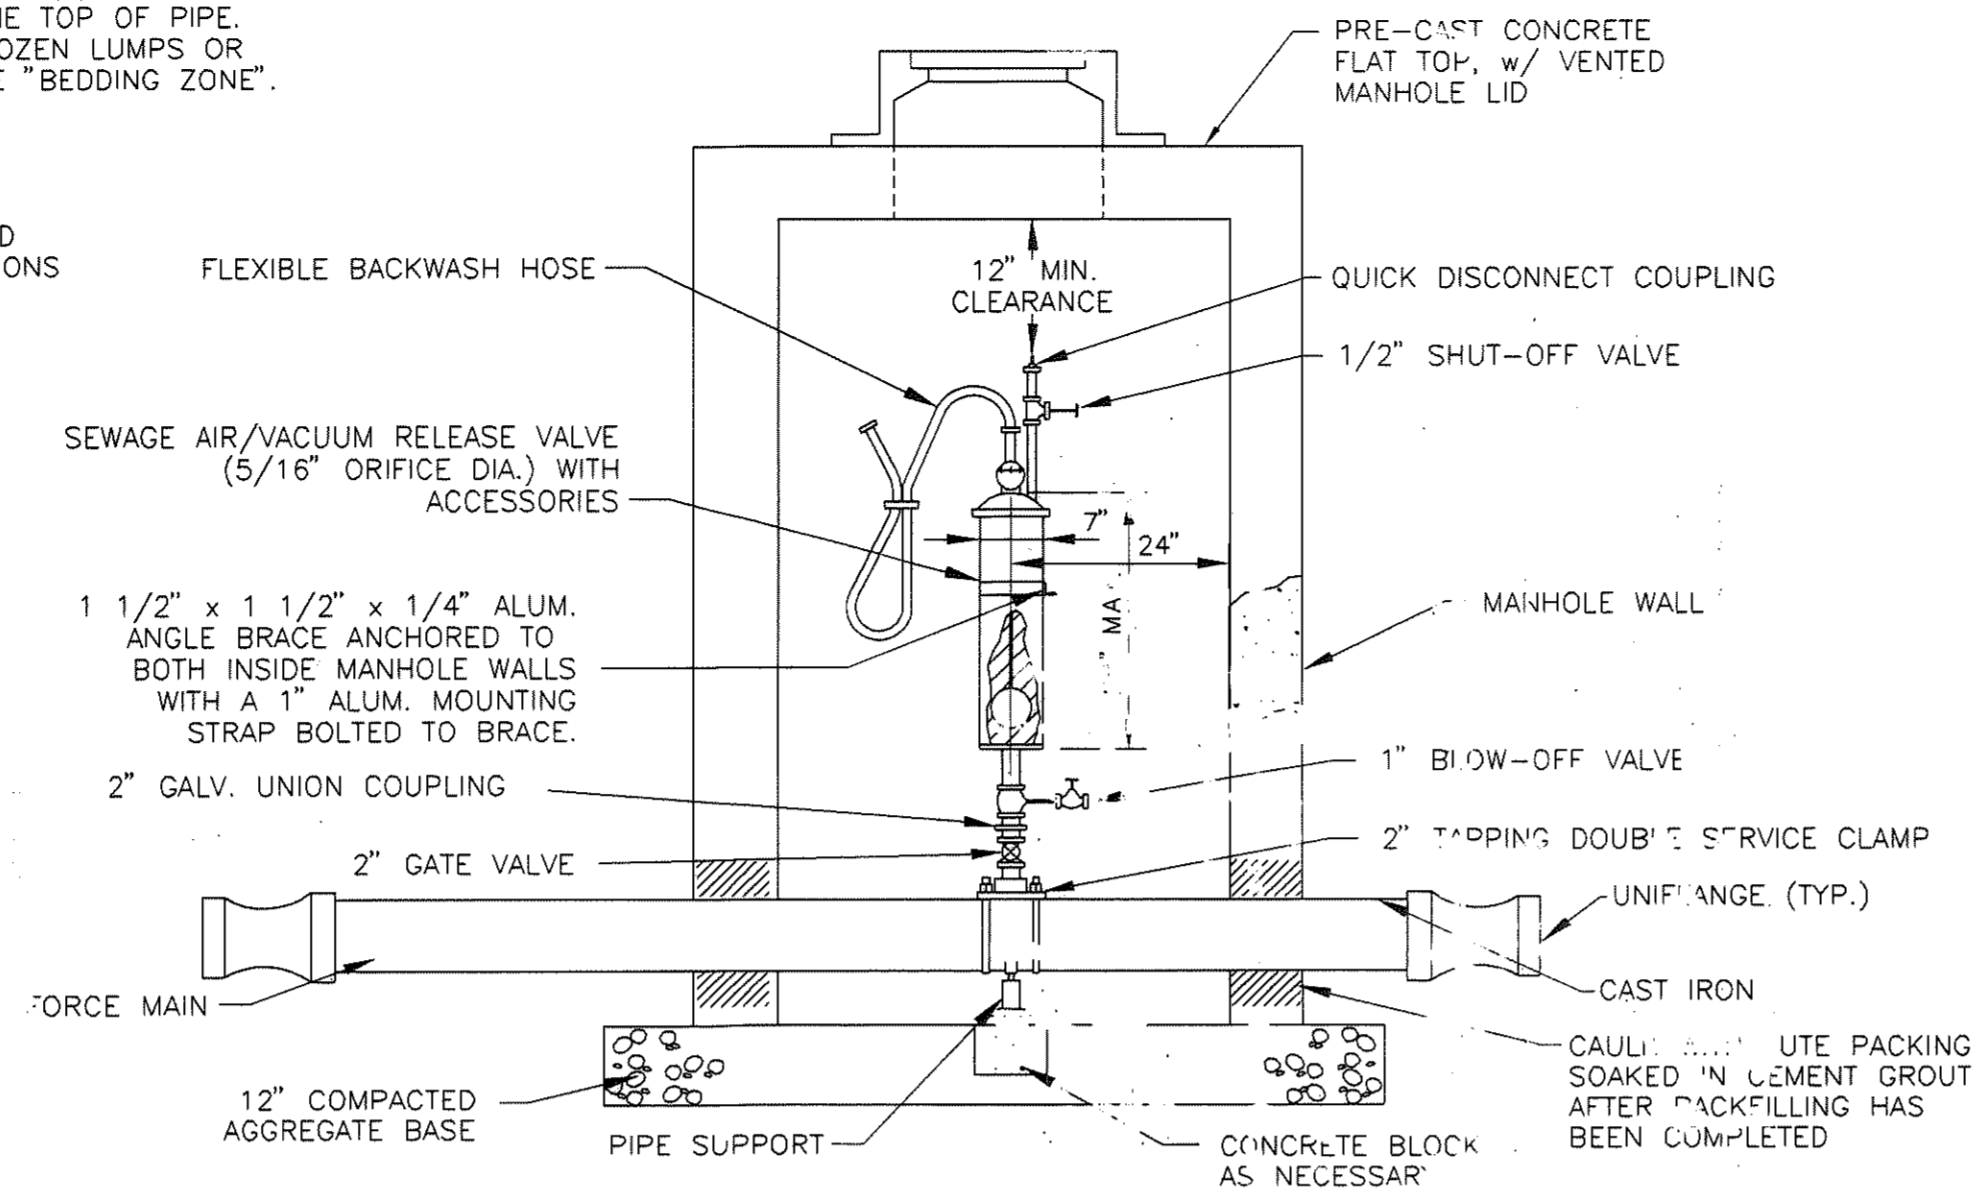


TYPICAL AIR/VACUUM RELEASE VALVE WITH CONNECTION
 NO SCALE

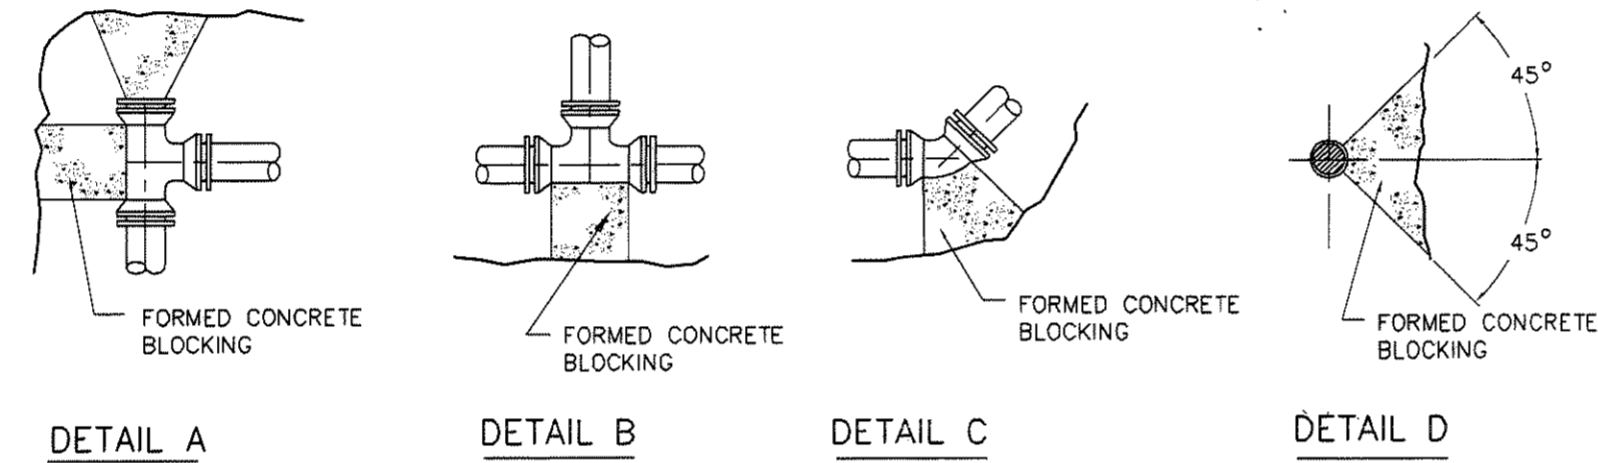


SIZE	TEE & PLUG	90° BEND	45° BEND	22-1/2° BEND	45° BEND
4"	2.0	2.5	1.5	1.0	1.0
6"	4.0	5.5	3.0	1.5	1.0
8"	6.5	9.0	5.0	2.5	1.5
10"	10.0	14.0	7.5	4.0	2.0
12"	14.0	20.0	11.0	5.5	3.0
16"	20.5	28.5	15.5	8.0	4.0
18"	31.5	44.5	24.0	12.5	6.5
20"	38.0	54.5	29.5	15.0	7.4
24"	55.0	78.5	42.5	22.0	11.0

THRUST BLOCKING DETAIL
 NO SCALE

- NOTE:**
- THRUST BLOCK AREAS ARE BASED ON A SOIL BEARING LOAD OF 2,000 LB./SQ. FT.
 - PREPARE ALL PIPE SURFACES PRIOR TO PLACEMENT OF CONCRETE

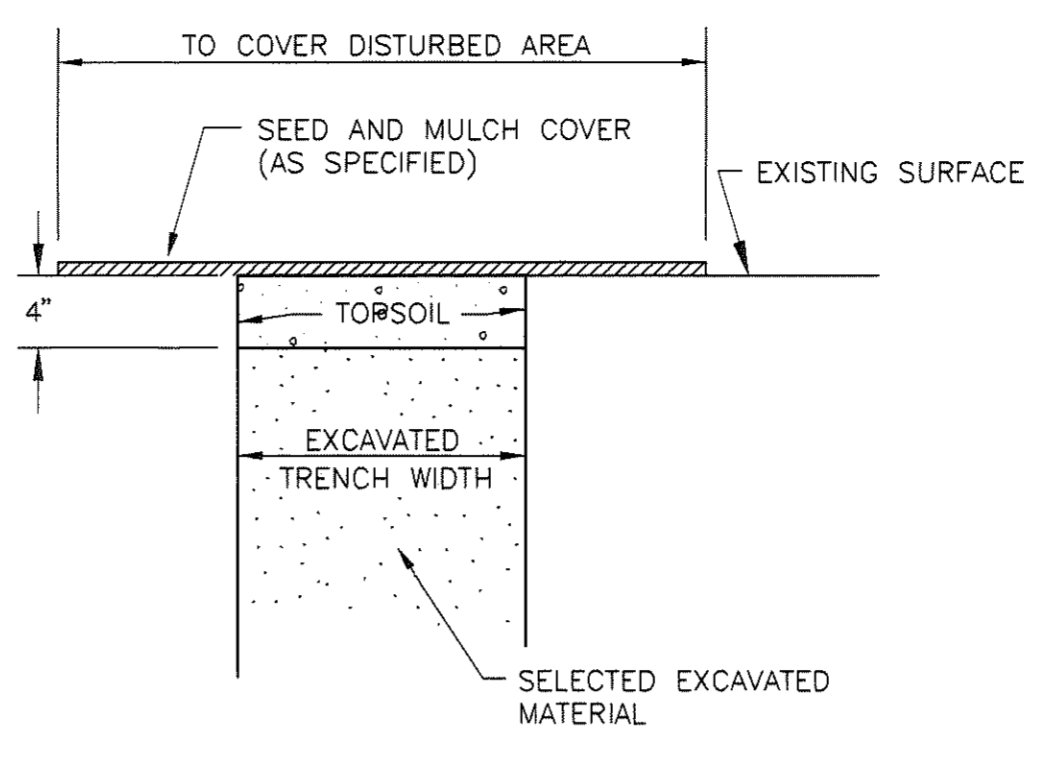


SURFACE RESTORATION DETAIL FOR GRASS AREAS
 NO SCALE

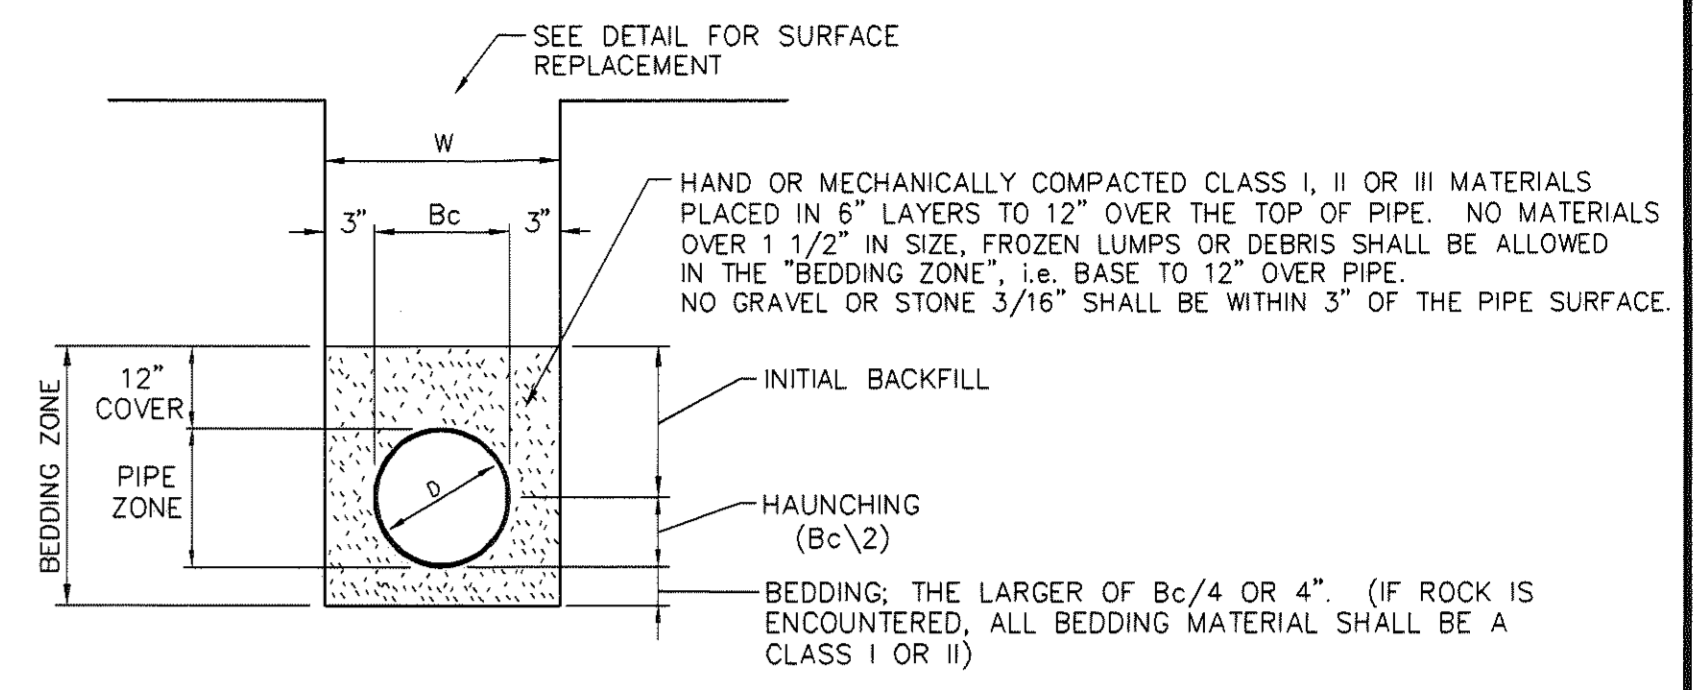


- W = MINIMUM ALLOWABLE TRENCH WIDTH FOR PIPE SHALL BE NOT LESS THAN PIPE O.D. PLUS 6"
 D = PIPE DIAMETER (INTERNAL)
 Bc = PIPE DIAMETER (EXTERNAL)
- NOTES:**
- INITIAL BACKFILL STOPS AT A POINT 12" ABOVE THE TOP OF THE PIPE. BACKFILLING ABOVE THIS POINT SHALL BE IN ACCORDANCE WITH THE SPECIFICATIONS AND AS REQUIRED BY NOTES 3 & 4 BELOW.
 - BEDDING, HAUNCHING AND INITIAL BACKFILL SHALL BE CLASS I, II, OR III MATERIALS IN ACCORDANCE WITH THE WORKMANSHIP AND MATERIALS SPECIFICATIONS.
 - WORK FALLING UNDER THE JURISDICTION OF THE INDIANA STATE HIGHWAY COMMISSION SHALL UTILIZE COMPACTED GRANULAR BACKFILL MATERIAL FOR INITIAL AND FINAL BACKFILL ANYWHERE WITHIN 12 FEET OF THE EDGE OF PAVEMENT.
 - WORK FALLING UNDER THE JURISDICTION OF TOWN OR COUNTY HIGHWAY DEPARTMENTS SHALL UTILIZE COMPACTED GRANULAR BACKFILL MATERIAL FOR INITIAL AND FINAL BACKFILL ANYWHERE WITHIN 5 FEET OF THE EDGE OF PAVEMENT.


FORCE MAIN TRENCHER INSTALLATION TRENCH AND BACKFILL DETAIL
 NO SCALE

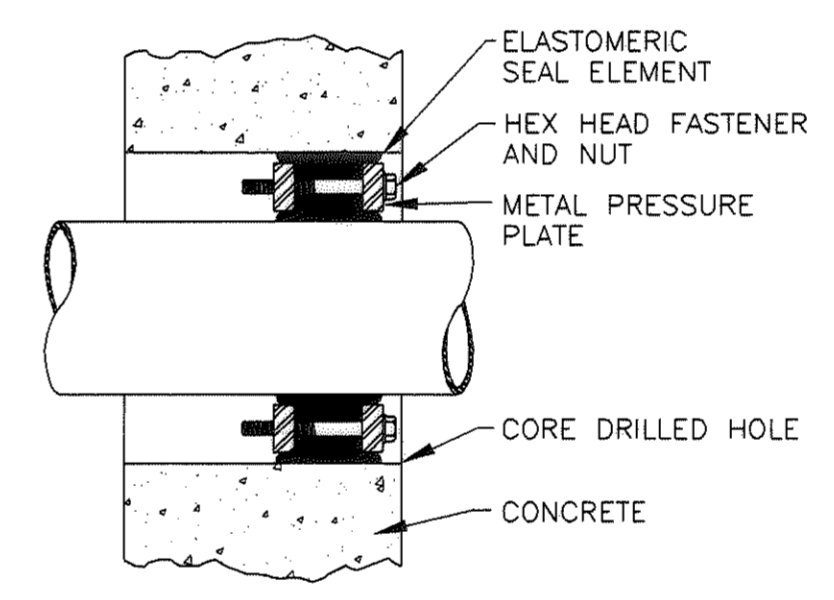

CORE DRILL/WATERTIGHT DETAIL
 NO SCALE

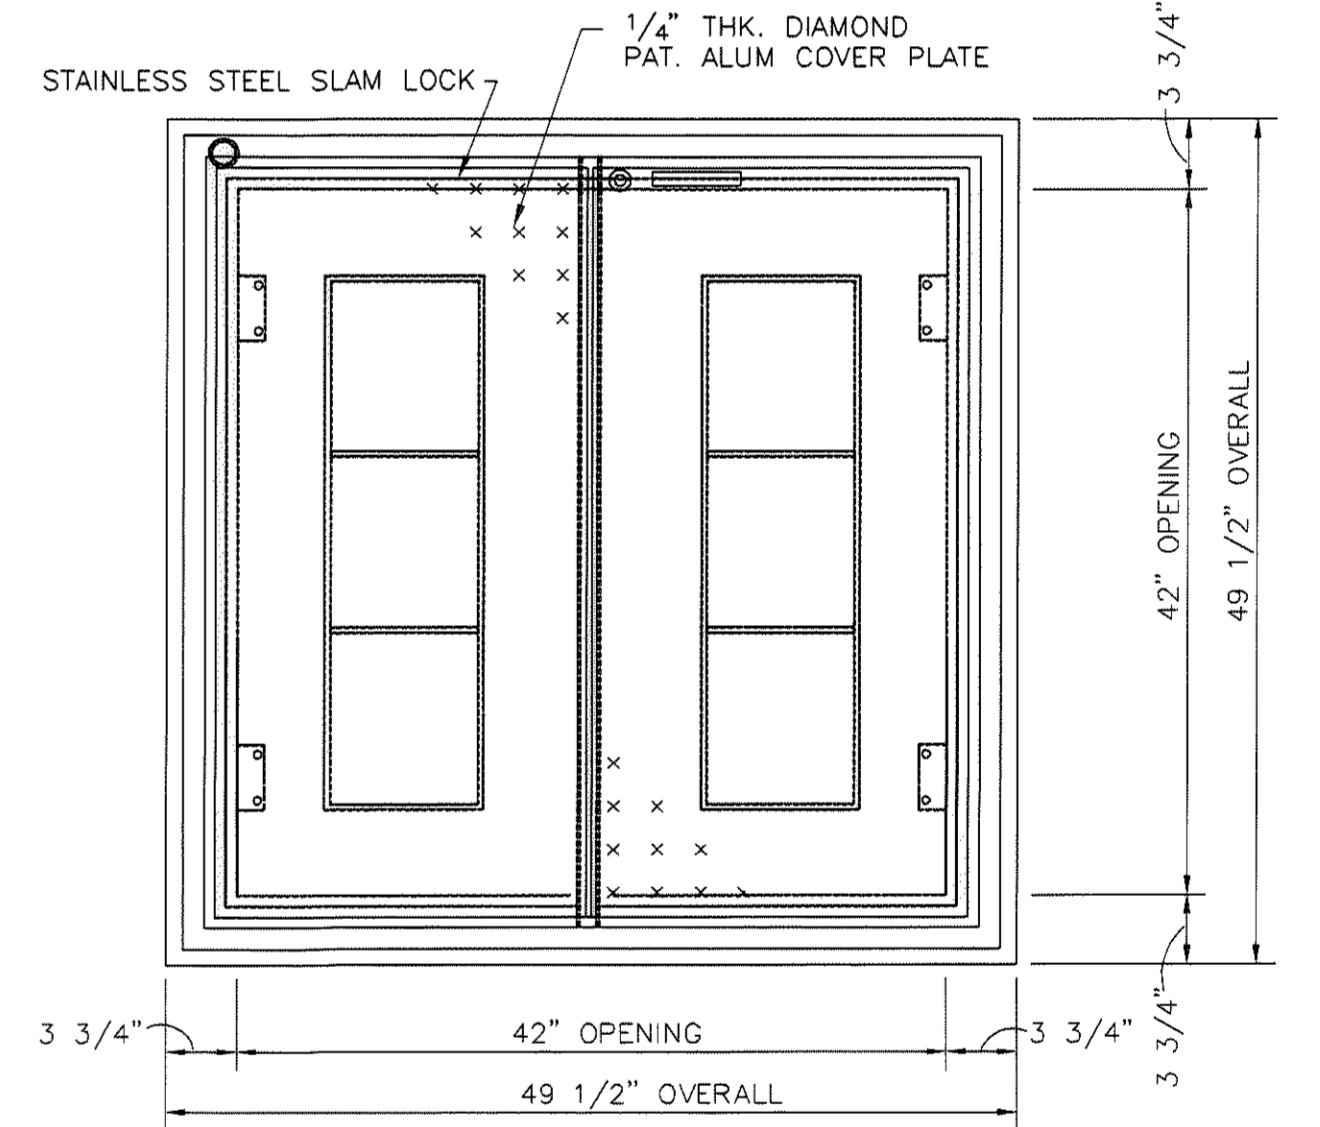

DROP LEAF ACCESS DOOR
 NO SCALE

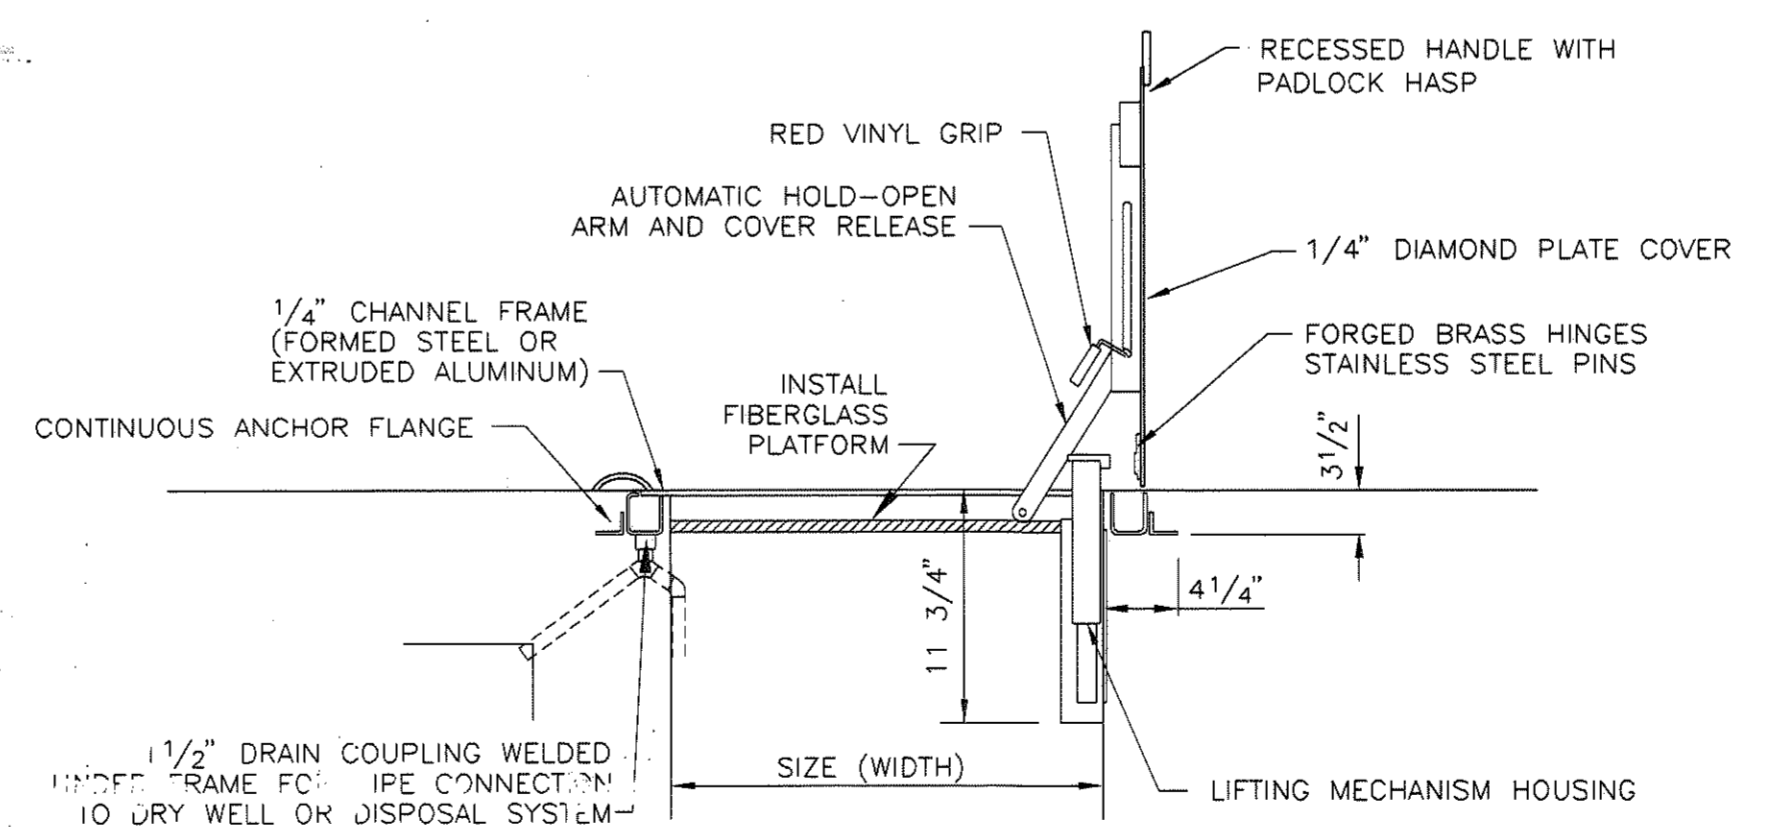


SINGLE LEAF ACCESS DOOR
 NO SCALE

REVISED "AS-BUILT" DRAWING

THIS DRAWING HAS BEEN REVISED IN ACCORDANCE WITH NOTES ON "RECORD DRAWINGS" FURNISHED BY THE CONTRACTOR AND WITH EXECUTED CHANGE ORDERS. THE BEST OF OUR KNOWLEDGE AND BELIEF, THIS DRAWING SHOWS ACTUAL "AS-BUILT" CONDITIONS.

COMMONWEALTH ENGINEERS, INC.

REVISED DATE: 10/06
 BY: JCW, CK: CWW





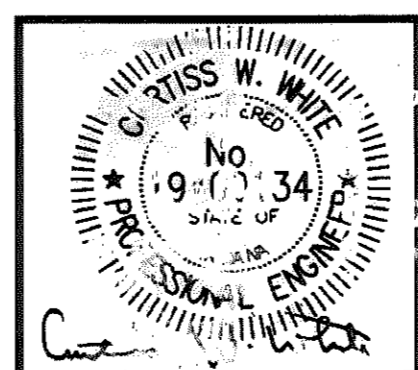


COMMONWEALTH ENGINEERS, INC.




DRAWN BY: CB
 DESIGNED BY: CWW
 CHECKED BY: CWW
 DATE: 1/04
 JOB NO: S02119-02
 SCALE: AS NOTED

SALAMONIE RESERVOIR
 WASTEWATER TREATMENT PLANT IMPROVEMENTS PROJECT
 PUBLIC WORKS PROJECT NO. E031410M
 MISCELLANEOUS DETAILS

DRAWING NO.
25
 25 OF 52

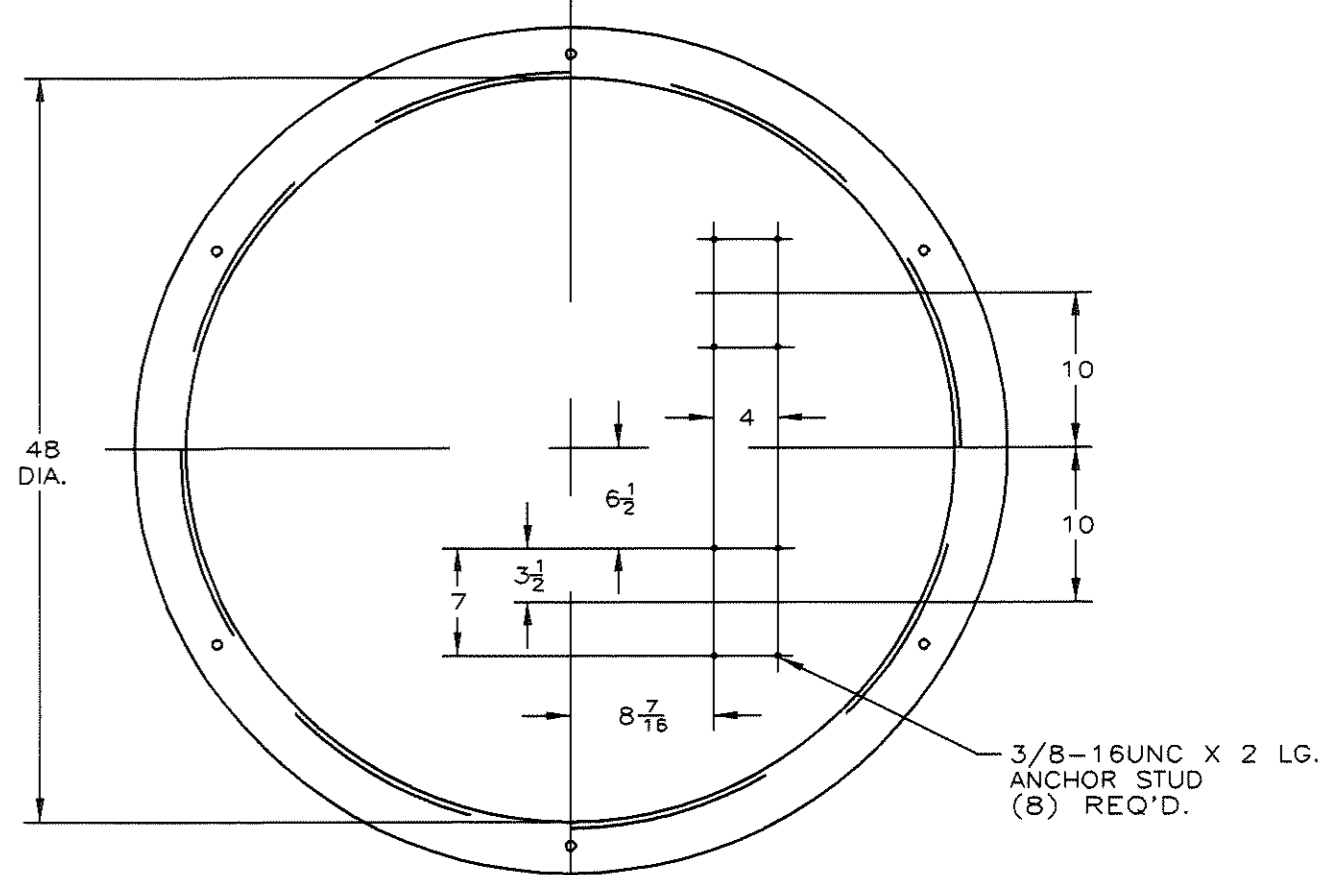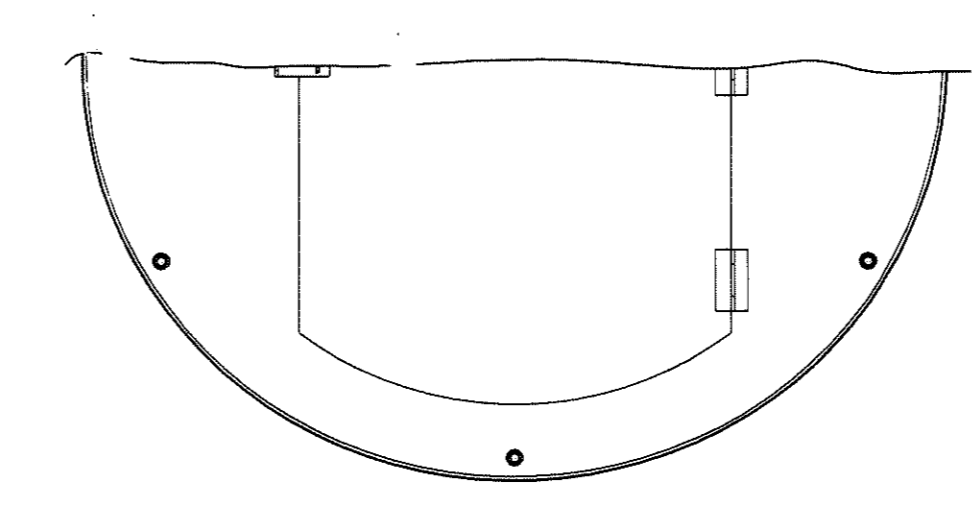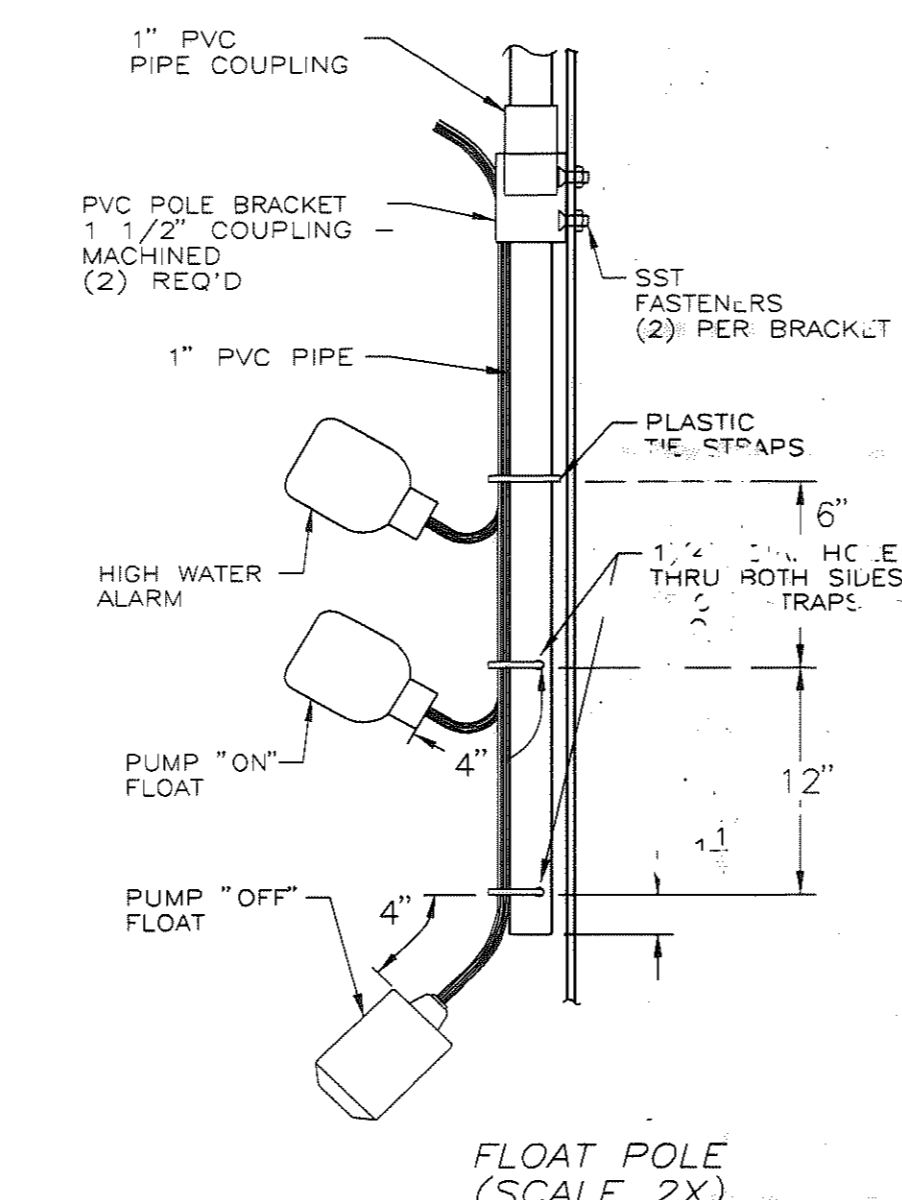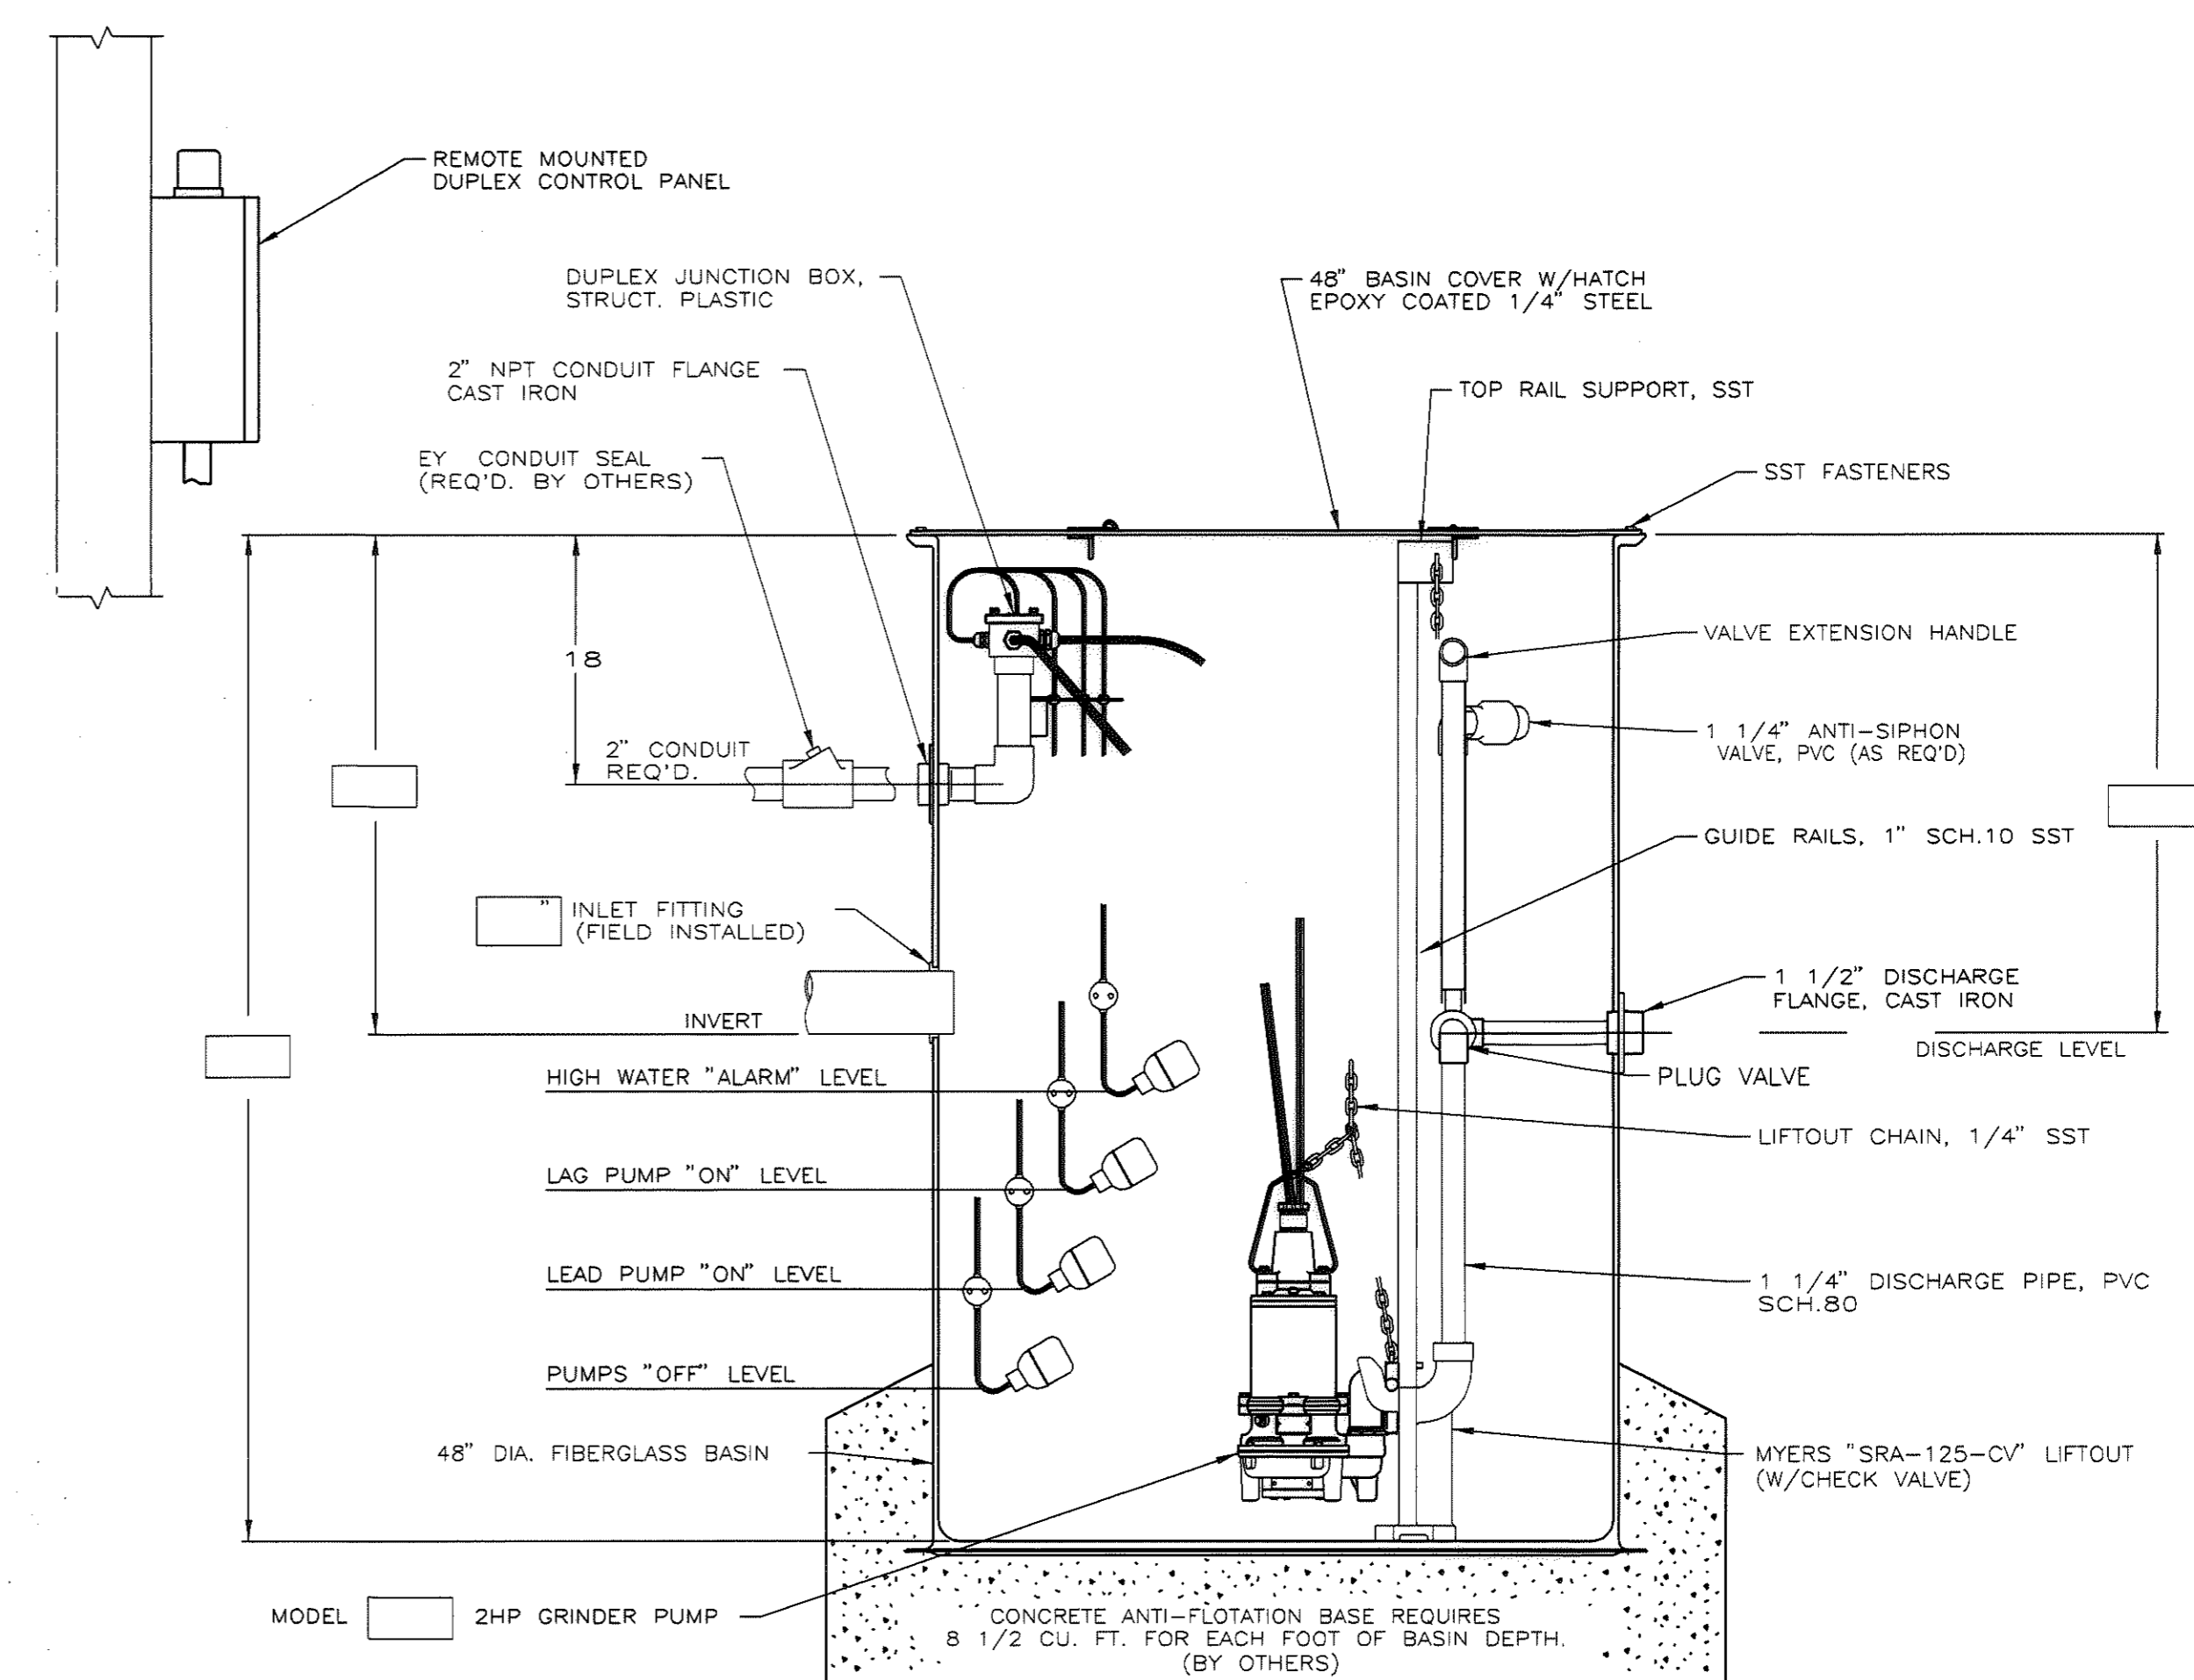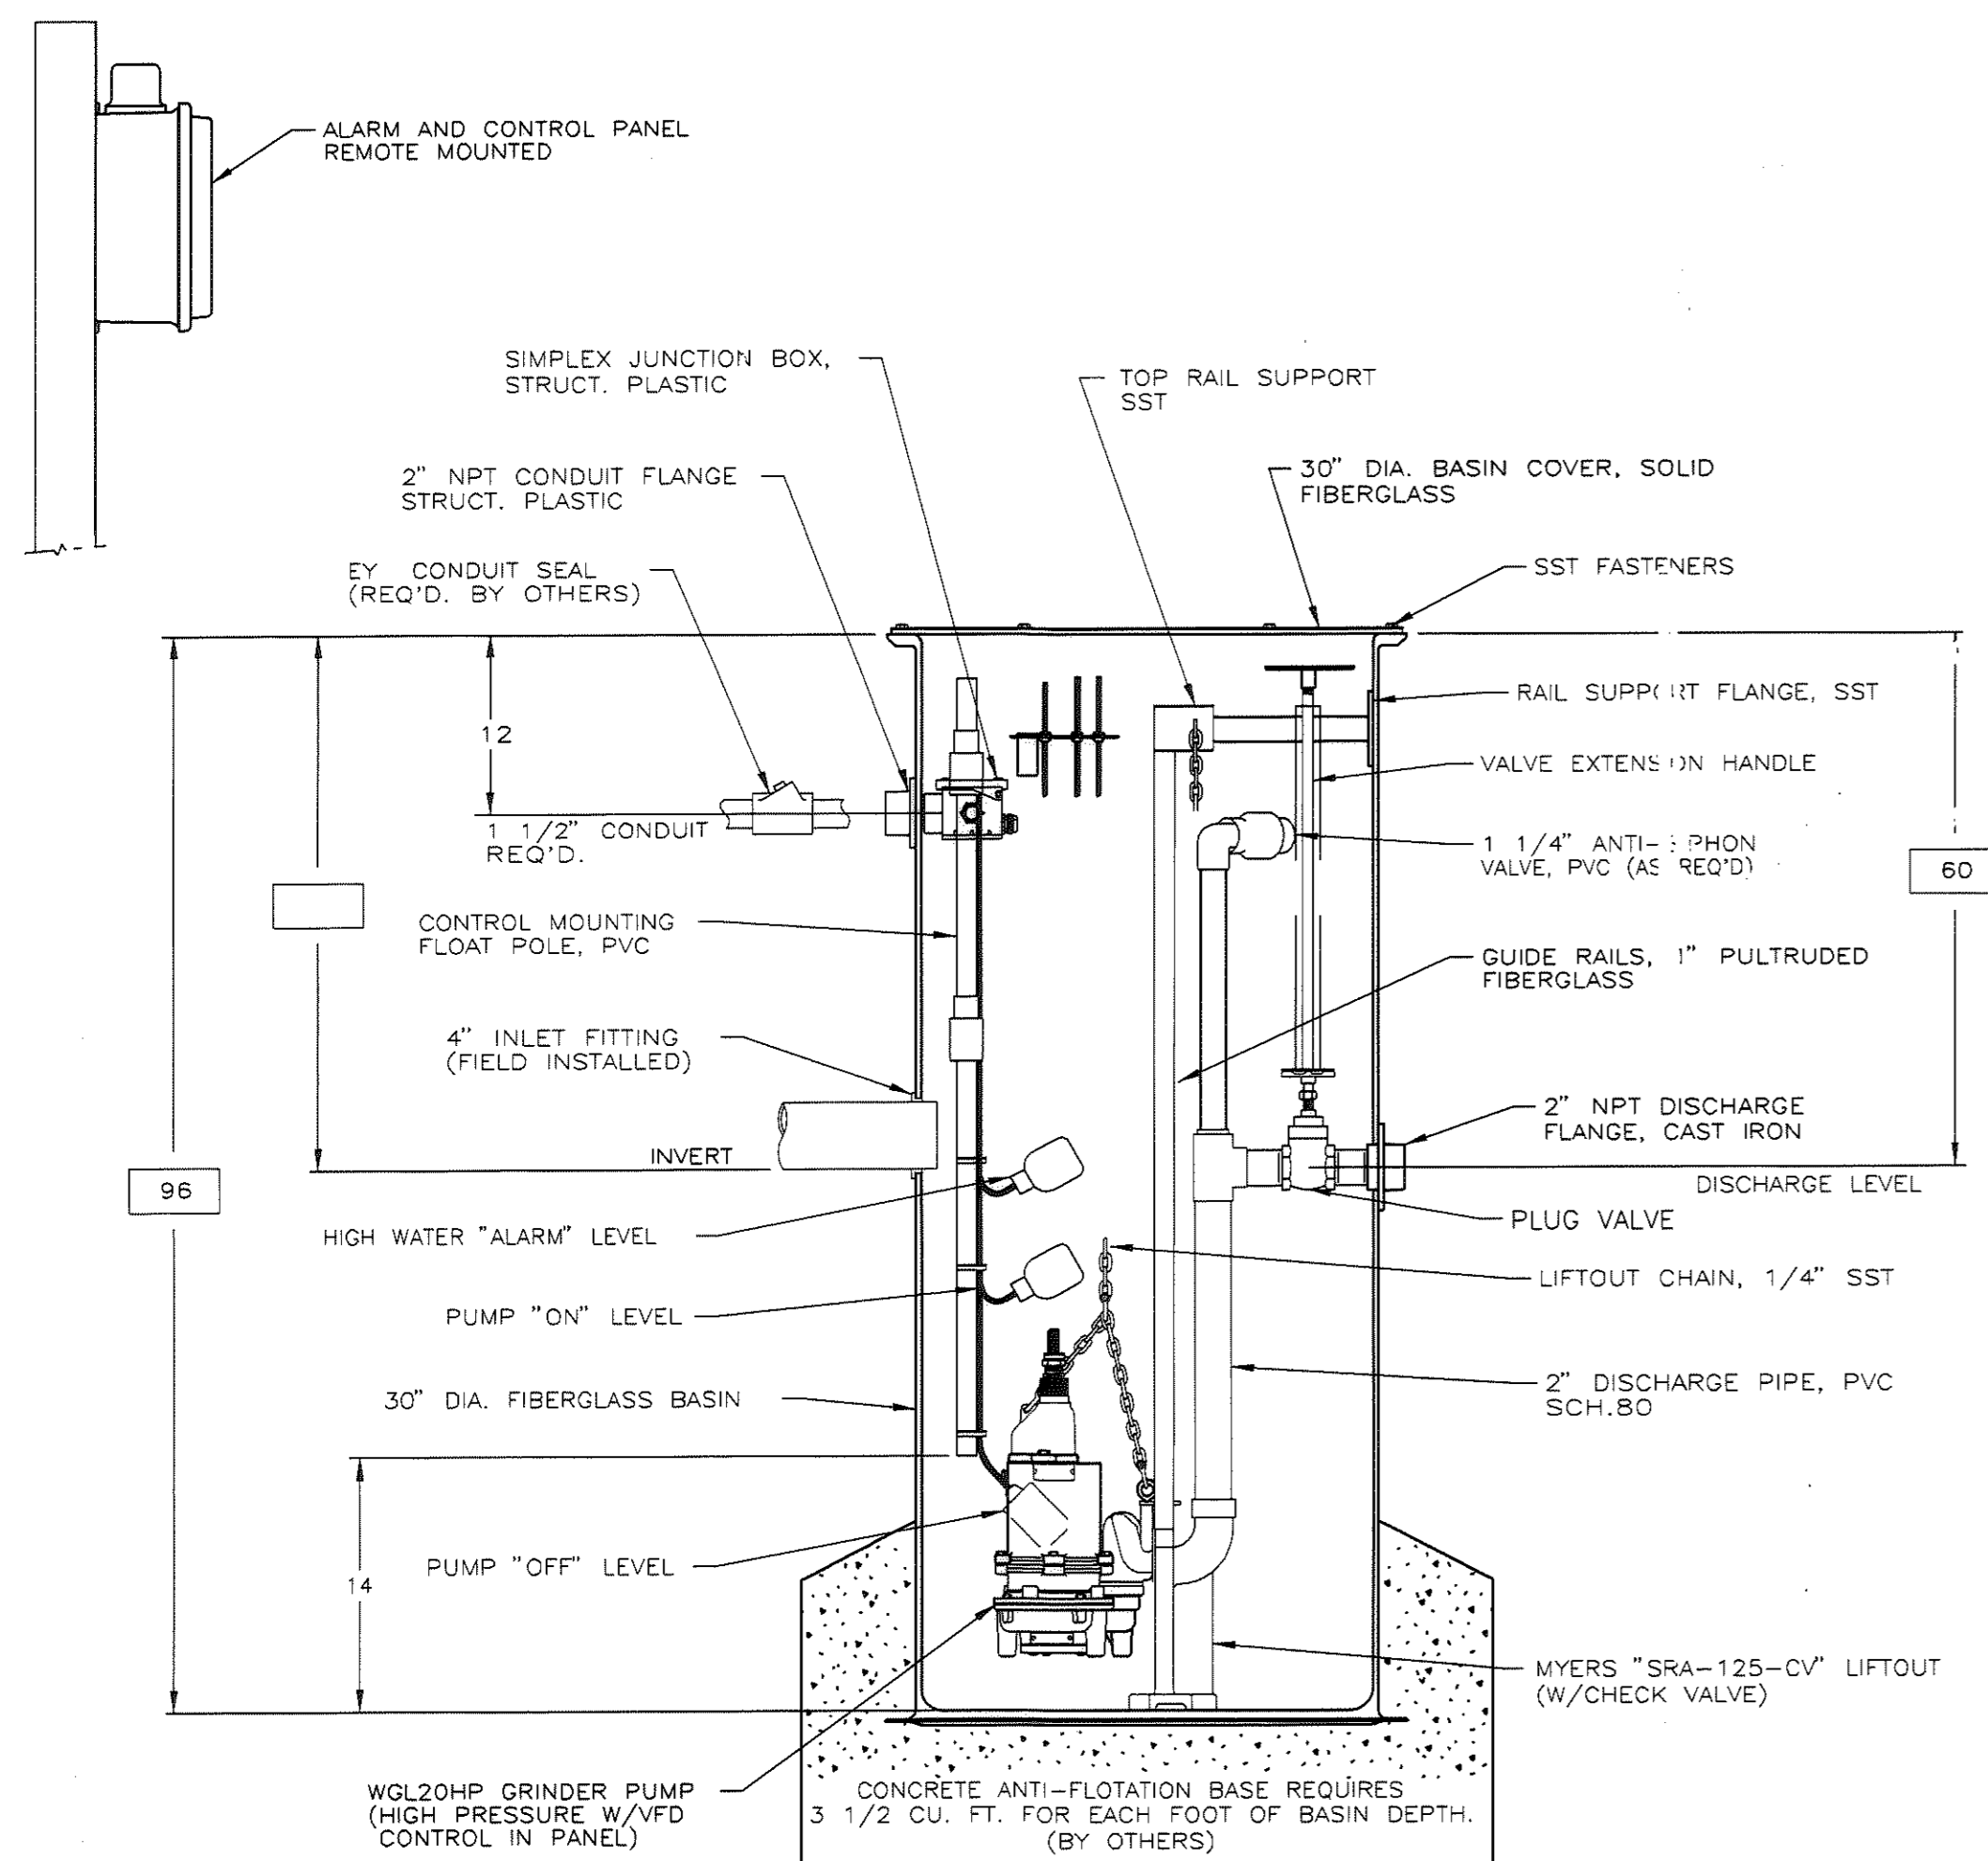

- NOTES:**
- 1.) THESE STATION DETAILS SHALL BE CONSIDERED GENERIC AND SHALL IN NO WAY BE DEEMED TO REPRESENT A SPECIFIC MANUFACTURER
 - 2.) ALL PIPE AND WIRE PENETRATIONS SHALL HAVE WATERTIGHT GASKETS
 - 3.) ALL TANKS SHALL HAVE AN ENCAPSULATED 1/4" THICK STEEL PLATE IN THE BOTTOM OF THE BASIN.
 - 4.) EACH TANK SHALL BE CAPABLE OF INCREASING IN DEPTH BY THE ADDITION OF RISERS. THESE RISERS SHALL ONLY BE USED WHEN THE NEW STATION IS TO BE SET IN AN EXISTING SEPTIC TANK UNLESS SPECIFICALLY ORDERED BY THE ENGINEER.
 - 5.) ALL CONDUCTORS SHALL BE COPPER, M STRANDED #10 AWG MINIMUM.
 - 6.) UNDERGROUND CONDUIT SHALL BE SCHEDULE 40 PVC WITH TRACER WIRE, MINIMUM SIZE 3/4" C
 - 7.) ABOVE GROUND CONDUIT SHALL BE RIGID GALVANIZED STEEL OR SCH. 80 PVC, MINIMUM SIZE 3/4" C
 - 8.) INSTALL 3/4" C, 2-#8 GROUND CONDUCTOR FROM MAIN SWITCH TO NOT LESS THAN TWO (2) GROUNDING ELECTRODES AT BASE OF SERVICE POLE.

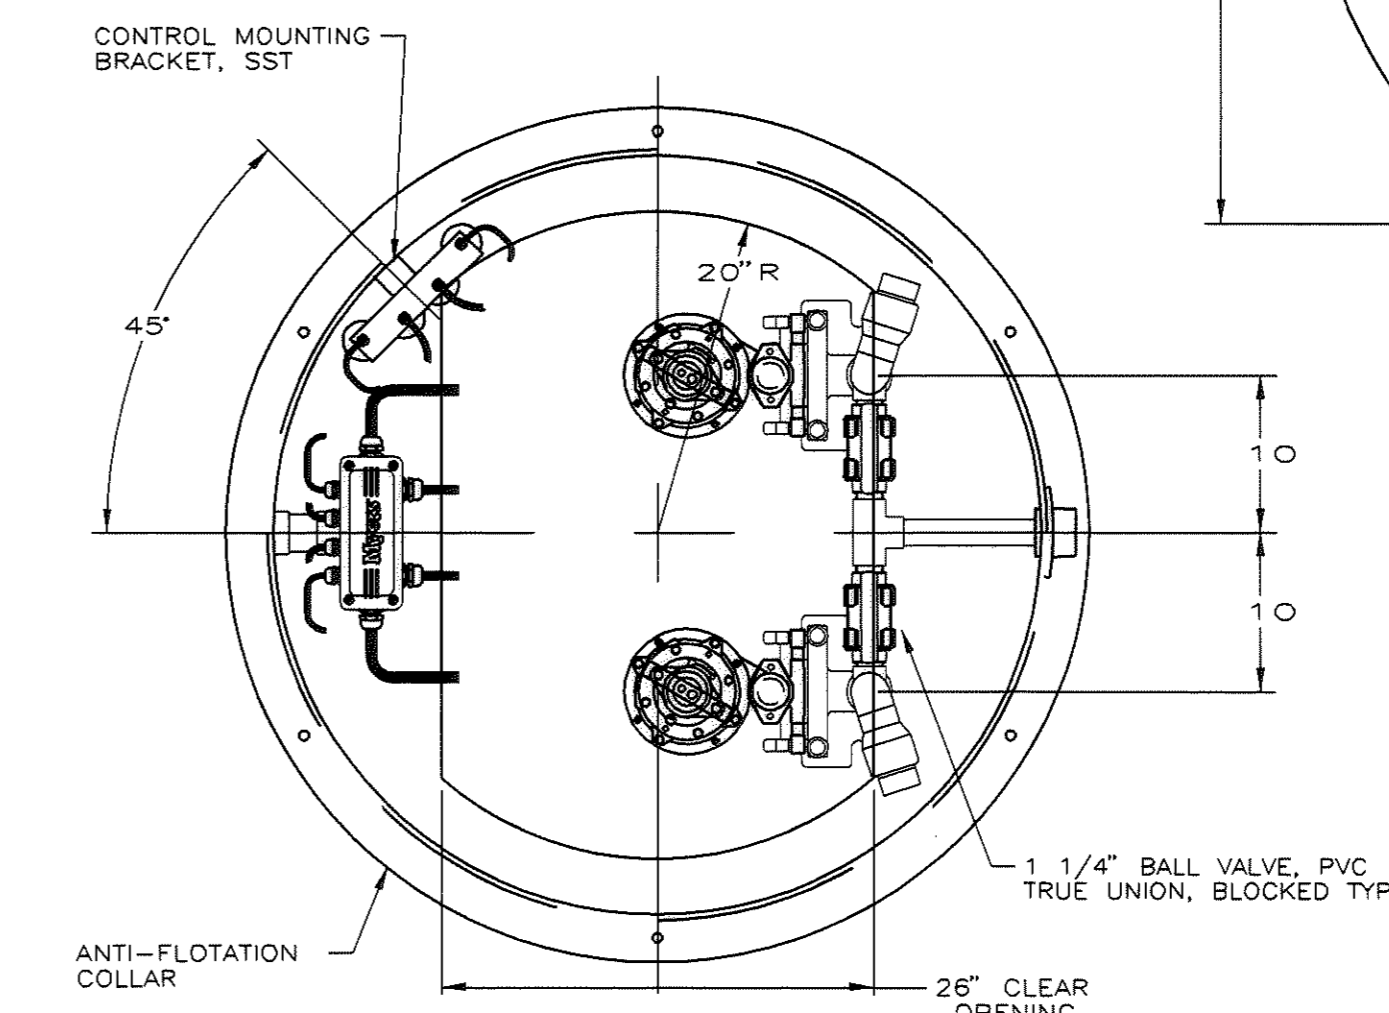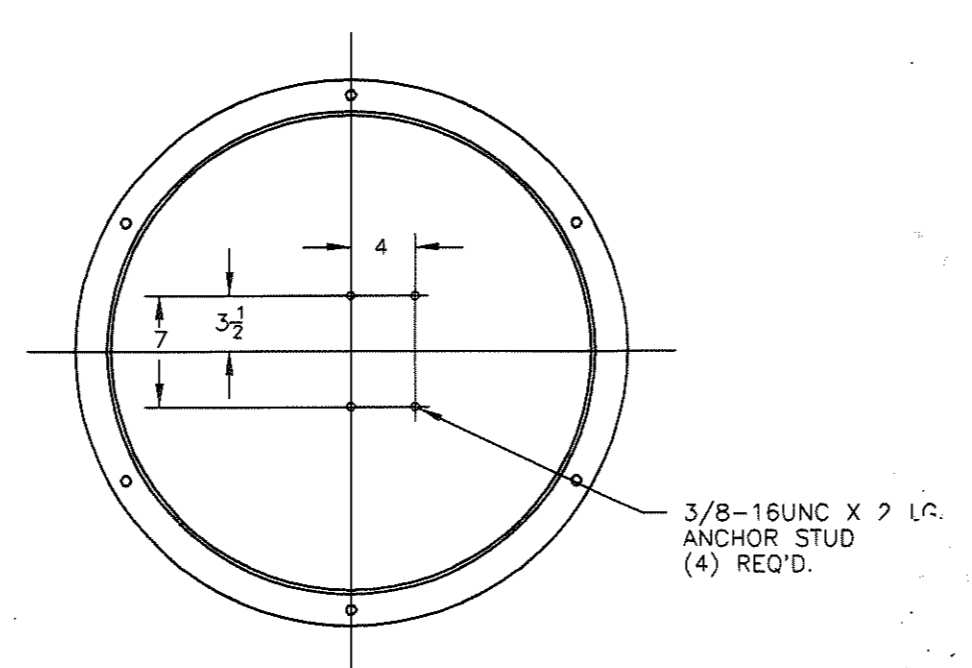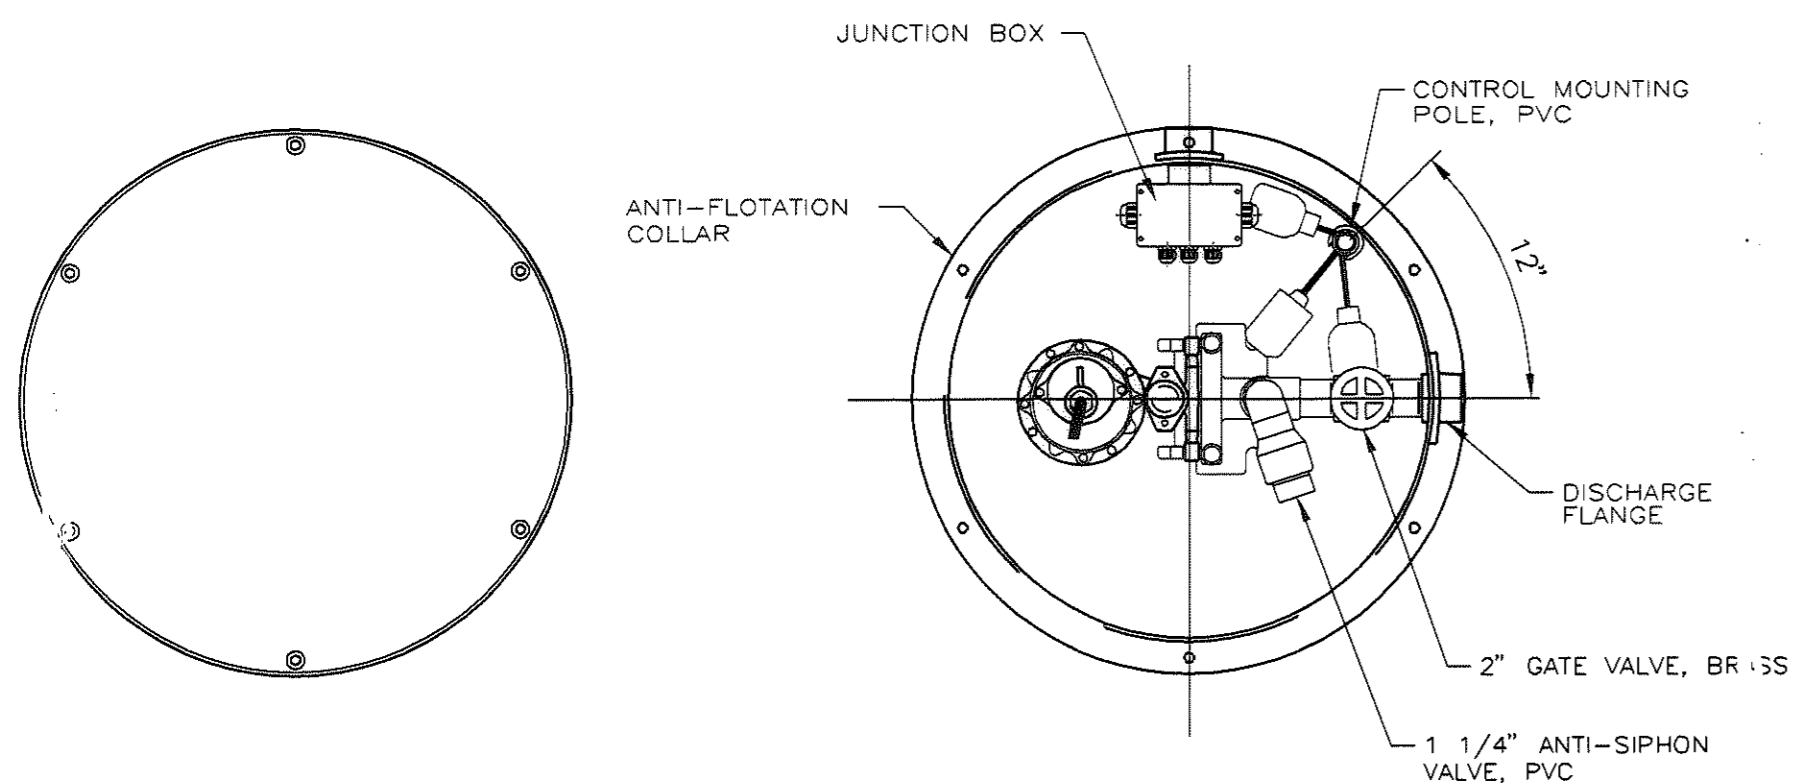


REVISED "AS-BUILT" DRAWING

THIS DRAWING HAS BEEN REVISED IN ACCORDANCE WITH NOTES ON "RECORD DRAWINGS" FURNISHED BY THE CONTRACTOR AND WITH EXPEDITED CHANGE ORDERS. TO THE BEST OF OUR KNOWLEDGE AND BELIEF, THIS DRAWING SHOWS ACTUAL "AS-BUILT" CONDITIONS.

COMMONWEALTH ENGINEERS, INC.

REVISED: DATE 10/06
BY JCW, CK. BY CWW

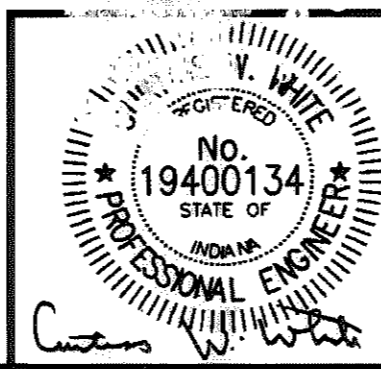

COMMONWEALTH ENGINEERS, INC.

DRAWN BY: CB
DESIGNED BY: CWW
CHECKED BY: CWW
DATE: 1/04
JOB NO: S02119-02
SCALE: NO SCALE

SALAMONIE RESERVOIR
WASTEWATER TREATMENT PLANT IMPROVEMENTS PROJECT
PUBLIC WORKS PROJECT NO. E031410M
GRINDER STATIONS

DRAWING NO.
26
26 OF 52

STRUCTURAL NOTES:

GENERAL -

- G1. THE APPLICABLE BUILDING CODE FOR THIS PROJECT IS THE 2000 INTERNATIONAL BUILDING CODE WITH THE 2003 INDIANA BUILDING CODE AMENDMENTS.
- G2. THE CONTRACTOR SHALL CHECK AND APPROVE ALL SHOP DRAWINGS PRIOR TO SUBMITTING SAME TO THE STRUCTURAL ENGINEER FOR REVIEW. FAILURE TO COMPLETELY CHECK THE SHOP DRAWINGS DOES NOT RELIEVE THE CONTRACTOR OF RESPONSIBILITY FOR PROBLEMS THAT MAY ARISE FROM COORDINATION, DETAILING, FABRICATION OR ERECTION ERRORS. ONE SEPIA PAPER COPY AND ONE BLUELINE COPY OF EACH SHOP DRAWING SHALL BE SUBMITTED TO THE STRUCTURAL ENGINEER FOR REVIEW. THE SEPIA PAPER COPY WILL BE RETURNED TO THE CONTRACTOR WITH THE STRUCTURAL ENGINEER'S REVIEW COMMENTS. THE CONTRACTOR SHALL MAKE BLUELINE COPIES OF THE MARKED-UP SEPIA PAPER DRAWINGS FOR DISTRIBUTION IN ACCORDANCE WITH THE SPECIFICATIONS. THE SEPIA PAPER COPY SHALL BE RETURNED TO THE DETAILER FOR CORRECTIONS.
- G3. THE USE OF REPRODUCTIONS OF THESE CONTRACT DRAWINGS BY THE CONTRACTOR OR ANY SUB-CONTRACTOR, DETAILER, FABRICATOR, ERECTOR, MATERIAL SUPPLIER, ETC. IN LIEU OF THE PREPARATION OF SHOP OR ERECTION DRAWINGS SHALL SIGNIFY THE ACCEPTANCE OF THE INFORMATION SHOWN HEREON AS CORRECT AND OBLIGATES THE CONTRACTOR TO ANY JOB EXPENSE ARISING DUE TO ANY ERRORS THAT MAY OCCUR HEREON.
- G4. THESE DRAWINGS REPRESENT THE STRUCTURAL COMPONENTS IN THEIR FINAL AND COMPLETED STATE. CONSTRUCTION PROCEDURES AND METHODS (INCLUDING, BUT NOT LIMITED TO, TEMPORARY SHORING AND BRACING), SAFETY PRECAUTIONS AND/OR MECHANICAL REQUIREMENTS TO ERECT THE ELEMENTS OF THIS BUILDING ARE THE SOLE RESPONSIBILITY OF THE GENERAL CONTRACTOR AND/OR SUBCONTRACTORS DOING THE WORK.
- G5. PROPRIETARY PRODUCTS OF INDIVIDUAL MANUFACTURERS AND/OR TRADEMARKED PRODUCTS ARE SPECIFIED HEREIN ON AN "OR APPROVED EQUAL" BASIS. AT THE CONTRACTOR'S OPTION, MANUFACTURER'S DATA ON ALTERNATE PRODUCTS OF EQUAL QUALITY MAY BE SUBMITTED TO THE ARCHITECT FOR APPROVAL. UPON THE APPROVAL OF THE ARCHITECT, THESE ALTERNATE PRODUCTS MAY BE USED IN LIEU OF THE SPECIFIED PRODUCTS.

GEOTECHNICAL REPORT, SLAB ON GRADE AND FOUNDATIONS -

- F1. FOUNDATION AND SLAB DESIGNS ARE BASED ON THE FOLLOWING ASSUMED BEARING VALUES.
- F2. THE DESIGN OF FOOTINGS BEARING ON UNDISTURBED NATIVE SOIL OR PROPERLY COMPACTED STRUCTURAL FILL IS BASED ON AN ASSUMED ALLOWABLE SOIL BEARING PRESSURE OF 2,000 psf FOR ISOLATED SPREAD COLUMN FOOTINGS AND CONTINUOUS WALL FOOTINGS.
- F3. THE CONTRACTOR SHALL ENGAGE AN APPROVED GEOTECHNICAL ENGINEERING FIRM TO INSPECT FOOTING EXCAVATIONS, SLAB SUBGRADE, SLAB BASE, ENGINEERED FILL, ETC. THE CONTRACTED GEOTECHNICAL ENGINEER SHALL CERTIFY THAT THE REQUIREMENTS SET FORTH IN THE CONTRACT DOCUMENTS, THE DUTIES OF THIS GEOTECHNICAL ENGINEER SHALL INCLUDE, BUT ARE NOT LIMITED TO THE FOLLOWING:

- INSPECT ALL FOUNDATION EXCAVATIONS TO ENSURE THAT THE BEARING STRATA CONSIST OF SUITABLE MATERIAL AND IS CAPABLE DEVELOPING THE ALLOWABLE BEARING PRESSURES LISTED IN NOTE NO. F2. DIRECT THE OVER-EXCAVATION OF ANY UNSUITABLE MATERIAL FROM FOUNDATION BEARING STRATA AS OUTLINED IN NOTE NO. F6.
- OBSERVE AND APPROVE THE STRIPPING OF ALL DELETERIOUS MATERIAL FROM THE SITE AS OUTLINED IN NOTE NO. F4 & F5.
- OBSERVE AND APPROVE THE PROOF-ROLLING OPERATION OUTLINED IN NOTE NO. F4 & F5.
- VERIFY THE PLACEMENT, AND TEST THE COMPACTION, OF ALL ENGINEERED FILL AND BACKFILL MATERIAL.
- INSPECT AND APPROVE THE SUBGRADE MATERIAL UNDER ALL CONCRETE SLABS ON GRADE AND PAVEMENTS.
- VERIFY THE PLACEMENT, AND TEST THE COMPACTION, OF THE NO. 8 STONE SLAB BASE REQUIRED IN NOTE NO. F4 & F5.
- PERFORM ANY AND ALL OTHER INSPECTIONS AND TESTS NECESSARY TO ENSURE THAT ALL FOUNDATION BEARING STRATA, SLAB SUBGRADES, GRANULAR SLAB BASES AND ENGINEERED FILLS ARE ADEQUATE FOR THE LOADS AND SERVICE.
- PROVIDE WRITTEN RECOMMENDATIONS TO THE CONTRACTOR FOR THE SHEETING, SHORING AND / OR BRACING OF ALL EXCAVATIONS TO ENSURE STABILITY. IF MATERIAL IS ENCOUNTERED AT THE SITE THAT WILL YIELD A STABLE EXCAVATION WITH SLOPED AND BENCHED SIDES, PROVIDE WRITTEN RECOMMENDATIONS TO THE CONTRACTOR IN ACCORDANCE WITH NOTE NO. F8. OBSERVE AND DIRECT THE SHEETING, SHORING, BRACING, SLOPING, BENCHING ECT. OF EXCAVATIONS TO ENSURE A SAFE AND STABLE EXCAVATION.

- F4. THE AREA UNDER THE BUILDING SLABS ON GRADE SHALL BE STRIPPED OF ALL TOPSOIL, VEGETATION, ORGANIC MATTER, SOFT SOILS, OLD UNCONTROLLED FILL OR ANY OTHER DELETERIOUS MATERIAL (SEE NOTE NO. F5). THE STRIPPING SHALL EXTEND AT LEAST FIVE FEET BEYOND THE BUILDING PERIMETER. AFTER THE STRIPPING OPERATION IS COMPLETE, THE AREA SHALL BE PROOF-ROLLED WITH A HEAVILY LOADED, RUBBER-TIRED DUMP TRUCK UNDER THE DIRECT SUPERVISION OF THE GEOTECHNICAL ENGINEER IDENTIFIED IN NOTE NO. F3. ANY SOFT OR YIELDING AREAS SHALL BE UNDERCUT TO FIRM MATERIAL, THEN RE-ROLLED. AFTER THE PROOF-ROLLING OPERATION IS COMPLETE, THE AREA SHALL BE BROUGHT TO GRADE WITH SUITABLE STRUCTURAL FILL COMPACTED TO 98% OF STANDARD PROCTOR DENSITY. THE LAST 6" OF FILL UNDER THE SLAB ON GRADE SHALL BE NO. 8 STONE COMPACTED TO 98% OF STANDARD PROCTOR DENSITY. FILL SHALL BE PLACED AND COMPACTED IN 8" MAXIMUM LIFTS AND AT A MOISTURE CONTENT WITHIN 2% OF OPTIMUM.
- F5. IF UNSUITABLE MATERIAL IS ENCOUNTERED AT THE FOOTING BEARING ELEVATION, THE EXCAVATION SHALL BE UNDERCUT TO SUITABLE MATERIAL. THE WIDTH OF THE FOUNDATION EXCAVATION SHALL BE INCREASED IN EACH DIRECTION BY THE DEPTH OF THE UNDERCUT. AFTER SUITABLE BEARING MATERIAL IS ENCOUNTERED, THE EXCAVATION SHALL BE BROUGHT TO PROPER BEARING ELEVATION WITH COMPACTED NO. 8 STONE. THE NO. 8 STONE SHALL BE PLACED AND COMPACTED IN 8" (MAX.) LIFTS TO 100% OF THE MAXIMUM RELATIVE DENSITY.
- F6. FOUNDATION CONCRETE SHALL BE PLACED THE SAME DAY THAT THE EXCAVATION IS OPENED. IF THIS IS NOT PRACTICAL, THE CONTRACTOR SHALL TAKE STEPS TO ENSURE THAT THE BEARING MATERIAL IS NOT DEGRADED BY SIGNIFICANT CHANGES IN MOISTURE CONTENT.
- F7. THE STABILITY OF ALL EXCAVATIONS IS THE RESPONSIBILITY OF THE CONTRACTOR. SHEET PILING, SHORING AND / OR BRACING SHALL BE INSTALLED TO MAINTAIN THE STABILITY OF EXCAVATIONS. THE DESIGN OF ALL SHEETING, SHORING AND BRACING IS THE RESPONSIBILITY OF THE CONTRACTOR.
- F8. TOPSOIL SHALL BE STRIPPED AND STOCKPILED FOR USE IN LANDSCAPING. AT THE END OF THE JOB, PORTIONS OF TOPSOIL NOT USED IN LANDSCAPING SHALL BE DISPOSED OF, OFF-SITE IN A LEGAL MANNER.

DESIGN LOADS -

- DL1. BUILDING CODES:
2000 INTERNATIONAL BUILDING CODES WITH THE 2003 INDIANA BUILDING CODE AMENDMENTS.
- DL2. ROOF LIVE LOAD: 50 psf.
ROOF SNOW LOAD:
GROUND SNOW LOAD (F_s): 27 psf.
FLAT-ROOF SNOW LOAD (F_f): 17 psf.
SNOW EXPOSURE FACTOR (C_e): 1.0
SNOW LOAD IMPORTANCE FACTOR (I_s): 1.2
THERMAL FACTOR (C_t): 1.0
- DL3. FLOOR SYSTEM:
FLOOR LIVE LOAD: 50 psf.
FLOOR DEAD LOAD: 15 psf.
- DL4. WIND LOADS:
BASIC WIND SPEED (V₃₀): 90 mph.
IMPORTANCE FACTOR (I_w): 1.15.
BUILDING CATEGORY: III
EXPOSURE: C
DESIGN WIND PRESSURE (W_{MFRS}): 27 psf.
DESIGN WIND PRESSURE (W_{ALLS}): 18 psf.
INTERNAL PRESSURE COEFFICIENT (GC_p): ±0.18.
- DL5. SEISMIC:
SEISMIC USE GROUP: III
SPECTRAL RESPONSE COEFFICIENT (S_{ps}): 0.183.
SPECTRAL RESPONSE COEFFICIENT (S_{ps1}): 0.137.
SEISMIC DESIGN CATEGORY: C
SITE CLASS: D
IMPORTANCE FACTOR (I_s): 1.50.
BASIC SEISMIC FORCE RESISTING SYSTEM: WOOD STRUCTURAL SHEARWALLS.
RESPONSE MODIFICATION COEFFICIENT (R): 6.0.
DESIGN BASE SHEAR (V): 0.046W.
ANALYSIS PROCEDURE: EQUIVALENT LATERAL FORCE.
- DL6. SOIL INFORMATION:
ALLOWABLE NET BEARING PRESSURE: 2000 psf (ASSUMED).

CONCRETE -

- C1. CONCRETE MIX DESIGN, PLACING AND TESTING SHALL BE IN ACCORDANCE WITH THE "SPECIFICATIONS FOR STRUCTURAL CONCRETE FOR BUILDINGS" (ACI 301) BY THE AMERICAN CONCRETE INSTITUTE (ACI), LATEST EDITION.
- C2. DETAILING, FABRICATION AND PLACING OF REINFORCING SHALL BE IN ACCORDANCE WITH ACI 308, "DETAILS AND DETAILING OF CONCRETE REINFORCEMENT" AND ACI 318, "BUILDING CODE REQUIREMENTS FOR REINFORCED CONCRETE", LATEST EDITIONS.
- C3. THE CONTRACTOR SHALL MAINTAIN A COPY OF THE "FIELD REFERENCE MANUAL", ACI PUBLICATION SP-15 (LATEST EDITION) AT THE JOB SITE AT ALL TIMES.
- C4. ALL CONCRETE SHALL HAVE A MINIMUM 4,000 psi COMPRESSIVE STRENGTH AT 28 DAYS (F_c) (UNLESS NOTED OTHERWISE).
- C5. THE MAXIMUM WATER-CEMENT RATIO FOR ALL CONCRETE ON THIS PROJECT SHALL BE 0.45.
- C6. REINFORCING STEEL SHALL COMPLY WITH THE REQUIREMENTS OF THE AMERICAN SOCIETY OF TESTING AND MATERIALS STANDARD (ASTM) A615, GRADE 60. WELDED WIRE FABRIC (WWF) SHALL CONFORM TO THE REQUIREMENTS OF ASTM A185.
- C7. ALL CONCRETE REINFORCING STEEL SPLICES SHALL BE CLASS "B" TENSION LAP SPLICES (UNLESS NOTED OTHERWISE). SPLICE LENGTHS SHALL BE IN ACCORDANCE WITH CHAPTER 5 OF THE "DESIGN HANDBOOK" (LATEST EDITION) OF THE CONCRETE REINFORCING STEEL INSTITUTE (CRSI).
- C8. PROVIDE "CORNER BARS" TO MATCH ALL LONGITUDINAL REINFORCING AT ALL FOUNDATION INTERSECTIONS AND CORNERS. CORNER BAR SIZE AND SPACING TO MATCH THE SIZE AND SPACING OF LONGITUDINAL BAR BEING LAPPED.
- C9. CONCRETE PROTECTION FOR REINFORCING STEEL:
Concrete Cast Against Earth 3 inches
Concrete Cast Against Forms:
Slabs 2 inches
Walls, Beams, Joists and Columns 2 inches
- C10. WHERE NEW REINFORCING STEEL IS REQUIRED OUT OF EXISTING, HARDENED CONCRETE, DEFORMED BARS OF THE SIZE INDICATED ON THE DRAWINGS SHALL BE SET INTO THE CONCRETE USING AN EPOXY ADHESIVE SYSTEM SUCH AS HILTI "HIT HY 150". THE DEPTH OF EMBEDMENT SHALL BE AS SPECIFIED BY THE ADHESIVE MANUFACTURER TO DEVELOP THE YIELD STRENGTH OF THE BAR. INSTALLATION SHALL BE IN ACCORDANCE WITH THE ADHESIVE MANUFACTURER'S SPECIFICATIONS.
- C11. WHERE "KWK BOLTS" ARE REQUIRED TO BE INSTALLED BY THE CONTRACTOR, THEY SHALL BE THE PRODUCTS OF HILTI, CORP., P.O. BOX 21148, TULSA, OK 74121, OR "TWIN RAISED/REINFORCED" WOOD DOWELS (LUNGS 0019) (4" VED EQUAL). THE EXPANSION ANCHORS SHALL BE INSTALLED IN ACCORDANCE WITH THE MANUFACTURER'S SPECIFICATIONS. WHERE NO EMBEDMENT DEPTH IS SPECIFIED ON THE DRAWINGS, THE EMBEDMENT ANCHORS SHALL BE EMBEDDED INTO CONCRETE TO THE DEPTH SPECIFIED IN THE FOLLOWING SCHEDULE:
EXPANSION ANCHOR DIAMETER MINIMUM EMBEDMENT DEPTH
1/2" 2-1/2"
3/4" 4"
1" 4-3/4"
- C12. REINFORCING FOR ALL BUILDING CONCRETE FLOOR SLABS ON GRADE SHALL BE WWF 6x6 @ 4"x4" LOCATED 1" DOWN FROM THE SLAB TOP SURFACE (U.N.O.) WHEN THE FABRIC SHALL BE PROPERLY LOCATED USING CHAIRS, BOLSTERS OR BAR SUPPORTS. "HOOKING" THE FABRIC AND PLACING IT IN POSITION AFTER THE CONCRETE IS IN PLACE IS NOT ACCEPTABLE. AT THE ENDS AND ENDS OF WELDED WIRE FABRIC SHEETS AND/OR ROLLS, THE WWF SHALL BE LAPPED A MINIMUM OF ONE (1) WIRE SPACING PLUS TWO INCHES (2").
- C13. AT THE CONTRACTOR'S OPTION, THE WELDED WIRE FABRIC (WWF) REINFORCEMENT FOR BUILDING FLOOR SLABS ON GRADE MAY BE REPLACED USING SYNTHETIC FIBER REINFORCING. THE SYNTHETIC FIBERS SHALL CONSIST OF 100% VIRGIN POLYPROPYLENE FIBRILATED FIBERS MIXED IN THE CONCRETE AT THE RATE RECOMMENDED BY THE FIBER MANUFACTURER, BUT NOT LESS THAN 1.75 POUNDS OF FIBERS PER CUBIC YARD OF CONCRETE. SUBJECT TO APPROVAL, "FIBERMESH" (AVAILABLE FROM MASTER BUILDERS) IS AN ACCEPTABLE FIBEROUS SYNTHETIC FIBER REINFORCEMENT FOR BUILDING CONCRETE FLOOR SLABS.
- C14. FOR ALL BUILDING CONCRETE FLOORS, "C.J." DENOTES A SLAB CONSTRUCTION JOINT OR CONTROL JOINT AT CONTRACTOR'S OPTION. C.J.'S SHALL BE CONSTRUCTED PER THE DETAILS. THE SLAB CONTROL JOINT LAYOUT SHOWN ON THE PLAN IS FOR CONCEPTUAL PURPOSES ONLY. THE CONTRACTOR SHALL LAYOUT CONTROL JOINTS AT A MAXIMUM SPACING OF 15'-0". UNLESS NOTED OTHERWISE, CONSTRUCTION JOINTS SHALL BE LOCATED BY THE CONTRACTOR TO FACILITATE CONCRETE PLACEMENT. WHERE THE CONTRACTOR ELECTS TO SAW-CUT THE CONTROL JOINTS IN CONCRETE SLABS, THE JOINTS MUST BE SAW CUT WITHIN 12 HOURS OF PLACING THE CONCRETE. AT THE CONTRACTOR'S OPTION, CONTROL JOINTS MAY BE MADE USING "ZIP STRIPS".


REINFORCED CONCRETE MASONRY (CMU) -

- M1. ALL MASONRY CONSTRUCTION SHALL MEET THE REQUIREMENTS OF ACI 530 / ASCE 5, LATEST EDITION.
- M2. ALL CONCRETE MASONRY UNITS SHALL HAVE A MINIMUM "PRISM STRENGTH" (f_m) OF 1,500psi BASED ON THE GROSS AREA AND SHALL CONFORM TO ASTM C90, GRADE N. ALL MORTAR FOR CMU CONSTRUCTION SHALL BE TYPE "S" AND CONFORM TO ASTM C270.
- M3. GROUT USED FOR CMU CONSTRUCTION SHALL HAVE A MINIMUM COMPRESSIVE STRENGTH (f_g) OF 2,500psi AND SHALL CONFORM TO ASTM C476.
- M4. A HORIZONTAL CONSTRUCTION JOINT SHALL BE FORMED BETWEEN GROUT POURS FOR CMU CELLS BY STOPPING THE CMU WALL AT A CONSTANT ELEVATION THROUGHOUT AND BY HOLDING THE GROUT A MINIMUM OF 1 1/2" AND A MAXIMUM OF 4 1/2" BELOW THE MORTAR JOINT (EXCEPT AT THE TOP OF THE WALL).
- M5. PROVIDE VERTICAL REINFORCEMENT FOR CMU WALLS CONSISTING OF #5 BARS IN GROUTED SOLID CMU CELLS AT 48" ctrs. UNLESS NOTED OTHERWISE ON THE DRAWINGS.
- M6. PROVIDE ADDITIONAL VERTICAL REINFORCEMENT FOR CMU WALLS CONSISTING OF #5 BARS IN GROUTED SOLID CMU CELLS AT EACH SIDE OF WALL OPENINGS AS WELL AS AT THE ENDS AND CORNERS OF ALL WALLS.
- M7. VERTICAL REINFORCING BARS FOR CMU WALLS SHALL BE FULLY DEVELOPED WITH MATCHING DOWELS OUT OF THE WALL FOOTING.
- M8. PROVIDE HORIZONTAL REINFORCEMENT FOR CMU WALLS CONSISTING OF PREFABRICATED TRUSS TYPE REINFORCEMENT SUCH AS "DUR-O-WALL TRUSS" OR APPROVED EQUAL AT 16" ctrs. UNLESS NOTED OTHERWISE. PROVIDE PREFABRICATED "L's" AND "T's" AT ALL WALL CORNERS AND INTERSECTIONS. LAP HORIZONTAL REINFORCEMENT A MINIMUM OF 6"
- M9. PROVIDE VERTICAL CONSTRUCTION JOINTS AT 30' MAX. SPACING OR AS SHOWN ON PLANS.

WOOD TRUSSES -

- T1. THE DESIGN, DETAILING, FABRICATION AND ERECTION OF ALL METAL-PLATE-CONNECTED WOOD TRUSSES SHALL BE IN ACCORDANCE WITH THE RECOMMENDATIONS AND REQUIREMENTS OUTLINED IN THE PUBLICATIONS OF THE "TRUSS PLATE INSTITUTE", LATEST EDITIONS.
- T2. THE WOOD TRUSS TOP AND BOTTOM CHORDS SHALL BE FABRICATED FROM LUMBER OF A SPECIES, GRADE AND MOISTURE CONTENT SUCH THAT THE FOLLOWING MINIMUM DESIGN VALUES FOR A MEMBER ARE MET:
ALLOWABLE BENDING STRESS, F_b = 1,800 psi
MODULUS OF ELASTICITY, E = 1,600,000 psi
- T3. THE LUMBER USED IN THE FABRICATION OF THE WOOD TRUSSES SHALL BE MACHINE STRESS RATED AND CERTIFIED TO MEET THE DESIGN VALUES LISTED ABOVE.
- T4. THE STRUCTURAL DESIGN OF THE WOOD TRUSSES SHALL BE IN ACCORDANCE WITH THE SPECIFICATIONS OF THE "AMERICAN INSTITUTE OF TIMBER CONSTRUCTION" AS WELL AS THE N.F.P.A.'S "NATIONAL DESIGN SPECIFICATIONS FOR WOOD CONSTRUCTION", LATEST EDITION OF EACH.
- T5. THE TRUSSES SHALL BE DESIGNED FOR THE FOLLOWING SUPERIMPOSED GRAVITY LOADS:
TOP CHORD LIVE LOAD 30 psf
TOP CHORD DEAD LOAD 15 psf
BOTTOM CHORD LIVE LOAD 10 psf
BOTTOM CHORD DEAD LOAD 10 psf
- T6. THE TRUSSES SHALL BE DESIGNED FOR WIND AND/OR SEISMIC LOADS IN ACCORDANCE WITH 2000 INTERNATIONAL BUILDING CODE WITH THE 2003 INDIANA BUILDING CODE AMENDMENTS.
- T7. THE TRUSS FABRICATOR SHALL SUBMIT SHOP DRAWINGS AND CALCULATIONS FOR THE WOOD TRUSSES WHICH ARE CERTIFIED, SIGNED AND STAMPED BY A PROFESSIONAL ENGINEER, REGISTERED IN THE STATE OF INDIANA AND EXPERIENCED IN STRUCTURAL ENGINEERING.
- T8. THE FABRICATOR IS RESPONSIBLE FOR DELIVERY OF THE WOOD TRUSSES TO THE JOB SITE. THE GENERAL CONTRACTOR SHALL RECEIVE, UNLOAD AND PROPERLY STORE THE WOOD TRUSSES UPON DELIVERY.

REVISED "AS-BUILT" DRAWING
THIS DRAWING HAS BEEN REVISED IN ACCORDANCE WITH NOTES ON "RECORD DRAWINGS" FURNISHED BY THE CONTRACTOR AND WITH EXECUTED CHANGE ORDERS, TO THE BEST OF OUR KNOWLEDGE AND BELIEF, THIS DRAWING SHOWS ACTUAL "AS-BUILT" CONDITIONS.
COMMONWEALTH ENGINEERS, INC.
REVISED: DATE 10/06
BY JCW, CK BY CWW

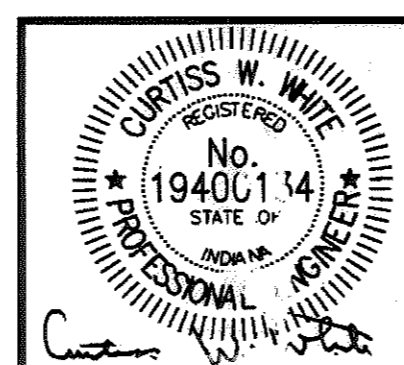


COMMONWEALTH ENGINEERS, INC.

DRAWN BY: CB
DESIGNED BY: DAH
CHECKED BY: DAH
DATE: 1/04
JOB NO: S02119-02
SCALE: AS NOTED

SALAMONIE RESERVOIR
WASTEWATER TREATMENT PLANT IMPROVEMENTS PROJECT
PUBLIC WORK PROJECT NO. E031410M
STRUCTURAL NOTES


27-Structural Notes.dwg 12
DRAWING NO.
A1
27 OF 52

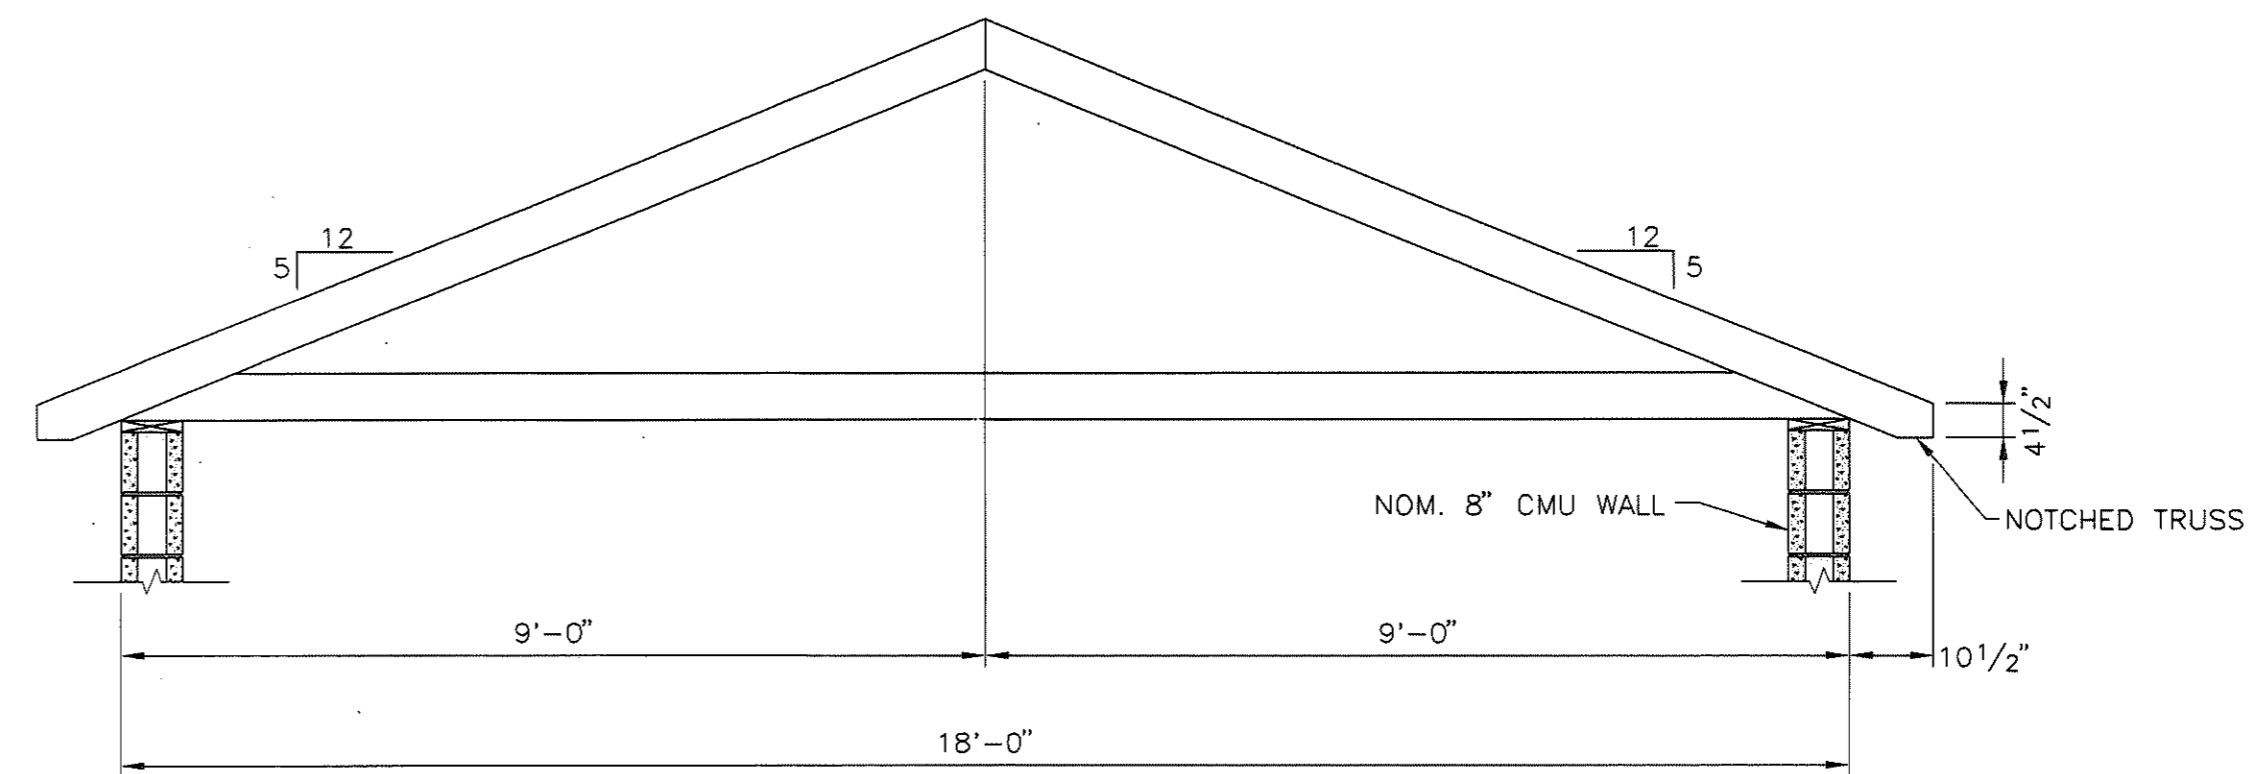


NOTE:
 1. SEE GENERAL WOOD NOTES FOR TRUSS LOADING.
 2. ACTUAL TRUSS WEB CONFIGURATION BY TRUSS MANUFACTURER.

TRUSS DETAIL
 SCALE: 1/2"=1'-0"


NOTE:
 CONTRACTOR SHALL PROVIDE SUPPORT
 FRAMING AROUND ROOF PENETRATIONS

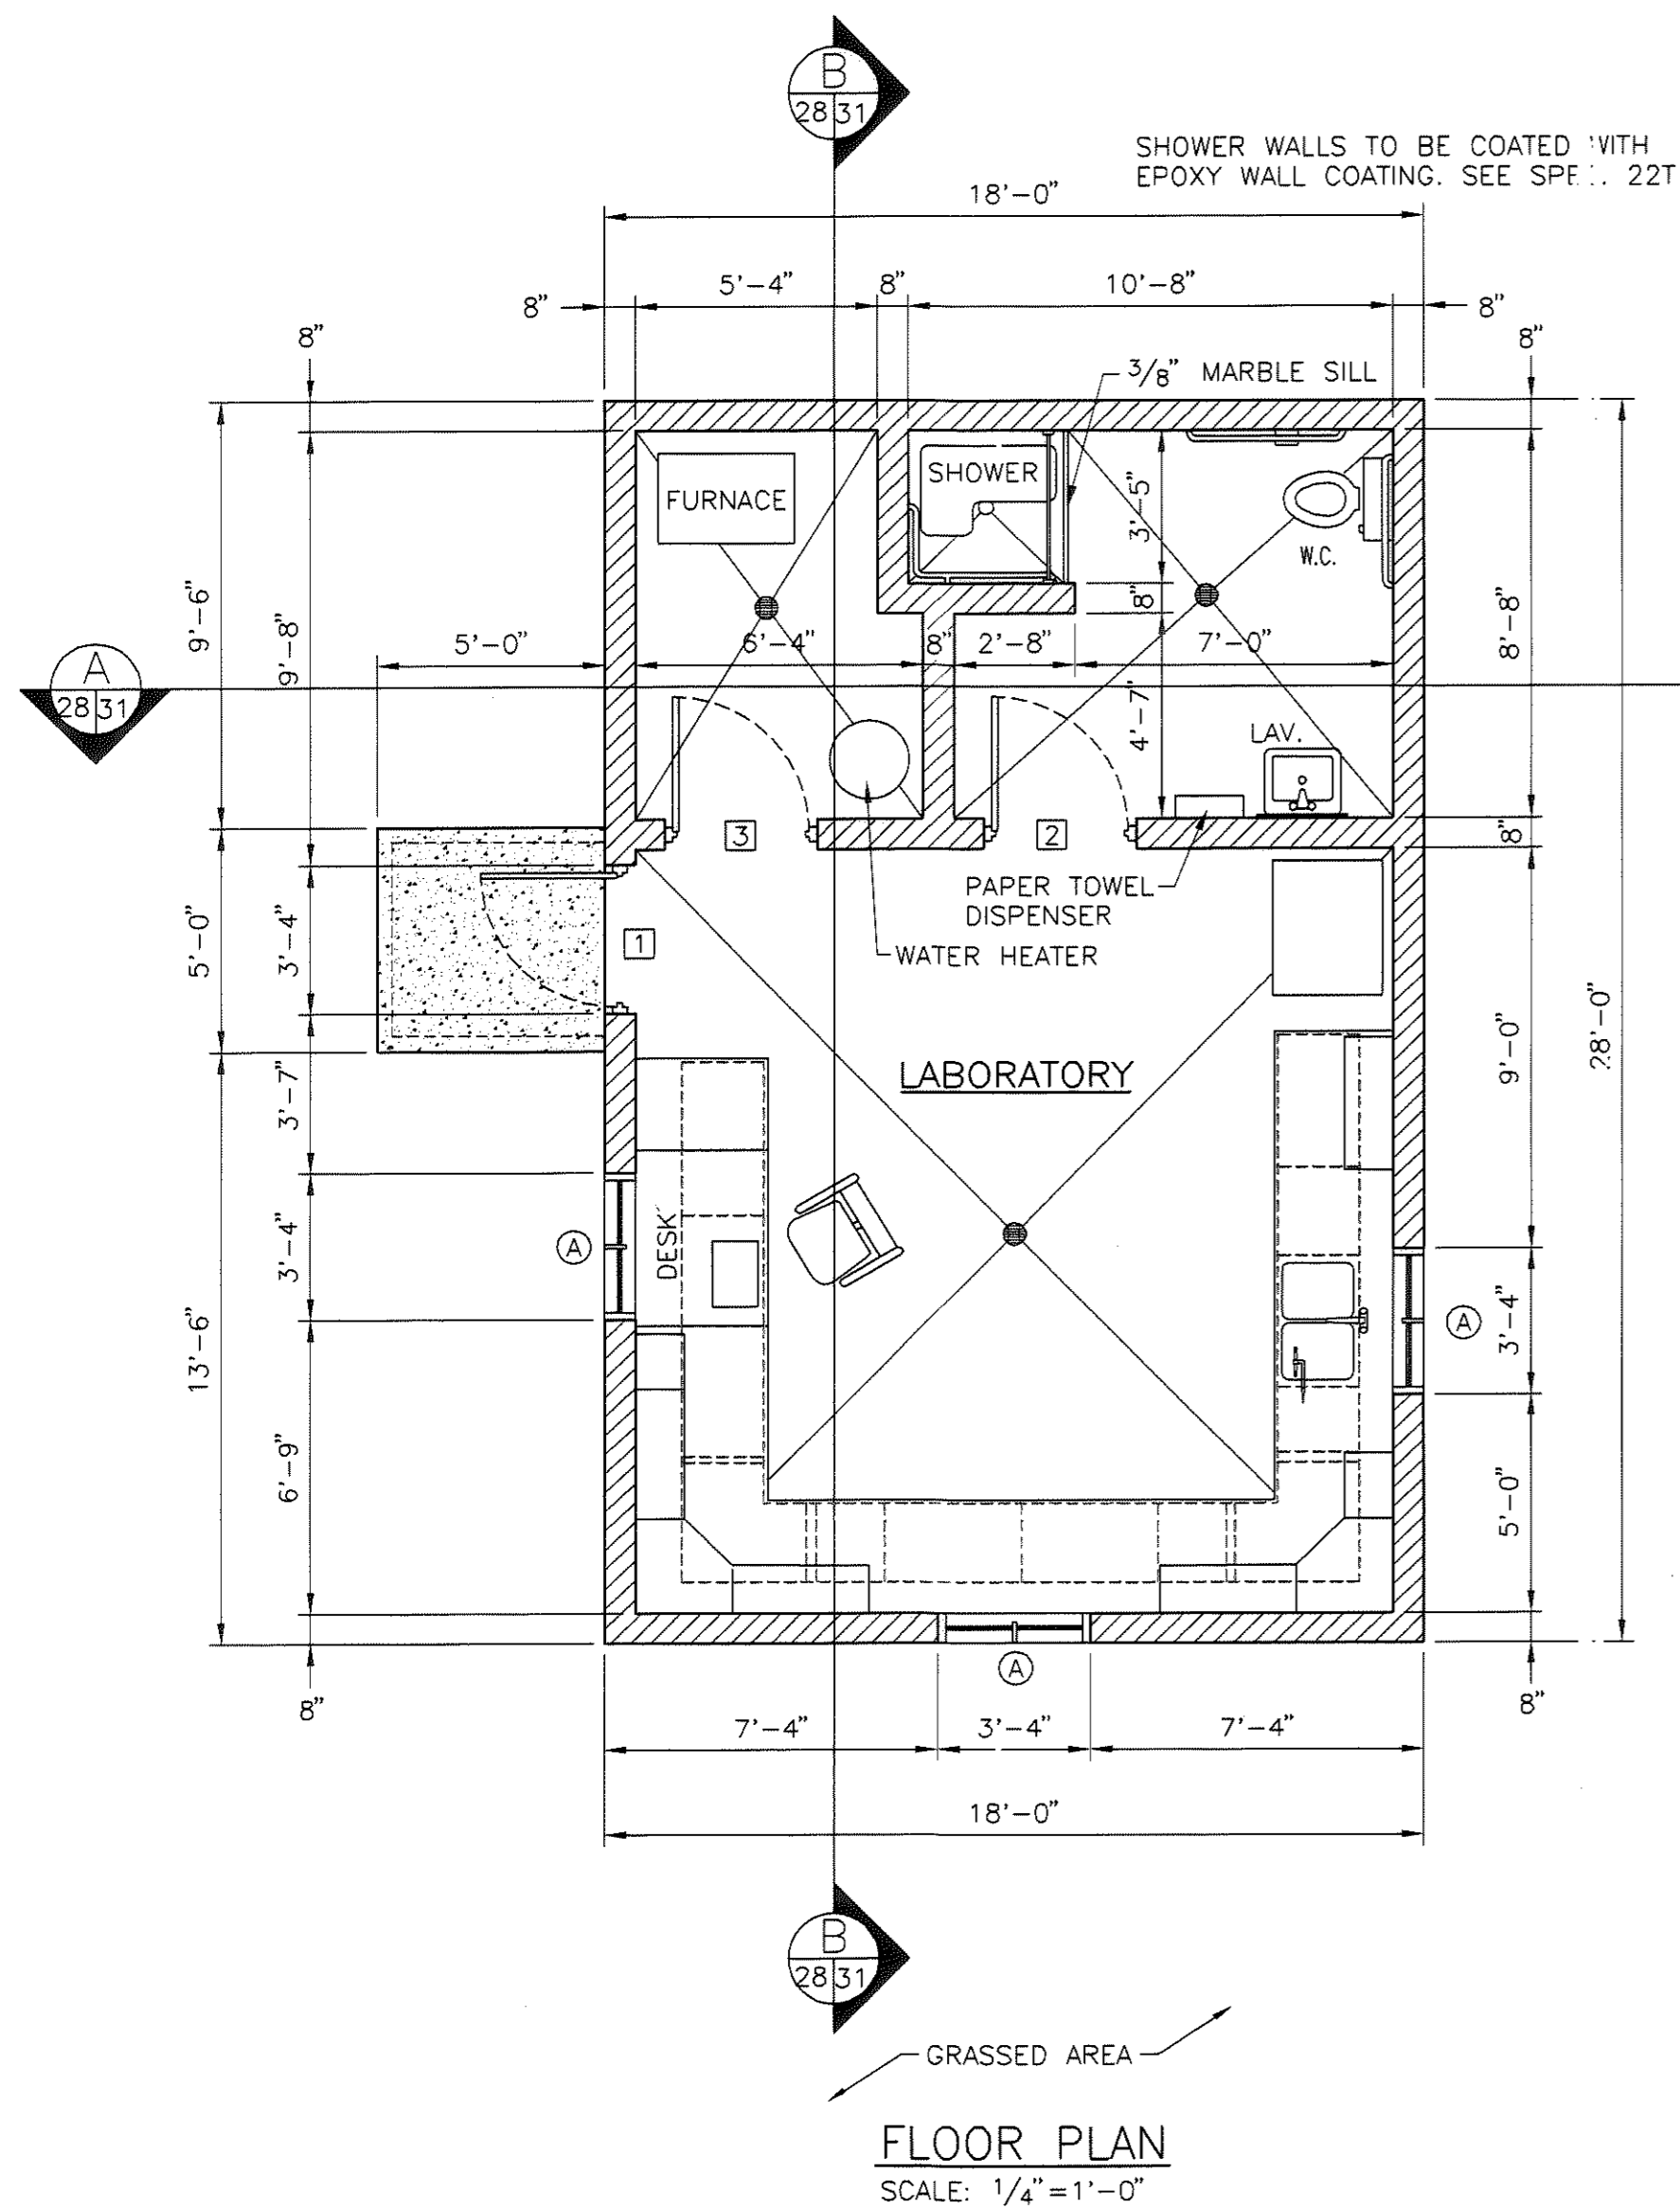

FLOOR PLAN
 SCALE: 1/4"=1'-0"

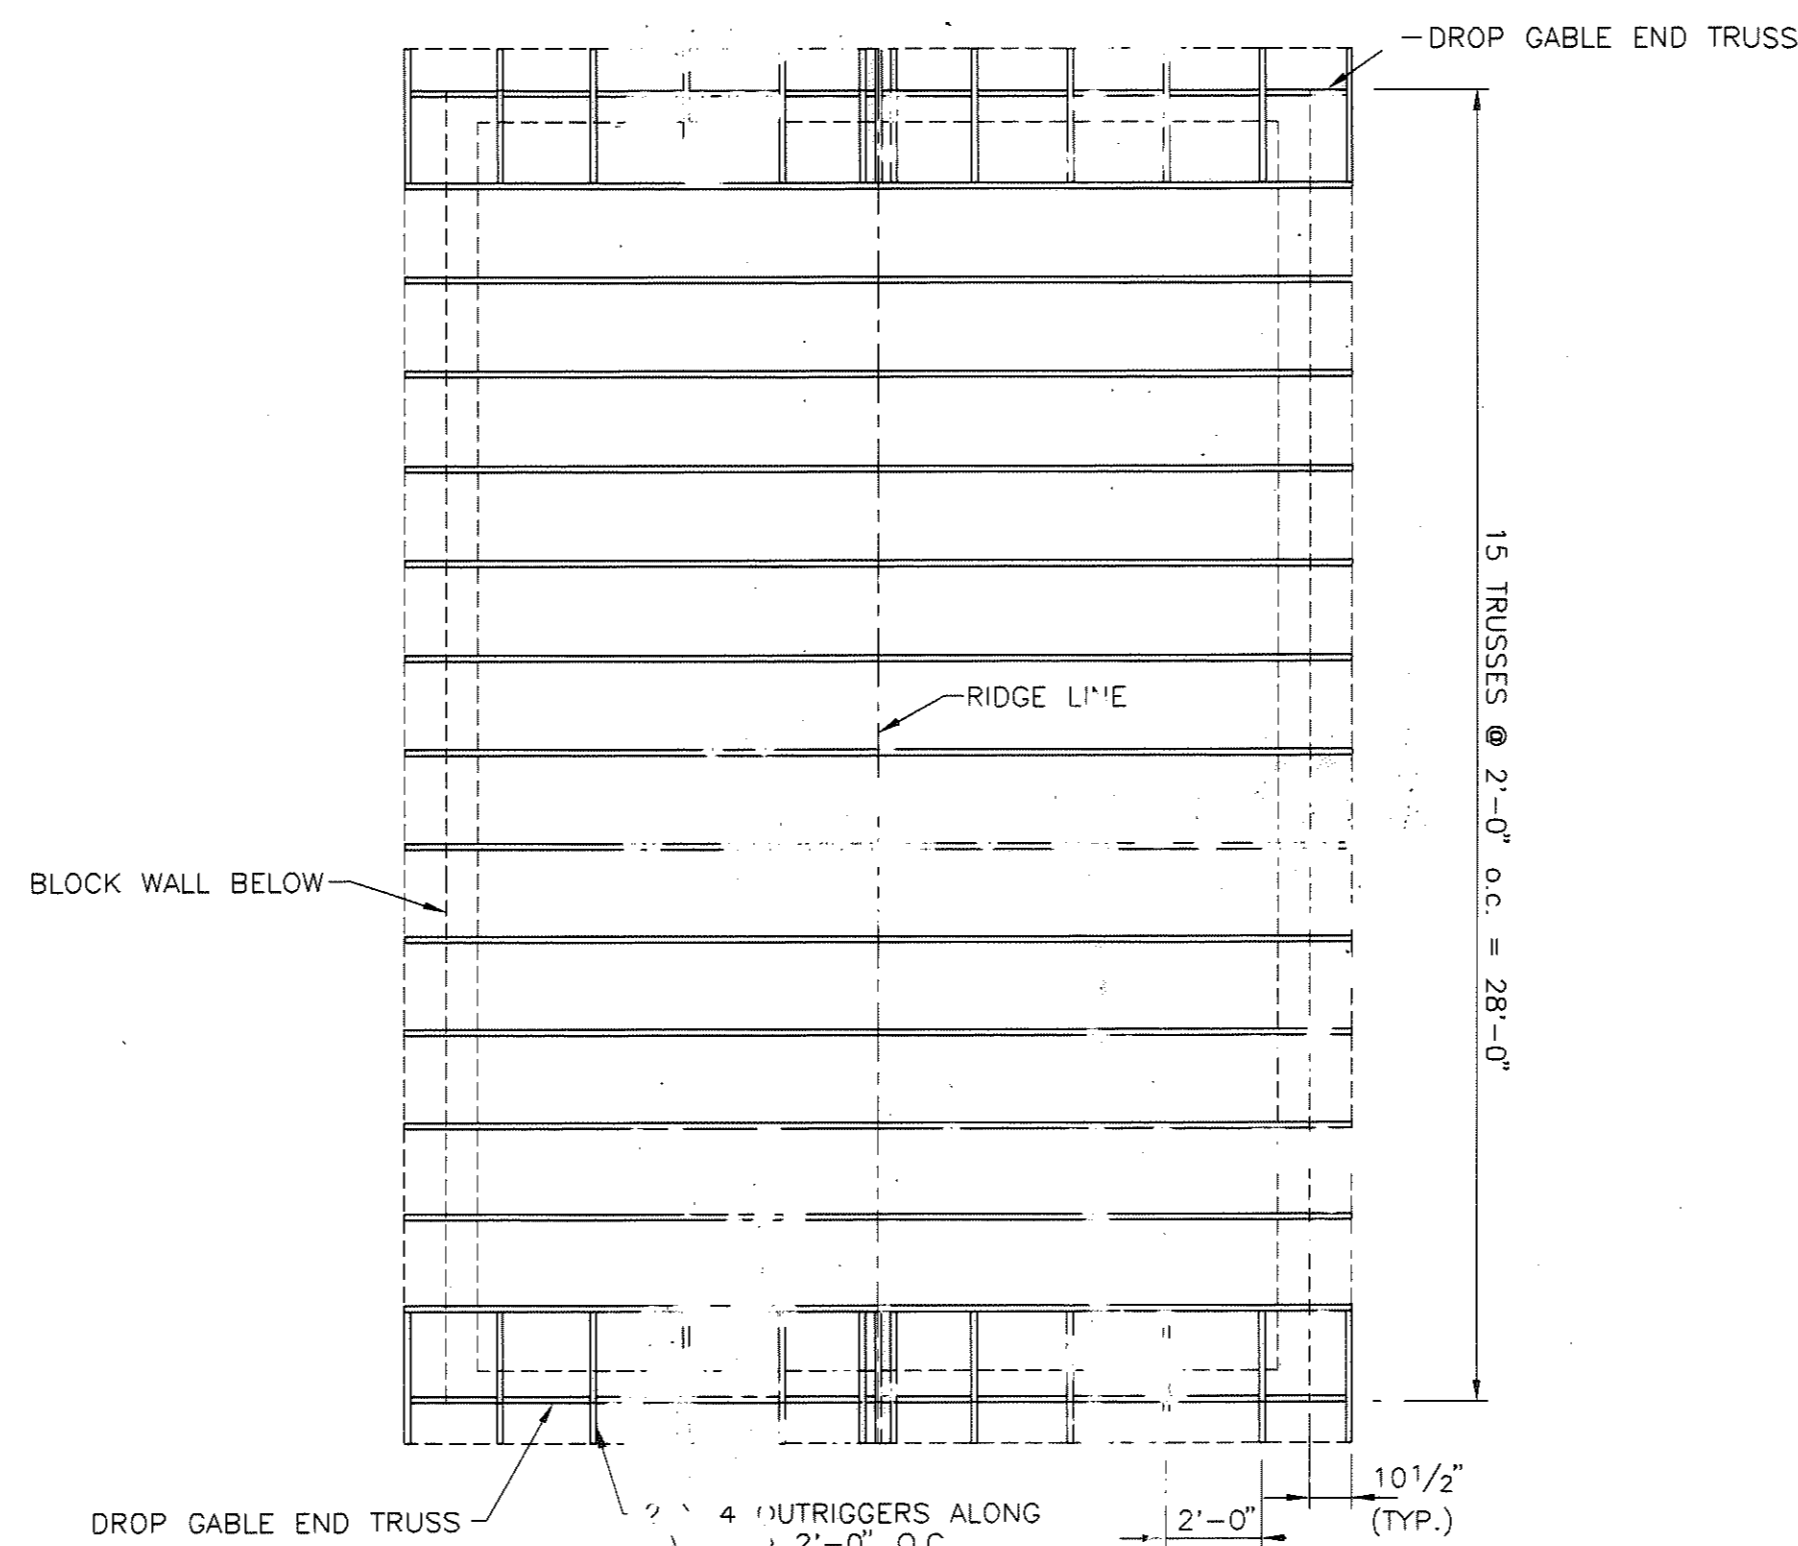


ROOF FRAMING PLAN
 SCALE: 1/4"=1'-0"

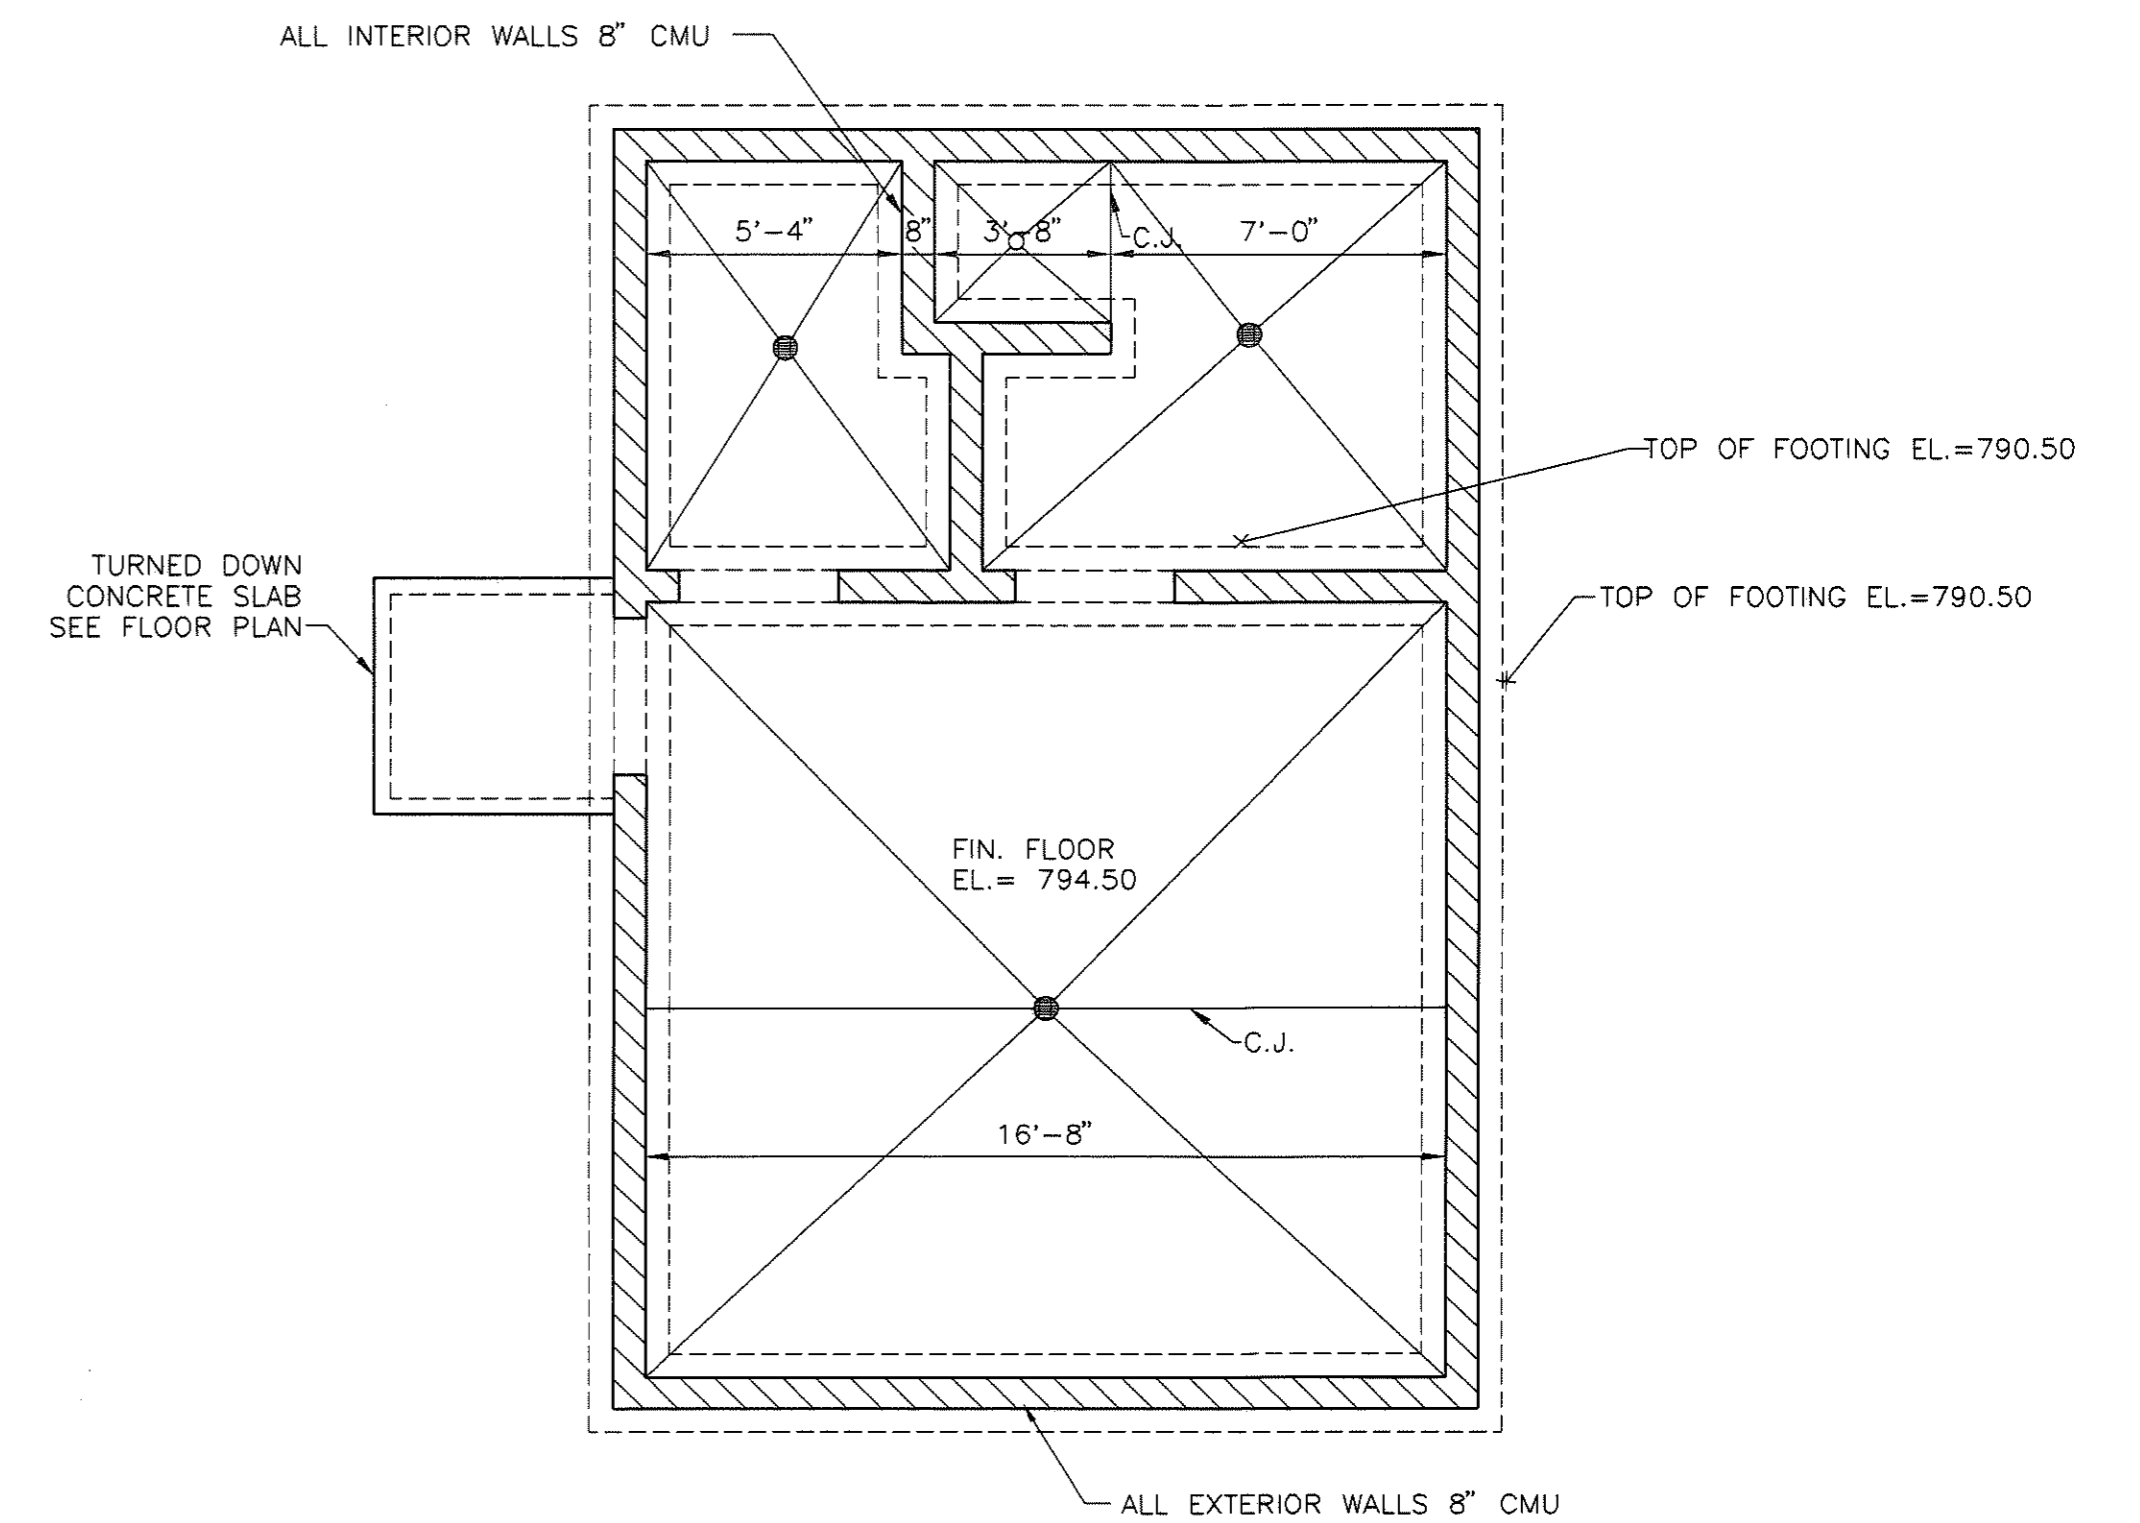

FOUNDATION PLAN
 SCALE: 1/4"=1'-0"

REVISED "AS-BUILT" DRAWING
 THIS DRAWING HAS BEEN REVISED IN ACCORDANCE WITH NOTES ON "RECORD DRAWINGS" FURNISHED BY THE CONTRACTOR AND WITH EXECUTED CHANGE ORDERS TO THE BEST OF OUR KNOWLEDGE AND BELIEF. THIS DRAWING SHOWS ACTUAL "AS-BUILT" CONDITIONS.
 COMMONWEALTH ENGINEERS, INC.
 REVISED DATE: 10/06
 BY: JCW, CK: BY: CWW

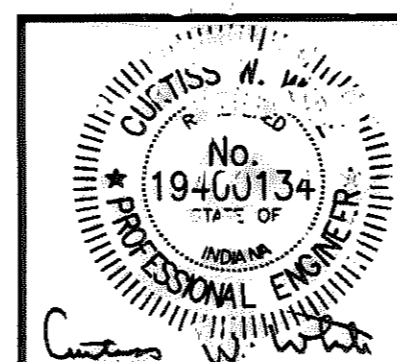


COMMONWEALTH ENGINEERS, INC.

DRAWN BY: CB
 DESIGNED BY: DAH
 CHECKED BY: DAH
 DATE: 1/04
 JOB NO: S02119-02
 SCALE: AS NOTED

SALAMONIE RESERVOIR
 WASTEWATER TREATMENT PLANT IMPROVEMENTS PROJECT
 PUBLIC WORK PROJECT NO. E031410M
 LABORATORY FOUNDATION, FLOOR PLANS,
 ROOF FRAMING PLAN, AND TRUSS DETAILS

DRAWING NO.
A2
 28 OF 52

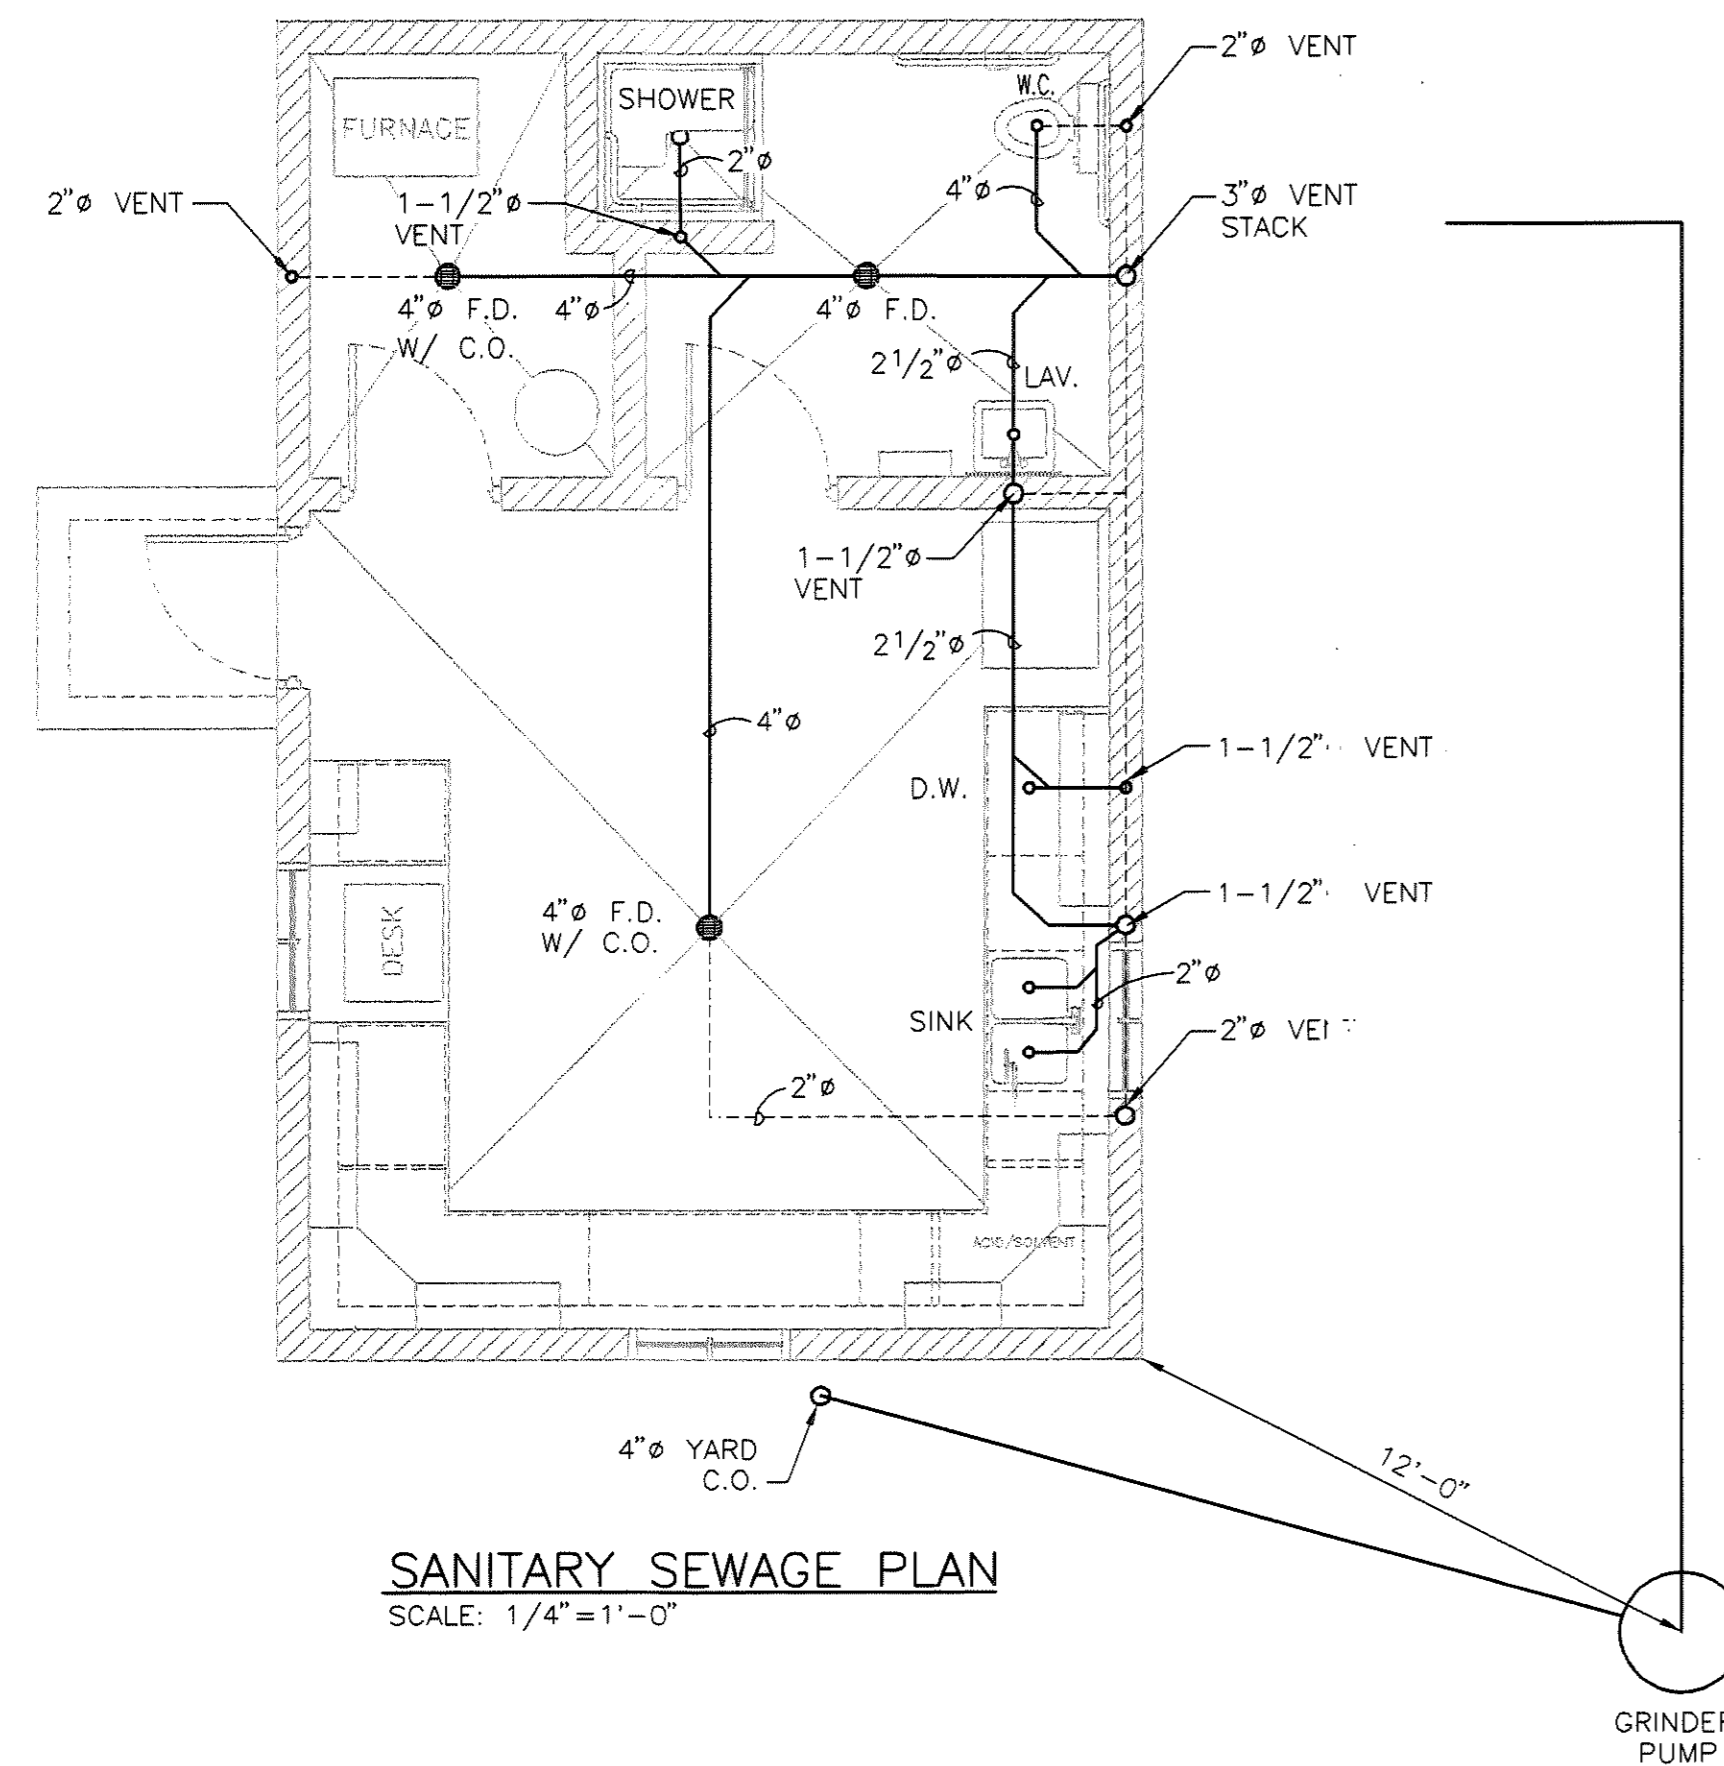


SANITARY SEWAGE PLAN
 SCALE: 1/4" = 1'-0"

SANITARY WASTE & VENT NOTES:

SANITARY WASTE AND VENT PIPING

1. ALL SANITARY WASTE AND VENT PIPING ABOVE AND BELOW GRADE SHALL BE PVC DWV SCH. 40, SOLVENT JOINT PIPING AND FITTINGS.
2. ALL REQUIRED EXCAVATION BY THE PLUMBING CONTRACTOR SHALL BE BACKFILLED WITH GRANULAR BACKFILL AND MECHANICALLY COMPACTED TO 95% COMPACTION. EXCESS MATERIALS SHALL BE REMOVED FROM THE SITE BY THE RESPECTIVE CONTRACTOR.
3. ALL PIPING TO BE INSTALLED ON FIRM EARTH TO SLOPE AT A MINIMUM 1/8" PER FOOT. VERIFY ALL INVERTS PRIOR TO CONSTRUCTION START. PROVIDE STANDPIPE 4" PER THE BOCA PLUMBING CODE.
4. NO SANITARY WASTE PIPING SMALLER THAN 2" SHALL BE INSTALLED UNDER SLAB.

SANITARY WASTE LEGEND

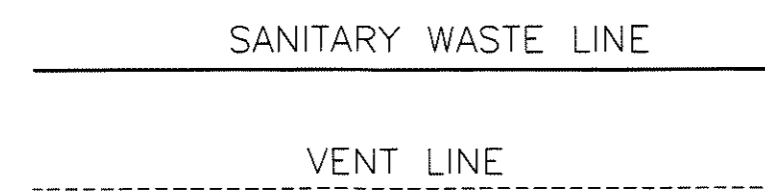


GENERAL NOTES:

1. UNLESS OTHERWISE SPECIFIED ALL MATERIALS AND EQUIPMENT INCORPORATED IN THE WORK SHALL BE NEW. ALL WORKMANSHIP SHALL BE FIRST CLASS AND SHALL BE PERFORMED BY PERSONS QUALIFIED IN THEIR RESPECTIVE TRADES.
2. ALL WORK PERFORMED BY THIS CONTRACTOR SHALL BE IN COMPLIANCE WITH ALL GOVERNING CODES, REGULATIONS AND THE RECOMMENDED INSTALLATION DETAILS OF THE PRODUCT MANUFACTURERS, UNLESS NOTED OTHERWISE.
3. THE PLUMBING CONTRACTOR SHALL LOCATE AND VERIFY SIZES OF EXISTING FACILITIES AND UTILITIES PRIOR TO THE INSTALLATION OF NEW CONSTRUCTION.
4. THE PLUMBING CONTRACTOR SHALL BE RESPONSIBLE FOR OBTAINING THE NECESSARY PERMITS, LICENSES, AND INSPECTIONS GOVERNING HIS PORTION OF THE CONTRACT FROM THE AUTHORITIES HAVING JURISDICTION, AND SHALL PAY THE COST OF SUCH UNLESS SPECIFIED OTHERWISE.


START-UP

1. THE PLUMBING CONTRACTOR SHALL BE RESPONSIBLE FOR THE START UP OF ALL PLUMBING EQUIPMENT. PRIOR TO START UP OF ANY EQUIPMENT THE CONTRACTOR SHALL CHECK AND REVIEW ALL MANUFACTURERS RECOMMENDATIONS FOR PROPER PROCEDURE.

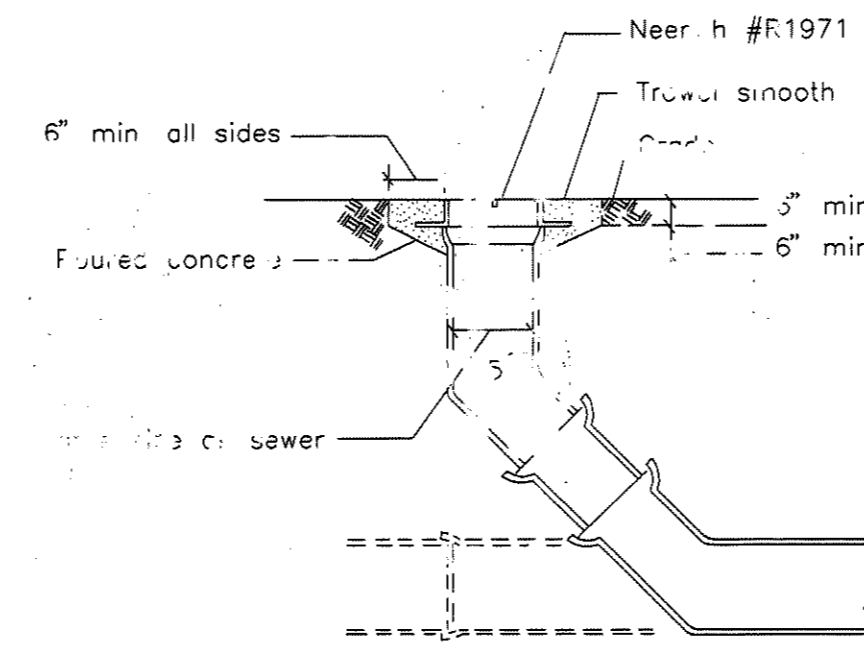

YCO CATCH BASIN DETAIL

NTS

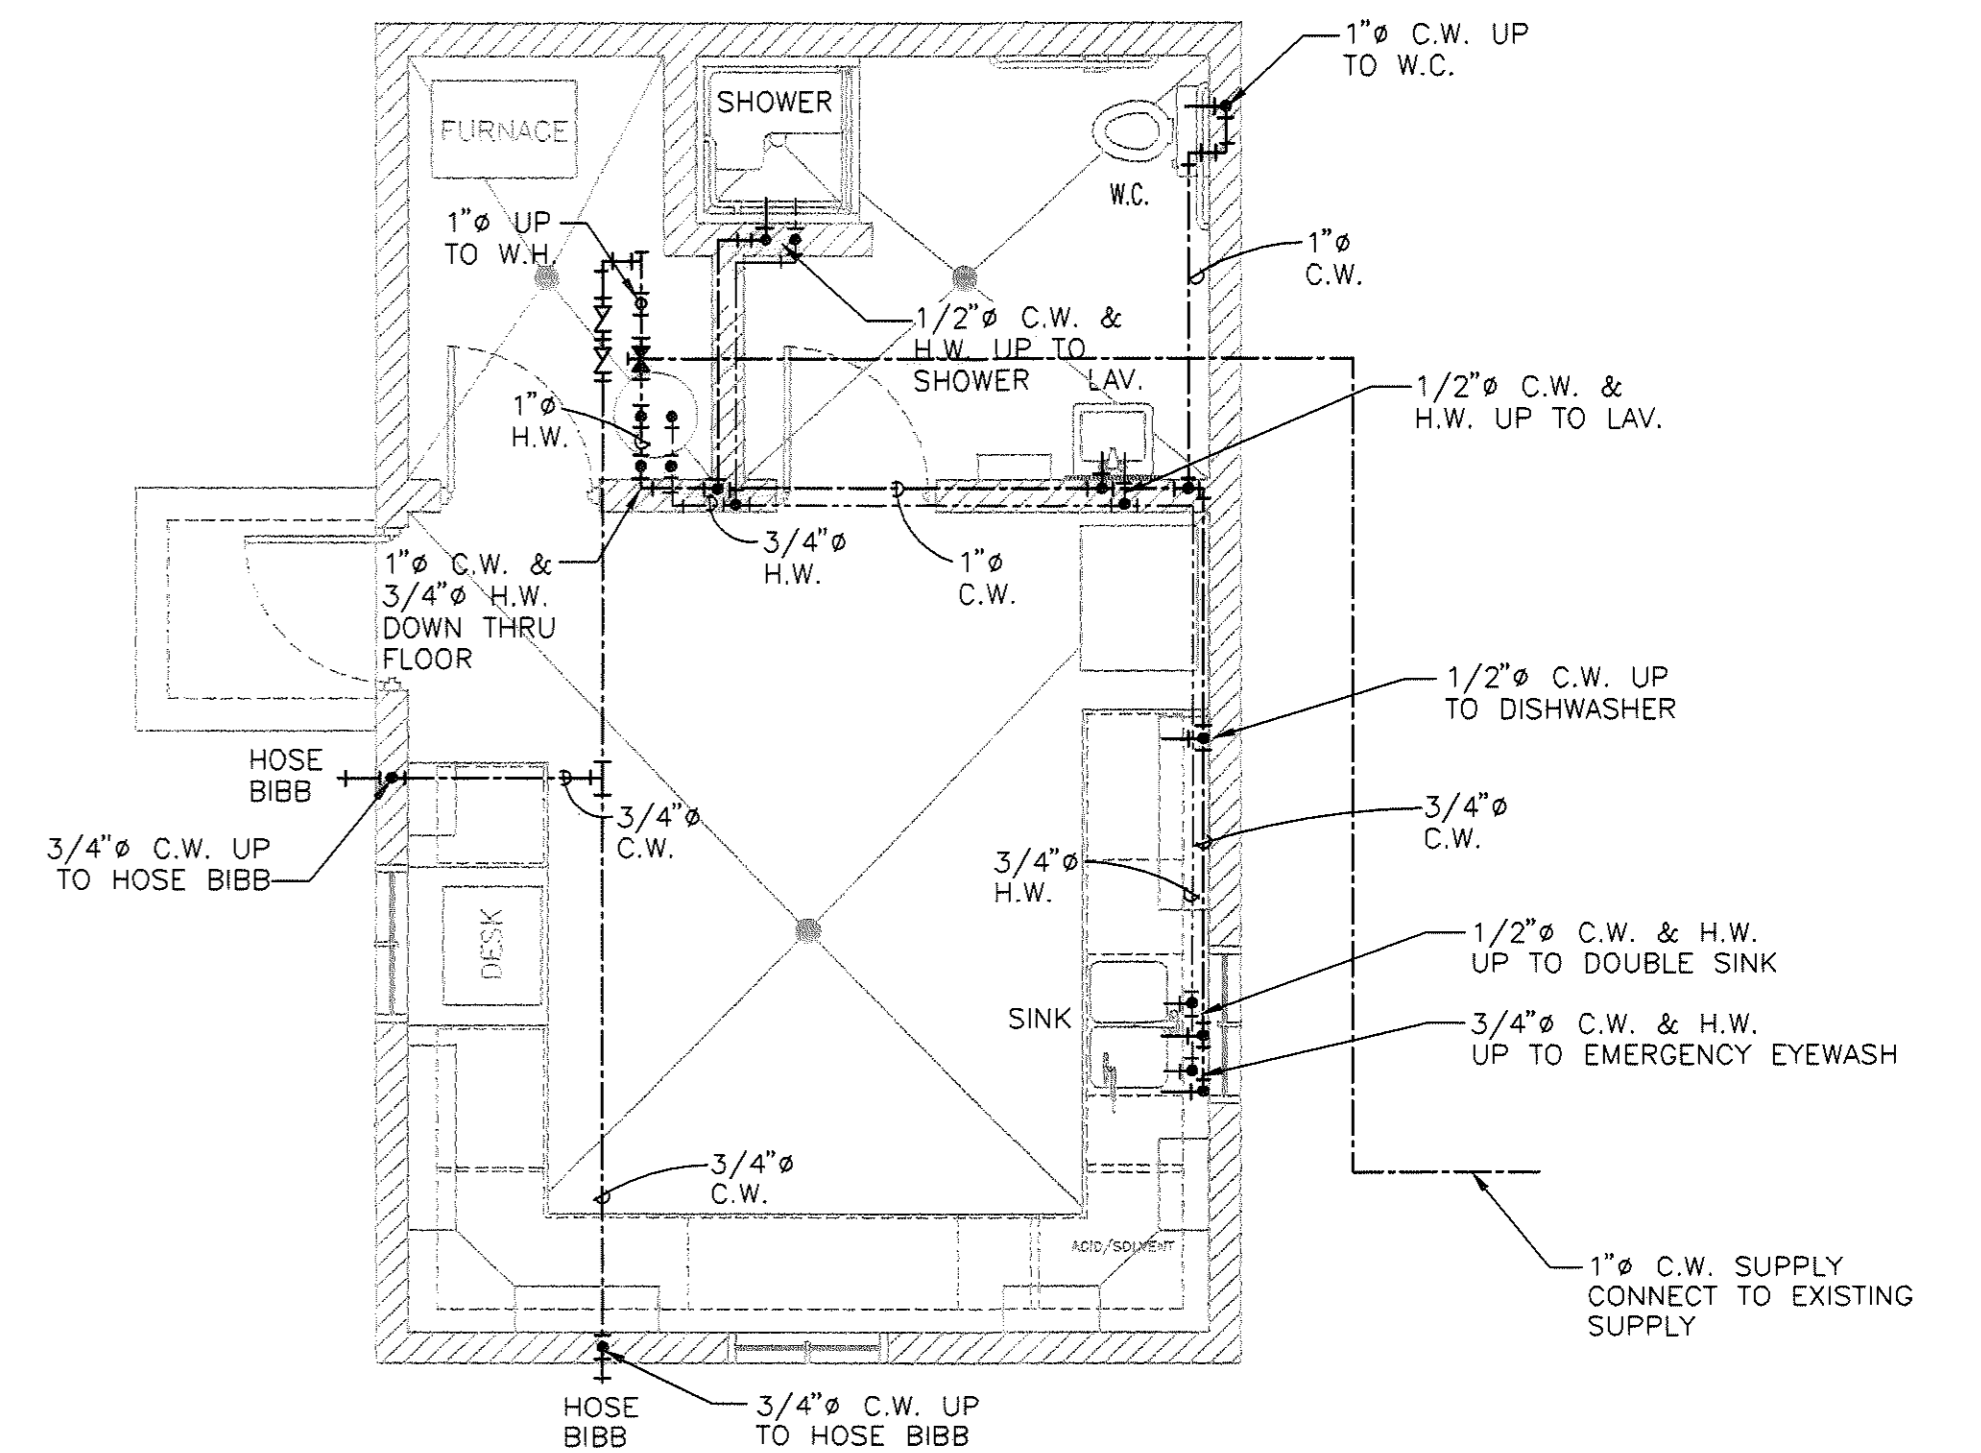

WATER DISTRIBUTION PLAN
 SCALE: 1/4" = 1'-0"

WATER DISTRIBUTION NOTES:


WATER PIPING

1. ALL WATER PIPING SHALL BE INSTALLED & CONNECTED BY THE PLUMBING CONTRACTOR. ALL WATER PIPING SHALL BE TYPE "K" COPPER UNDERGROUND & TYPE "M" ABOVE GROUND. ALL JOINTS SHALL BE MADE WITH WROUGHT COPPER FITTINGS USING LEAD FREE SOLDER.
2. ALL WATER PIPING SHALL BE SUPPORTED @ MAX. 8'-0" INTERVALS AND AT ALL CHANGES IN DIRECTION USING STANDARD CLAMPS AND HANGERS AS REQUIRED, AS PER MANUFACTURERS RECOMMENDATIONS.
3. HORIZONTAL AND VERTICAL RUNS OF PIPING SHALL BE INSTALLED PARALLEL AND PERPENDICULAR TO THE WALLS. VERTICAL PIPING SHALL BE PLUMB AND PERPENDICULAR TO THE FLOORS AND CEILINGS UNLESS NOTED OTHERWISE.


PIPE INSULATION

1. ALL HOT AND COLD WATER PIPING SHALL BE INSULATED WITH 1" THICK ELASTOMERIC INSULATION INSTALLED AS PER MANUFACTURERS RECOMMENDATIONS. ALL INSULATION SHALL BE INSTALLED BY A QUALIFIED PERSONNEL TO PROVIDE A PROFESSIONAL VAPOR TIGHT SEAL ON ALL PIPING.

WATER DISTRIBUTION LEGEND

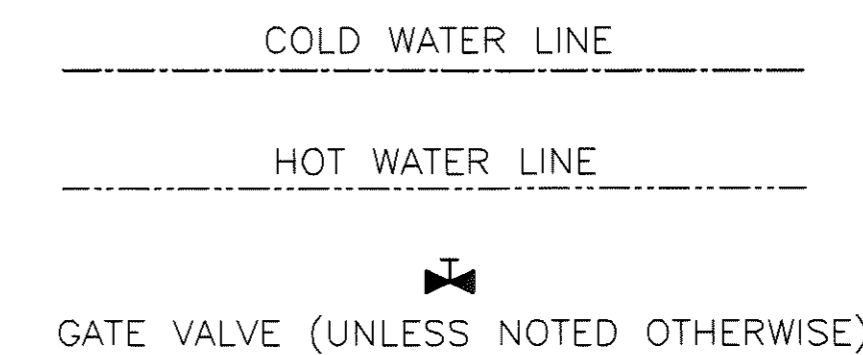

REVISED "AS-BUILT" DRAWING
 THIS DRAWING HAS BEEN REVISED IN ACCORDANCE WITH NOTES ON "RECORD DRAWINGS" FURNISHED BY THE CONTRACTOR AND WITH EXECUTED CHANGE ORDERS. TO THE BEST OF OUR KNOWLEDGE AND BELIEF, THIS DRAWING SHOWS ACTUAL "AS-BUILT" CONDITIONS.
 COMMONWEALTH ENGINEERS, INC.
 REVISED DATE: 10/06
 BY: JCW, CK. BY: CWV

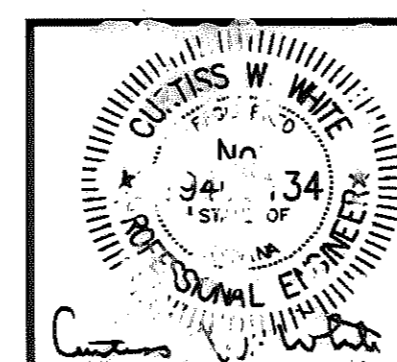

COMMONWEALTH ENGINEERS, INC.


DRAWN BY: DH
 DESIGNED BY: DAH
 CHECKED BY: DAH
 DATE: 1/04
 JOB NO: S02119-02
 SCALE: AS NOTED

SALAMONIE RESERVOIR
 WASTEWATER TREATMENT PLANT IMPROVEMENTS PROJECT
 PUBLIC WORK PROJECT NO. E031410M
 LABORATORY
 SANITARY SEWAGE AND WATER DISTRIBUTION PLANS

DRAWING NO.



A3

29 OF 52

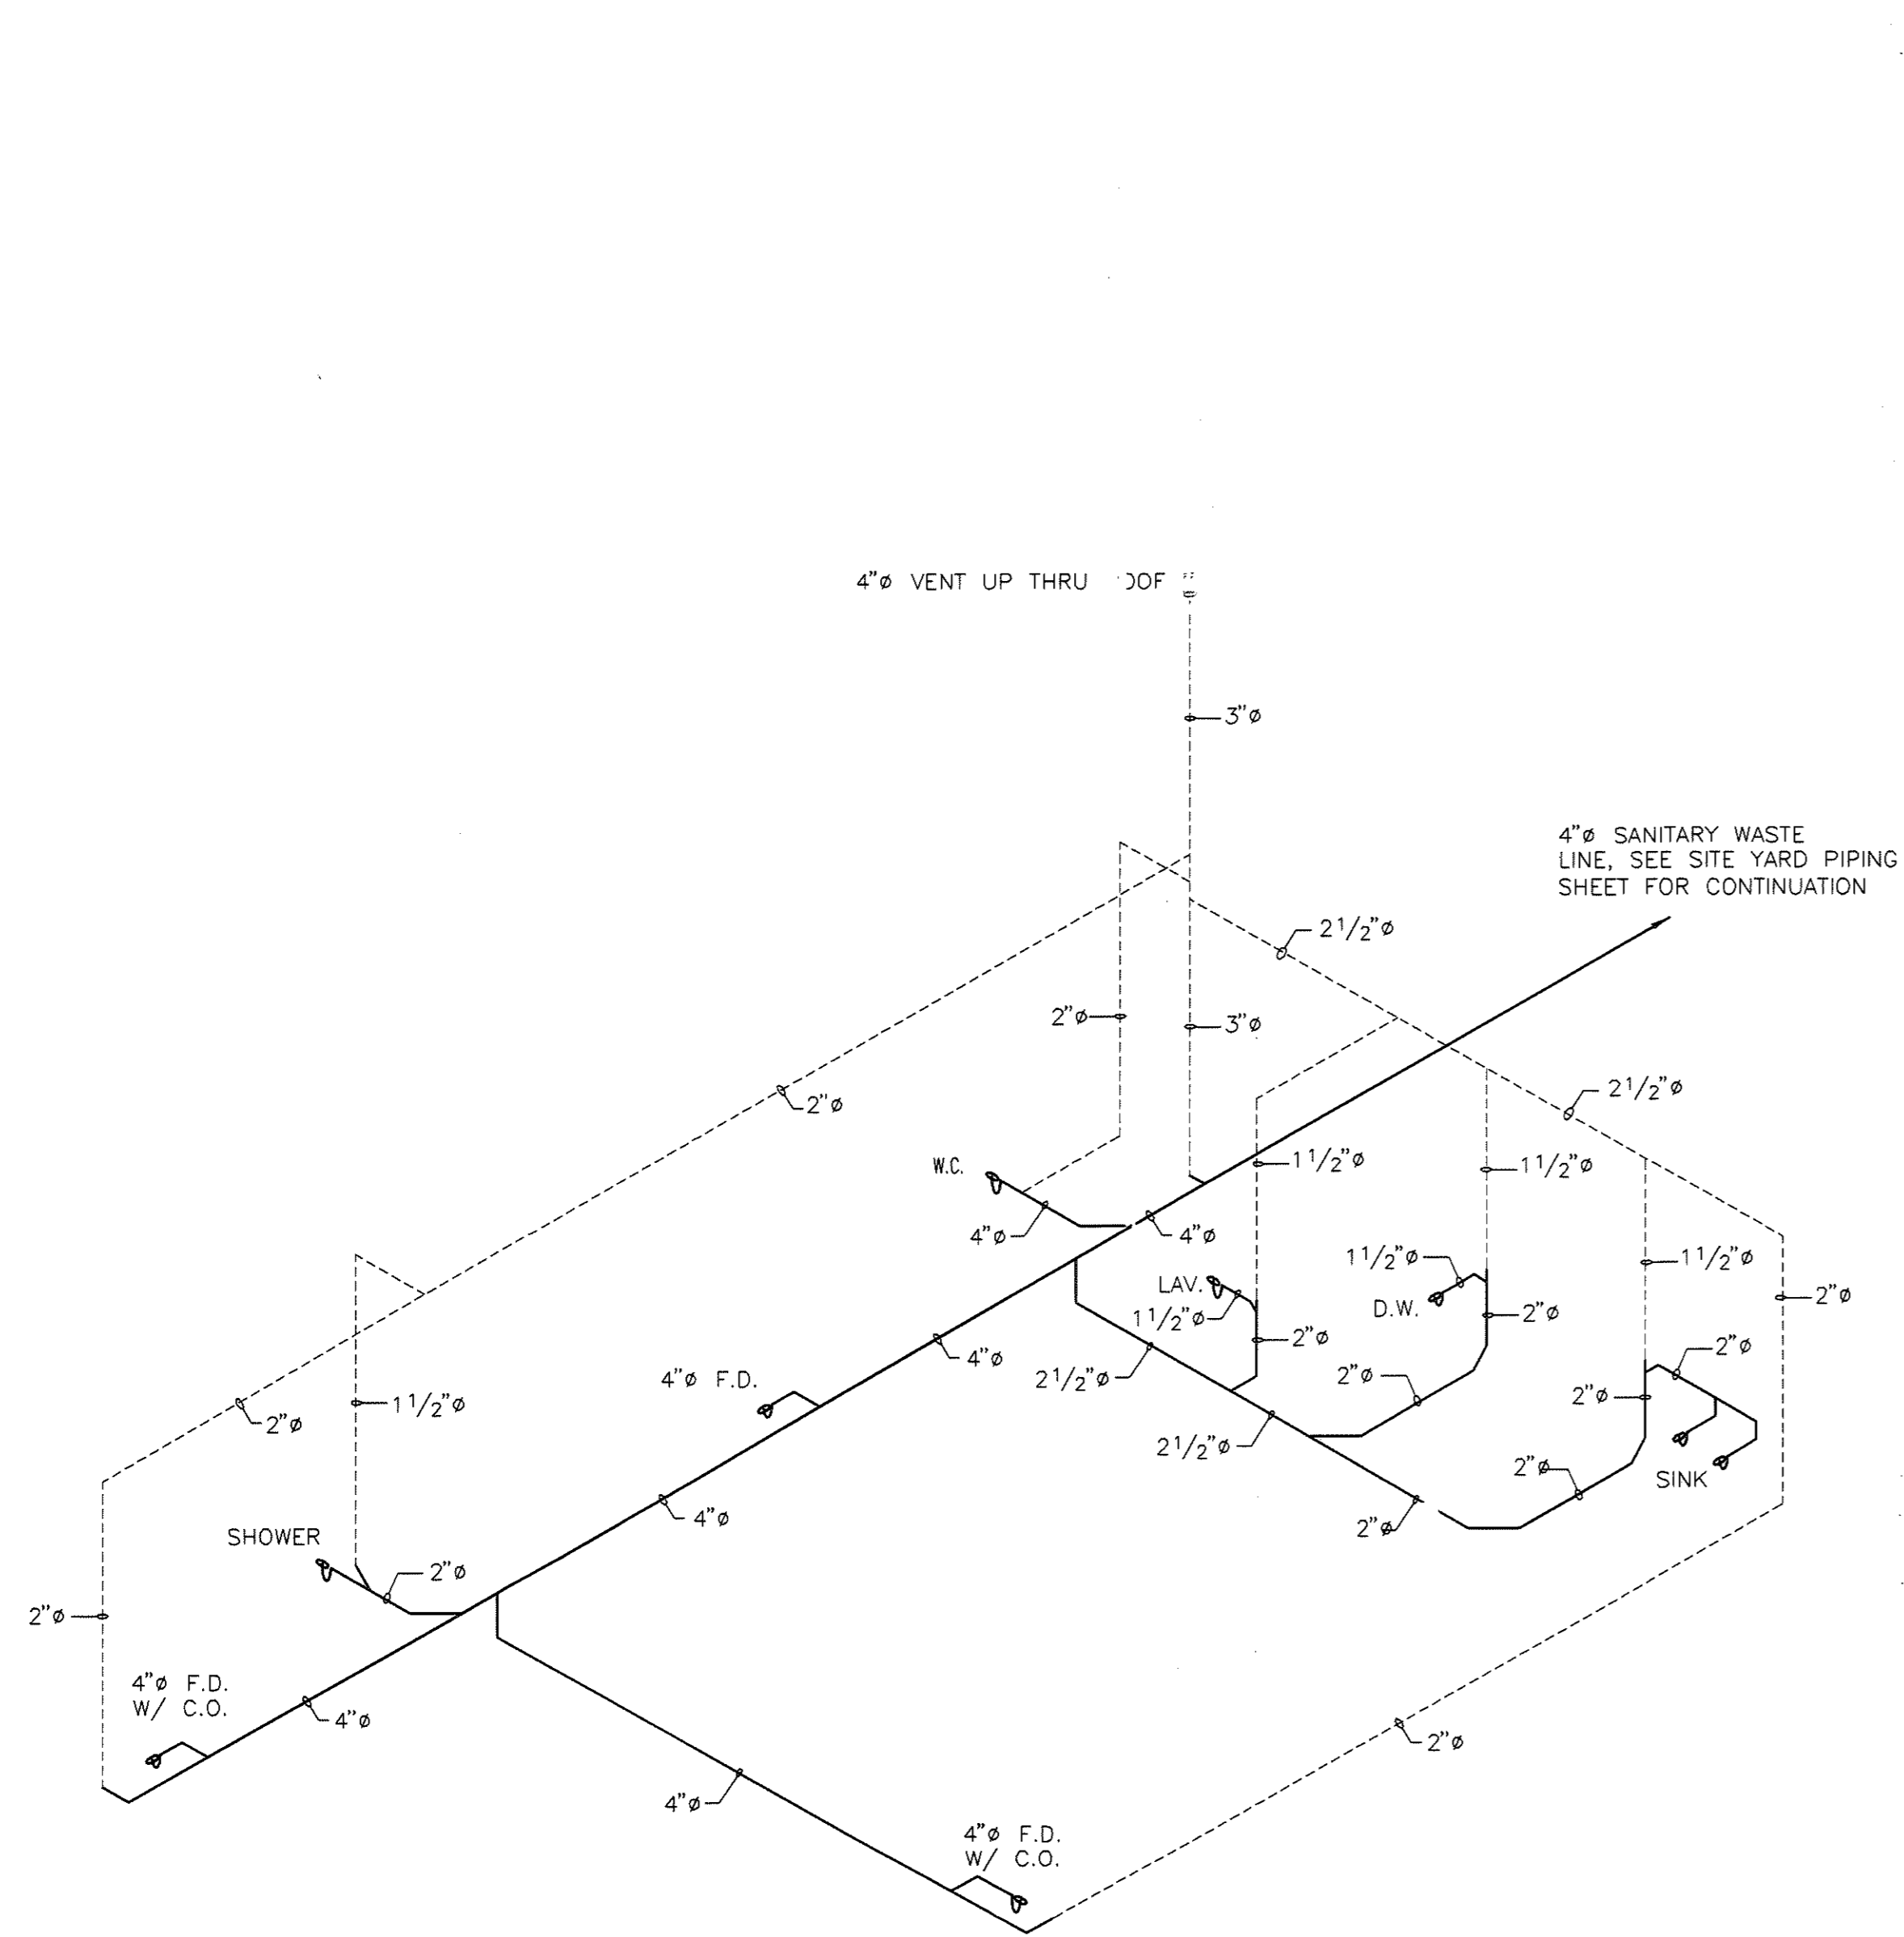


SANITARY SEWAGE SCHEMATIC
 SCALE: N.T.S.

SANITARY WASTE LEGEND

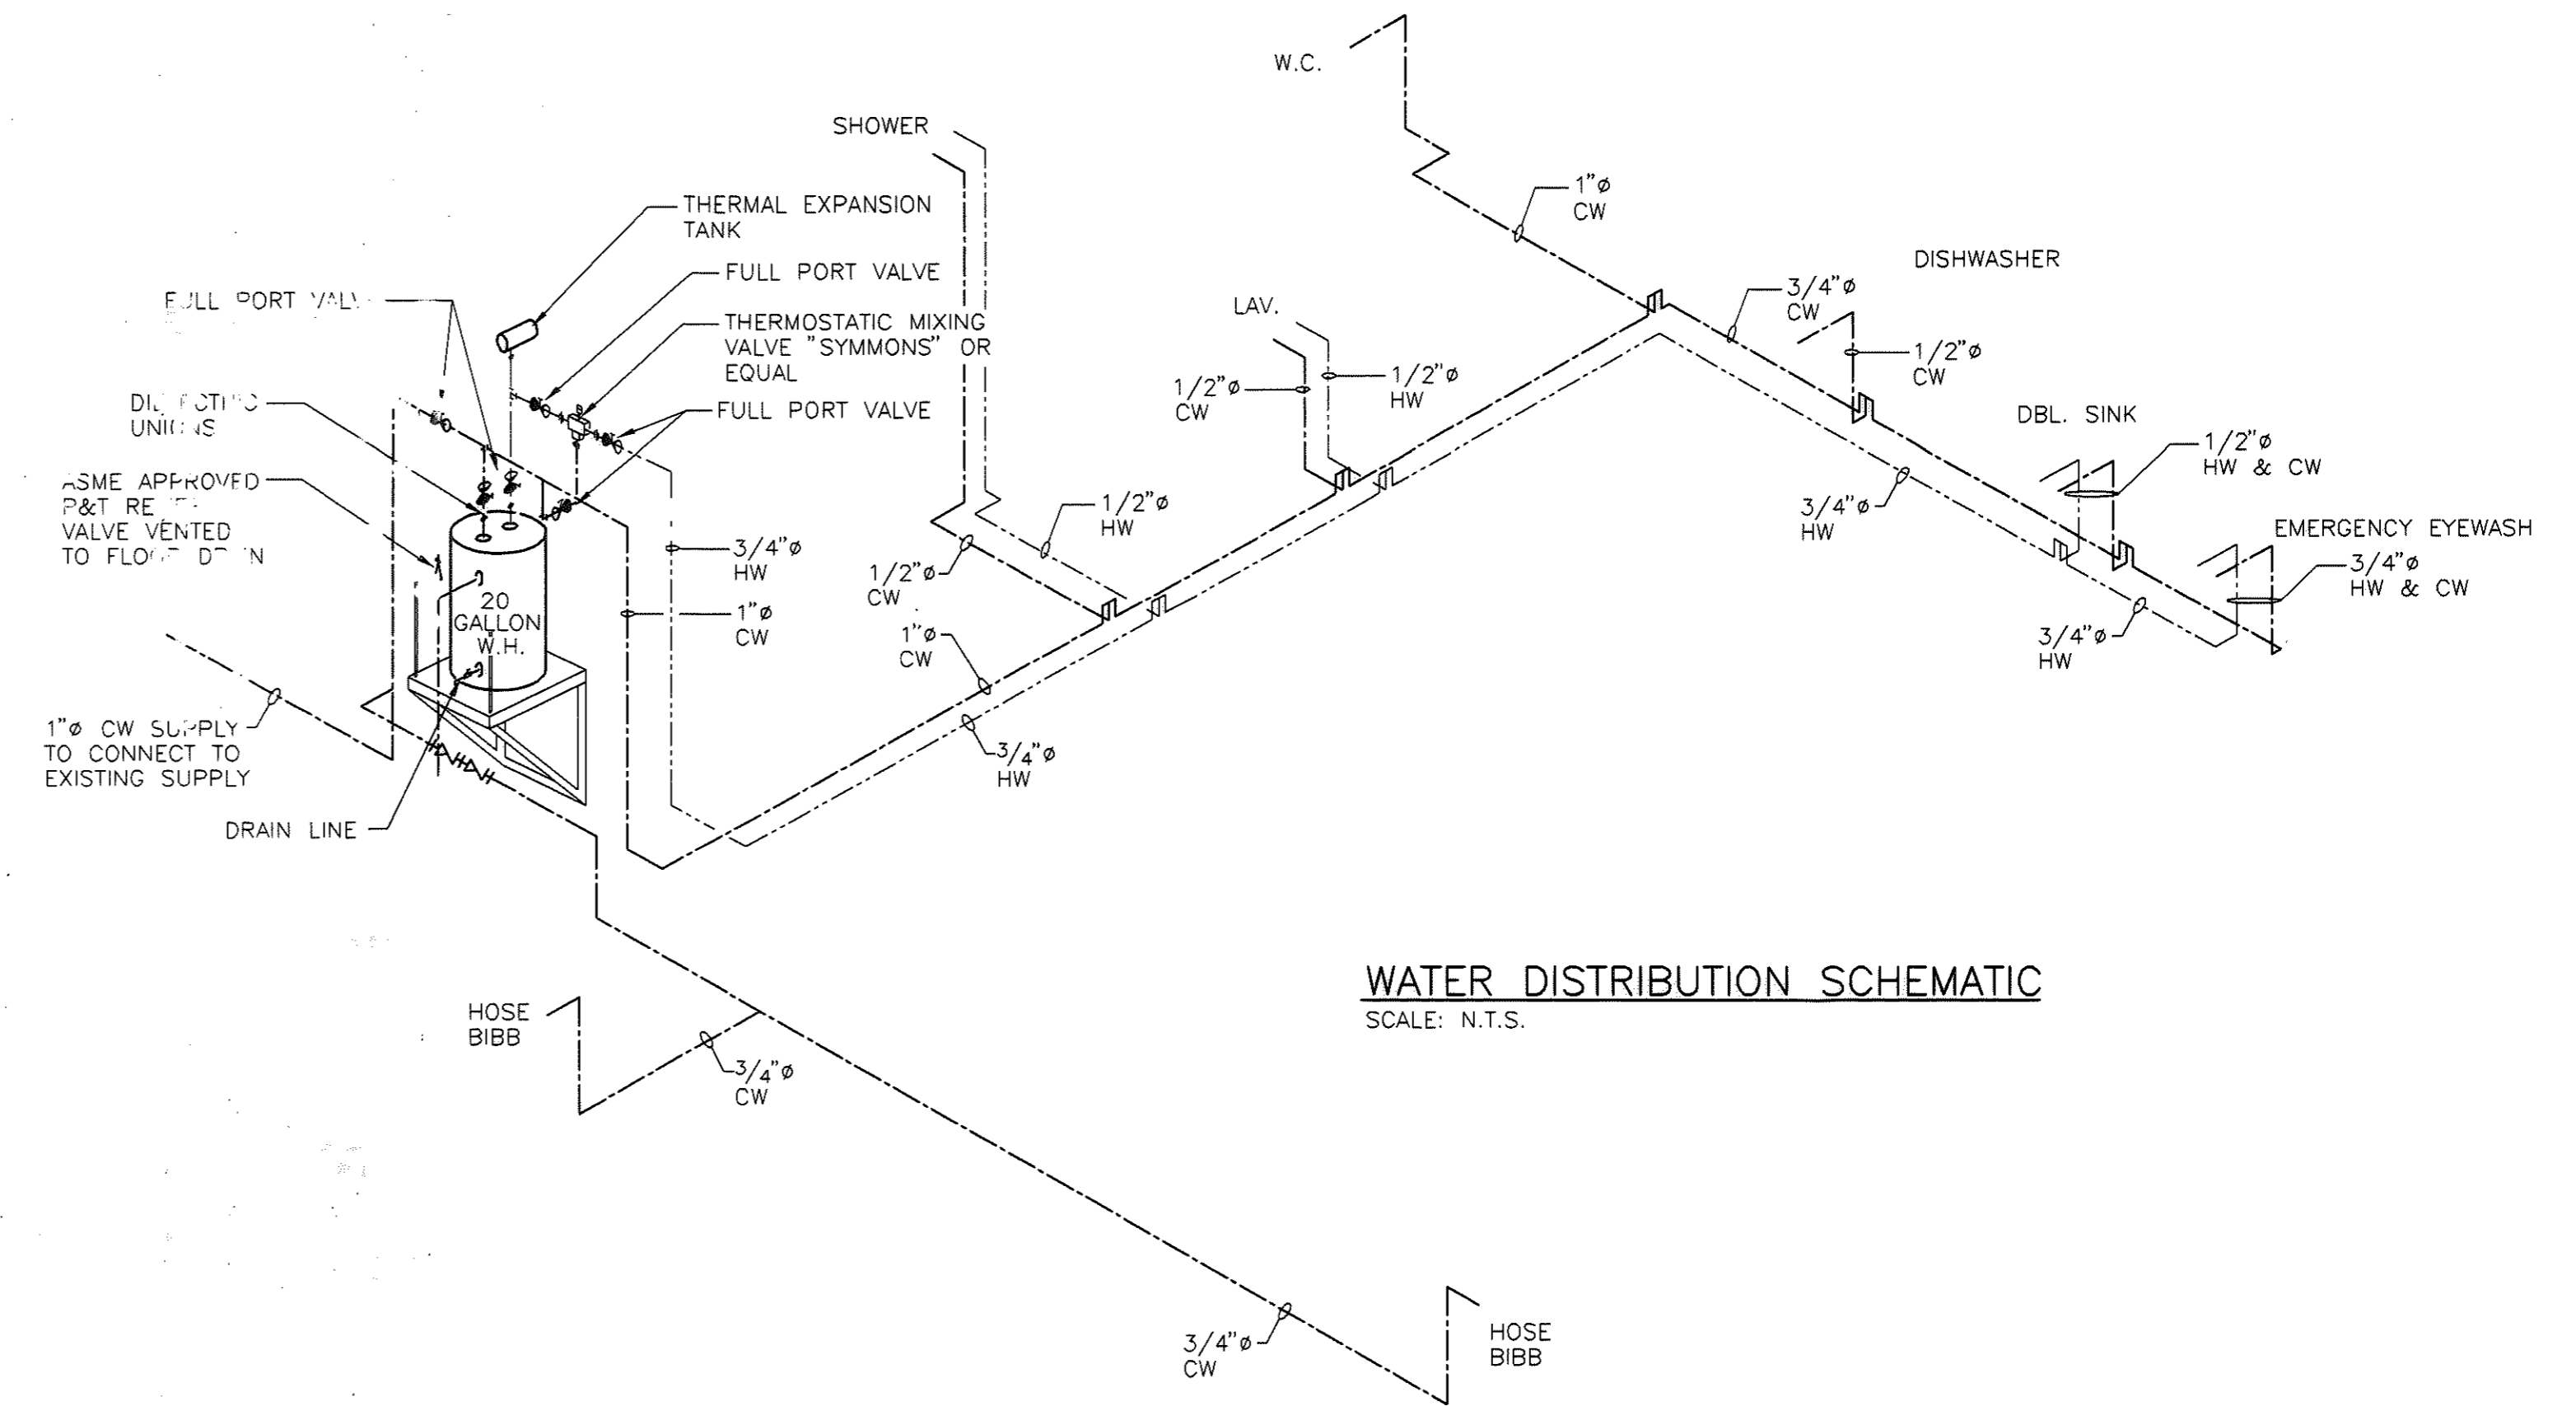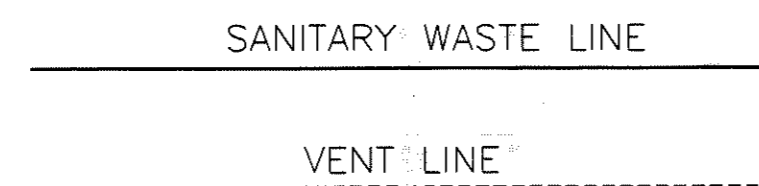


WATER DISTRIBUTION SCHEMATIC
 SCALE: N.T.S.

WATER DISTRIBUTION LEGEND

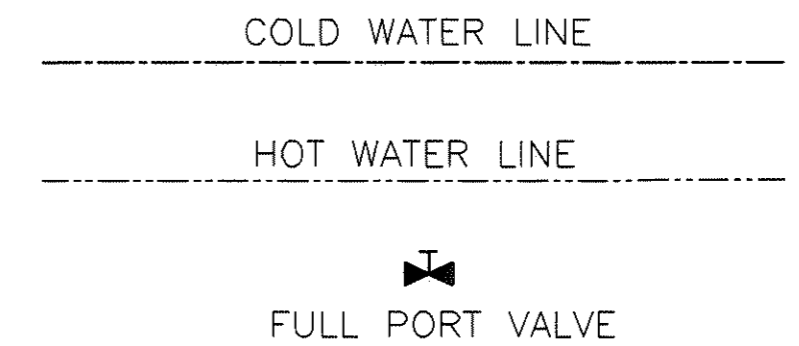

REVISED "AS-BUILT" DRAWING
 THIS DRAWING HAS BEEN REVISED IN ACCORDANCE WITH NOTES ON "RECORD DRAWINGS" FURNISHED BY THE CONTRACTOR AND WITH EXECUTED CHANGE ORDERS, TO THE BEST OF OUR KNOWLEDGE AND BELIEF, THIS DRAWING SHOWS ACTUAL "AS-BUILT" CONDITIONS.
COMMONWEALTH ENGINEERS, INC.
 REVISED: DATE 10/06
 BY JCW, CK, BY CWW

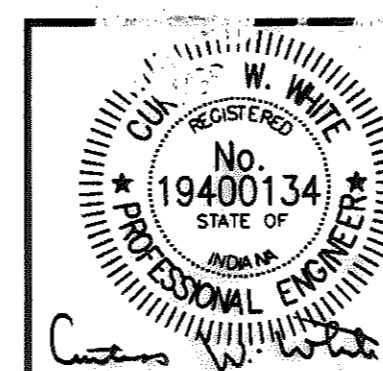


COMMONWEALTH ENGINEERS, INC.


DRAWN BY:	DH
DESIGNED BY:	DAH
CHECKED BY:	DAH
DATE:	1/04
JOB NO:	S02119-02
SCALE:	AS NOTED

SALAMONIE RESERVOIR
 WASTEWATER TREATMENT PLANT IMPROVEMENTS PROJECT
 PUBLIC WORK PROJECT NO. E031410M
 LABORATORY
 SANITARY SEWAGE AND WATER DISTRIBUTION SCHEMATICS

DRAWING NO.	A4
30 OF 52	

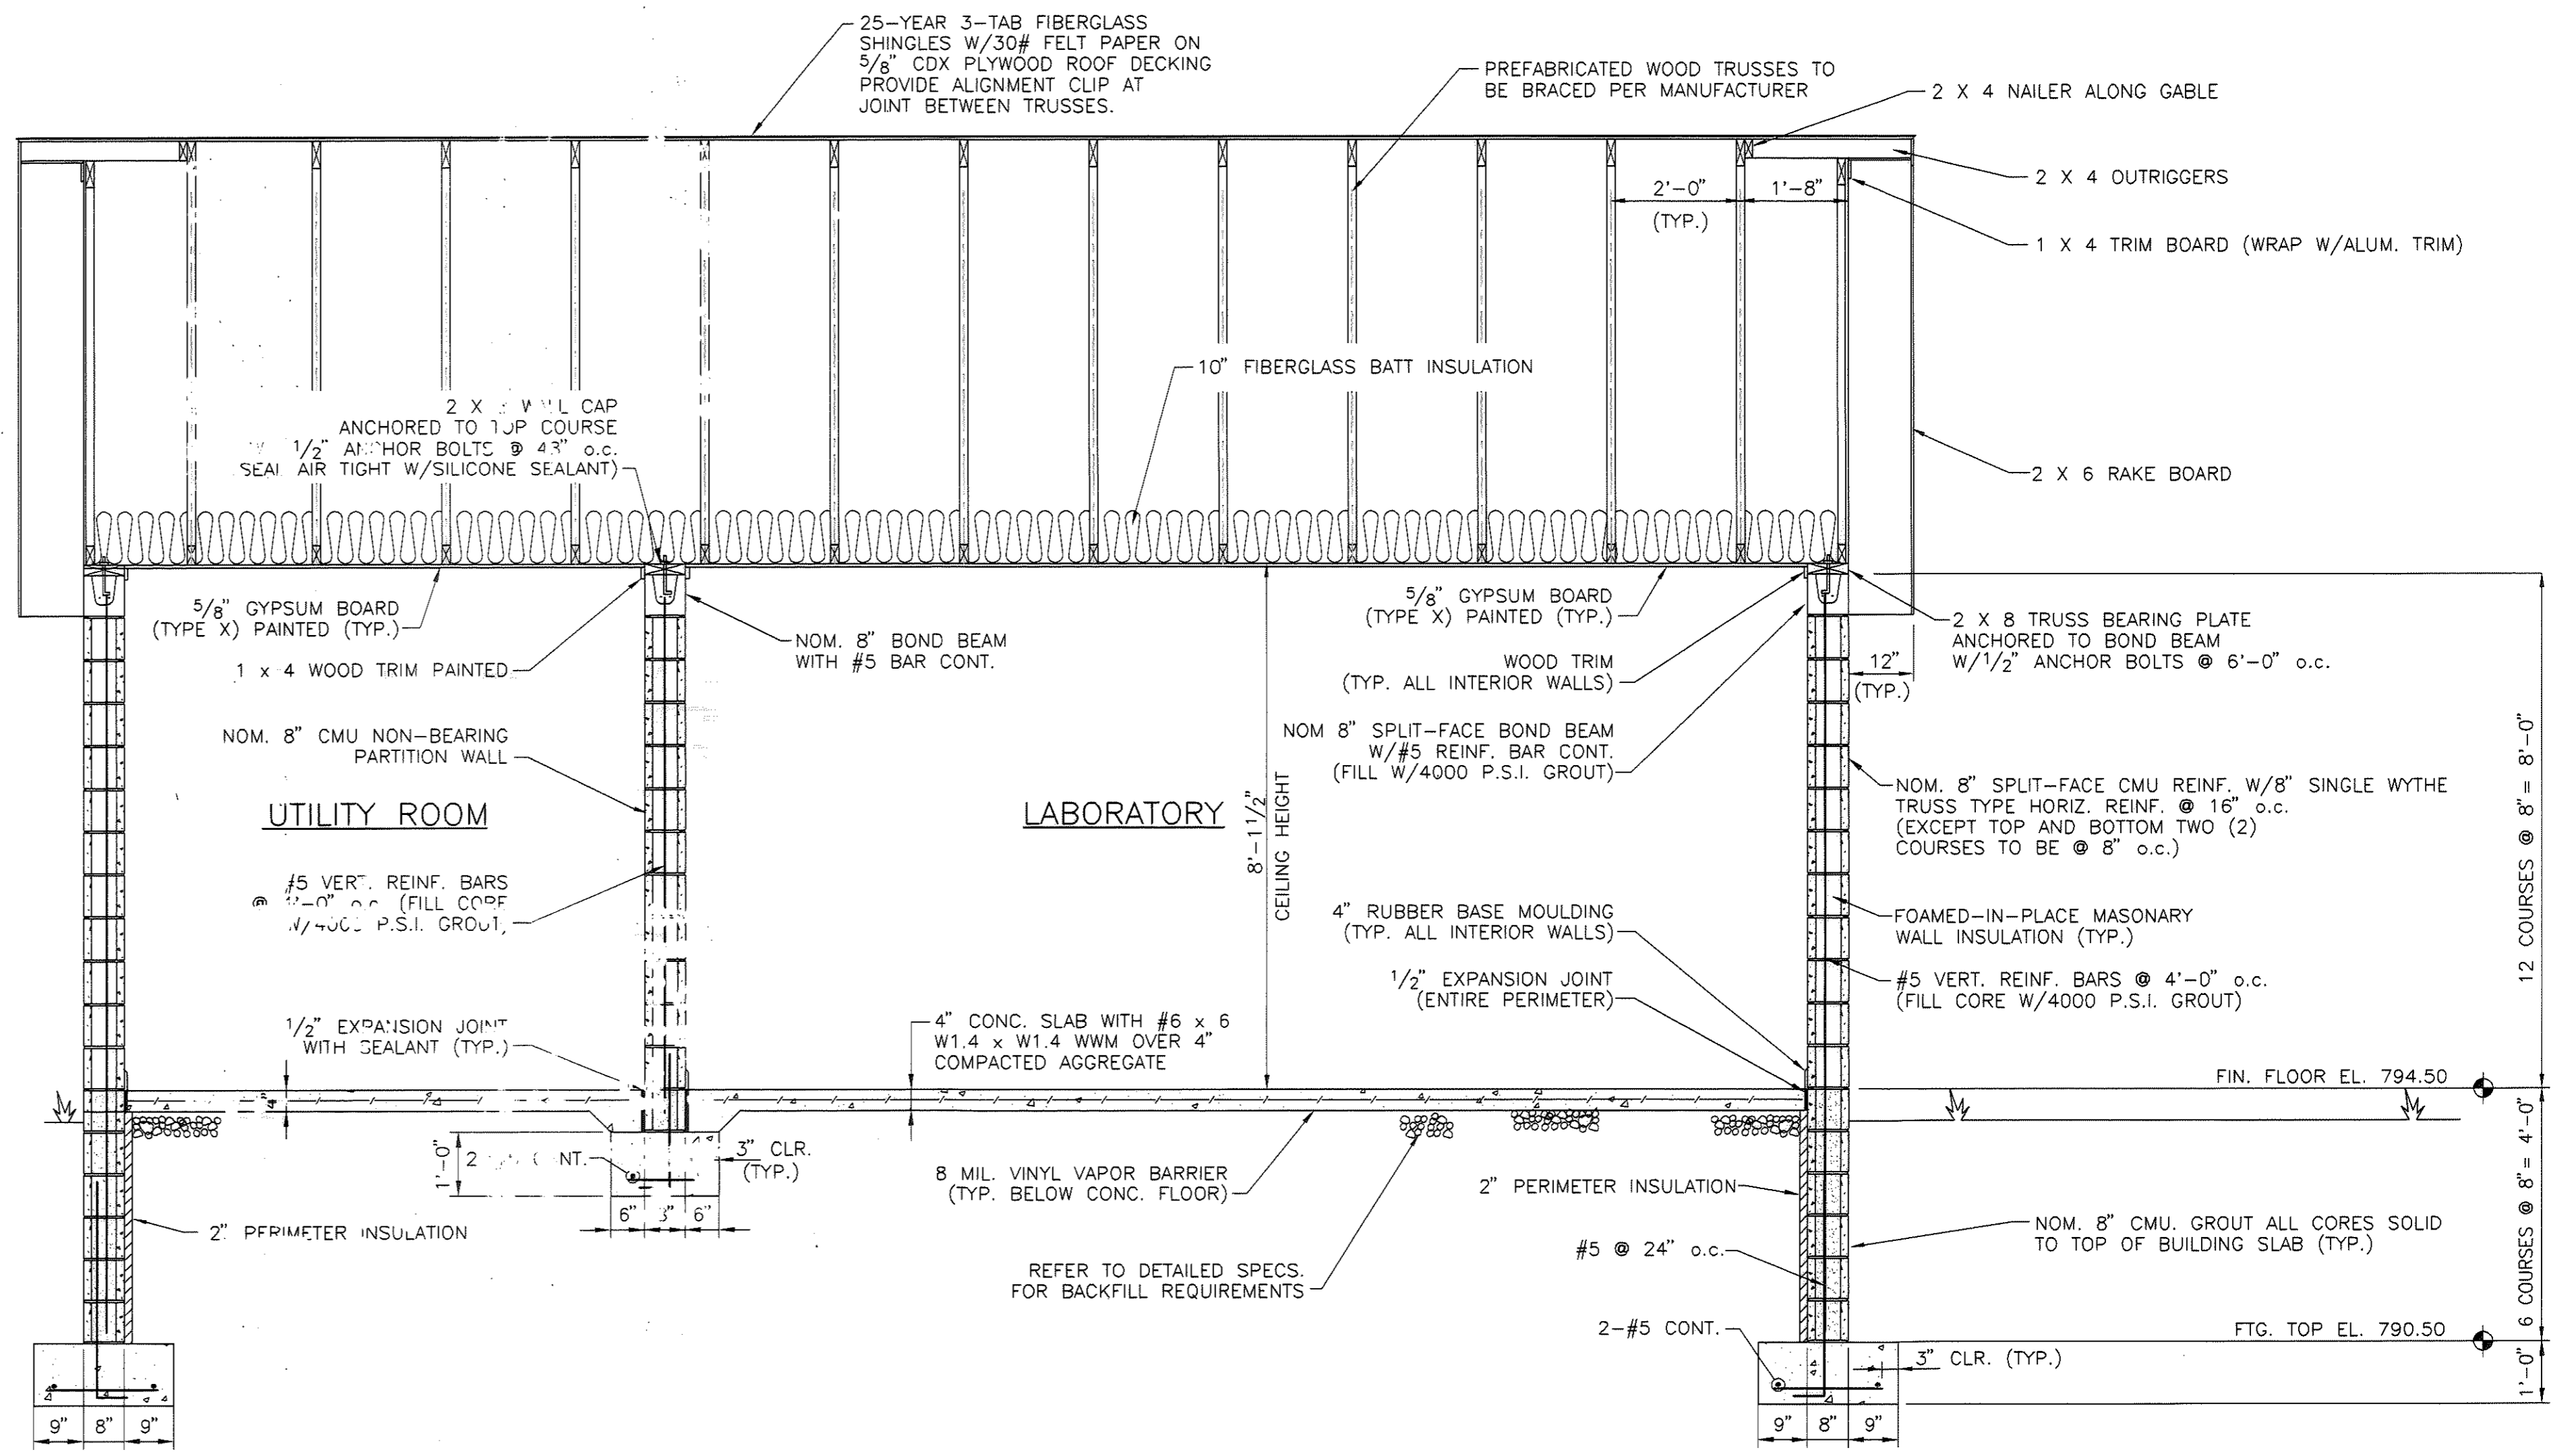


SECTION B
 SCALE: 1/2" = 1'-0" 3128

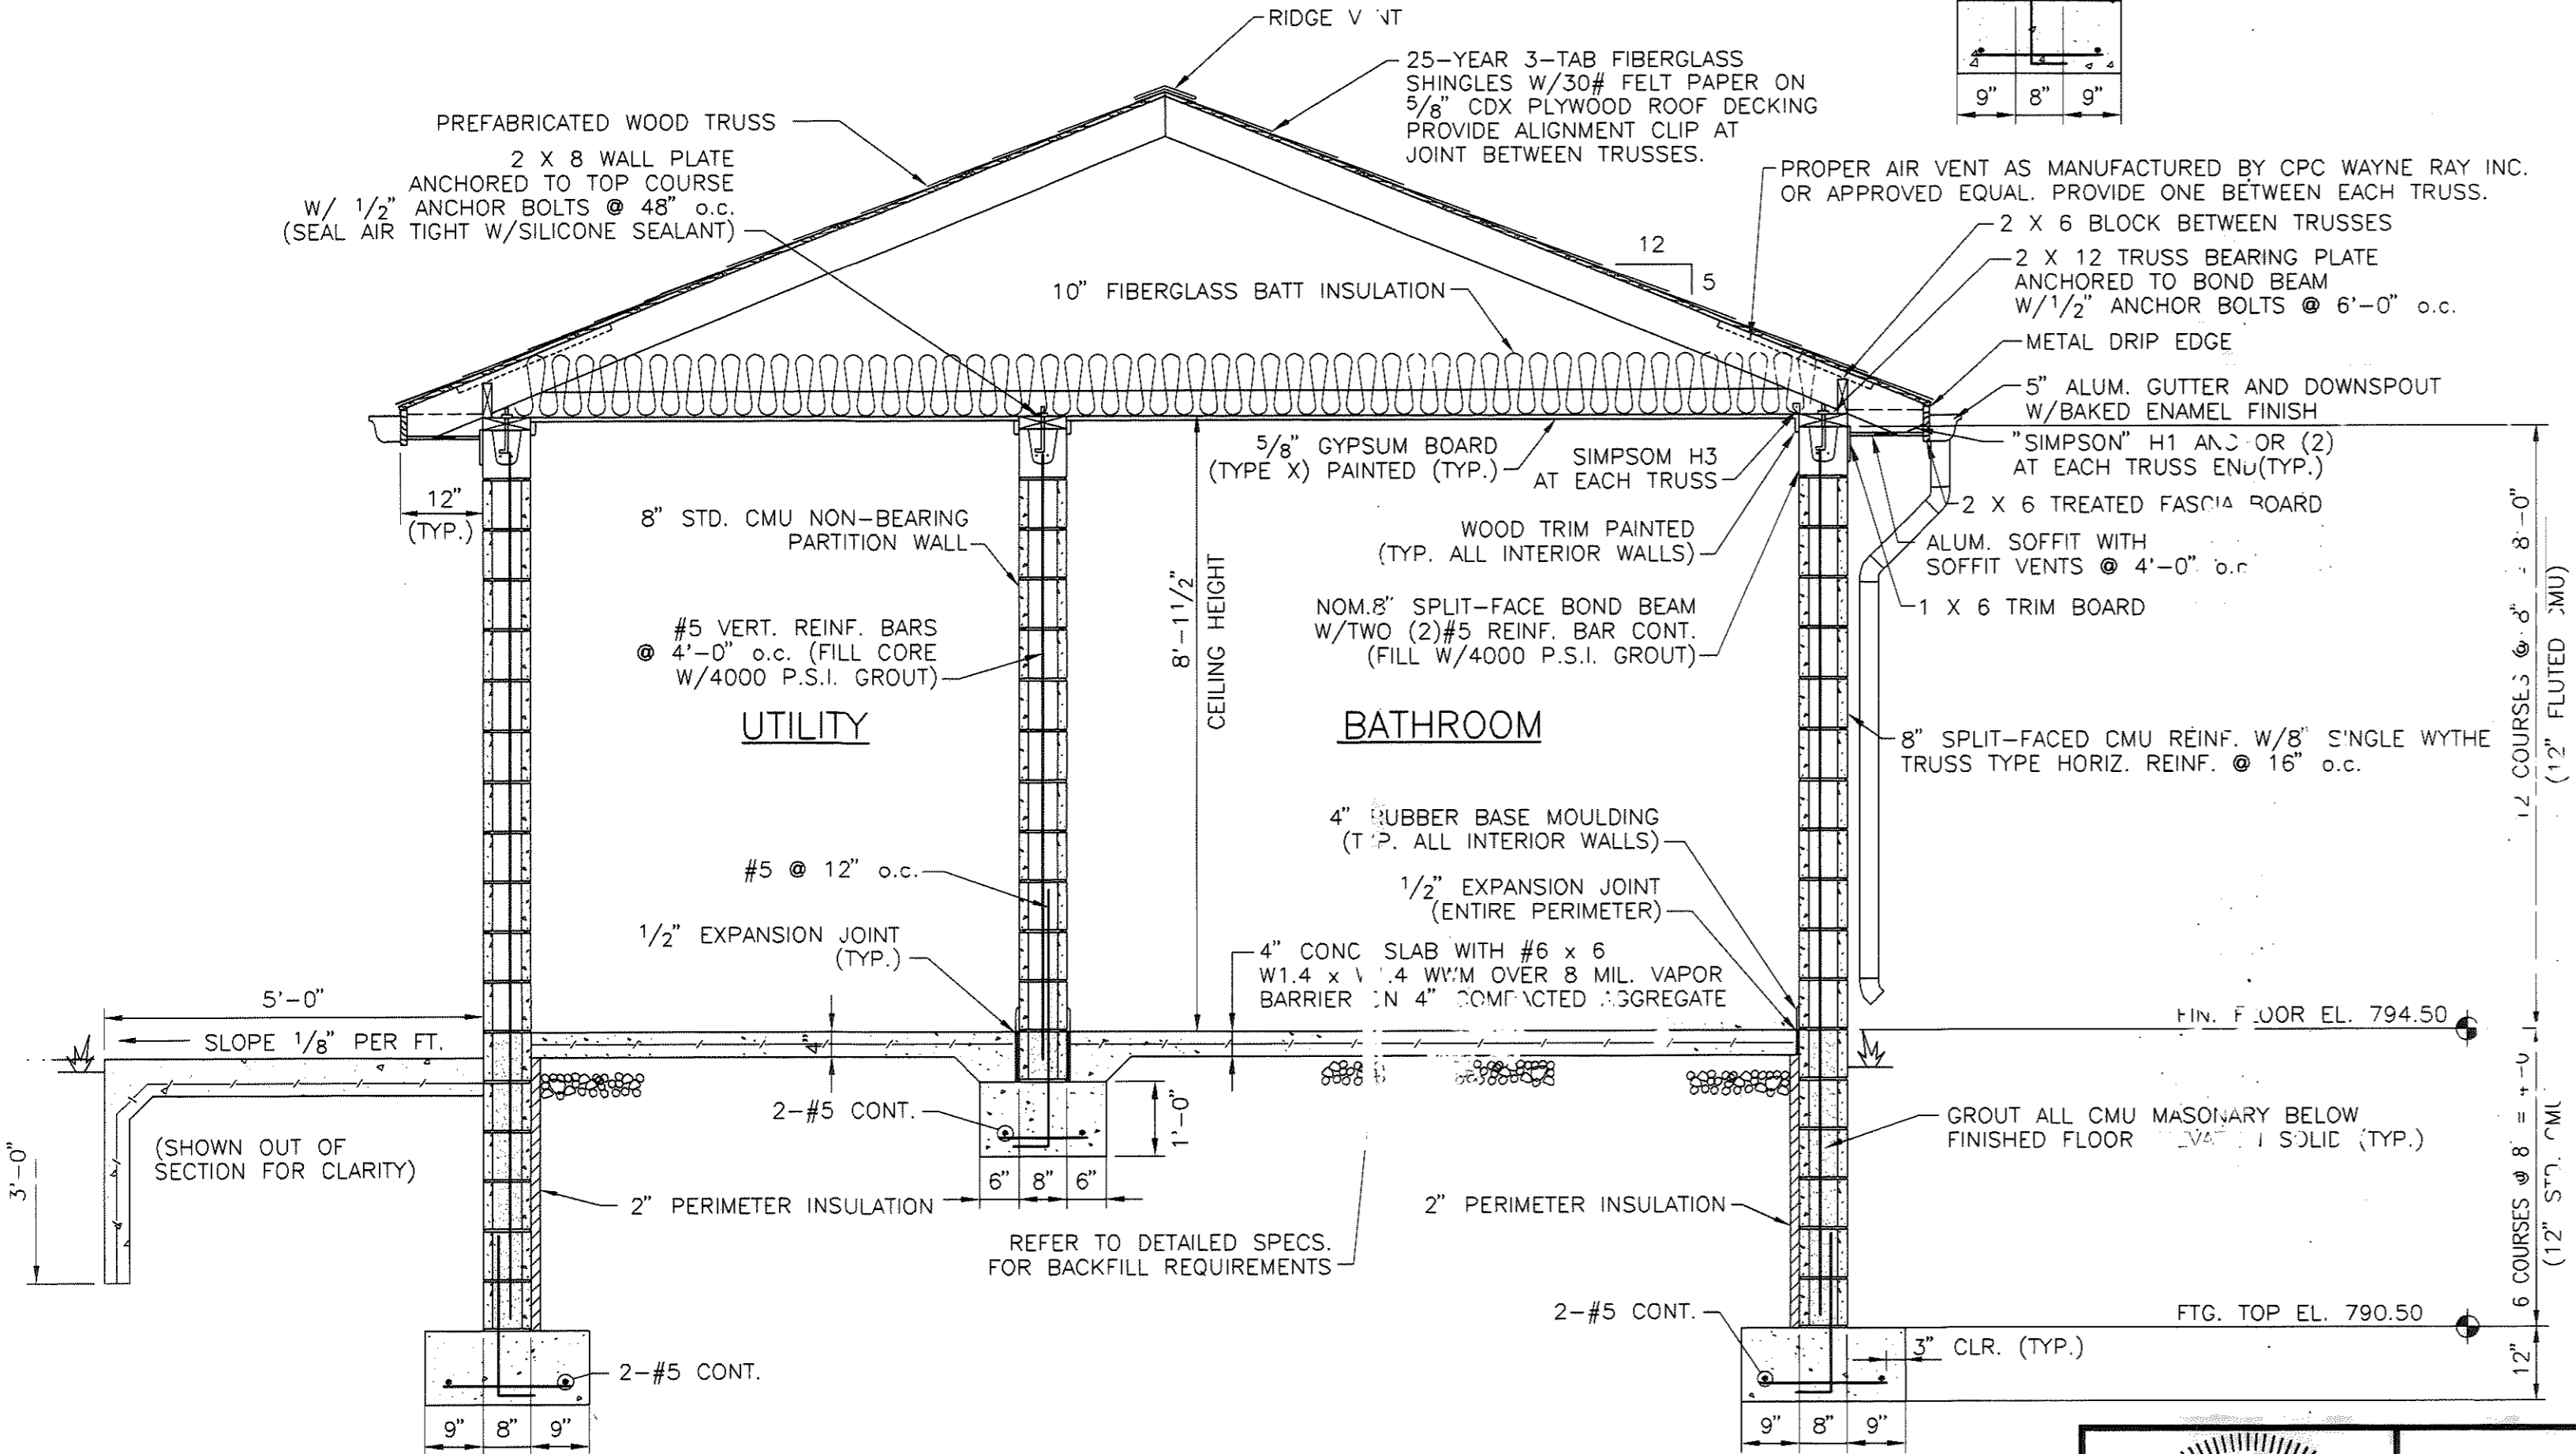

SECTION A
 SCALE: 1/2" = 1'-0" 3128

REVISED "AS-BUILT" DRAWING
 THIS DRAWING HAS BEEN REVISED IN ACCORDANCE WITH NOTES ON "RECORD DRAWINGS" FURNISHED BY THE CONTRACTOR AND WITH EXECUTED CHANGE ORDERS. TO THE BEST OF OUR KNOWLEDGE AND BELIEF, THIS DRAWING SHOWS ACTUAL "AS-BUILT" CONDITIONS.
 COMMONWEALTH ENGINEERS, INC.
 REVISED: DATE 10/06
 BY JCW, CK BY CWW

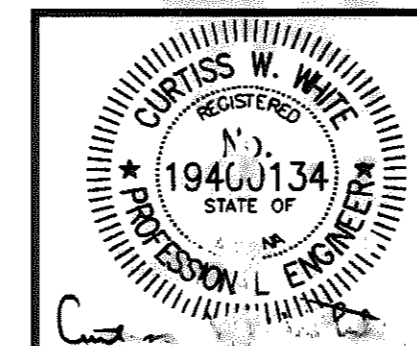


COMMONWEALTH ENGINEERS, INC.


DRAWN BY:	CB
DESIGNED BY:	DAH
CHECKED BY:	DAH
DATE:	1/04
JOB NO:	S02119-02
SCALE:	AS NOTED

SALAMONIE RESERVOIR WASTEWATER TREATMENT PLANT IMPROVEMENTS PROJECT	
PUBLIC WORK PROJECT NO. E031410M	
LABORATORY BUILDING WALL SECTION	


DRAWING NO.	A5
31 OF 52	

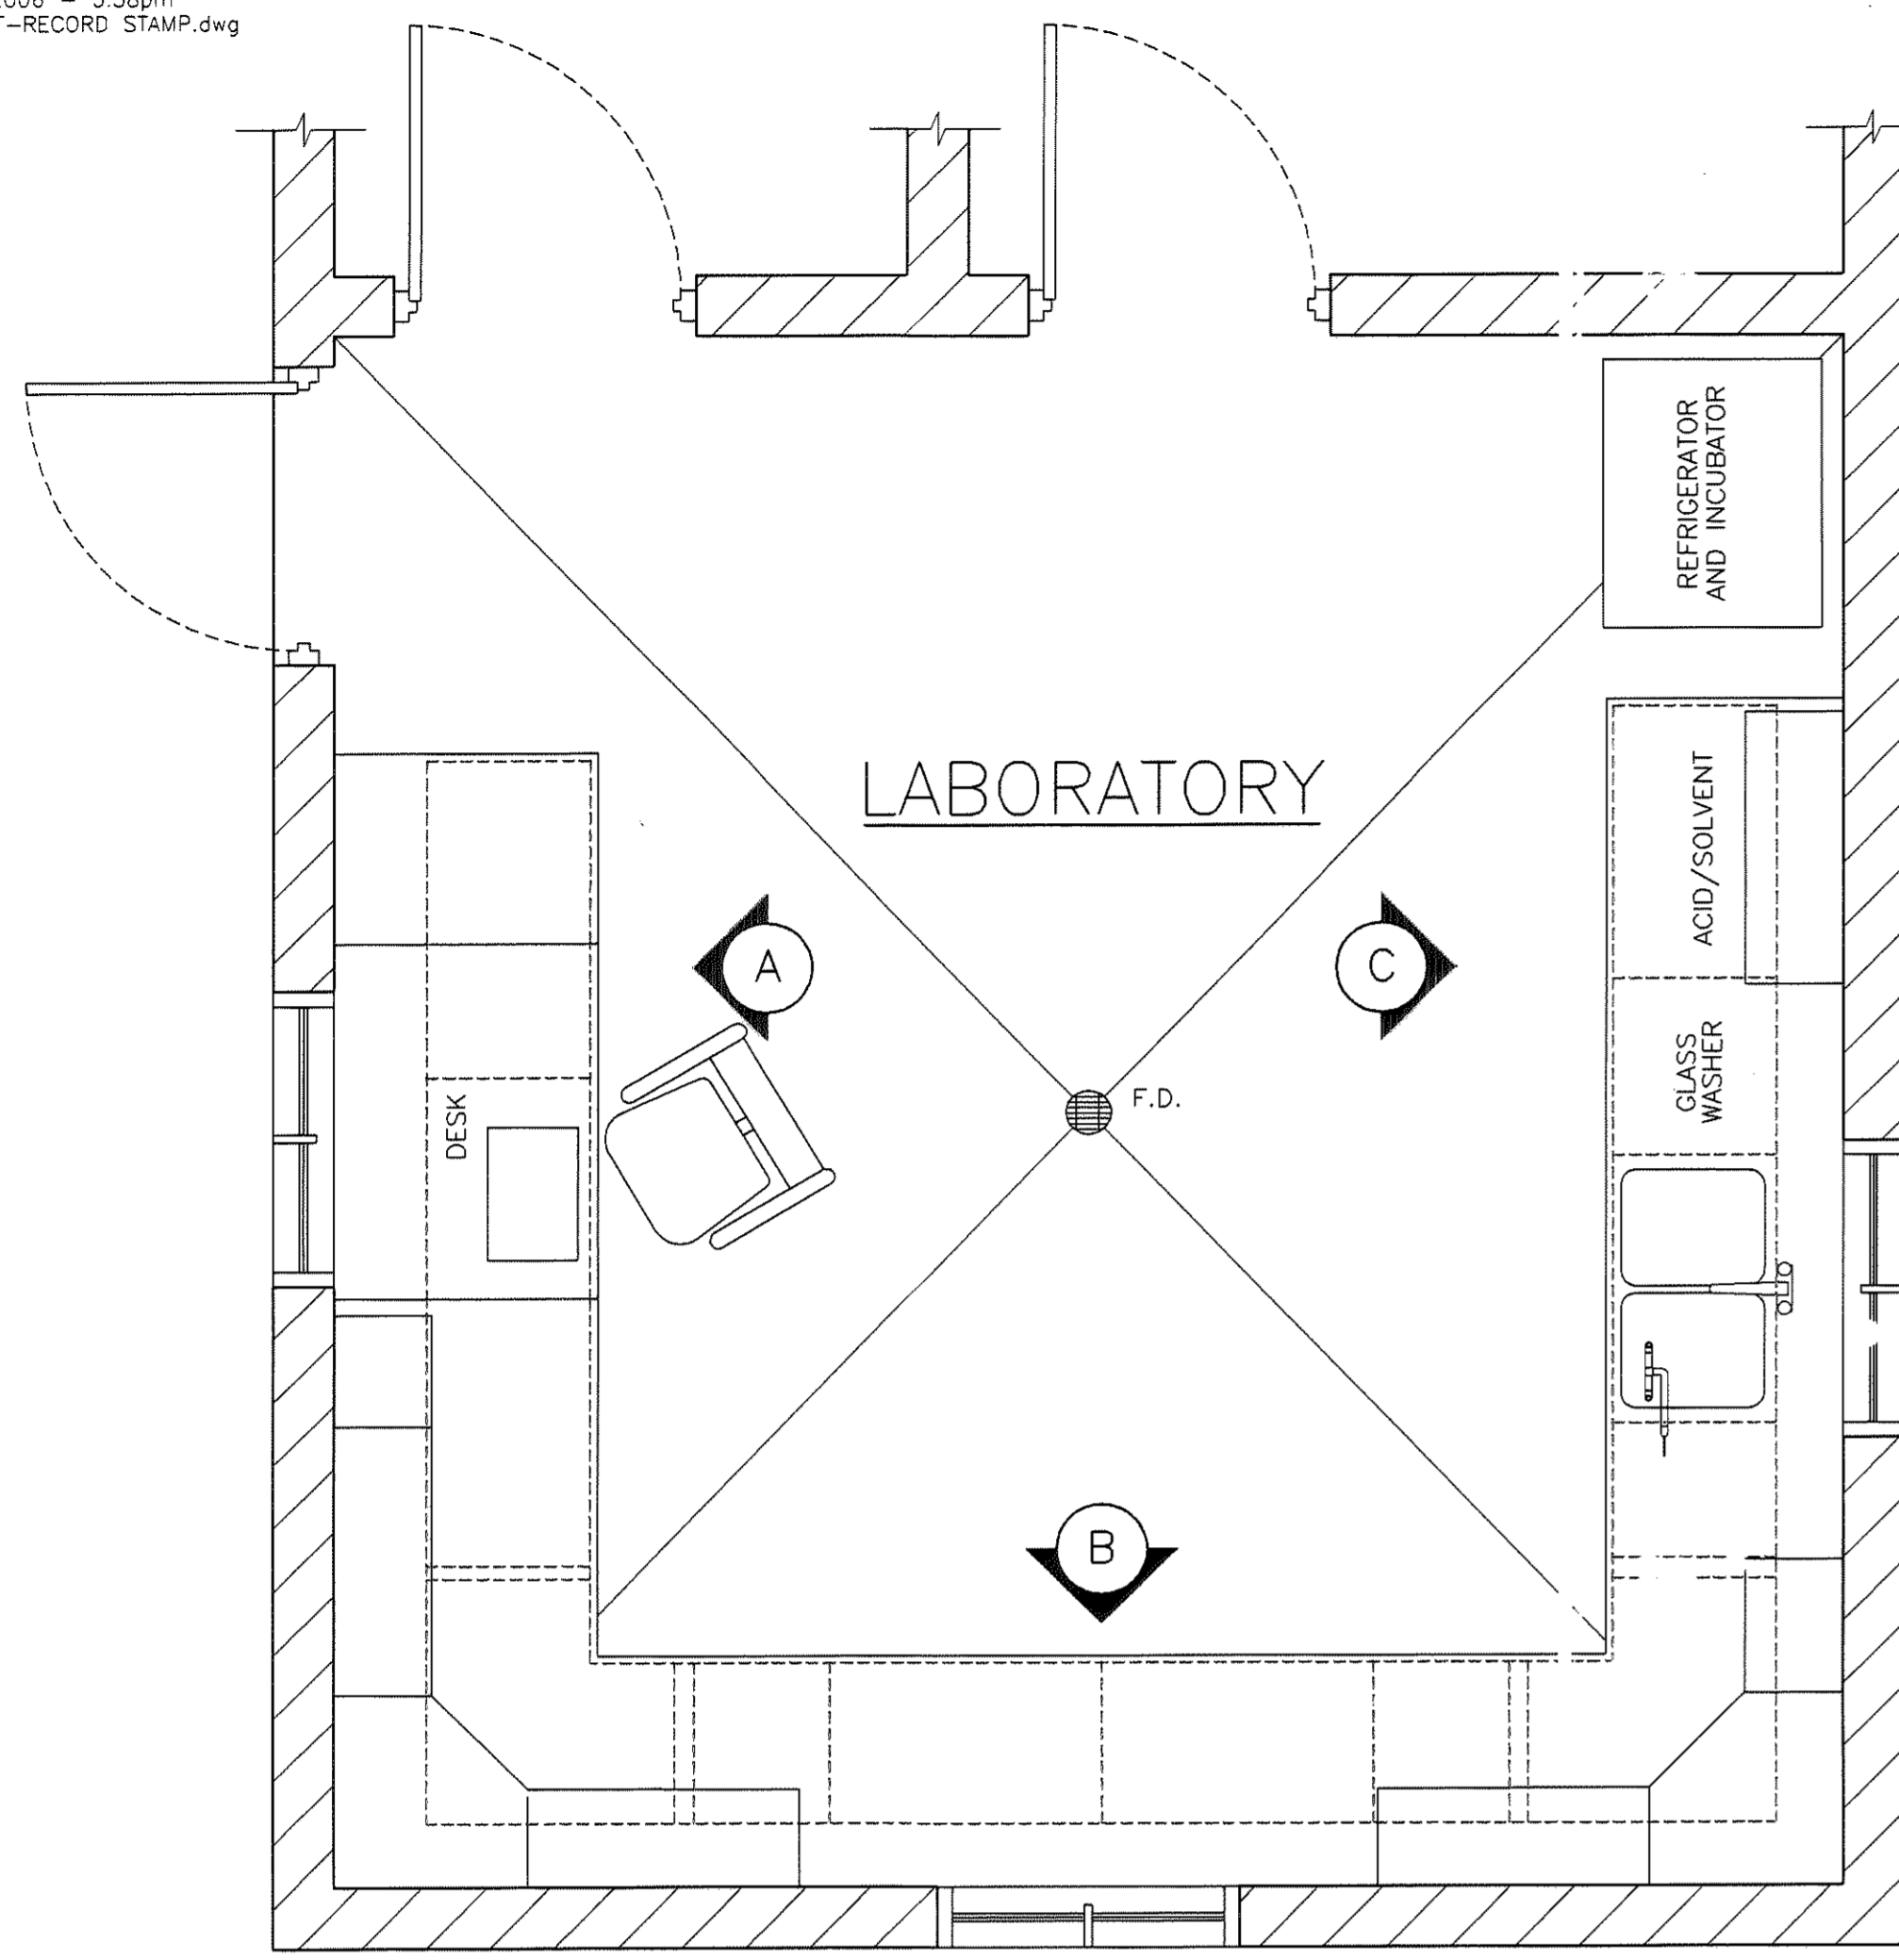

LABORATORY - PLAN
SCALE: 1/2"=1'-0"

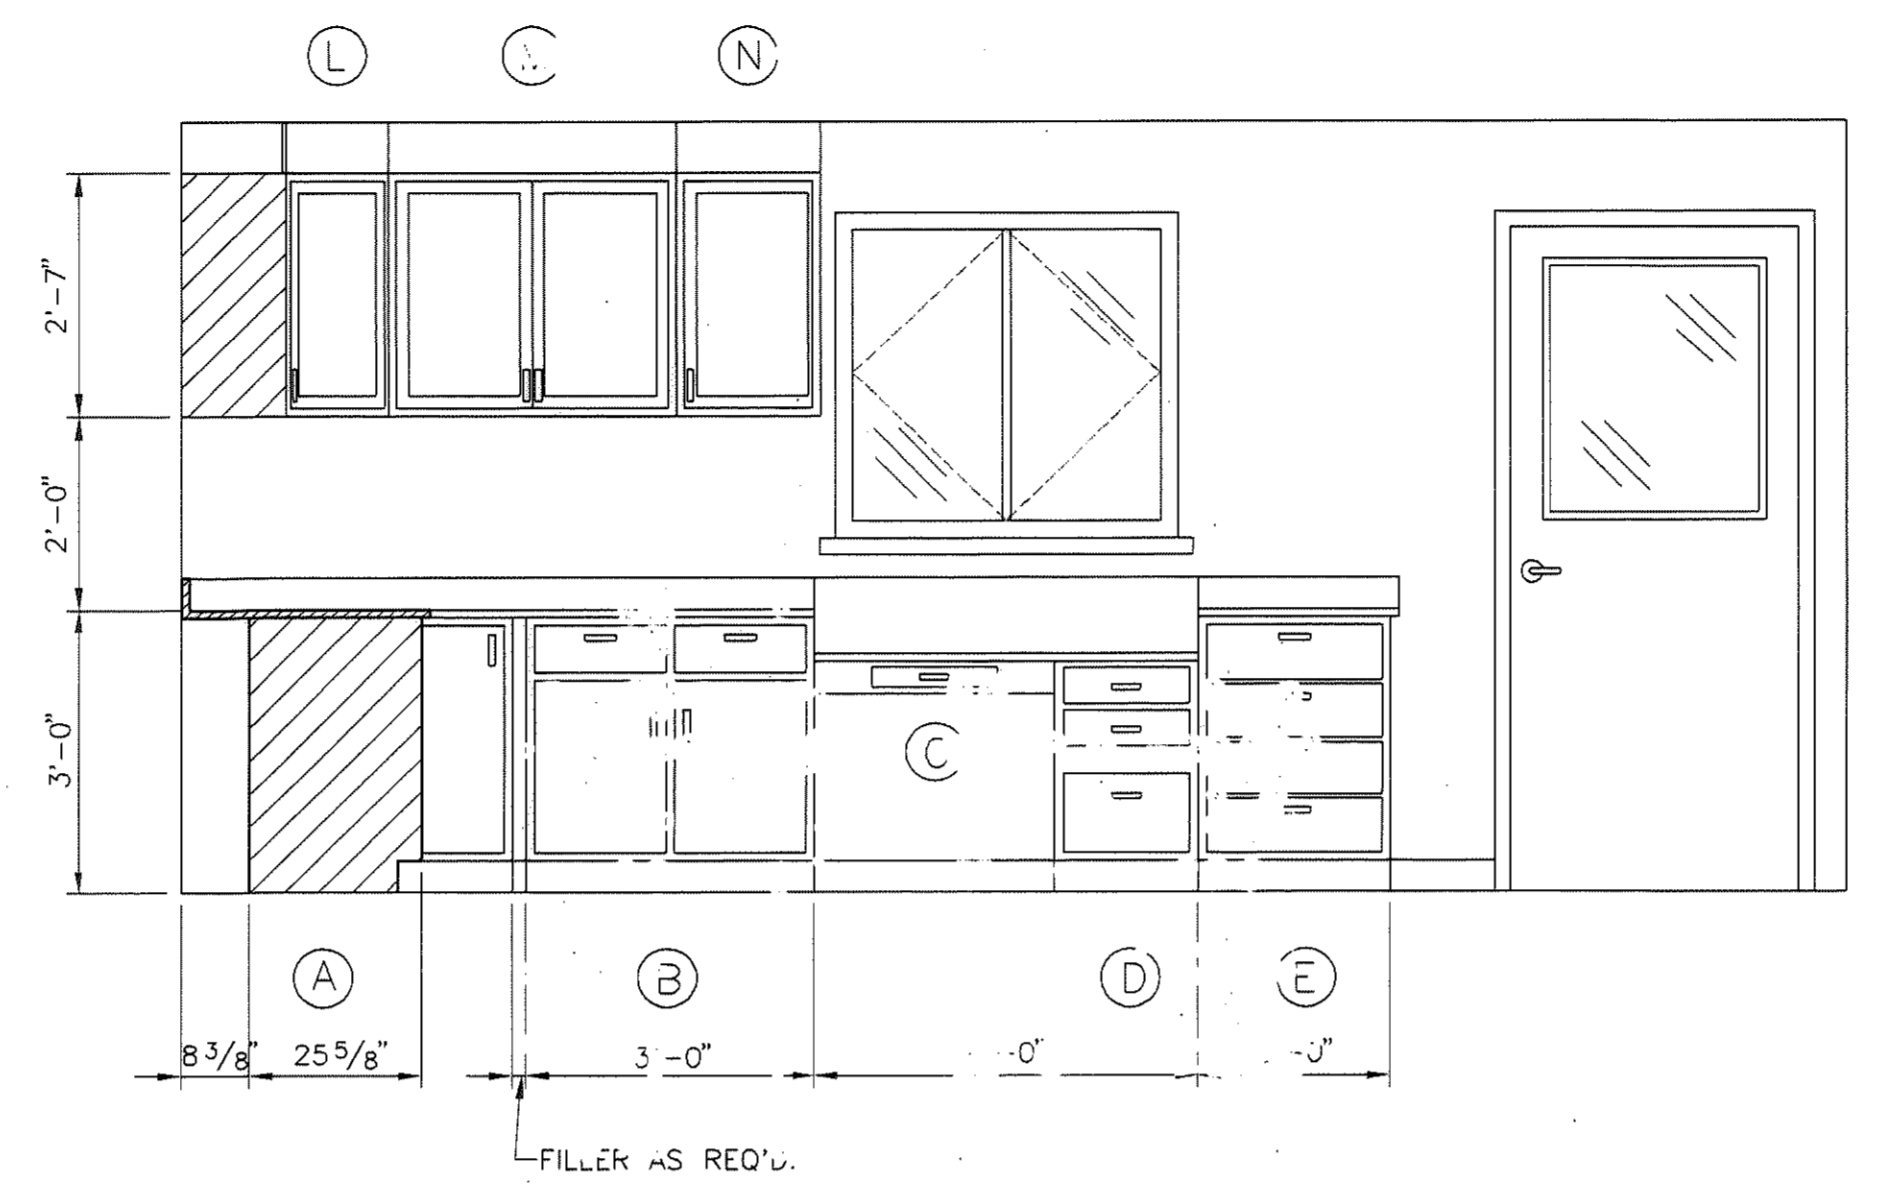


ELEVATION A

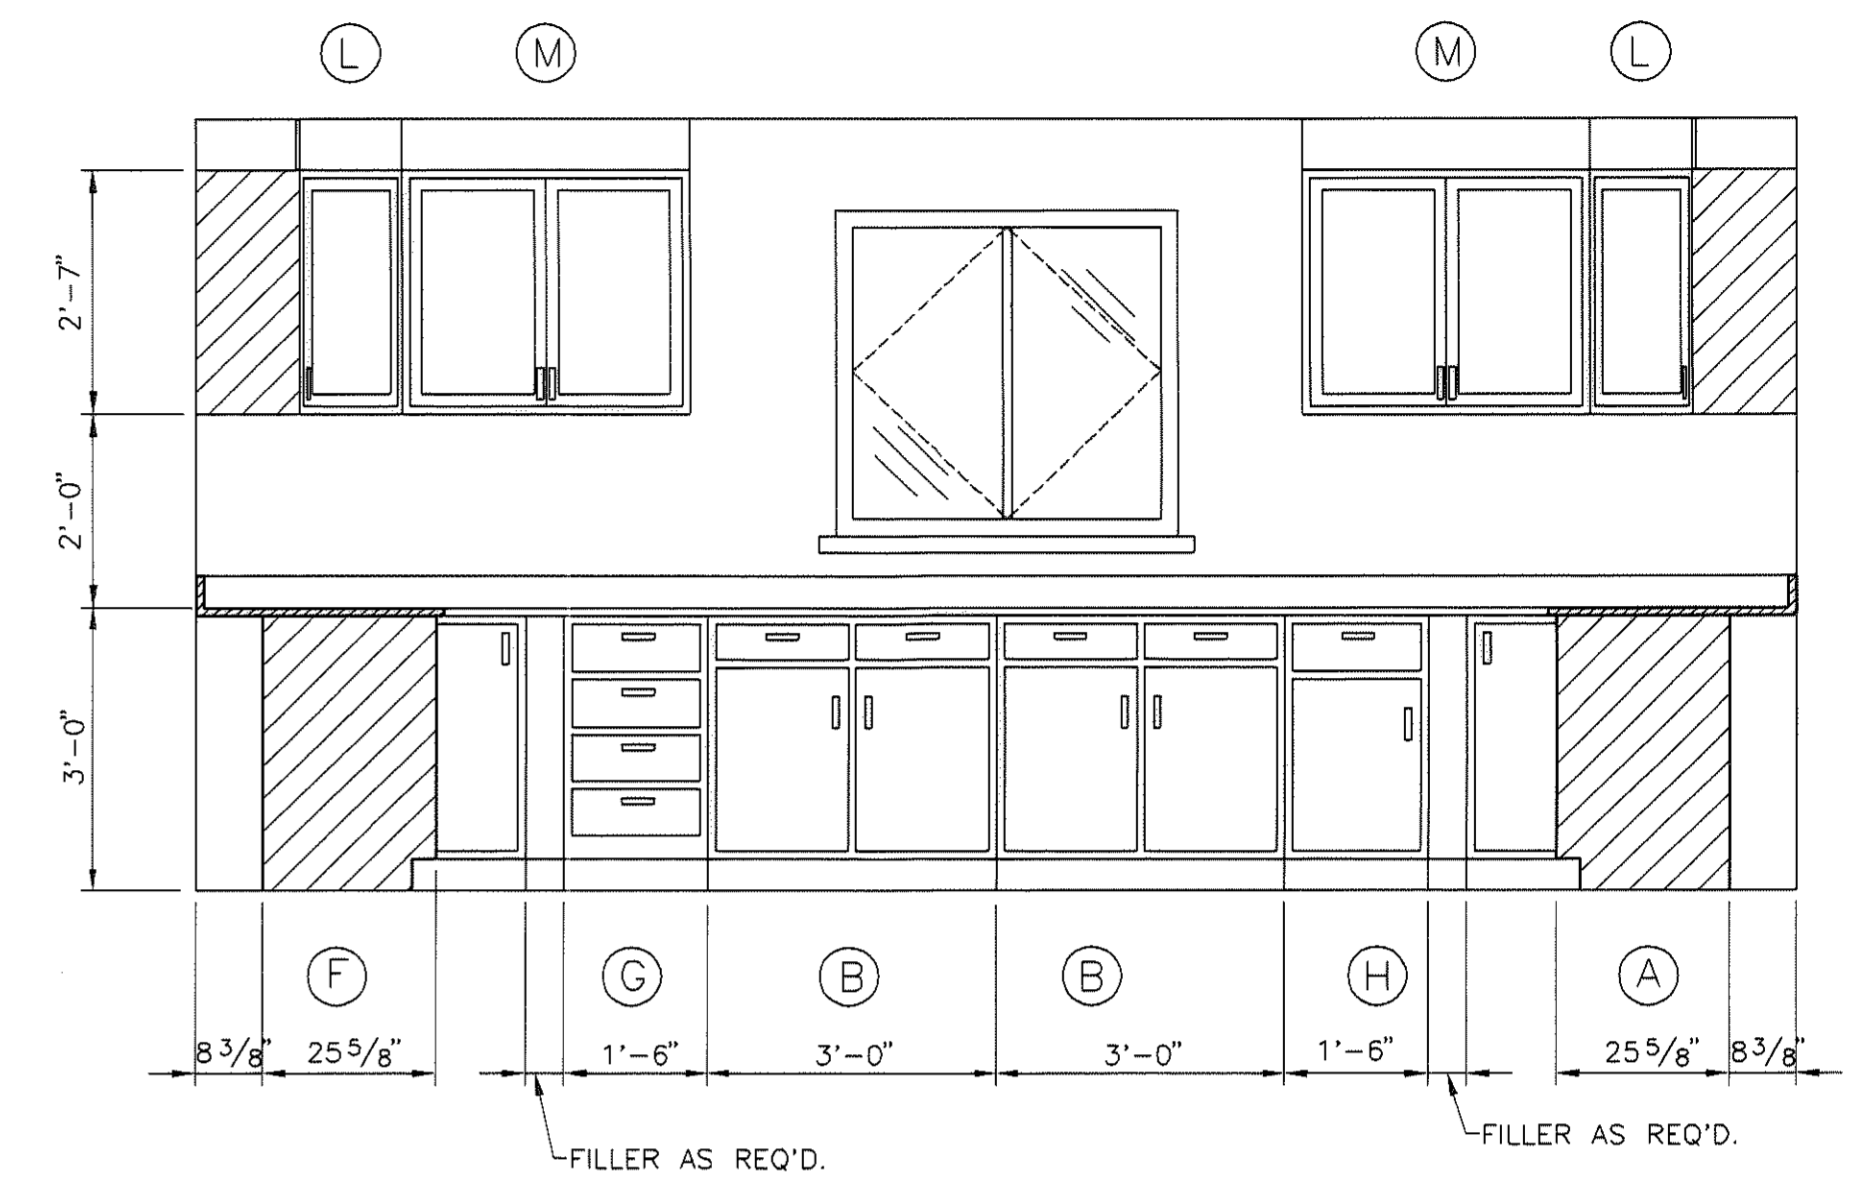


ELEVATION B


CABINET SCHEDULE			
UNIT	QTY.	DESCRIPTION	MANUFACTURER OR EQUAL
(A)	1	CORNER CABINET RIGHT HAND HINGED	FISHER HAMILTON # 424-S-6320
(B)	3	COMBINATION CABINET 36" TWO 6" DRAWERS SIDE BY SIDE ABOVE CUPBOARD	FISHER HAMILTON # 457-S-6320
(C)	1	DRAWER FRAME	FISHER HAMILTON # 501-S-2220
(D)	1	DRAWER CABINET (TWO) 4 1/2" - (ONE) 10 1/2" DRAWERS	FISHER HAMILTON # 339-S-2220
(E)	1	DRAWER CABINET 24" (FOUR) 3" HIGH DRAWERS	FISHER HAMILTON # 373-S-4320
(F)	1	CORNER CABINET LEFT HAND HINGED	FISHER HAMILTON # 425-S-6320
(G)	1	DRAWER CABINET 18" (FOUR) 6" HIGH DRAWERS	FISHER HAMILTON # 373-S-2320
(H)	2	COMBINATION CABINET 18" ONE 6" DRAWER ABOVE CUPBOARD	FISHER HAMILTON # 336-S-2320
(I)	1	POLYETHYLENE LINED ACID STORAGE CABINET	FISHER HAMILTON # 950-S-2380 AND 90-L-16600
(J)	1	24" UNDERCOUNTER GLASS WASHER BY LABCONCO OR EQUAL	# 44003
(K)	1	SINK CABINET	FISHER HAMILTON # 115-S-6320
(L)	2	CORNER WALL CASE HINGED DOOR	FISHER HAMILTON # 724-M-2330
(M)	4	WALL CASE HINGED DOOR	FISHER HAMILTON # 712-S-6330
(N)	2	WALL CASE HINGED DOOR	FISHER HAMILTON # 709-S-1330

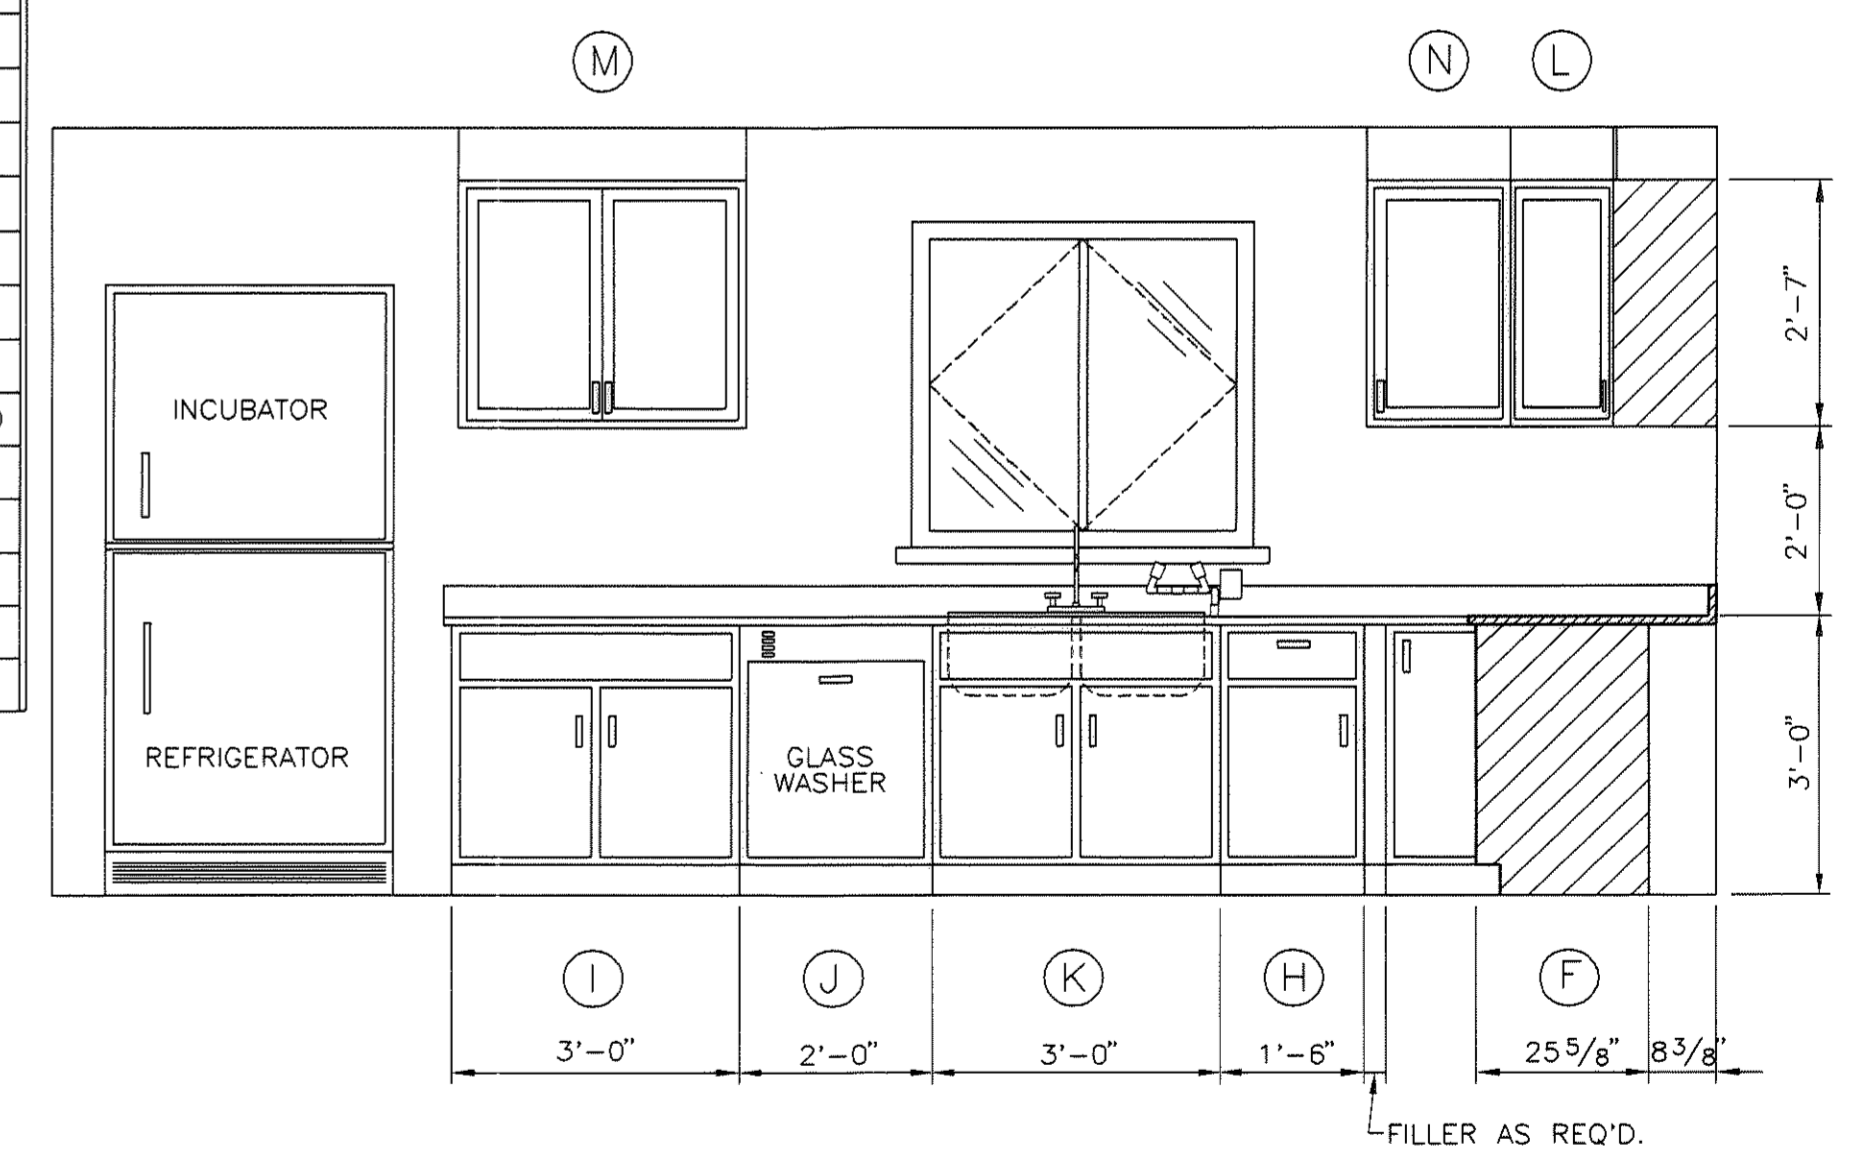


ELEVATION C

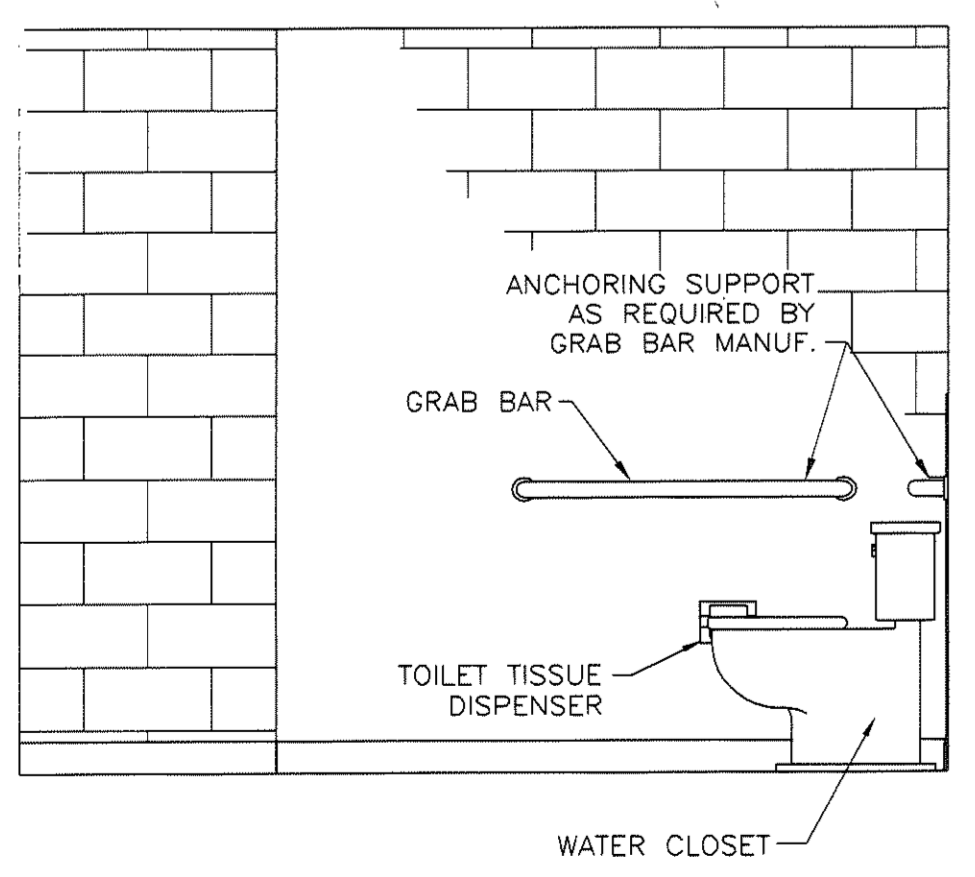

EAST ELEVATION

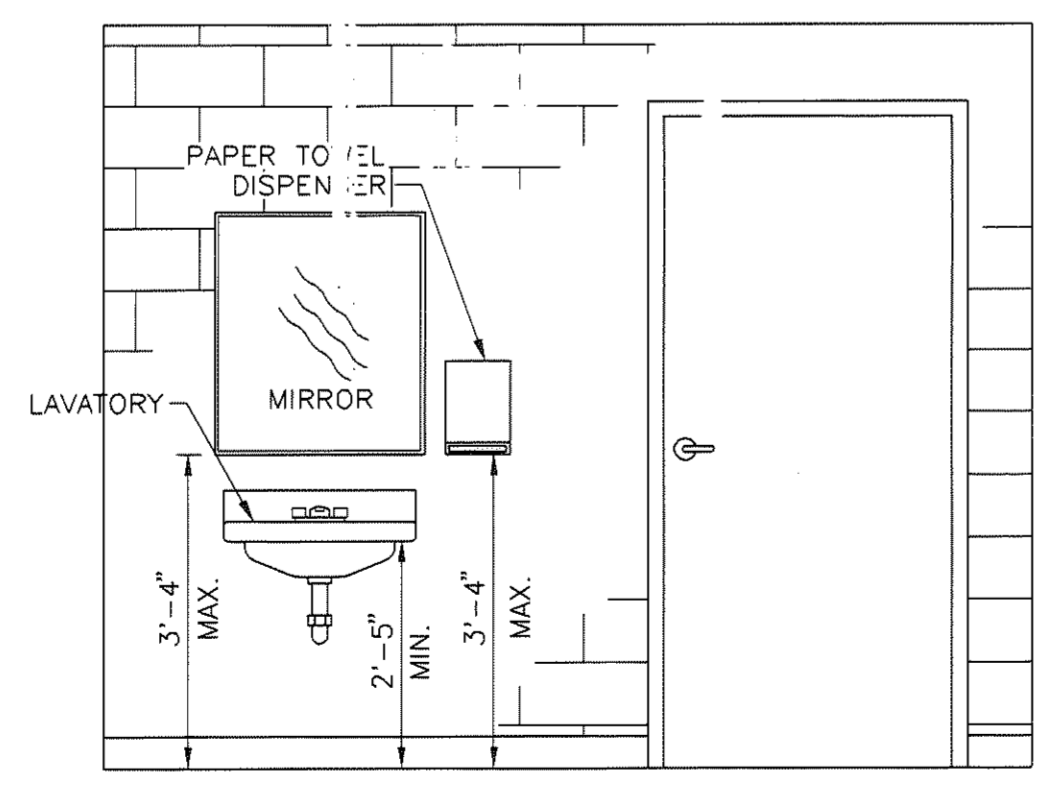


SOUTH ELEVATION

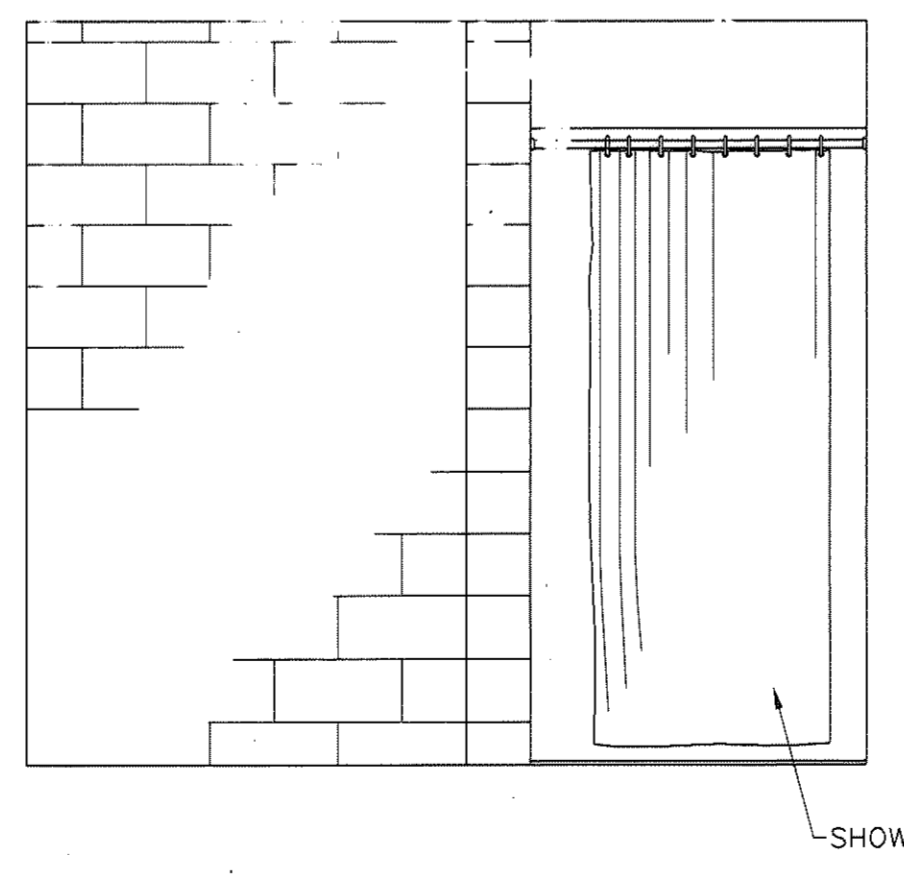

LABORATORY ELEVATIONS
SCALE: 1/2"=1'-0"

BATHROOM ELEVATIONS
SCALE: 1/2"=1'-0"

REVISED "AS-BUILT" DRAWING
THIS DRAWING HAS BEEN REVISED IN ACCORDANCE WITH NOTES ON "RECORD DRAWINGS" FURNISHED BY THE CONTRACTOR AND WITH EXECUTED CHANGE ORDERS TO THE BEST OF OUR KNOWLEDGE AND BELIEF. THIS DRAWING SHOWS ACTUAL "AS-BUILT" CONDITIONS.
COMMONWEALTH ENGINEERS, INC.
REVISED DATE 10/06
BY JCW, CK BY CWW

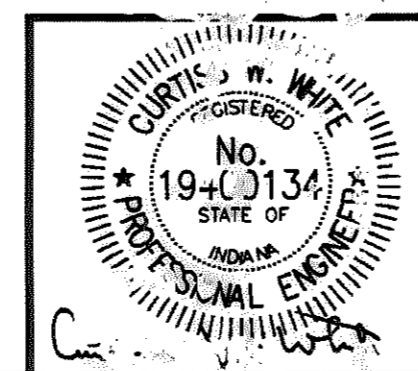


COMMONWEALTH ENGINEERS, INC.


DRAWN BY: CB
DESIGNED BY: DAH
CHECKED BY: DAH
DATE: 1/04
JOB NO: S02119-02
SCALE: AS NOTED

SALAMONIE RESERVOIR
WASTEWATER TREATMENT PLANT IMPROVEMENTS PROJECT
PUBLIC WORK PROJECT NO. E031410M
LABORATORY AND RESTROOM ELEVATION AND DETAILS


DRAWING NO.
A6
32 OF 52

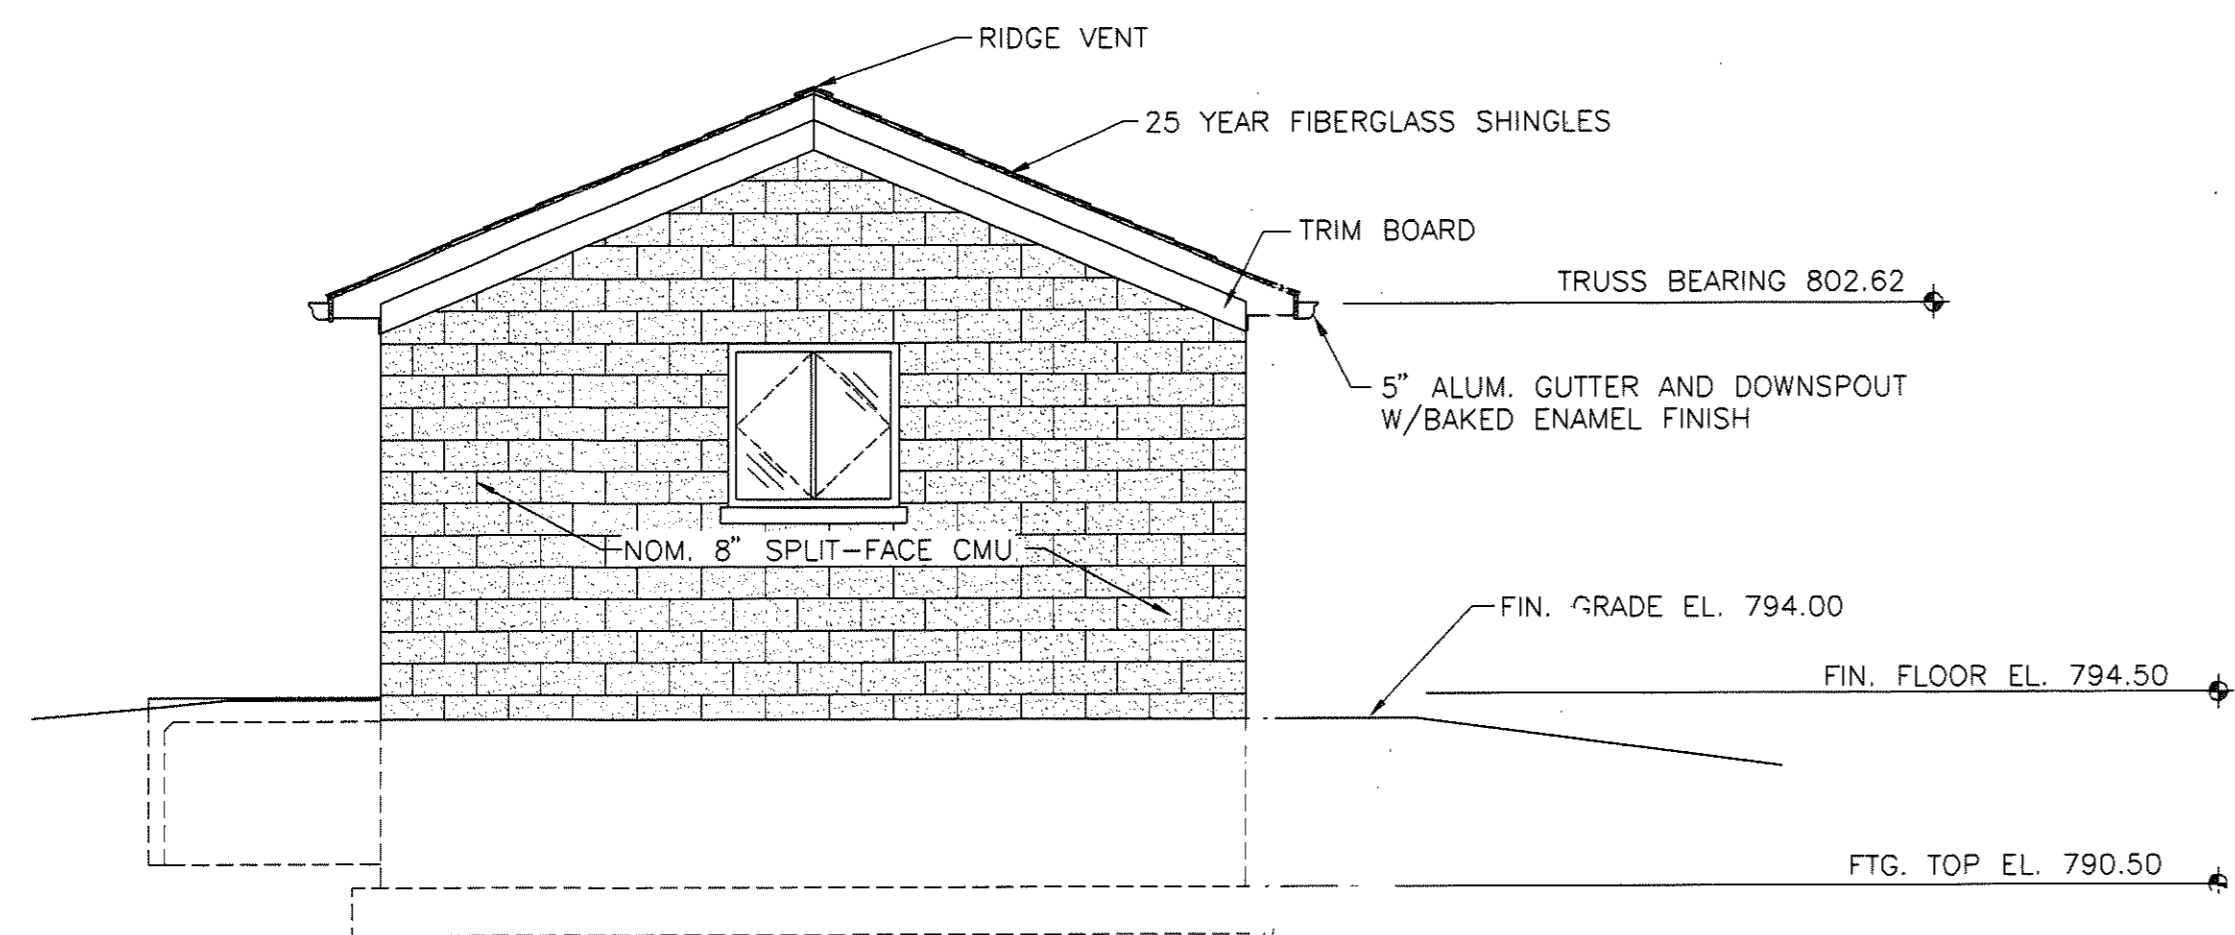


NORTH ELEVATION
 SCALE: 1/4"=1'-0"

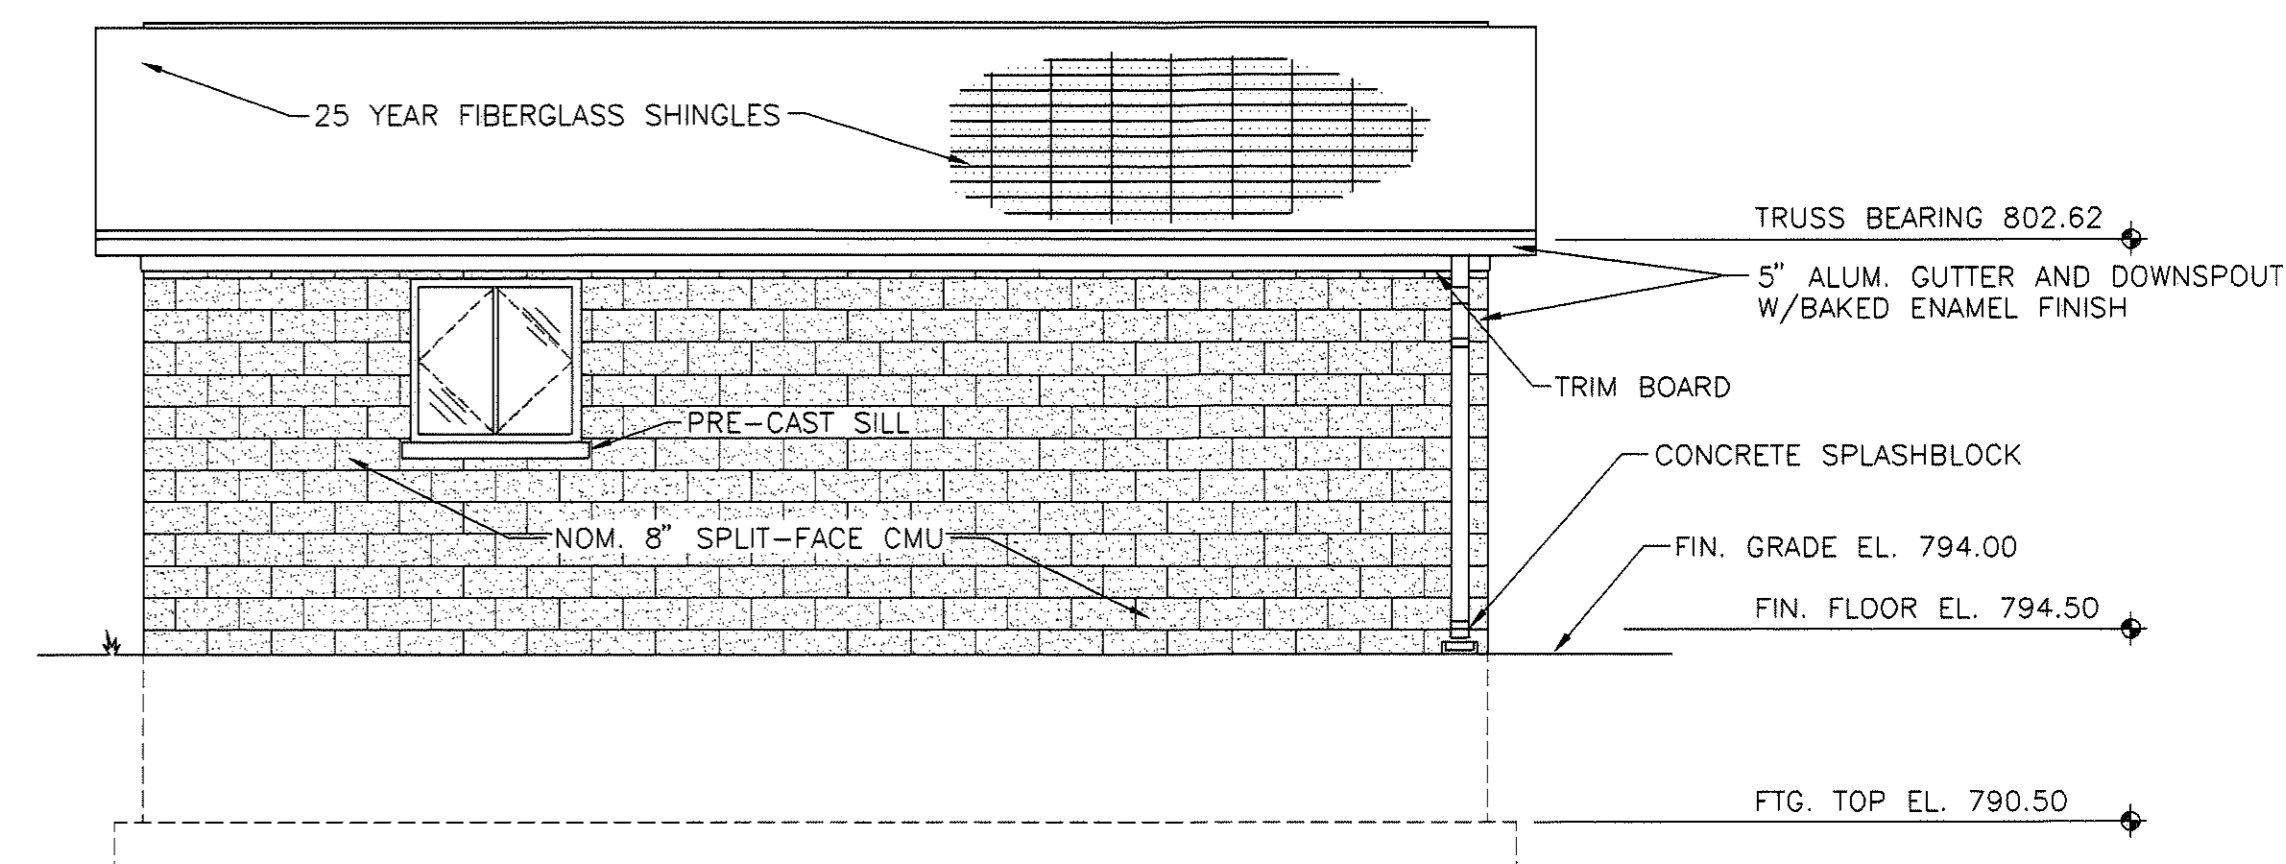

WEST ELEVATION
 SCALE: 1/4"=1'-0"

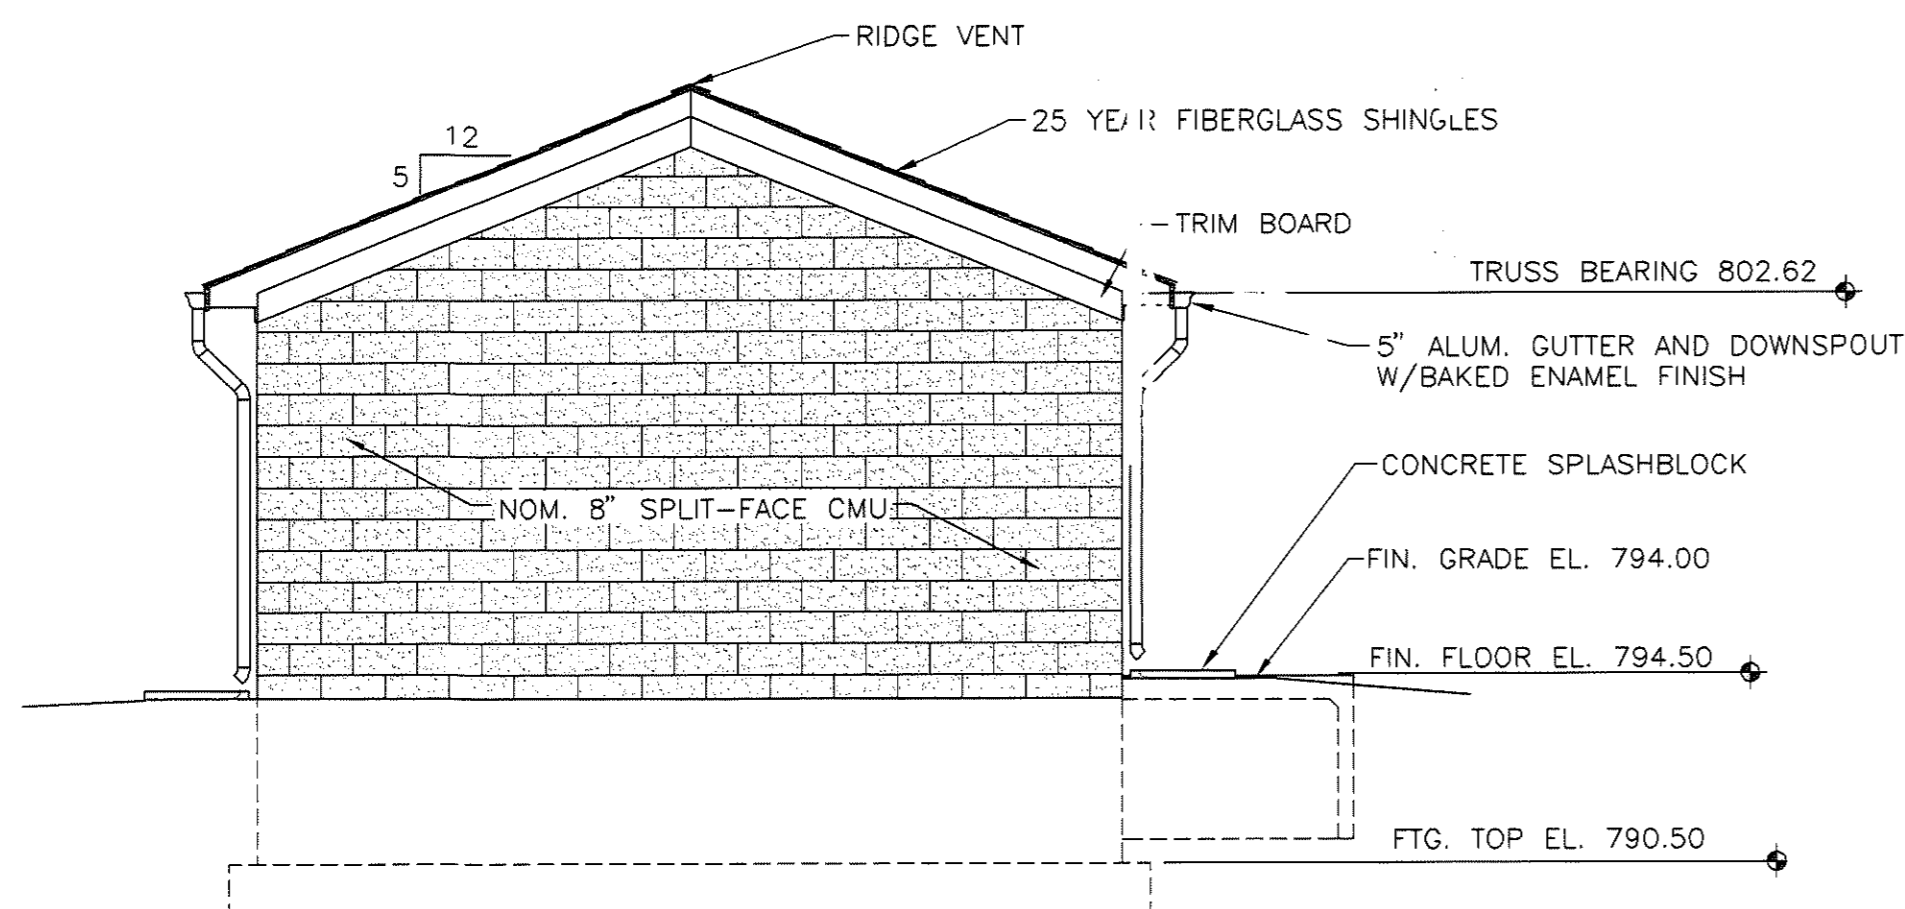


SOUTH ELEVATION
 SCALE: 1/4"=1'-0"

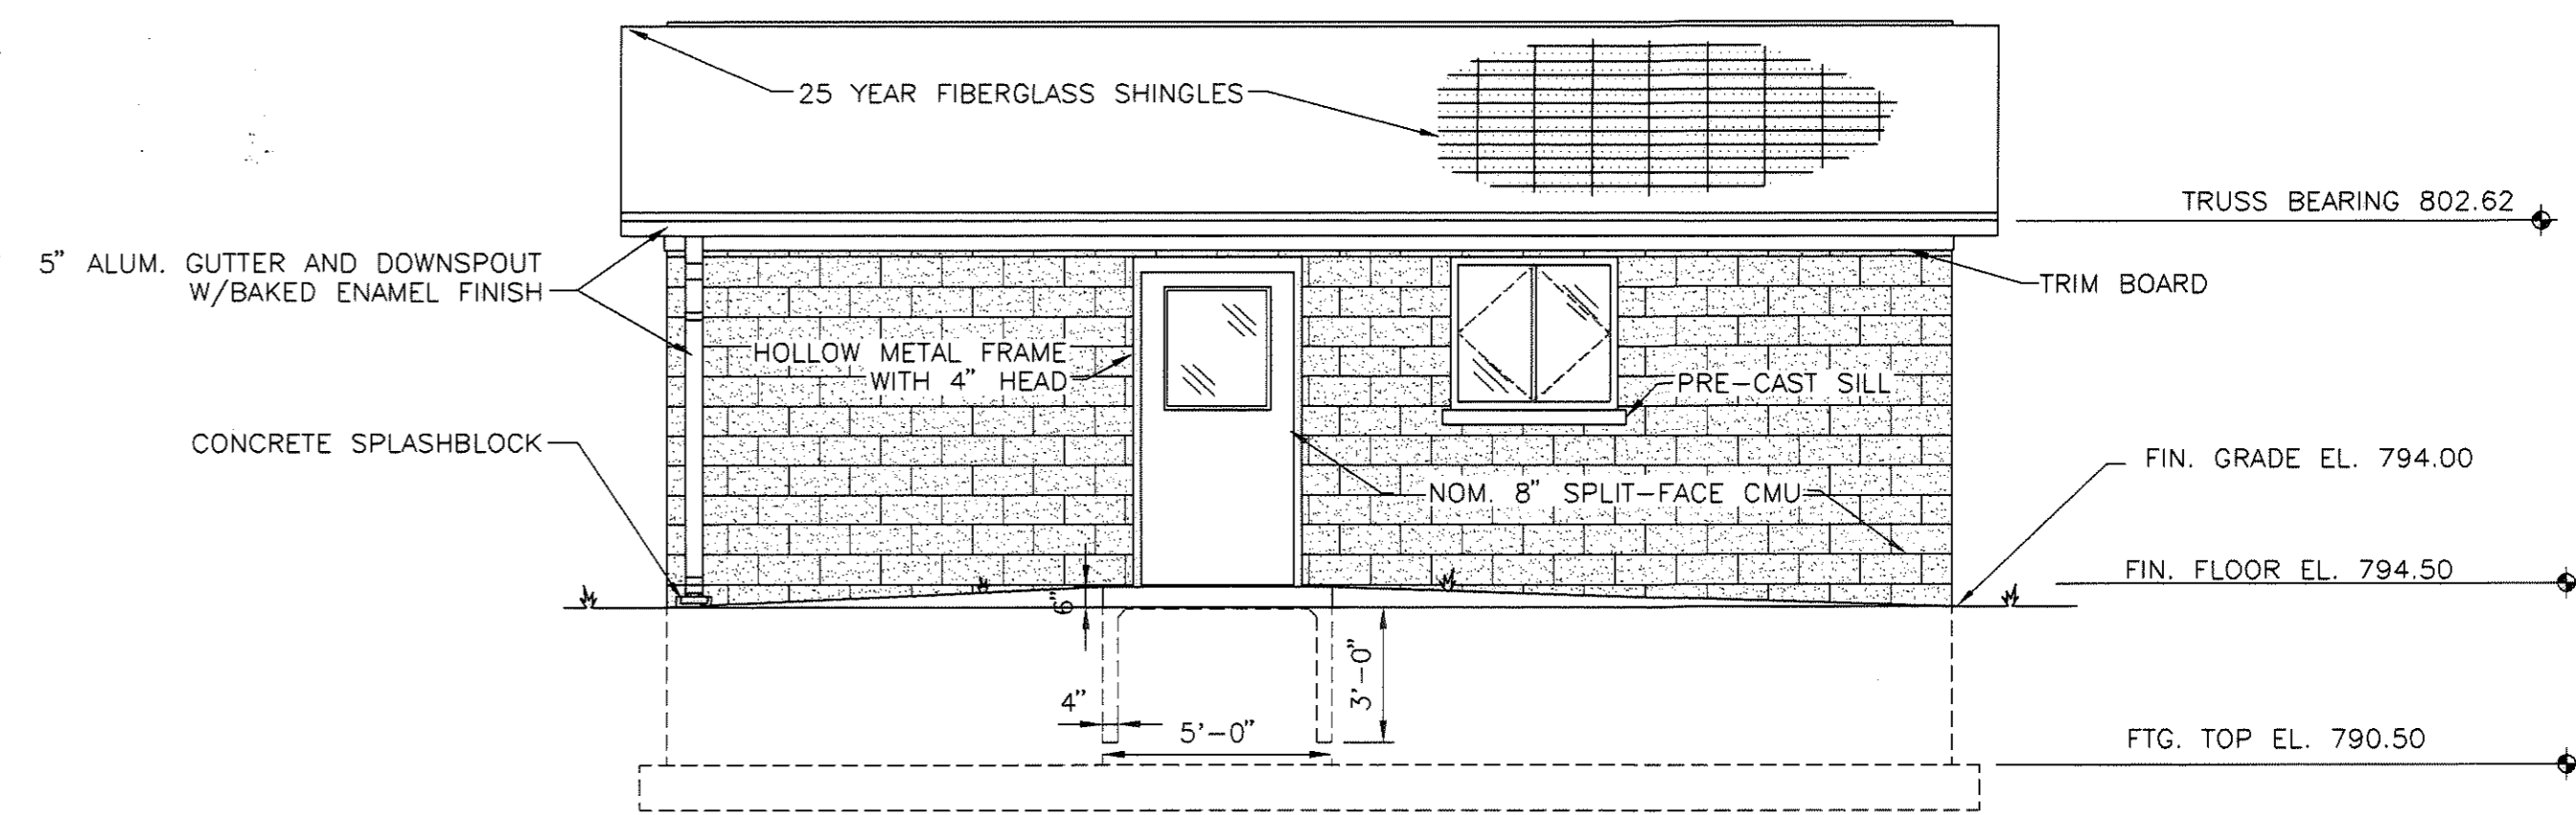

EAST ELEVATION
 SCALE: 1/4"=1'-0"

NOT:
 CONTRACTOR TO MAKE ALL ROOF
 PENETRATIONS REQUIRED AND
 INSTALL ALL VENTS.

REVISED "AS-BUILT" DRAWING
 THIS DRAWING HAS BEEN REVISED IN ACCORDANCE
 WITH NOTES ON "RECORD DRAWINGS" FURNISHED BY
 THE CONTRACTOR AND WITH EXECUTED CHANGE
 ORDERS. TO THE BEST OF OUR KNOWLEDGE AND
 BELIEF, THIS DRAWING SHOWS ACTUAL "AS-BUILT"
 CONDITIONS.
 COMMONWEALTH
 ENGINEERS, INC.
 REVISED DATE 10/06
 BY JCW, CK, BY CWW

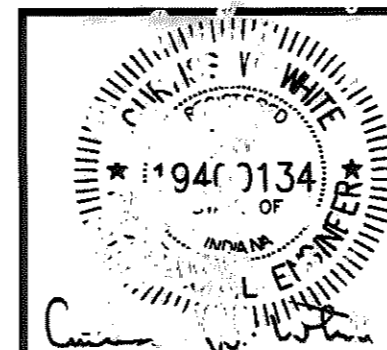

**COMMONWEALTH
 ENGINEERS, INC.**

DRAWN BY: CB
 DESIGNED BY: DAH
 CHECKED BY: DAH
 DATE: 1/04
 JOB NO: S02119-02
 SCALE: AS NOTED


SALAMONIE RESERVOIR
 WASTEWATER TREATMENT PLANT IMPROVEMENTS PROJECT
 PUBLIC WORK PROJECT NO. E031410M
 LABORATORY BUILDING
 ELEVATIONS

33-LAB-ELEV.DWG 48
 DRAWING NO.
A7
 33 OF 52


DOOR SCHEDULE

LOCATION	DOOR DATA							FRAME DATA					REMARKS				
	DOOR NUMBER	DOOR TYPE	M.O./R.O. WIDTH	M.O./R.O. HEIGHT	MATERIAL	DOOR WIDTH	DOOR HEIGHT	THICKNESS	LOUVER WINDOW	SIDE LITE	FRAME NUMBER	MATERIAL		DEPTH	HEAD DETAIL	JAMB DETAIL	SILL DETAIL
LABORATORY BUILDING	1	B	3'-4"	7'-4"	HOLLOW METAL	3'-0"	7'-0"	1 3/4"	Y		A	HOLLOW METAL	5 3/4"	1	2	3	1
	2	A	3'-4"	7'-4"	HOLLOW METAL	3'-0"	7'-0"	1 3/4"			A	HOLLOW METAL	5 3/4"	1 SIM.	2 SIM.	3 SIM.	2
	3	A	3'-4"	7'-4"	HOLLOW METAL	3'-0"	7'-0"	1 3/4"			A	HOLLOW METAL	5 3/4"	1 SIM.	2 SIM.	3 SIM.	3


NOTES:
1. ALL DOORS & FRAMES TO BE GALVANIZED.
2. ALL EXTERIOR DOORS SHALL BE INSULATED.

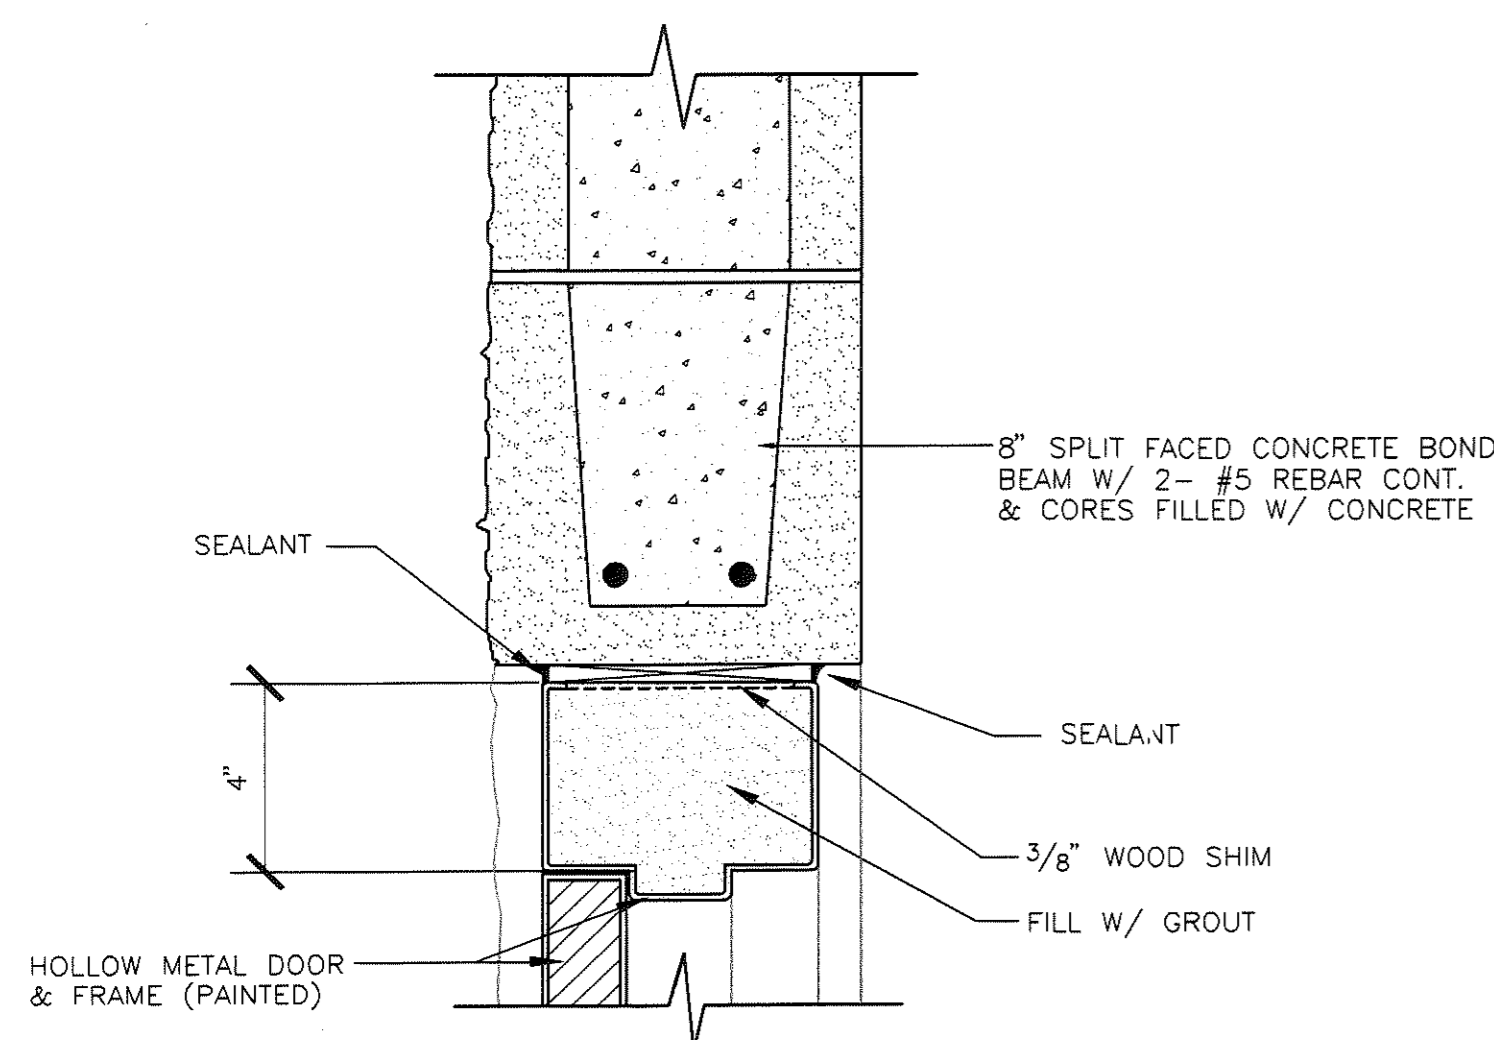


DOOR HEAD DETAIL 1
SCALE 3" = 1'-0"

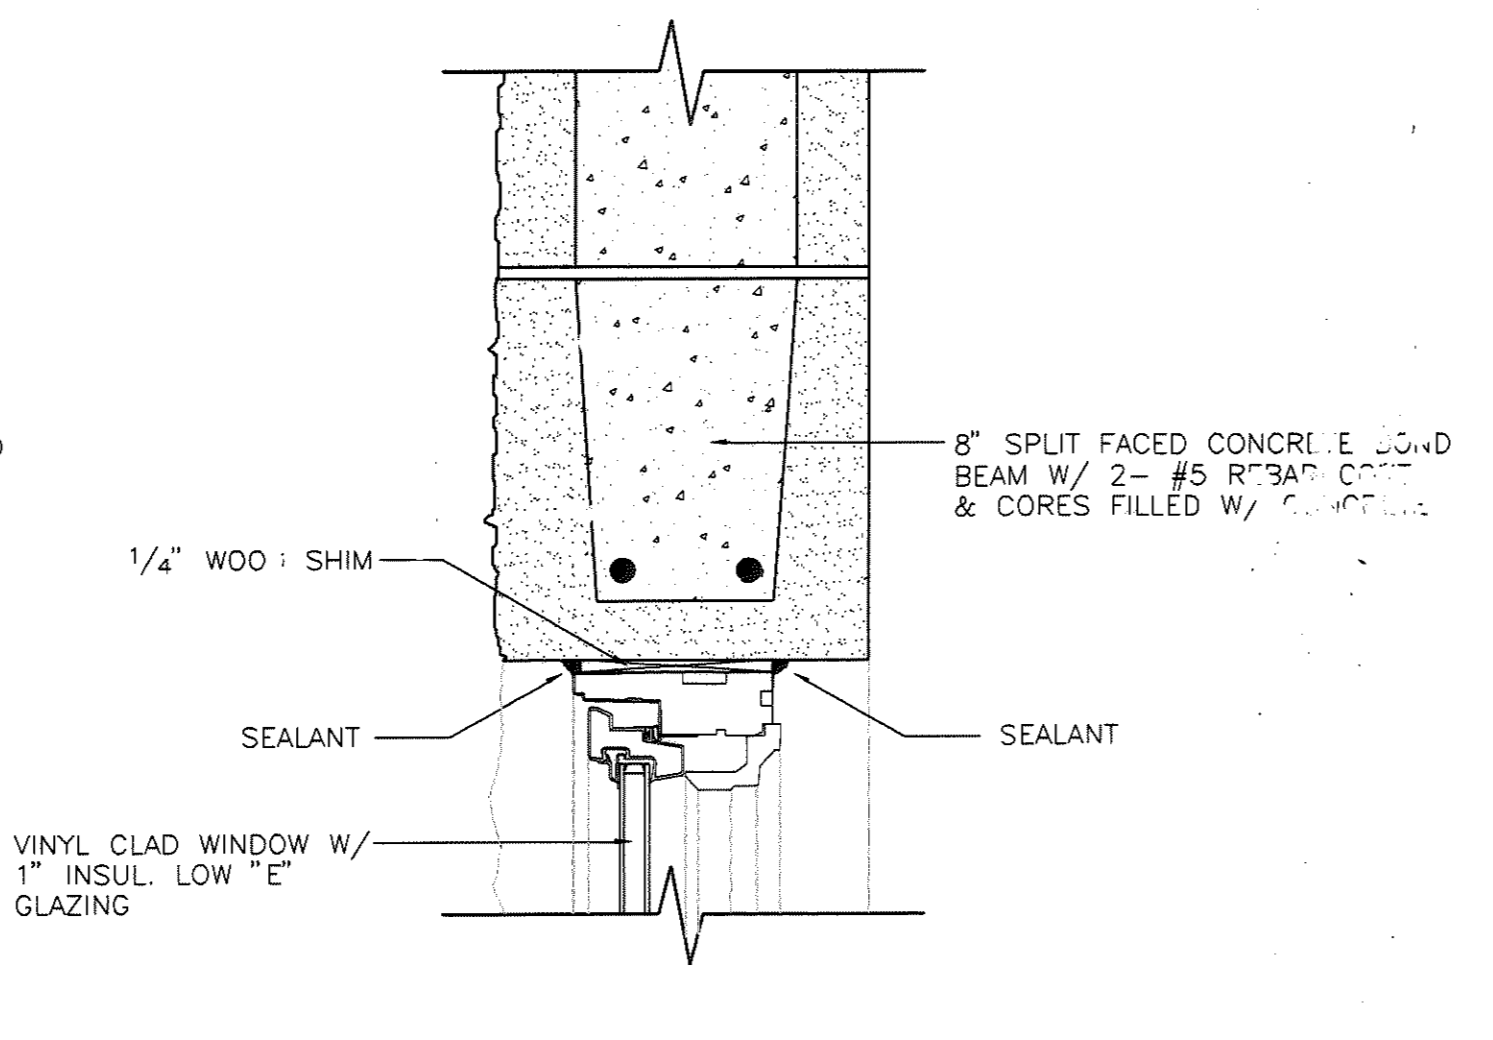

WINDOW HEAD DETAIL 4
SCALE 3" = 1'-0"

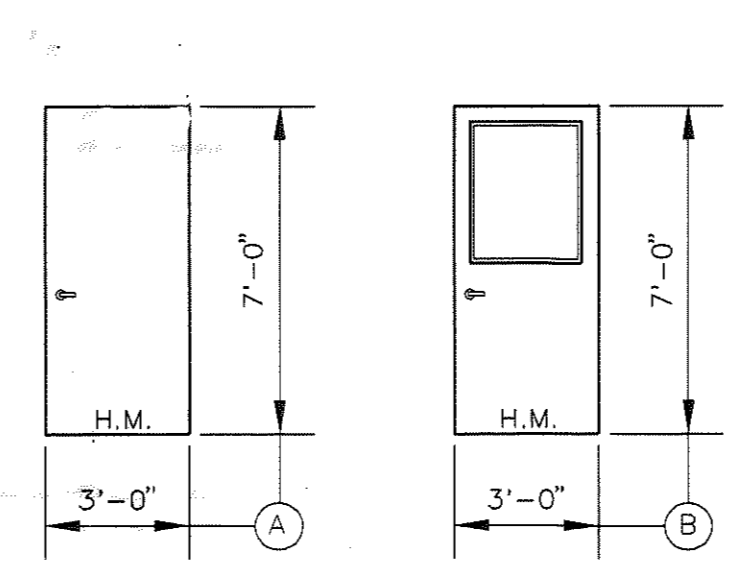

DOOR TYPE ELEVATION
1/4" = 1'-0"

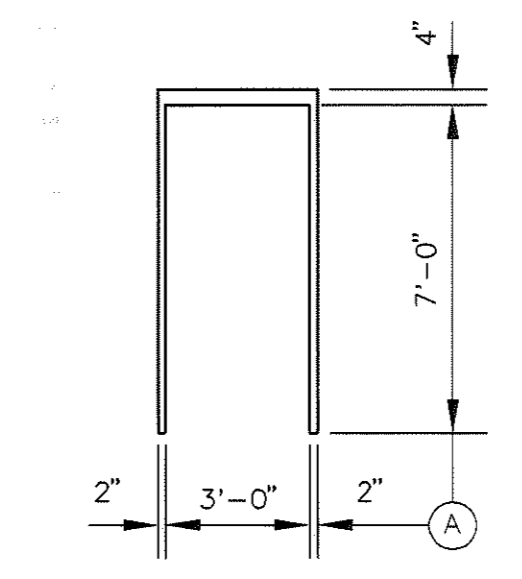


DOOR FRAME ELEVATIONS
1/4" = 1'-0"


WINDOW SCHEDULE

LOCATION	WINDOW DATA											REMARKS		
	WINDOW SYMBOL	QUANTITY	WINDOW TYPE	WIDTH	HEIGHT	R.O. WIDTH	R.O. HEIGHT	MATERIAL	SCREEN	GLAZING TYPE	HEAD DETAIL		JAMB DETAIL	SILL DETAIL
LABORATORY BUILDING	A	3	A	3'-4 3/4"	3'-4 13/16"	3'-5 1/4"	3'-5 3/8"	VINYL CLAD	Y	HIGH PERF. TEMPERED	4	5	6	PROVIDE SCREENS


WINDOW SCHEDULE REMARKS
1. TOP OF FRAME SHALL MATCH DOOR FRAME HEIGHT.

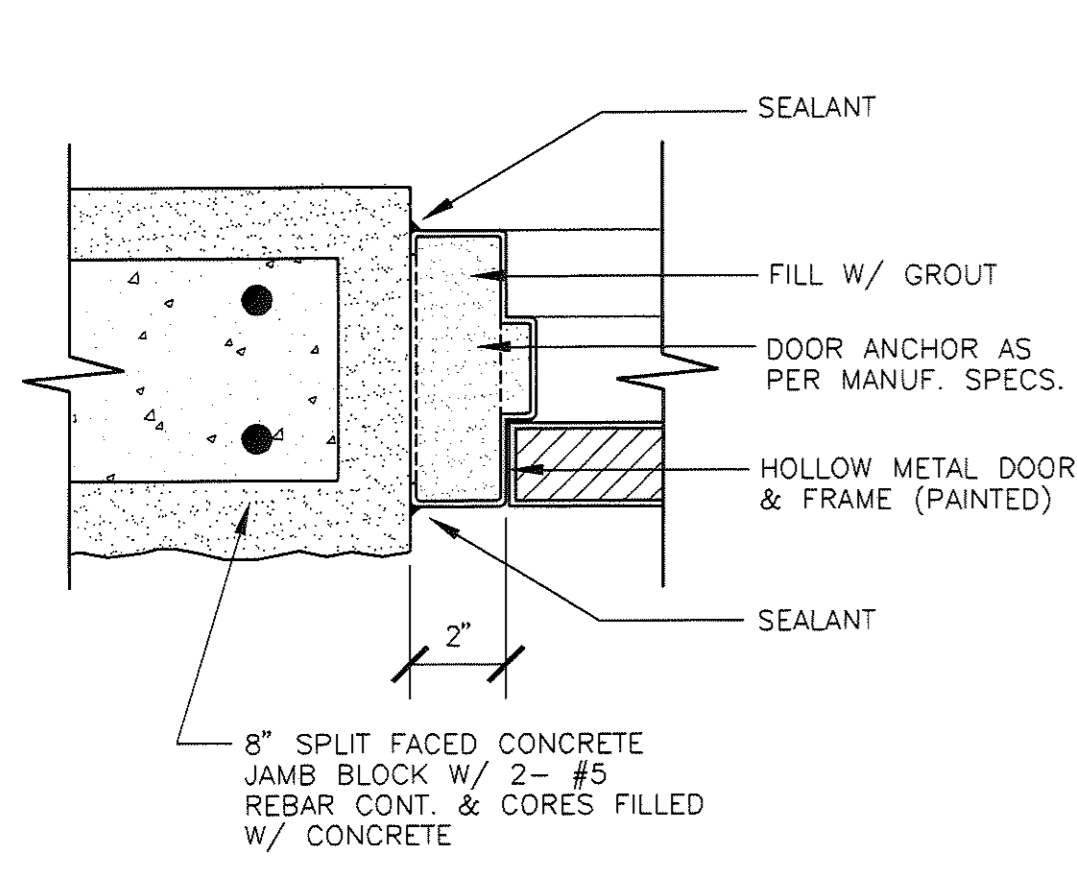


DOOR JAMB DETAIL 2
SCALE 3" = 1'-0"

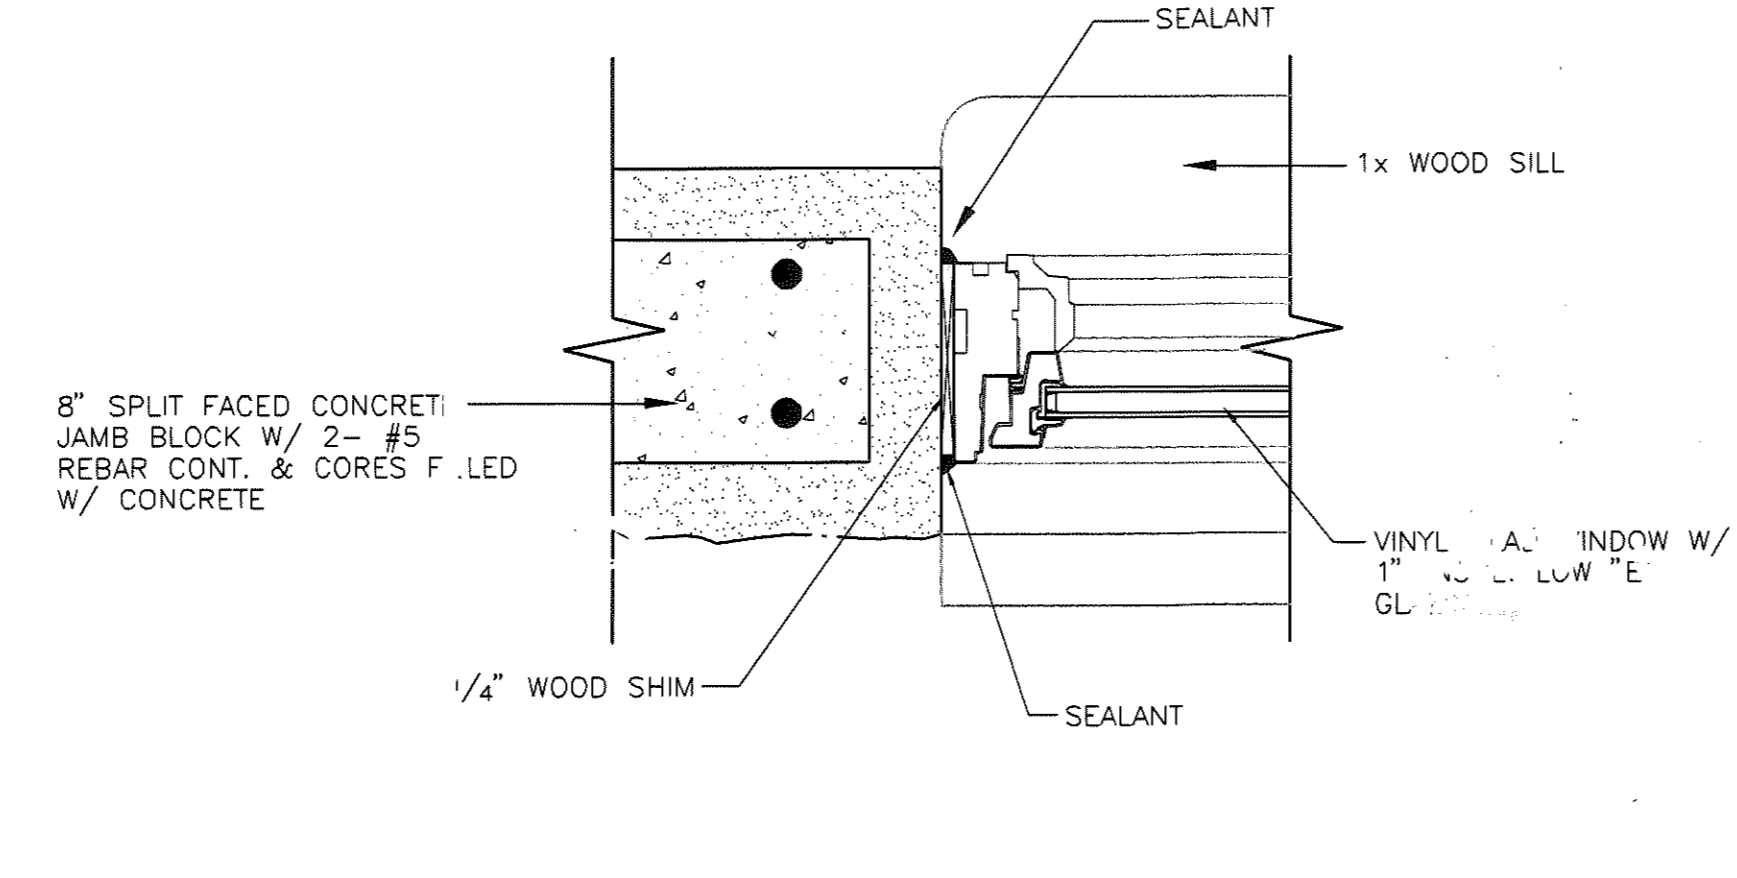


WINDOW JAMB DETAIL 5
SCALE 3" = 1'-0"

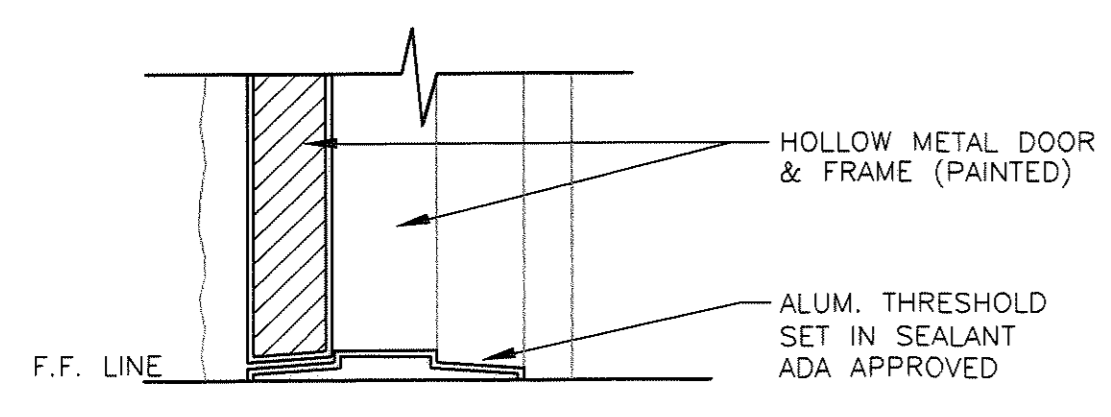

DOOR SILL DETAIL 3
SCALE 3" = 1'-0"

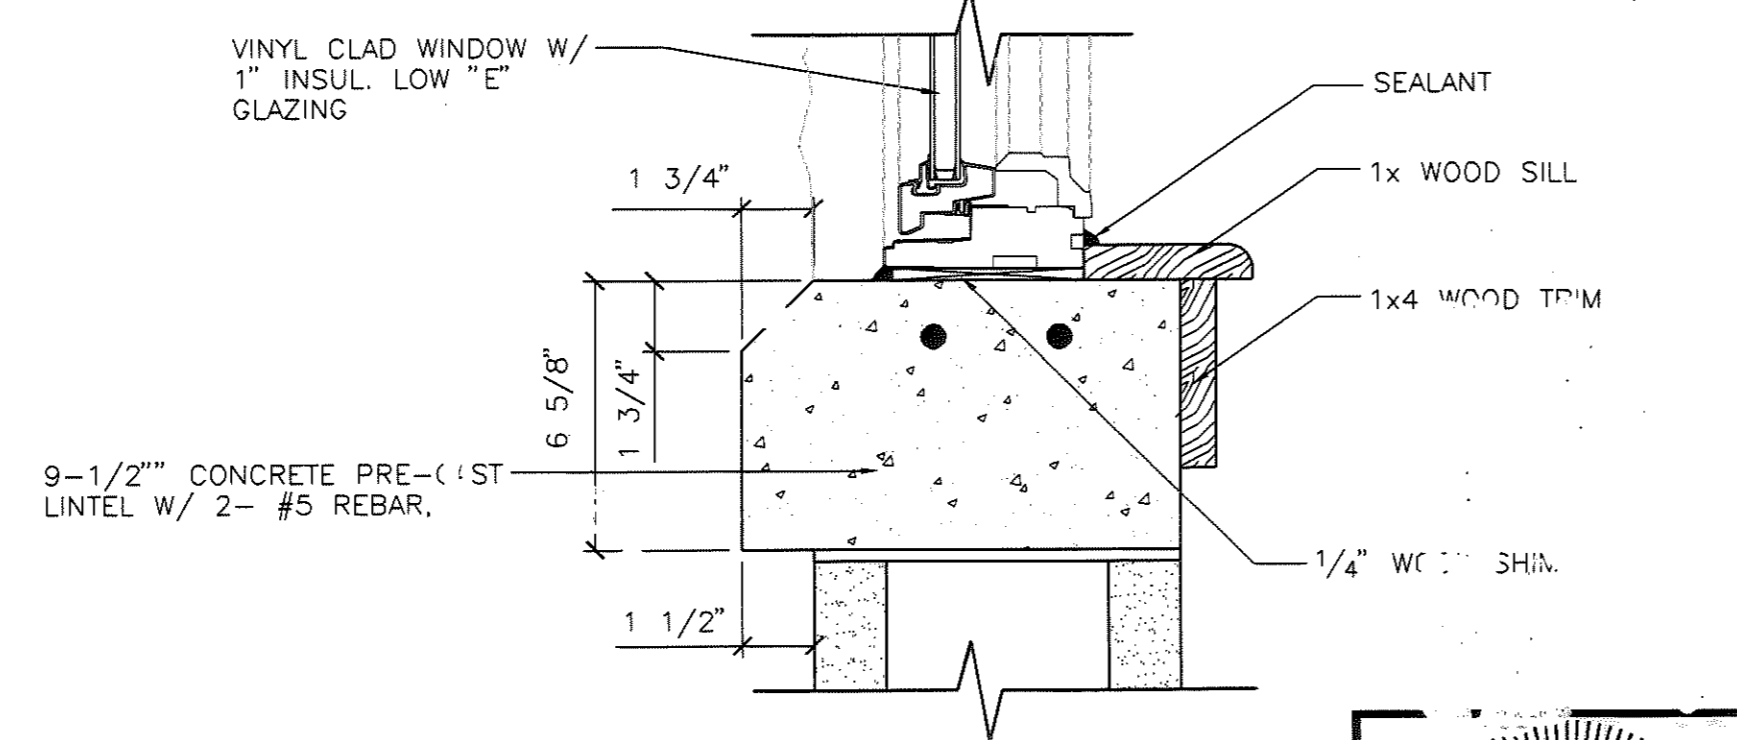


WINDOW SILL DETAIL 6
SCALE 3" = 1'-0"

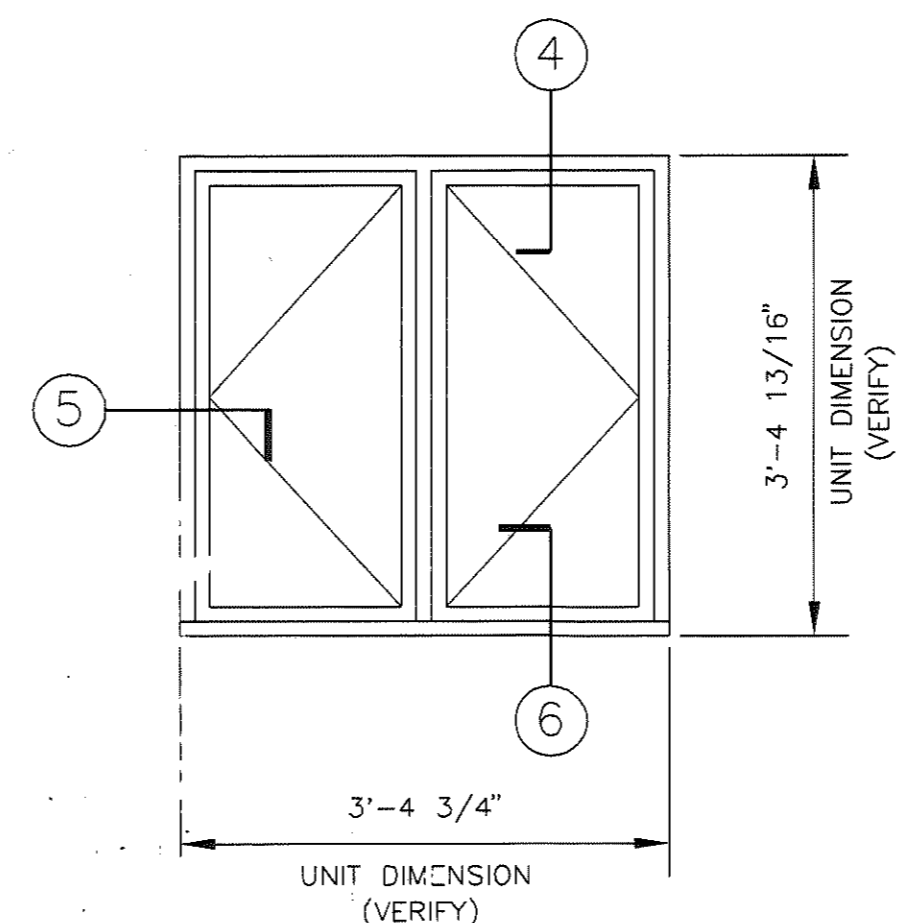

WINDOW ELEVATION
SCALE 3/4" = 1'-0"

REVISED "AS-BUILT" DRAWING
THIS DRAWING HAS BEEN REVISED IN ACCORDANCE WITH NOTES ON "RECORD DRAWINGS" FURNISHED BY THE CONTRACTOR AND WITH EXECUTED CHANGE ORDERS, TO THE BEST OF OUR KNOWLEDGE AND BELIEF, THIS DRAWING SHOWS ACTUAL "AS-BUILT" CONDITIONS.
COMMONWEALTH ENGINEERS, INC.
REVISED DATE 10/06
By JCW, ck. By CWV

34-LAB DOOR & WINDOW SCHED.dwg 4

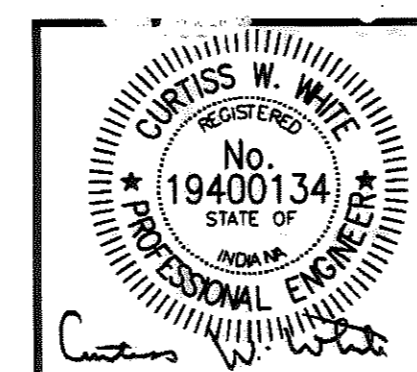


COMMONWEALTH ENGINEERS, INC.

DRAWN BY: DH
DESIGNED BY: DAH
CHECKED BY: DAH
DATE: 3/04
JOB NO: S02119-02
SCALE: AS NOTED

SALAMONIE RESERVOIR
WASTEWATER TREATMENT PLANT IMPROVEMENTS PROJECT
PUBLIC WORK PROJECT NO. E031410M
DOOR & WINDOW SCHEDULES & DETAILS


DRAWING NO.
A8
34 OF 52

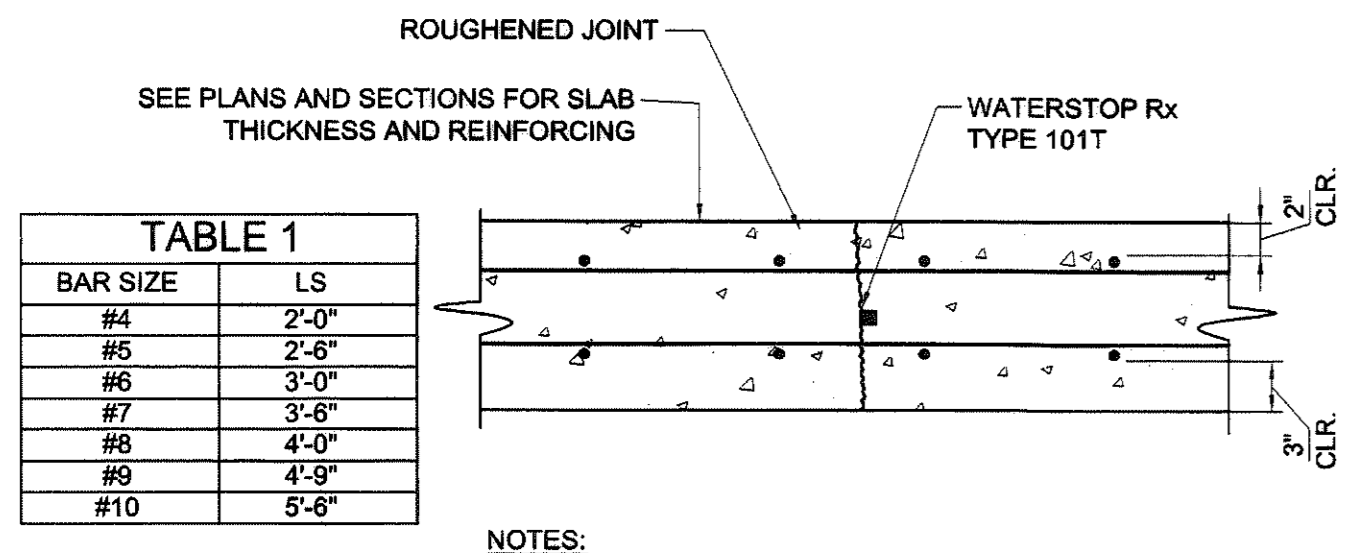

BAR SIZE	LS
#4	2'-0"
#5	2'-6"
#6	3'-0"
#7	3'-6"
#8	4'-0"
#9	4'-9"
#10	5'-6"

- NOTES:
1. ALL REINFORCING TO BE CONTINUOUS THRU JOINT.
 2. CONSTRUCTION JOINT SPACING NOT TO EXCEED 75'-0".
 3. SEE SOIL REPORT FOR UNDERSLAB PREPARATION AND COMPACTION.
 4. SEE TABLE 1 FOR LAP SPICE (LS) REQUIREMENTS.


TYPICAL BASE SLAB CONSTRUCTION JOINT (4)
SCALE: 1" = 1'-0"

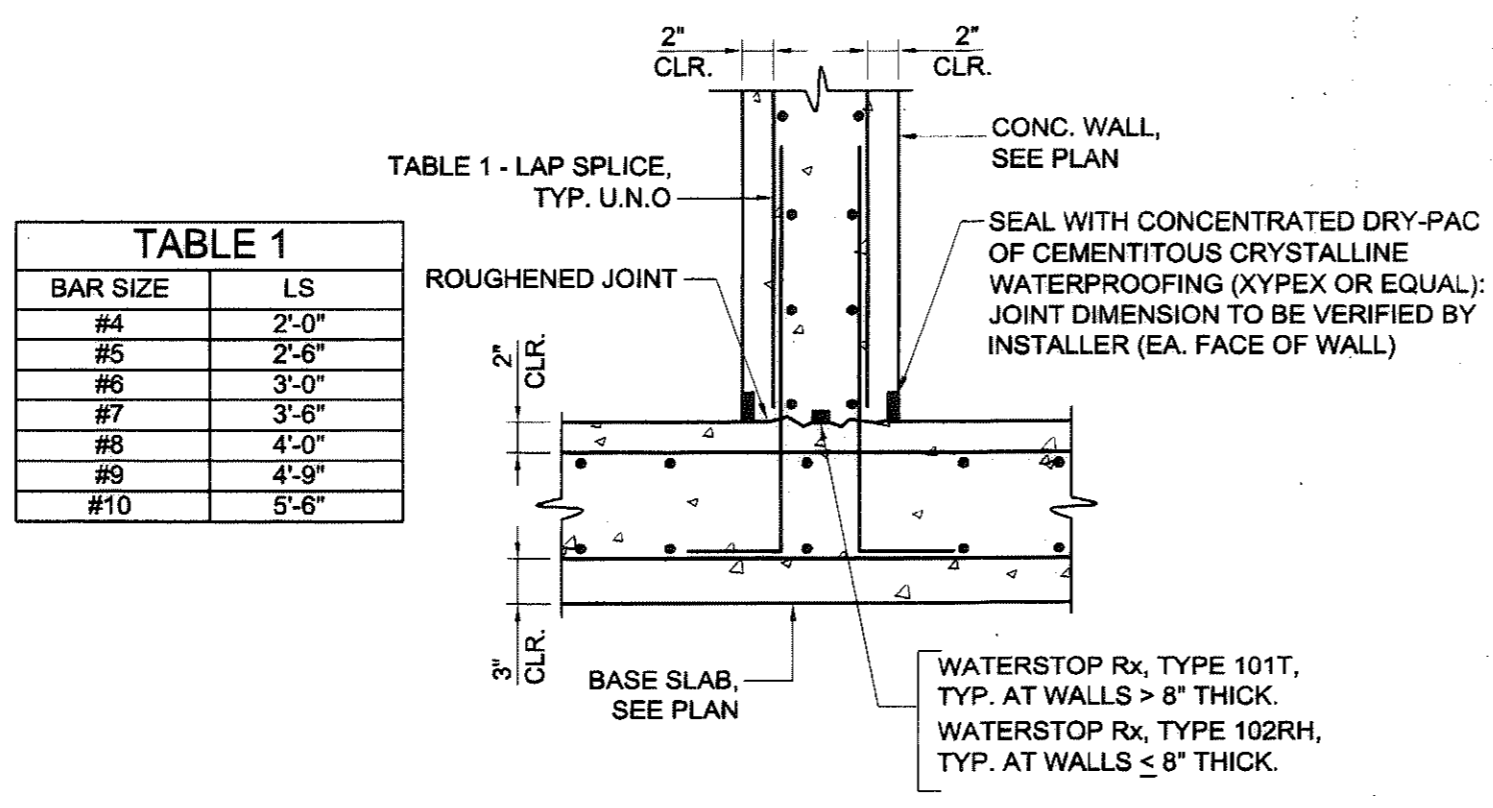

BAR SIZE	LS
#4	2'-0"
#5	2'-6"
#6	3'-0"
#7	3'-6"
#8	4'-0"
#9	4'-9"
#10	5'-6"

- NOTES:
1. ALL REINFORCING TO BE CONTINUOUS THRU JOINT.
 2. CONSTRUCTION JOINT SPACING NOT TO EXCEED 75'-0".
 3. SEE SOIL REPORT FOR UNDERSLAB PREPARATION AND COMPACTION.
 4. SEE TABLE 1 FOR LAP SPICE (LS) REQUIREMENTS.


TYPICAL WALL TO BASE SLAB (3)
SCALE: 1" = 1'-0"

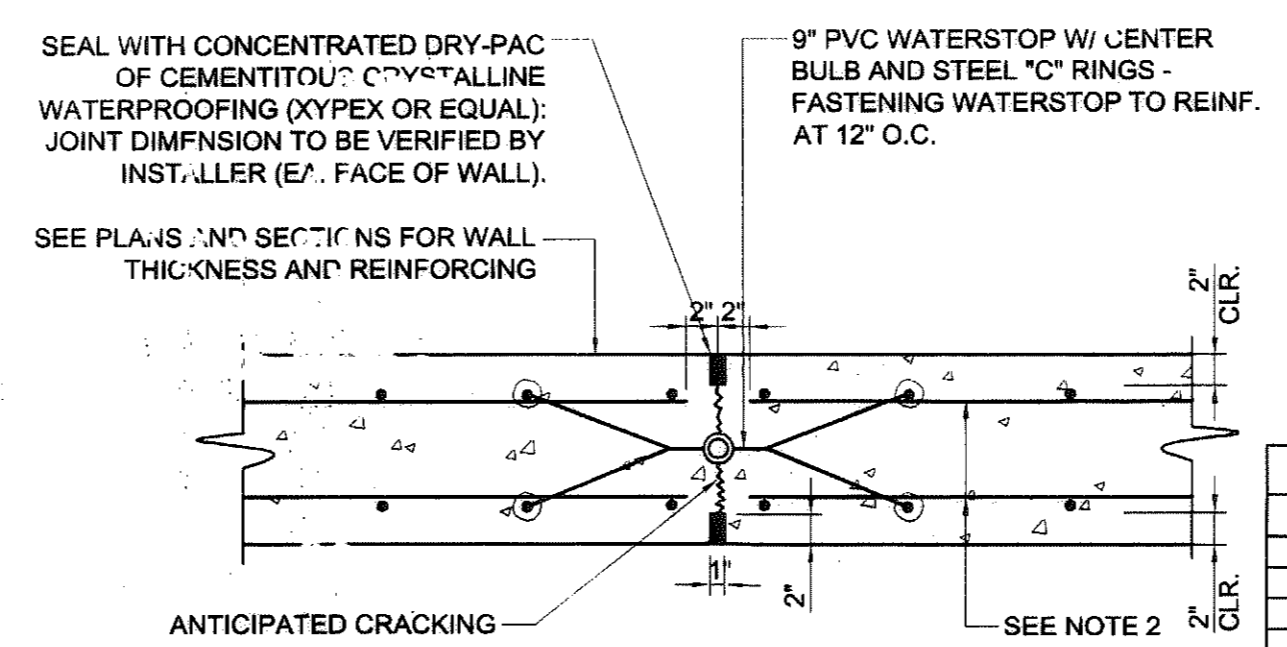

BAR SIZE	LS
#4	2'-0"
#5	2'-6"
#6	3'-0"
#7	3'-6"
#8	4'-0"
#9	4'-9"
#10	5'-6"

- NOTES:
1. CONTRACTION JOINTS SHALL BE LOCATED AT JOINTS MARKED CT.
 2. WATERSTOPS REQUIRED AT WATER RETAINING WALLS ONLY.
 3. UNLESS NOTED OTHERWISE, CONTRACTION JOINT SPACING NOT TO EXCEED 75 FEET.
 4. 50% OF THE HOIRZ. REINF. STEEL SHALL BE CONTINUOUS THRU JOINT. HORIZONTAL BARS THAT STOP SHORT OF JOINT SHALL BE FABRICATED ACCORDINGLY AND SHALL NOT BE FIELD CUT. CONTINUOUS AND DISCONTINUOUS HORIZ. BARS SHALL BE ALTERNATED ALONG WALL HEIGHT.
 5. SEE SPECIFIC DETAILS AT NOTED STRUCTURES WHERE 100% OF HORIZONTAL REINFORCING STEEL IS CONTINUOUS THRU JOINT.
 6. CONTRACTION JOINTS SHALL NOT OCCUR WITHIN 5'-0" OF A CORNER.
 7. SEE TABLE 1 FOR LAP SPICE (LS) REQUIREMENTS.


TYPICAL WALL CONTRACTION JOINT (2)
SCALE: 1" = 1'-0"

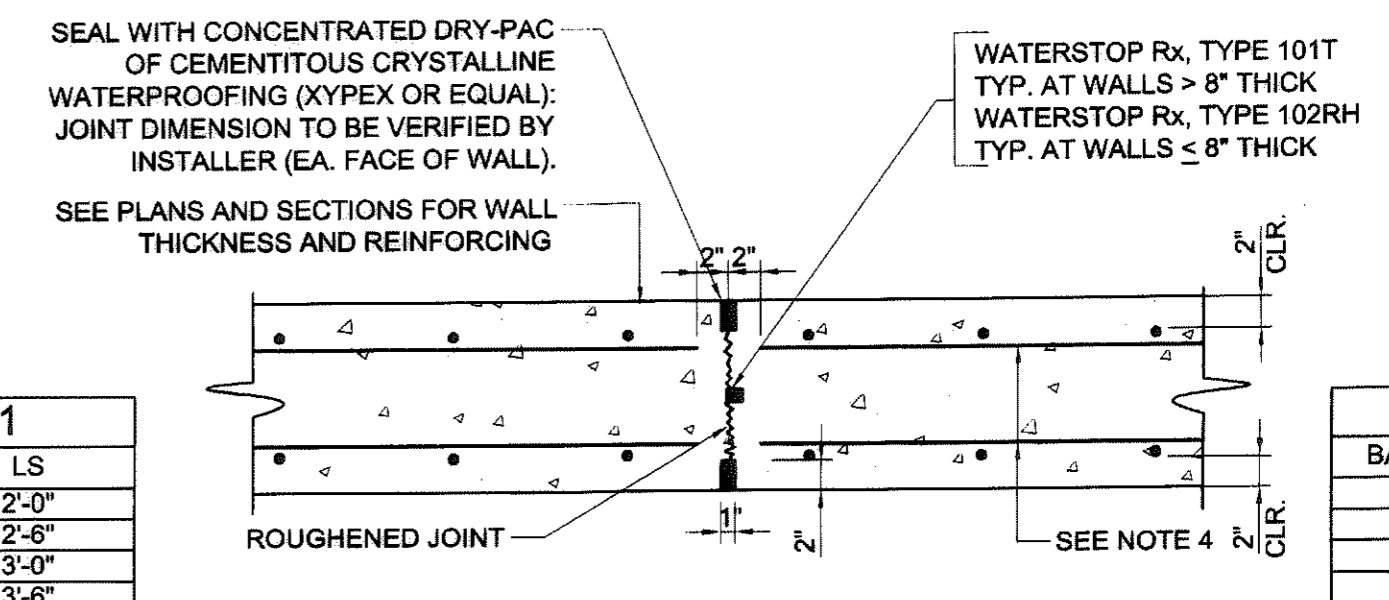


BAR SIZE	LS
#4	2'-0"
#5	2'-6"
#6	3'-0"
#7	3'-6"
#8	4'-0"
#9	4'-9"
#10	5'-6"

- NOTES:
1. CONSTRUCTION JOINTS SHALL BE LOCATED AT JOINTS MARKED CJ.
 2. WATERSTOP REQUIRED AT WATER RETAINING WALLS ONLY.
 3. UNLESS NOTED OTHERWISE, CONSTRUCTION JOINT SPACING NOT TO EXCEED 75 FEET.
 4. 50% OF THE HOIRZ. REINF. STEEL SHALL BE CONTINUOUS THRU JOINT. HORIZONTAL BARS THAT STOP SHORT OF JOINT SHALL BE FABRICATED ACCORDINGLY AND SHALL NOT BE FIELD CUT. CONTINUOUS AND DISCONTINUOUS HORIZ. BARS SHALL BE ALTERNATED ALONG WALL HEIGHT.
 5. SEE SPECIFIC DETAILS AT NOTED STRUCTURES WHERE 100% OF THE HORIZONTAL REINFORCING STEEL IS CONTINUOUS THRU JOINT.
 6. CONSTRUCTION JOINTS SHALL NOT OCCUR WITHIN 5'-0" OF A CORNER.
 7. SEE TABLE 1 FOR LAP SPICE (LS) REQUIREMENTS.

TYPICAL WALL CONSTRUCTION JOINT (1)
SCALE: 1" = 1'-0"

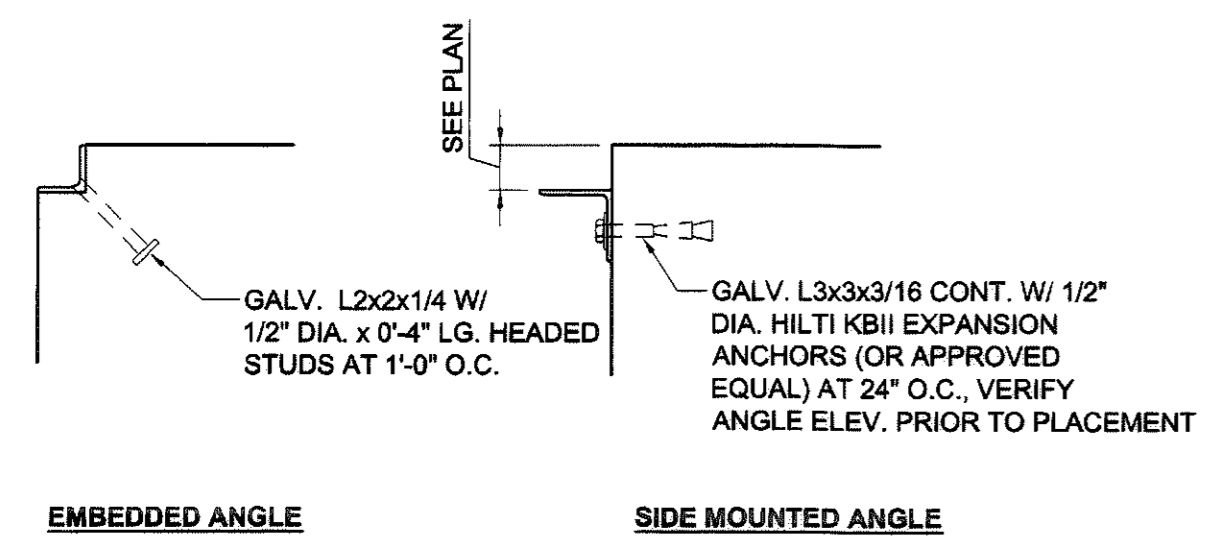


TYPICAL GRATING SUPPORT (8)
SCALE: 1-1/2" = 1'-0"

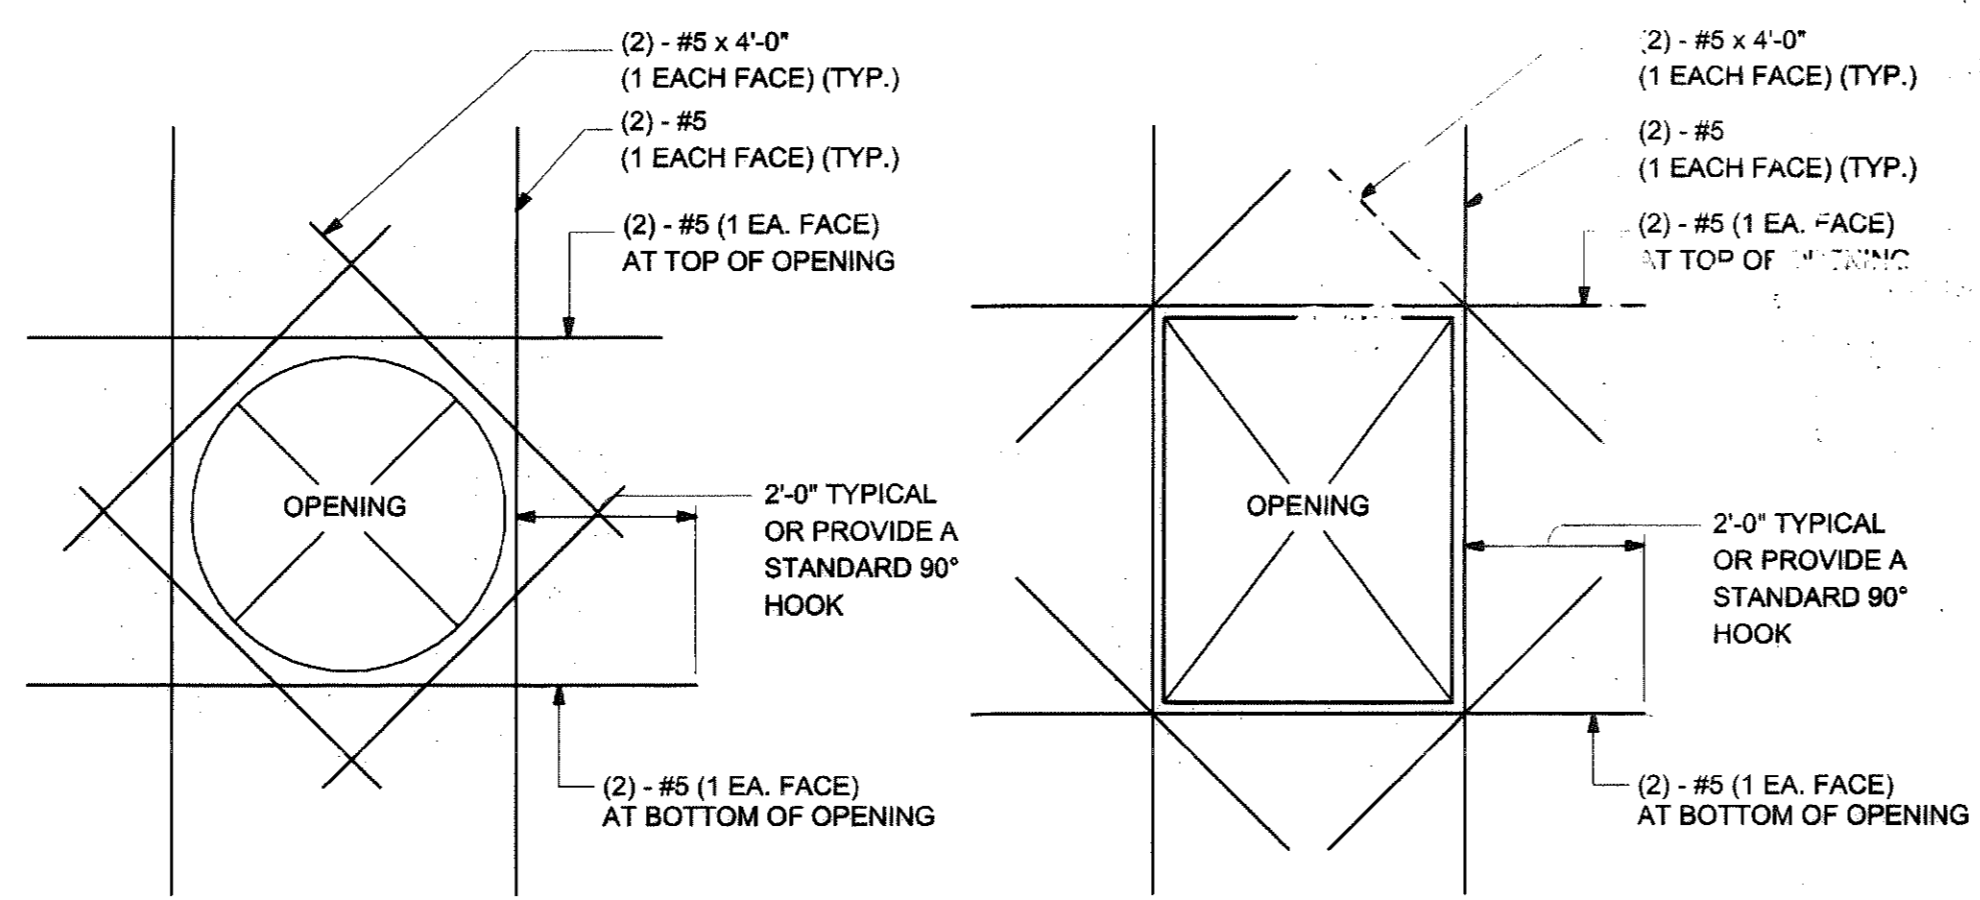

- NOTES:
1. WHERE VERTICAL REINFORCING IS INTERRUPTED BY THE OPENING, ONE HALF THE INTERRUPTED STEEL SHALL BE ADDED EACH SIDE OF OPENING. USE FULL LENGTH BARS.
 2. THIS DETAIL APPLIES TO ALL OPENINGS IN CONCRETE WALLS UNLESS DEFINED OTHERWISE ON THE PLANS.


TYPICAL OPENING IN CONCRETE WALLS (7)
NO SCALE

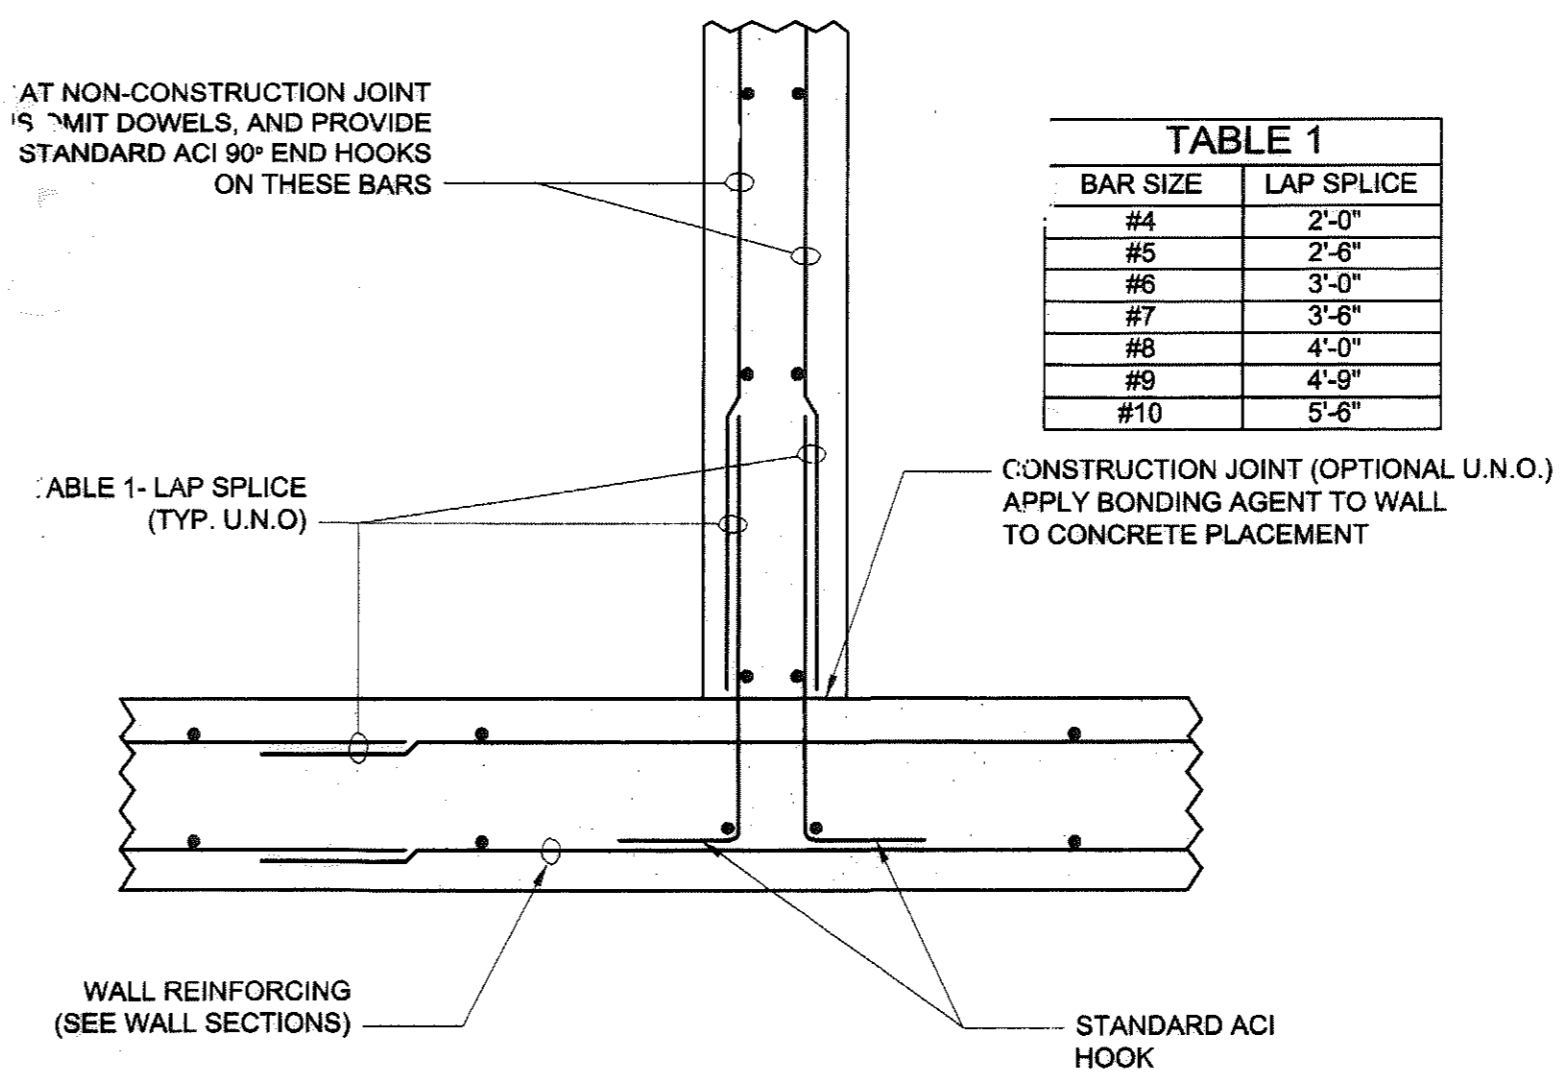

BAR SIZE	LAP SPICE
#4	2'-0"
#5	2'-6"
#6	3'-0"
#7	3'-6"
#8	4'-0"
#9	4'-9"
#10	5'-6"

- NOTES:
1. SEE WALL SECTIONS FOR TYPICAL WALL REINFORCING (SIZE AND SPACING).
 2. SEE GENERAL NOTES AND/OR WALL SECTIONS FOR REINFORCING STEEL CLEARANCES.


TYPICAL CONCRETE WALL INTERSECTION (6)
NO SCALE

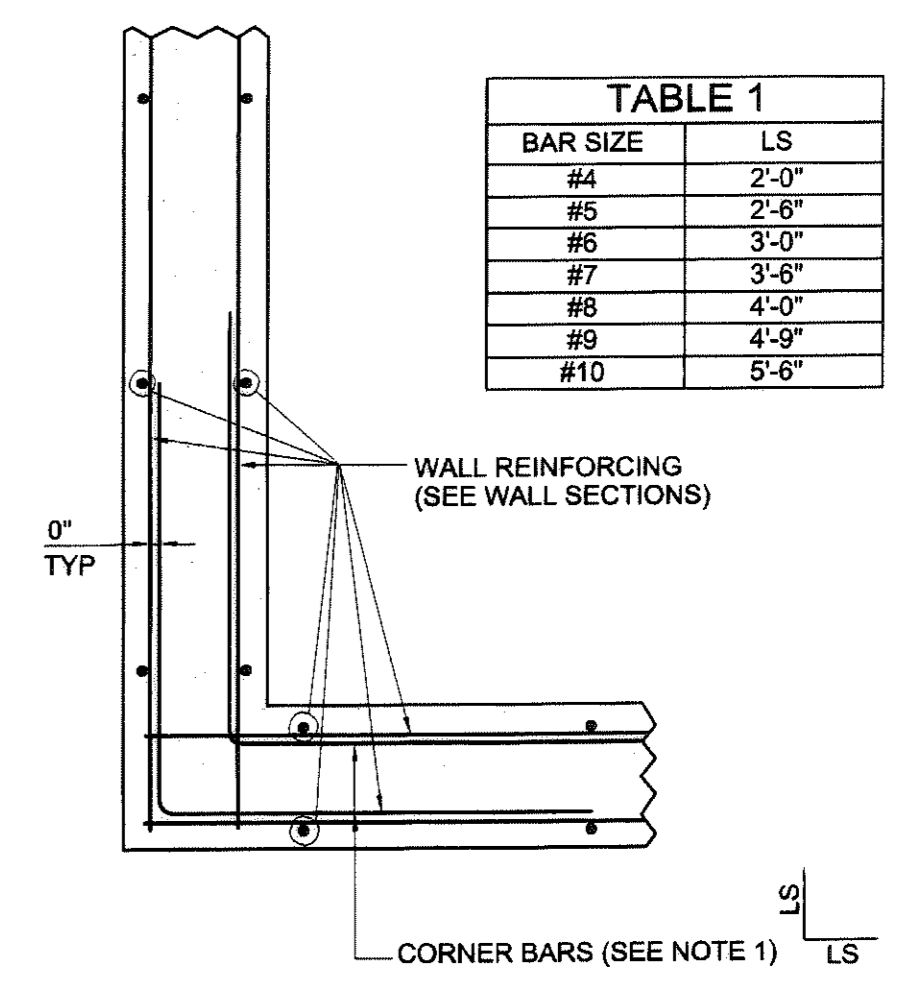

BAR SIZE	LS
#4	2'-0"
#5	2'-6"
#6	3'-0"
#7	3'-6"
#8	4'-0"
#9	4'-9"
#10	5'-6"

- NOTES:
1. PROVIDE CORNER BARS AS SHOWN, MATCH HORIZONTAL WALL REINFORCING (SIZE AND SPACING). SEE TABLE 1 FOR LS DIM.
 2. TERMINATE HORIZONTAL WALL REINFORCING 2" CLEAR FROM END OF WALL (TYPICAL U.C. 4).

TYPICAL CONCRETE WALL CORNER REINFORCEMENT - PLAN VIEW (5)
NO SCALE

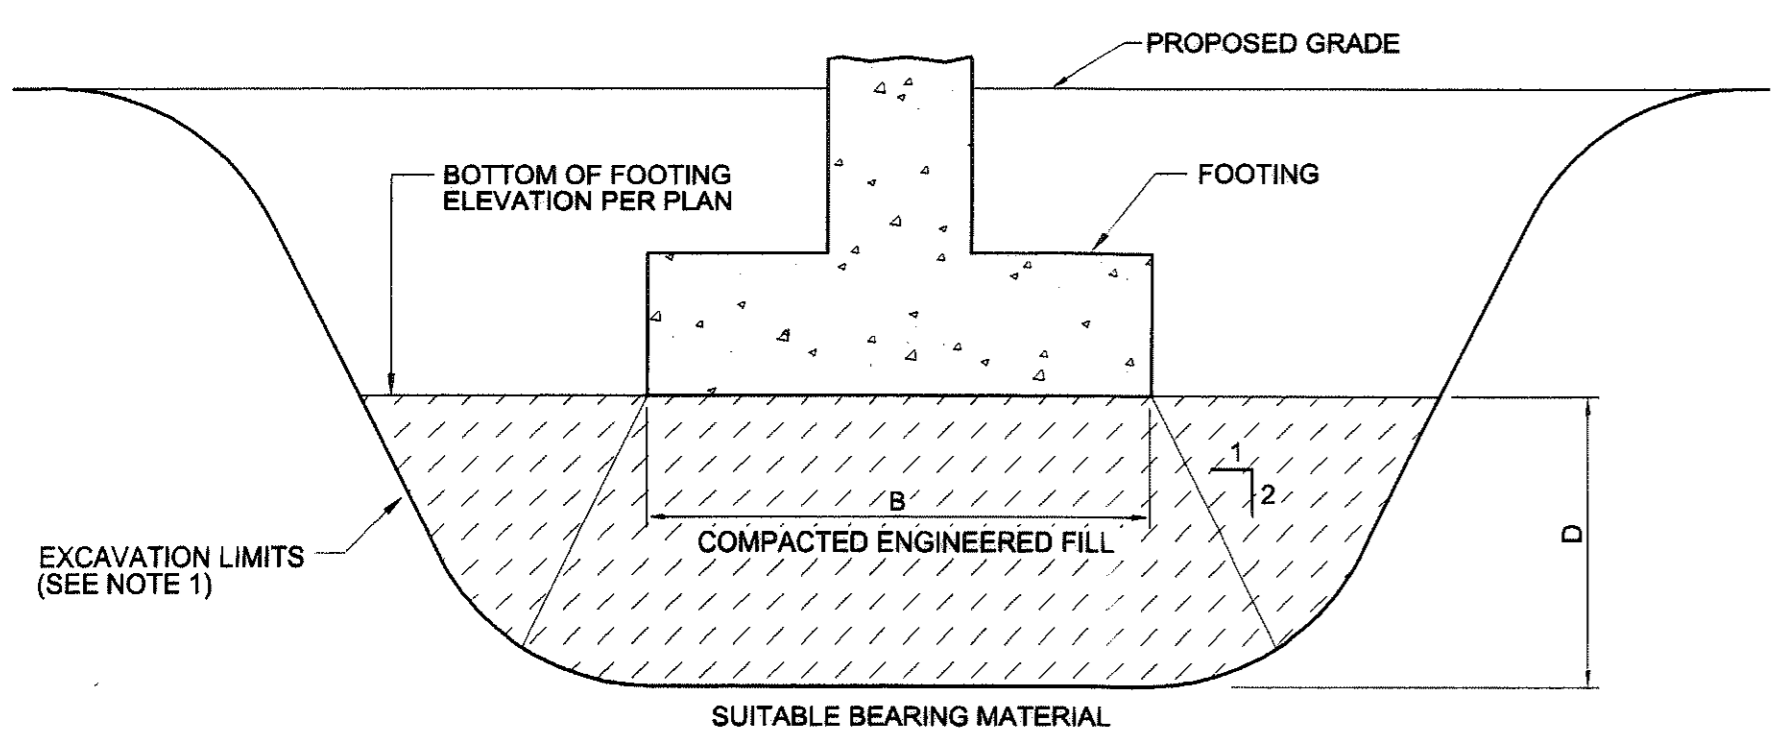

- NOTES:
1. DEWATER EXCAVATION AS REQUIRED.
 2. WIDTH OF EXCAVATION SHALL EQUAL WIDTH OF FOOTING PLUS DEPTH OF UNDERCUT (W=B+D)

TYPICAL FOOTING IN UNDERCUT AREA (9)
NO SCALE

REVISED "AS-BUILT" DRAWING


THIS DRAWING HAS BEEN REVISED IN ACCORDANCE WITH NOTES ON "RECORD DRAWINGS" FURNISHED BY THE CONTRACTOR AND WITH EXECUTED CHANGE ORDERS. TO THE BEST OF OUR KNOWLEDGE AND BELIEF, THIS DRAWING SHOWS ACTUAL "AS-BUILT" CONDITIONS.

COMMONWEALTH ENGINEERS, INC. REVISED DATE 10/06
BY JEW. CK. BY [Signature]

COPYRIGHT NOTICE: THIS ENGINEERING DRAWING IS GIVEN IN CONFIDENCE AND SHALL BE USED ONLY PURSUANT TO THE AGREEMENT WITH CE SOLUTIONS, INC. NO OTHER USE, DISSEMINATION OR DUPLICATION MAY BE MADE WITHOUT PRIOR WRITTEN CONSENT OF CE SOLUTIONS, INC. ALL COMMON LAW RIGHTS OF COPYRIGHT AND OTHERWISE ARE HEREBY SPECIFICALLY RESERVED.
CE SOLUTIONS, INC. PROJ. NO. 03-113

CE Solutions, Inc.
Structural Engineers

10 Shoobone Drive, Suite 100
Carmel, Indiana 46032
317-818-1912

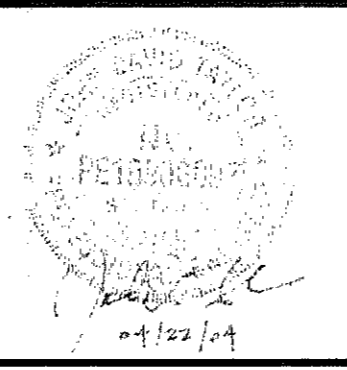

COMMONWEALTH ENGINEERS, INC.

DRAWN BY: KDD
DESIGNED BY: DT
CHECKED BY: JDT
DATE: 04/21/04
JOB NO: S02119-02
SCALE: AS NOTED

SALAMONIE RESERVOIR
WASTEWATER TREATMENT FACILITIES IMPROVEMENTS PROJECT

PUBLIC WORKS PROJECT NO. E031410M


TYPICAL DETAILS

DRAWING NO.
52
36 OF 52


301-63

PLAN NOTES:

1. SEE SHEET S1 FOR GENERAL STRUCTURAL NOTES.
2. SEE SHEET S2 FOR TYPICAL DETAILS.
3. GENERAL CONTRACTOR TO COORDINATE ALL OPENINGS, PIPE SLEEVES, EMBED ITEMS, HANDRAILS, GRATING, ETC. WITH PROCESS DRAWINGS.
4. ALL DIMENSIONS AND ELEVATIONS SHALL BE VERIFIED PRIOR TO FABRICATION, CONSTRUCTION OR ERECTION. THE GENERAL CONTRACTOR SHALL ASSUME RESPONSIBILITY FOR ANY DISCREPANCIES.
5. SEE SITE PLAN FOR ALL FINAL GRADE ELEVATIONS.
6. SEE GEOTECHNICAL REPORT FOR ALL BACKFILLING AND COMPACTION REQUIREMENTS BEHIND WALLS AND UNDER BASE SLABS.

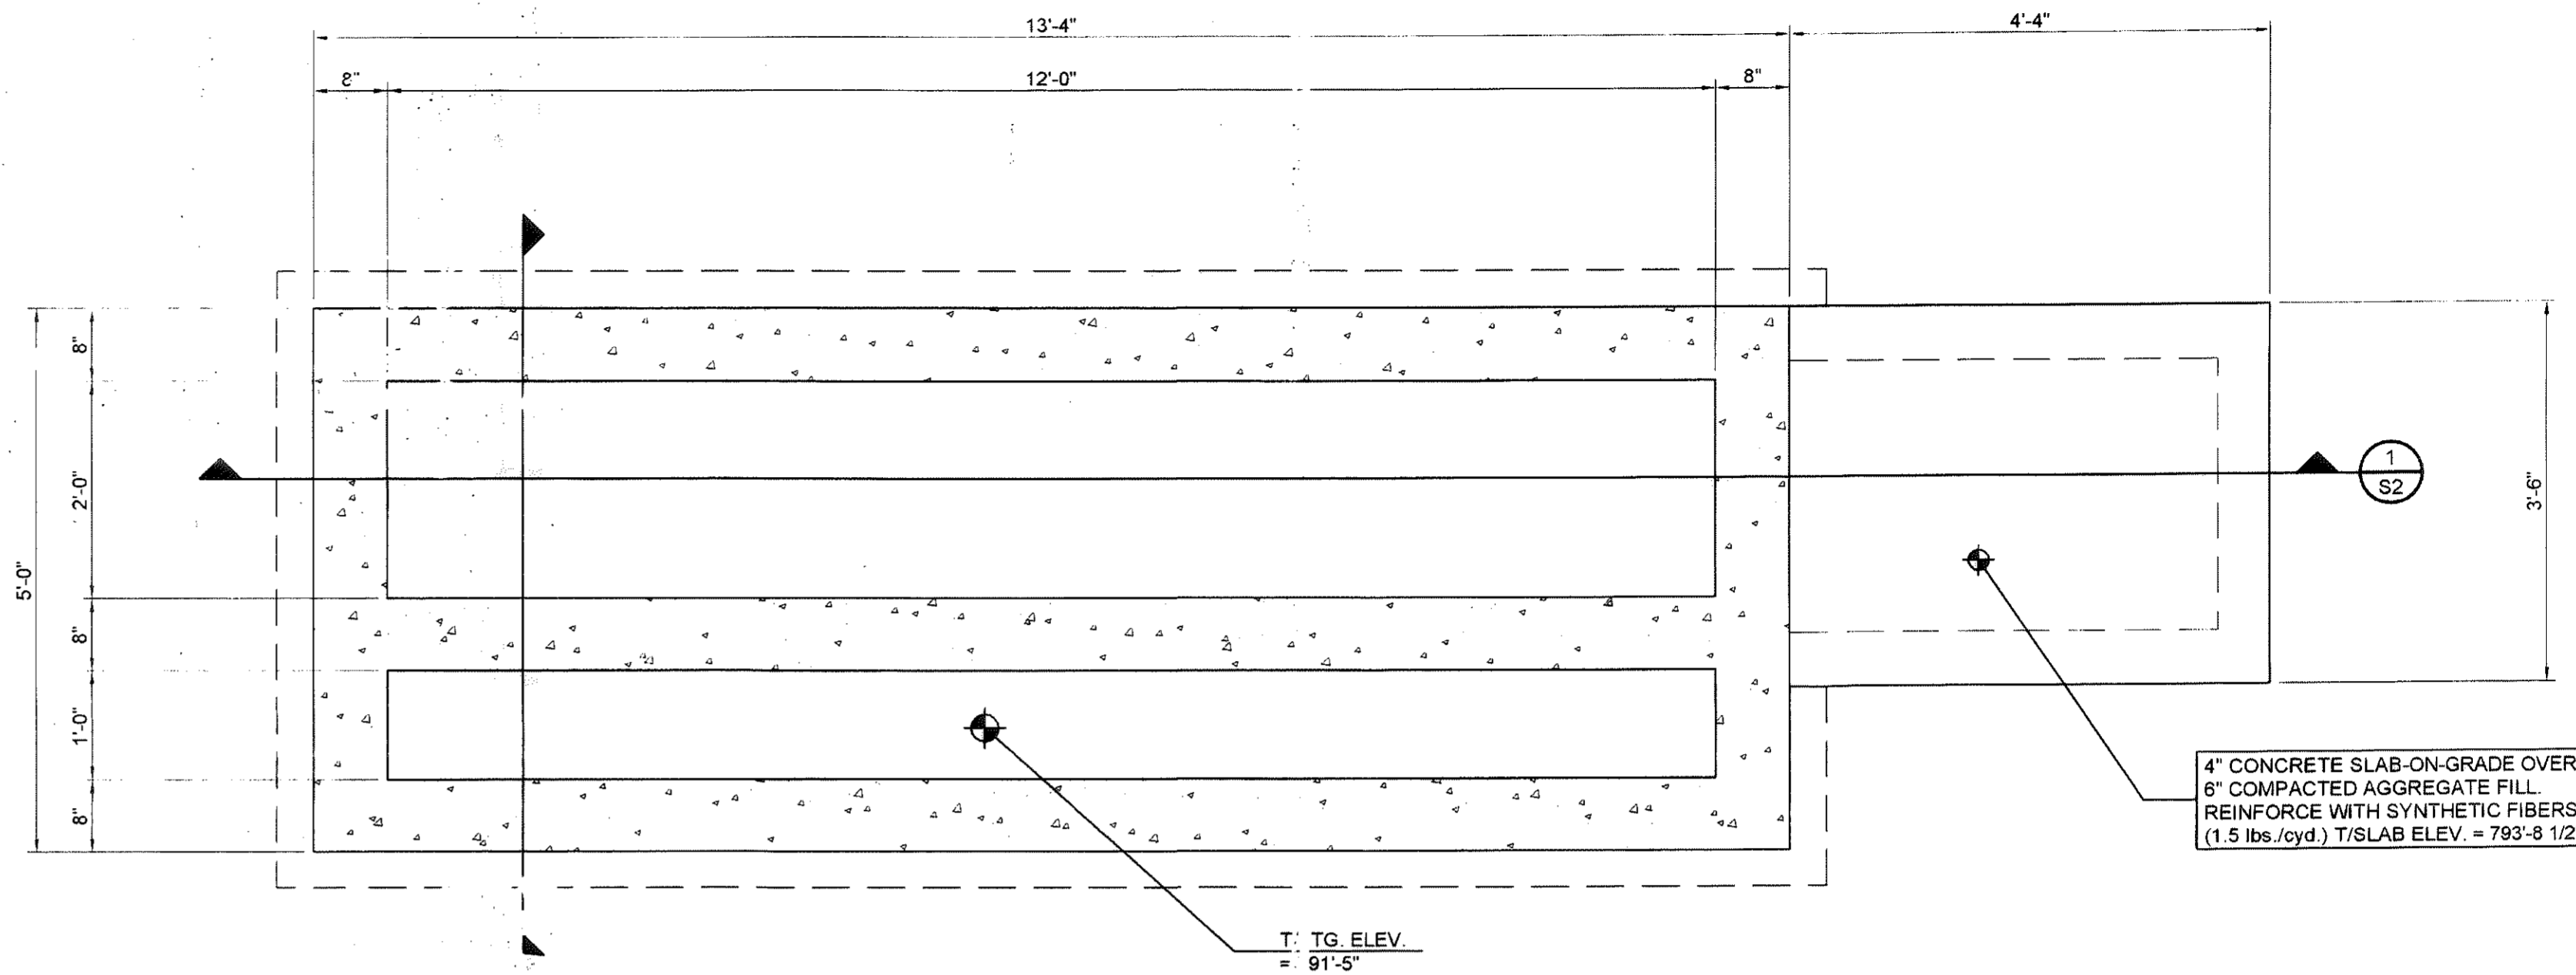

**HEADWORKS STRUCTURE
FOUNDATION / SLAB PLAN**
SCALE: 3/4"=1'-0"

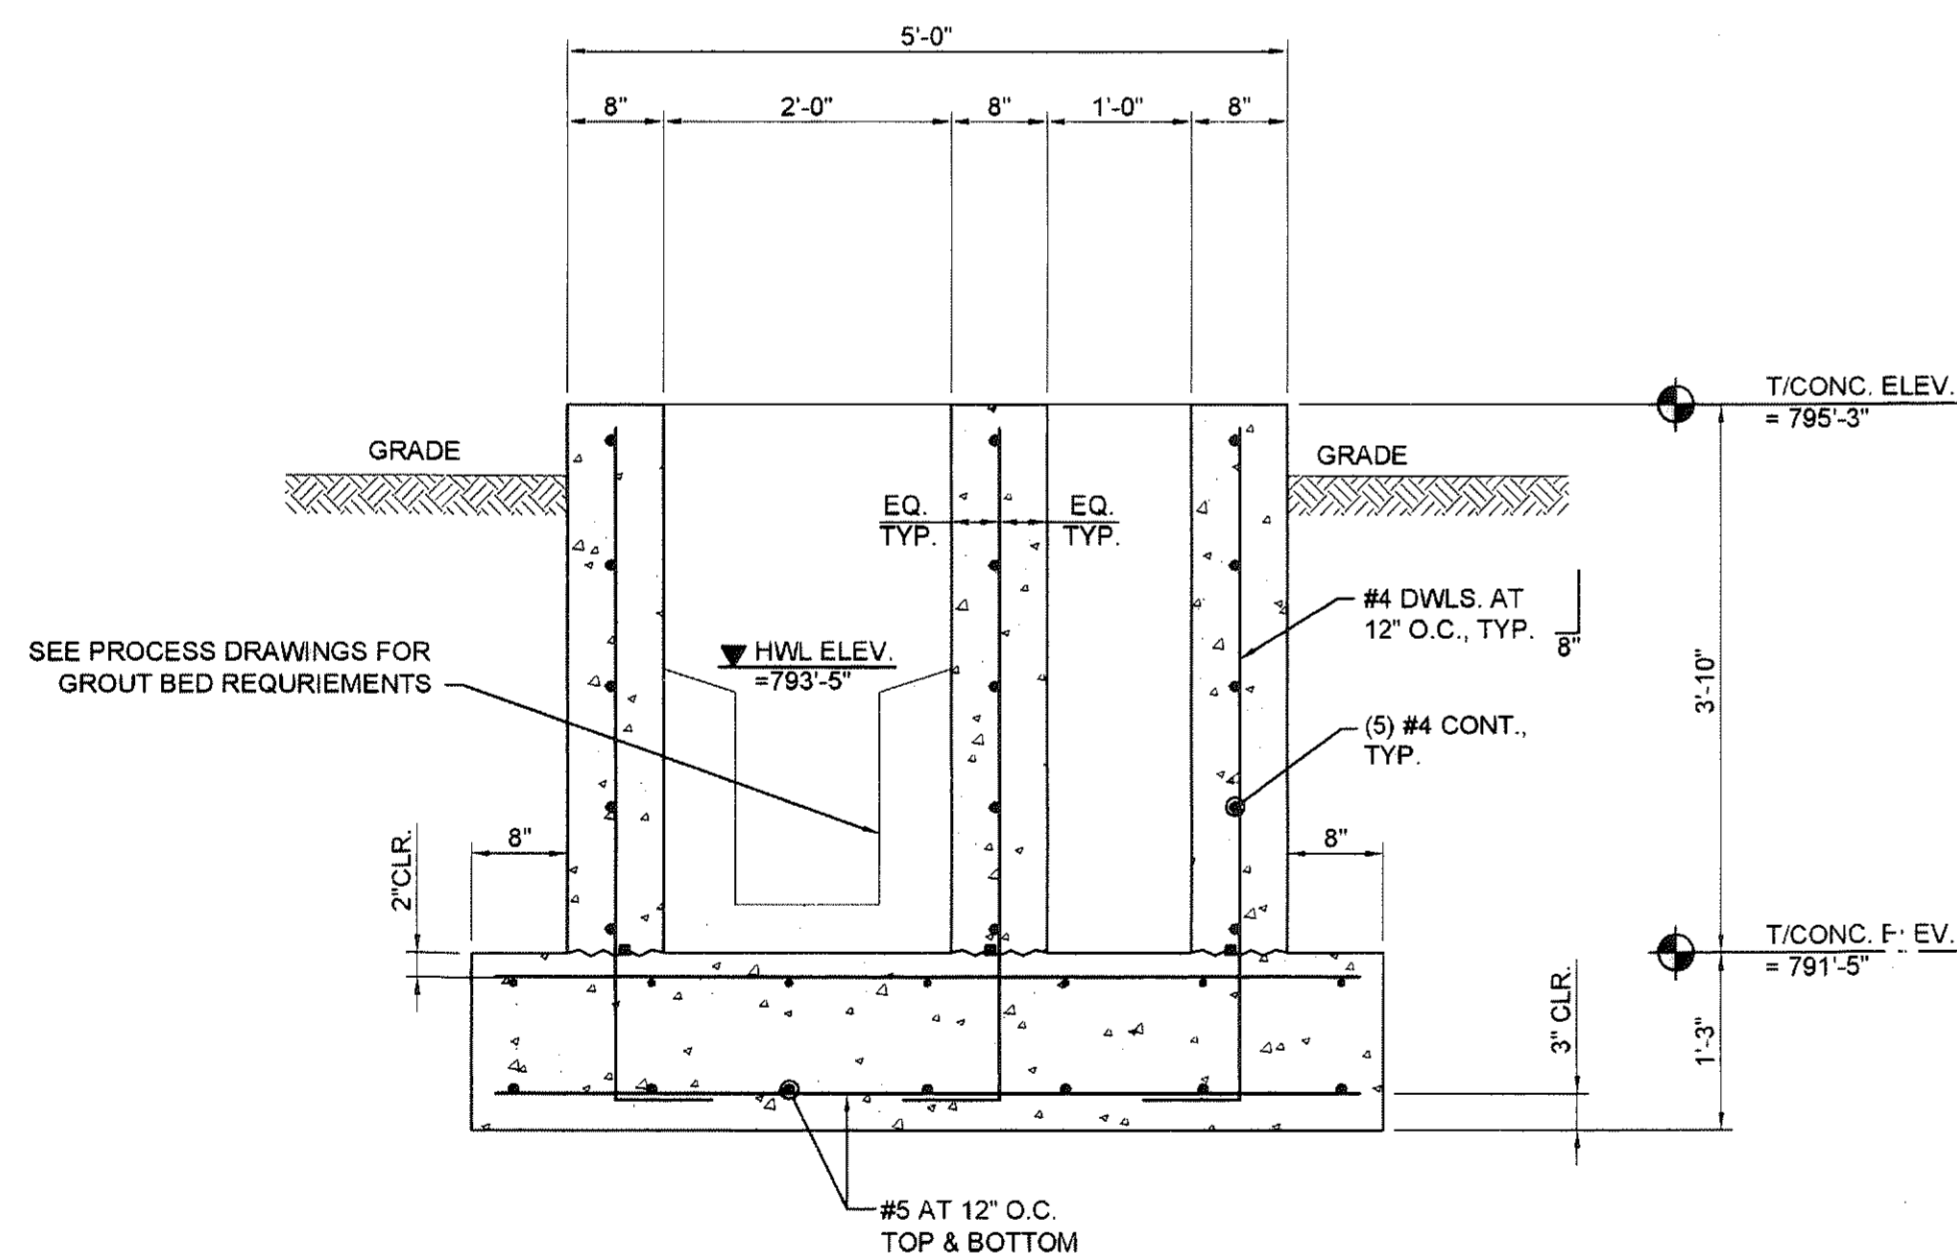


SECTION 2
SCALE: 3/4"=1'-0"

REVISED "AS-BUILT" DRAWING

THIS DRAWING HAS BEEN REVISED IN ACCORDANCE WITH NOTES ON "RECORD DRAWINGS" TO REFLECT THE CONTRACTOR AND WITH EXECUTED CHANGE ORDERS. TO THE BEST OF OUR KNOWLEDGE AND BELIEF, THIS DRAWING SHOWS ACTUAL "AS-BUILT" CONDITIONS.

REVISED DATE: 10/06
BY: [Signature] CK BY: [Signature]

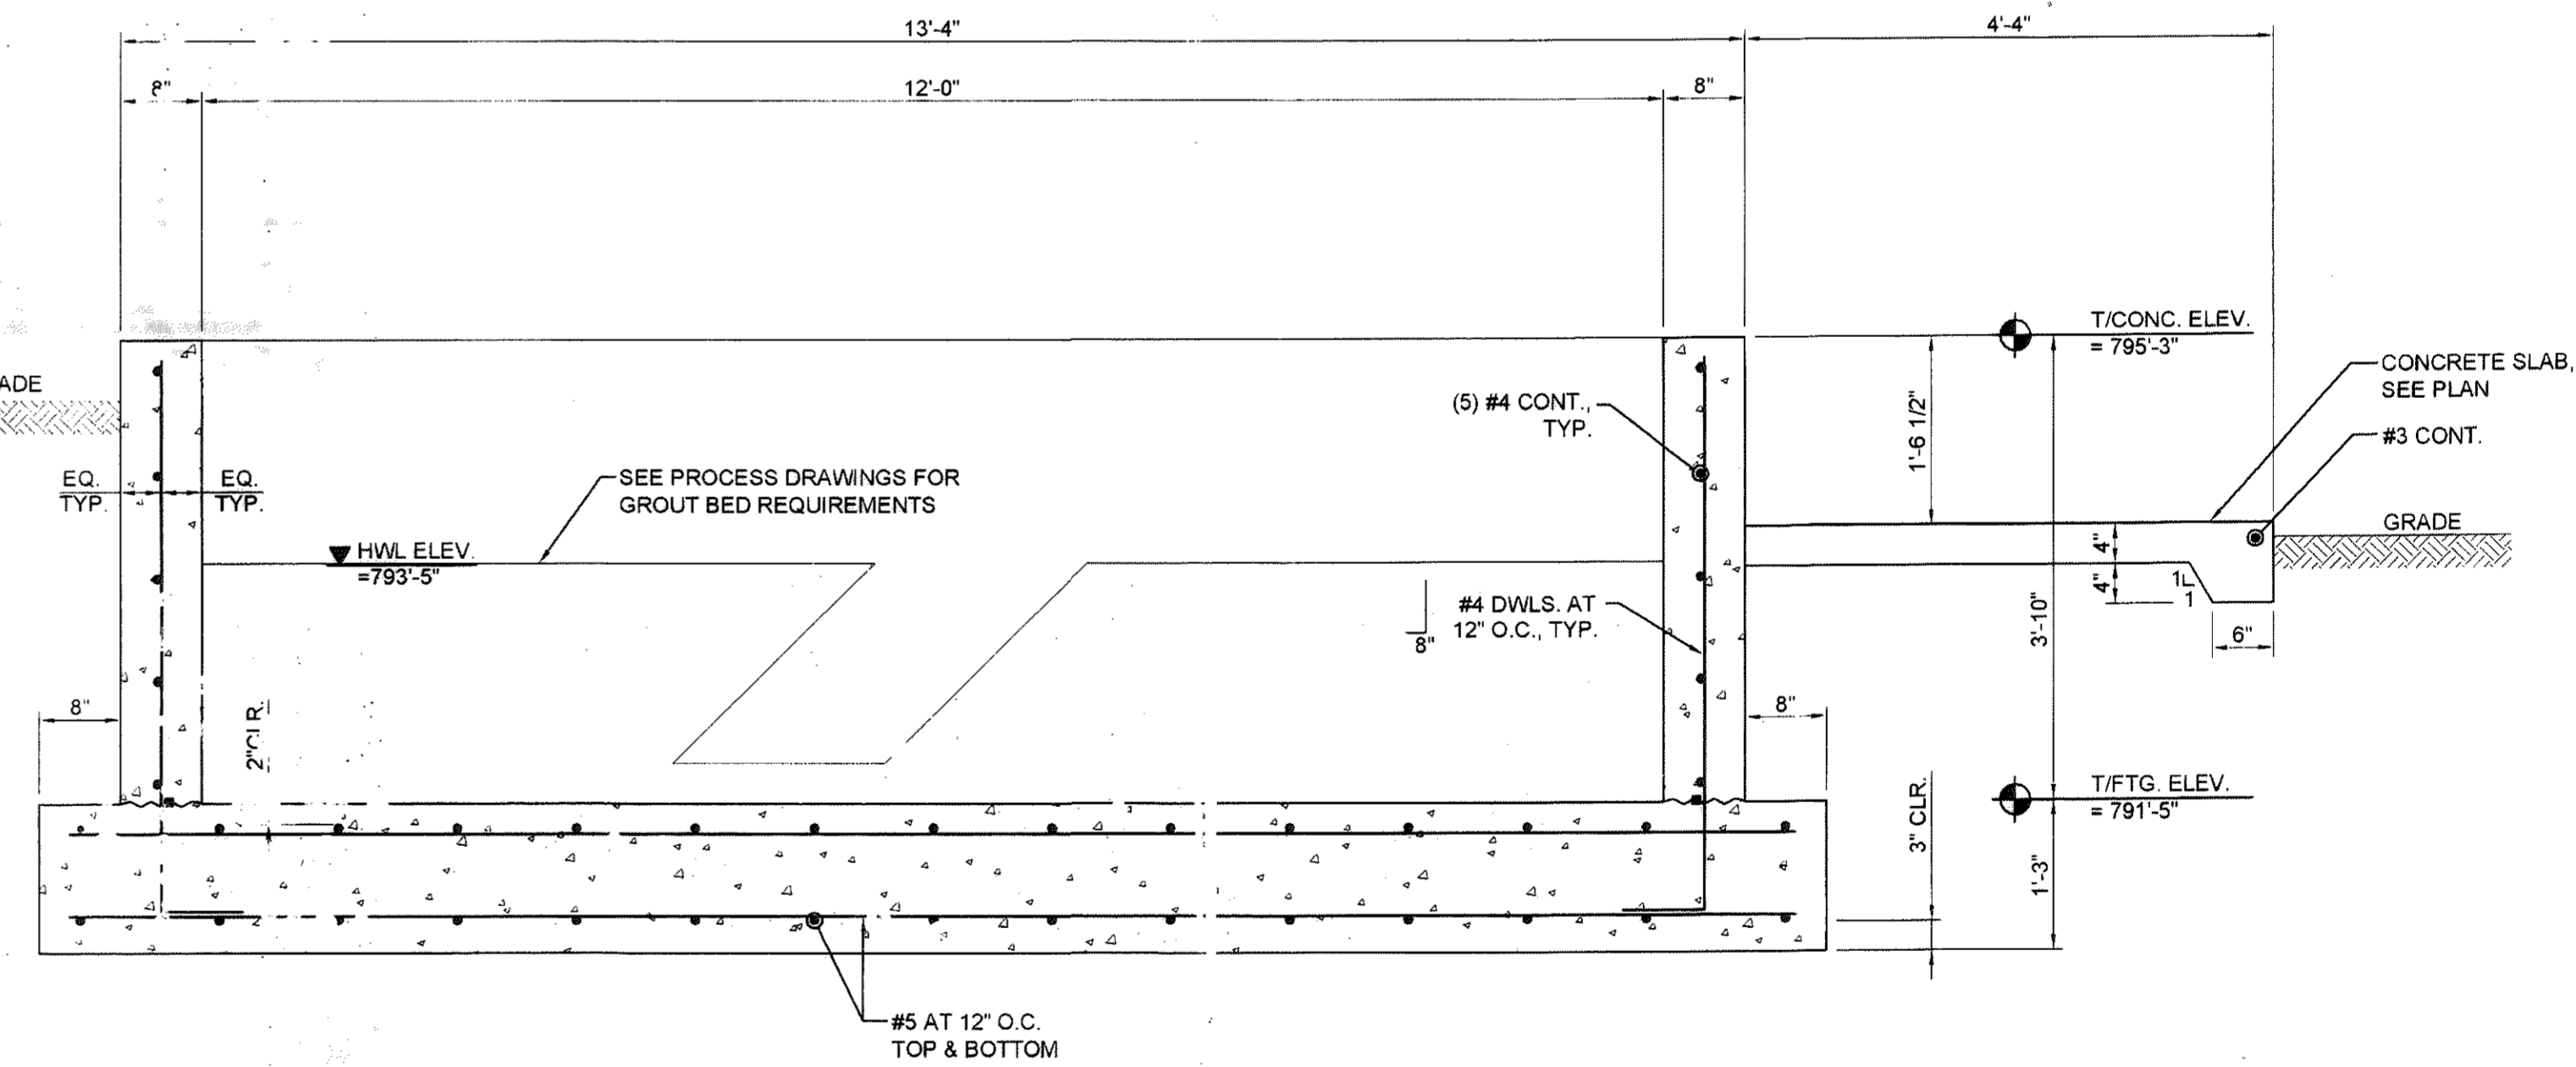

SECTION 1
SCALE: 3/4"=1'-0"

COPYRIGHT NOTICE: THIS ENGINEERING DRAWING IS GIVEN IN CONFIDENCE AND SHALL BE USED ONLY PURSUANT TO THE AGREEMENT WITH CE SOLUTIONS, INC. NO OTHER USE, DISSEMINATION OR DUPLICATION MAY BE MADE WITHOUT PRIOR WRITTEN CONSENT OF CE SOLUTIONS, INC. ALL COMMON LAW RIGHTS OF COPYRIGHT AND OTHERWISE ARE HEREBY SPECIFICALLY RESERVED.
CE SOLUTIONS, INC. PROJ. NO. 03-113

CE Solutions, Inc.
Structural Engineers
10 Shoshone Drive, Suite 100
Carmel, Indiana 46032
317-818-1912




**COMMONWEALTH
ENGINEERS, INC.**


DRAWN BY: KDD
DESIGNED BY: JDT
CHECKED BY: JDT
DATE: 04/21/04
JOB NO: S02119-02
SCALE: AS NOTED

SALAMONIE RESERVOIR
WASTEWATER TREATMENT FACILITIES IMPROVEMENTS PROJECT
PUBLIC WORKS PROJECT NO. E031410M
HEADWORKS STRUCTURE
FOUNDATION PLAN AND SECTIONS

DRAWING NO.
S3
37 OF 52

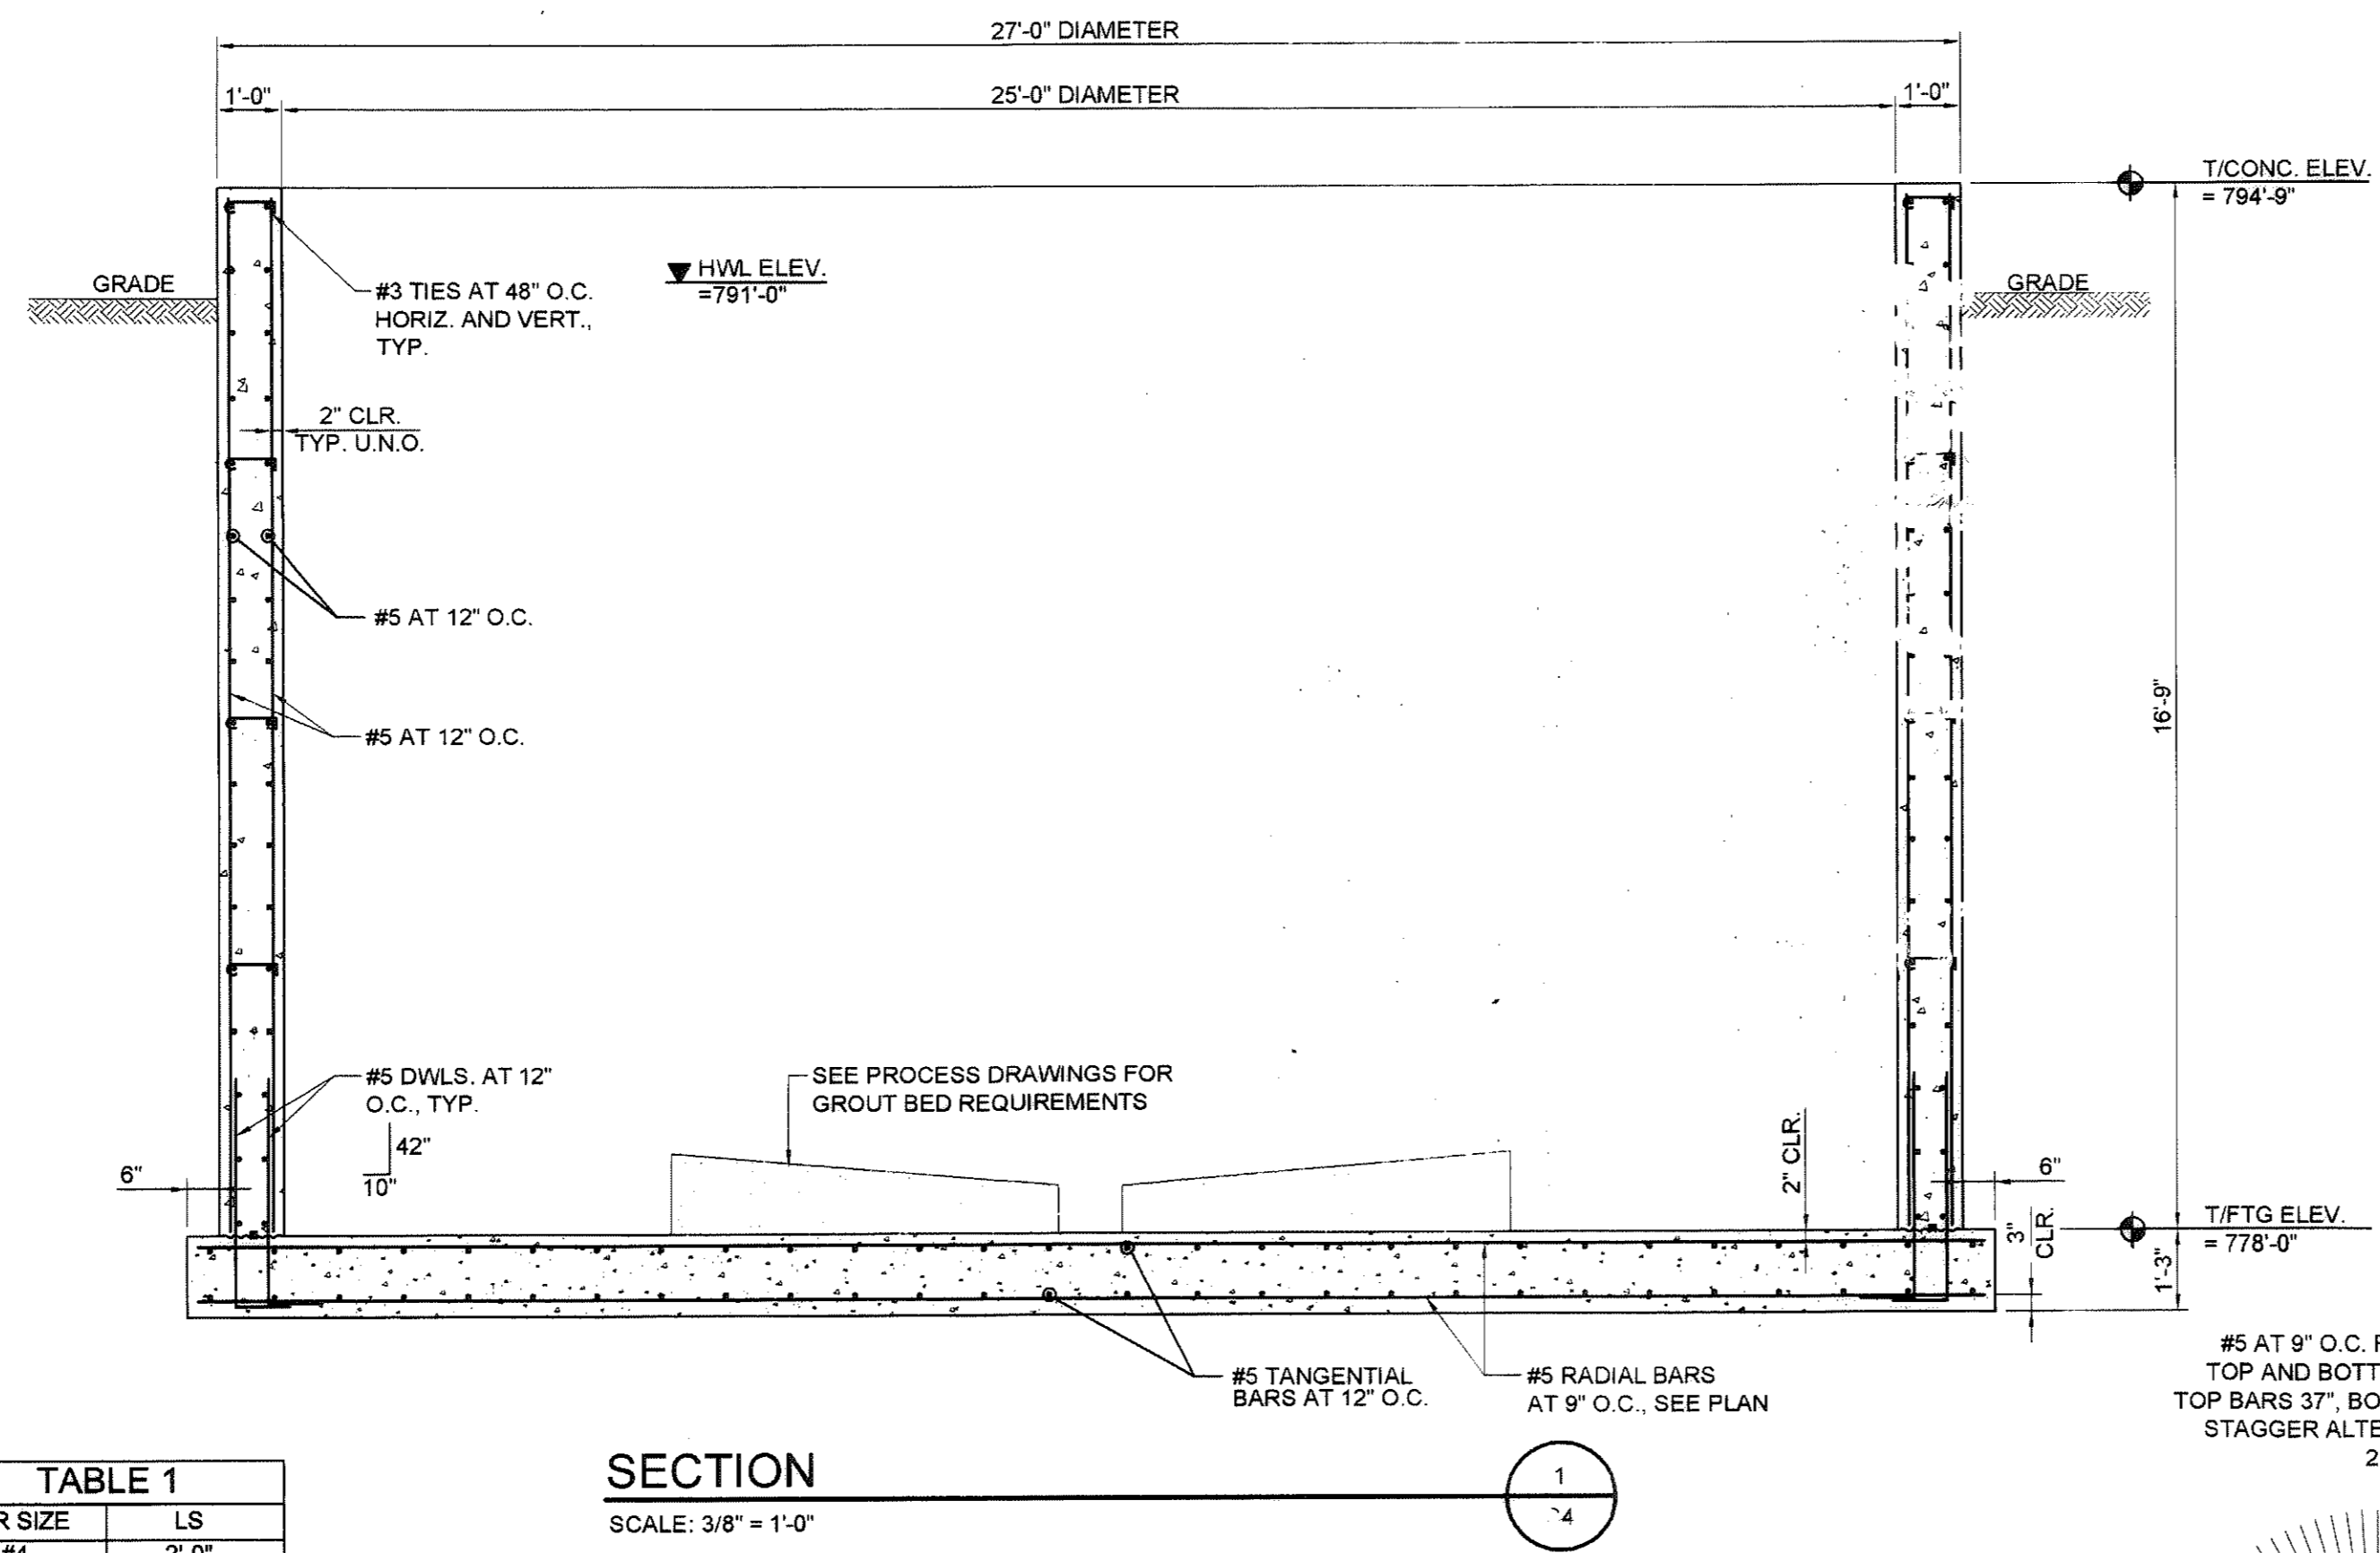


SECTION
SCALE: 3/8" = 1'-0"

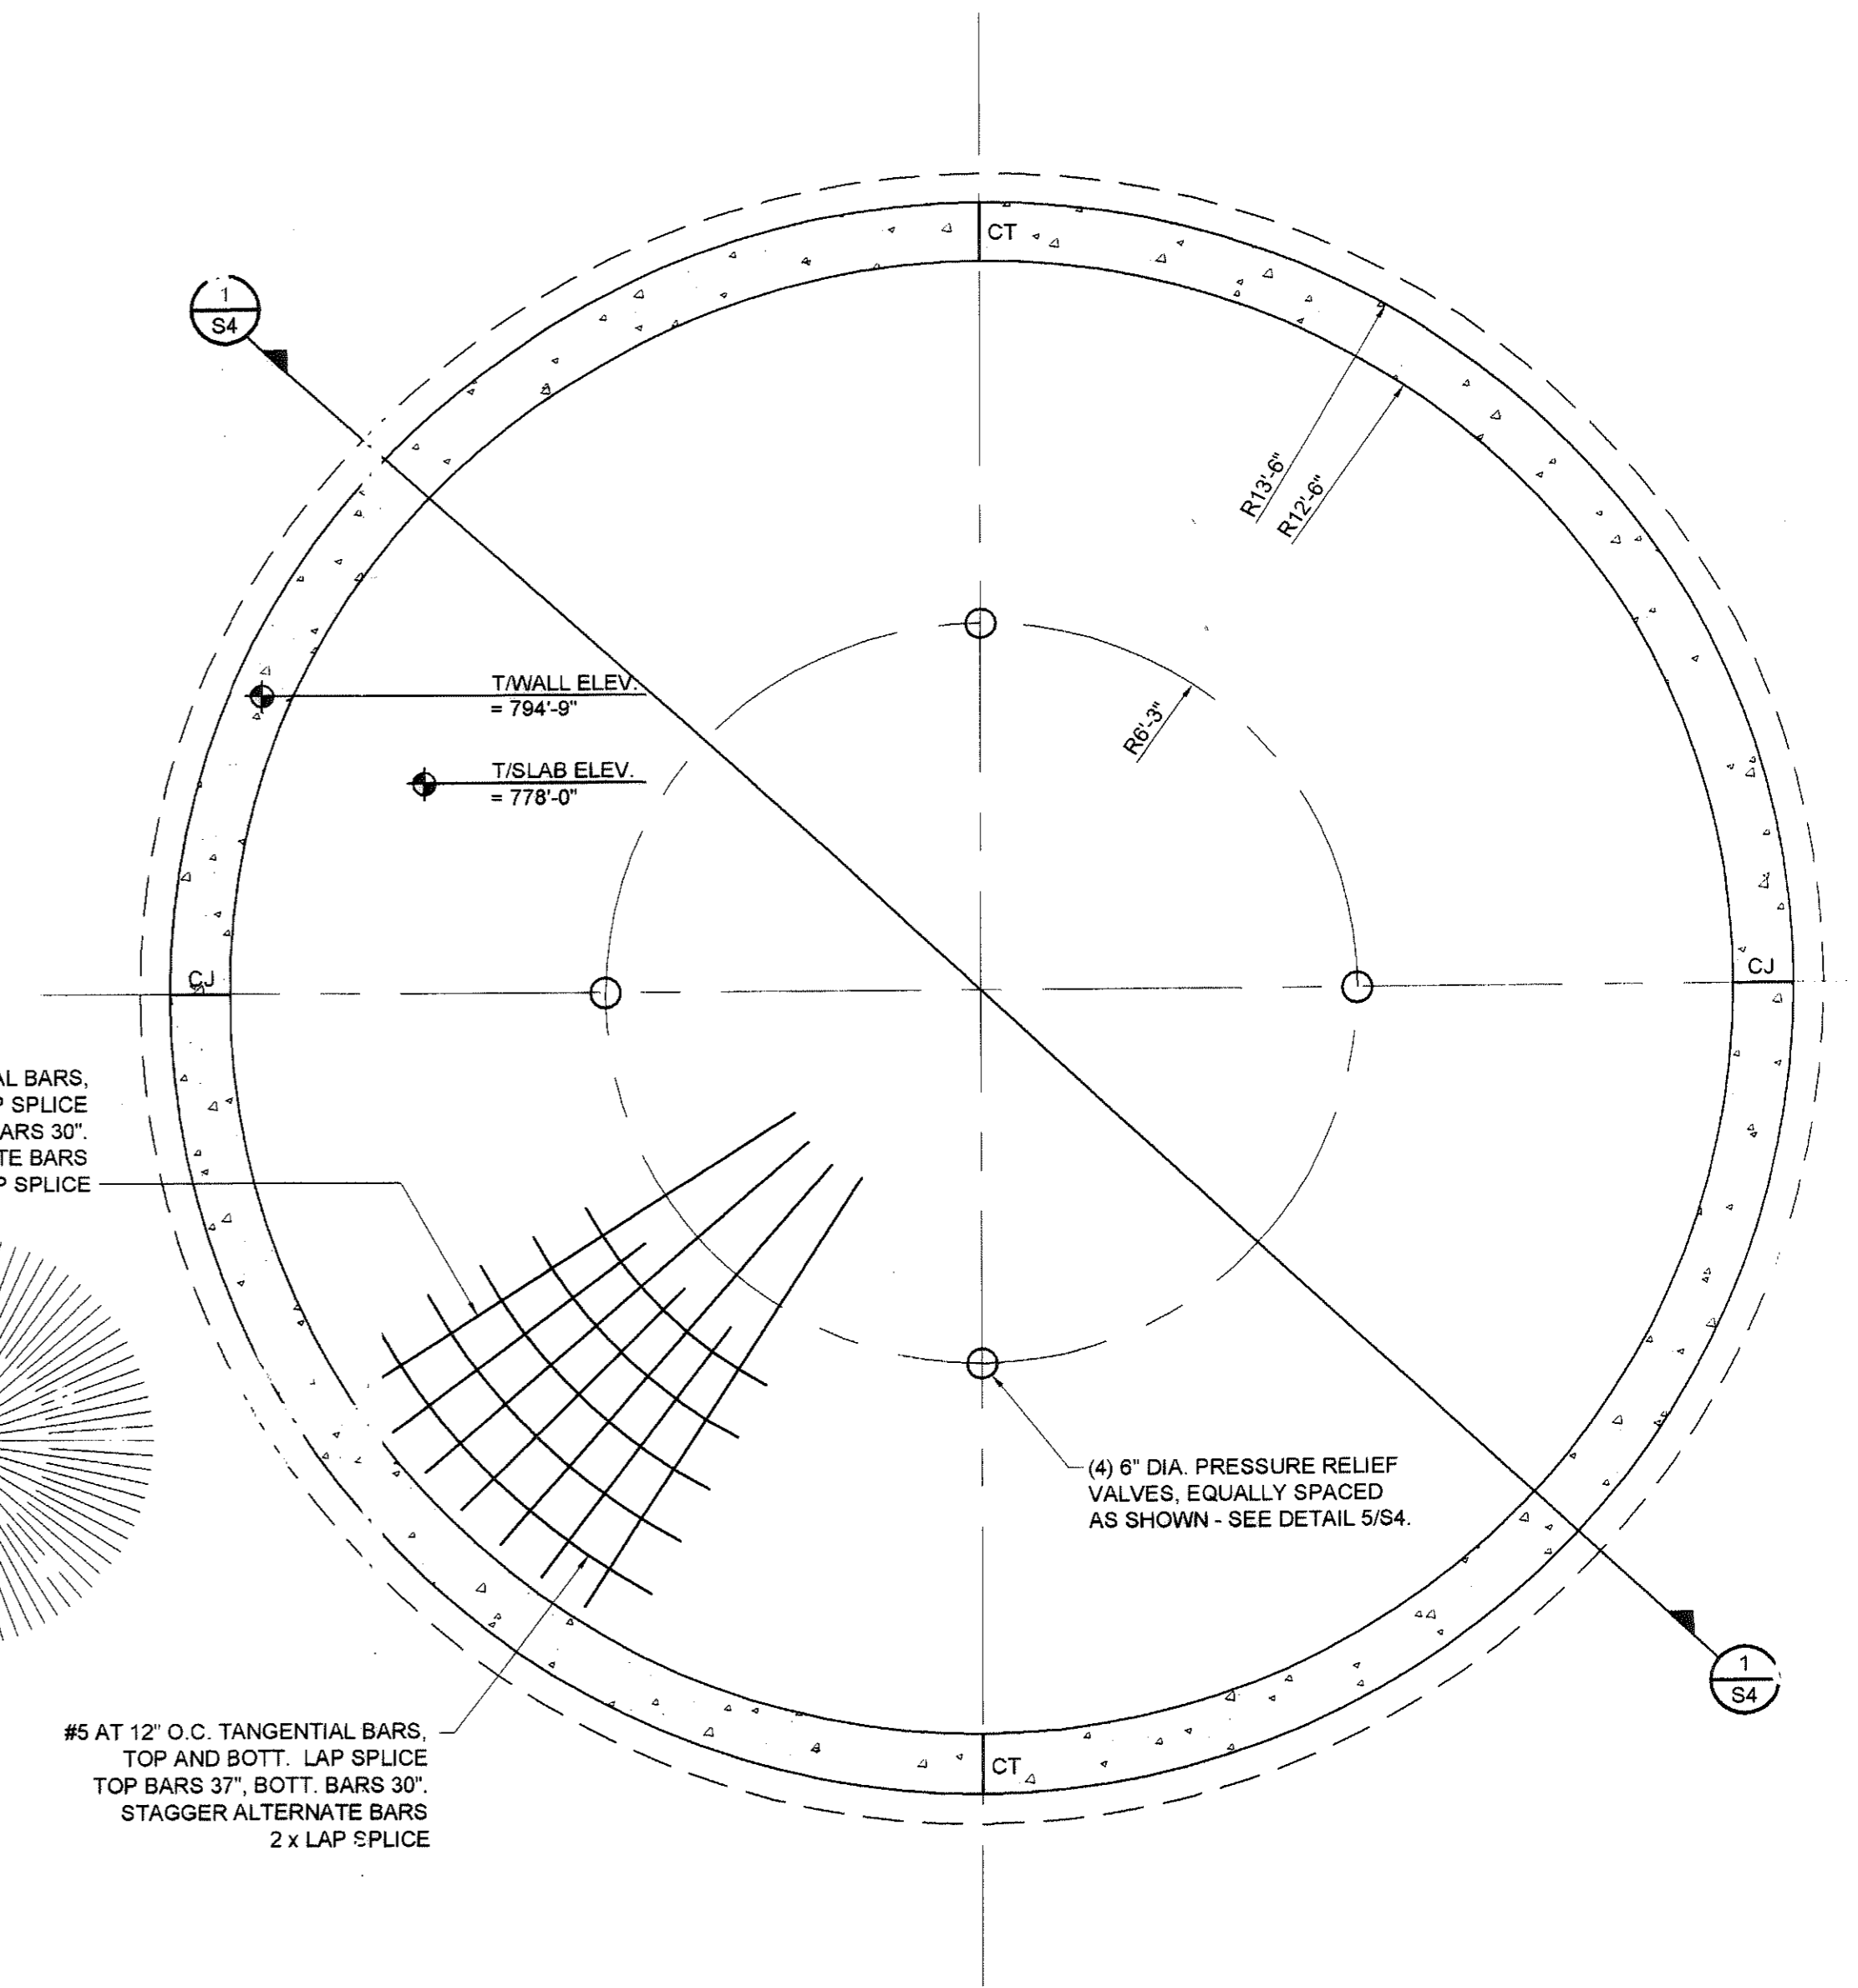


TREATMENT PLANT FOUNDATION / SLAB PLAN
SCALE: 3/8" = 1'-0"

- PLAN NOTES:**
- SEE SHEET S1 FOR GENERAL STRUCTURAL NOTES.
 - SEE SHEET S2 FOR TYPICAL DETAILS.
 - GENERAL CONTRACTOR TO COORDINATE ALL OPENINGS, PIPE SLEEVES, EMBED ITEMS, HANDRAILS, GRATING, ETC. WITH PROCESS DRAWINGS.
 - ALL DIMENSIONS AND ELEVATIONS SHALL BE VERIFIED PRIOR TO FABRICATION, CONSTRUCTION OR ERECTION. THE GENERAL CONTRACTOR SHALL ASSUME RESPONSIBILITY FOR ANY DISCREPANCIES.
 - SEE SITE PLAN FOR ALL FINAL GRADE ELEVATIONS.
 - SEE GEOTECHNICAL REPORT FOR ALL BACKFILLING AND COMPACTION REQUIREMENTS BEHIND WALLS AND UNDER BASE SLABS.
 - GENERAL CONTRACTOR SHALL SUBMIT ALL CHANGES MADE TO THE CONSTRUCTION JOINT (CJ) AND/OR CONTRACTION JOINT (CT) LOCATIONS TO THE STRUCTURAL ENGINEER FOR APPROVAL PRIOR TO CONCRETE PLACEMENT.

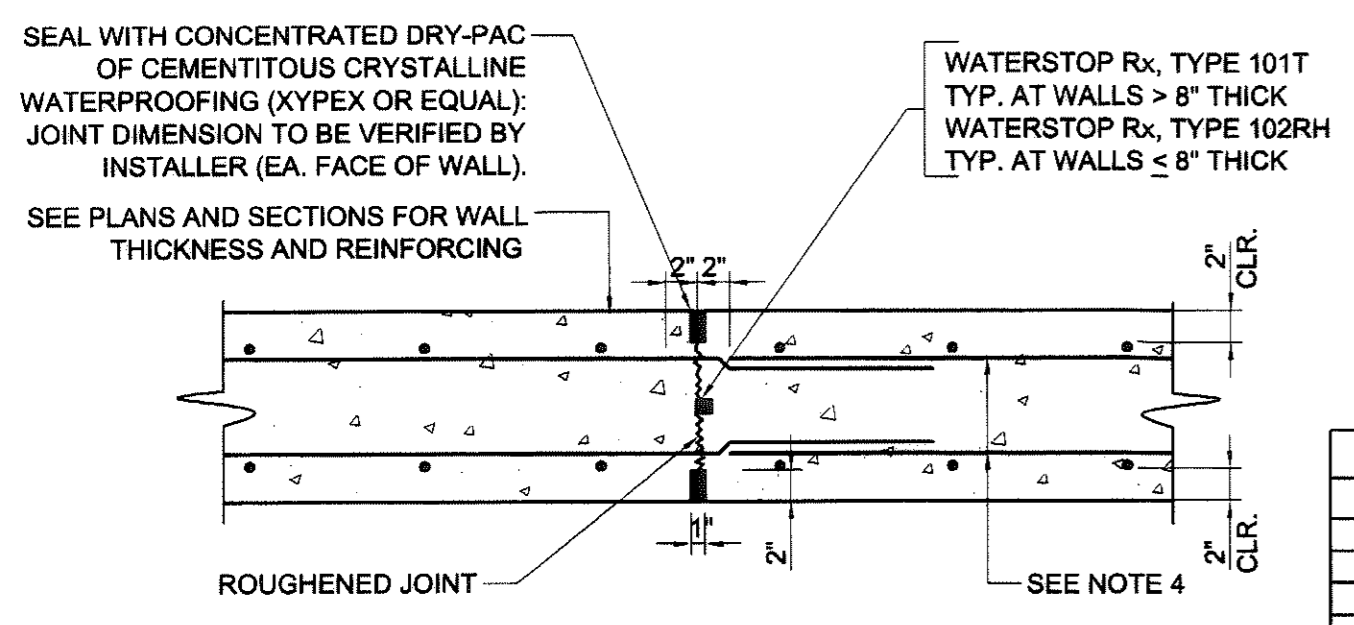

WALL CONSTRUCTION JOINT
SCALE: 1" = 1'-0"

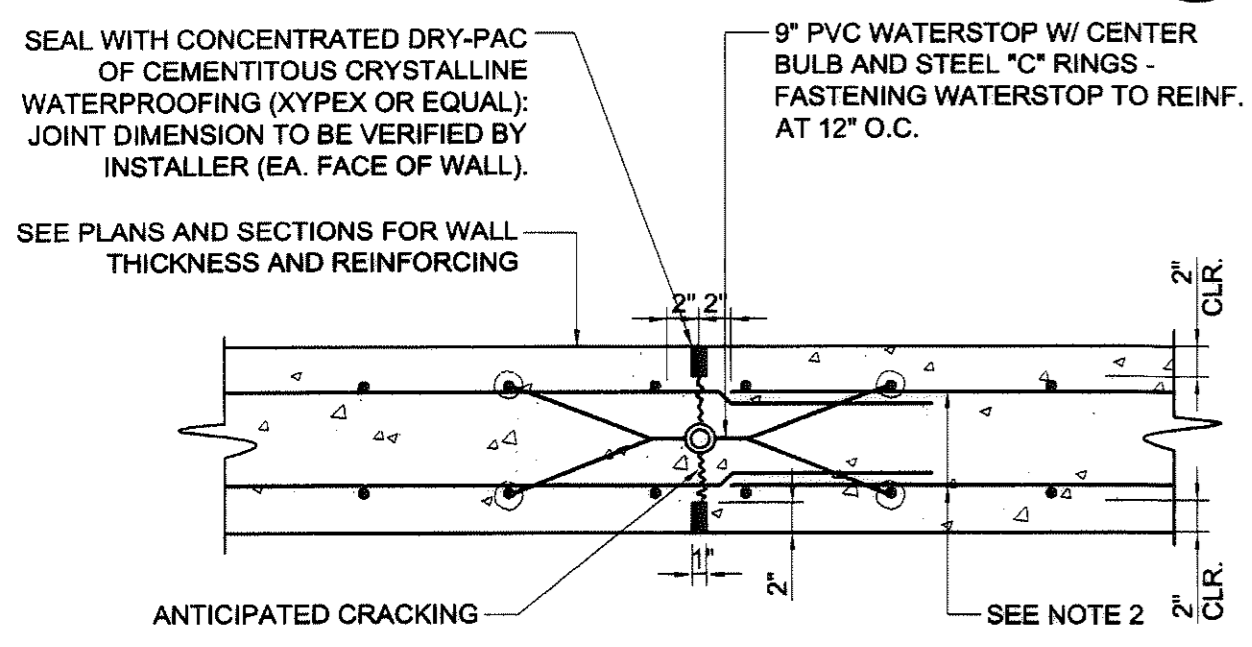


WALL CONTRACTION JOINT
SCALE: 1" = 1'-0"


BAR SIZE	LS
#4	2'-0"
#5	2'-6"
#6	3'-0"
#7	3'-6"
#8	4'-0"
#9	4'-9"
#10	5'-6"

BAR SIZE	LS
#4	2'-0"
#5	2'-6"
#6	3'-0"
#7	3'-6"
#8	4'-0"
#9	4'-9"
#10	5'-6"

REVISED "AS-BUILT" DRAWING
THIS DRAWING HAS BEEN REVISED IN ACCORDANCE WITH NOTES ON RECORD DRAWINGS FURNISHED BY THE CONTRACTOR AND WITH PROPOSED CHANGE ORDER. THE CONTRACTOR'S BELIEF, THIS DRAWING SHOWS ACTUAL "AS-BUILT" CONDITIONS.
COMMONWEALTH ENGINEERS, INC. REVISED DATE: 10/01
BY: [Signature], CK. BY: [Signature]

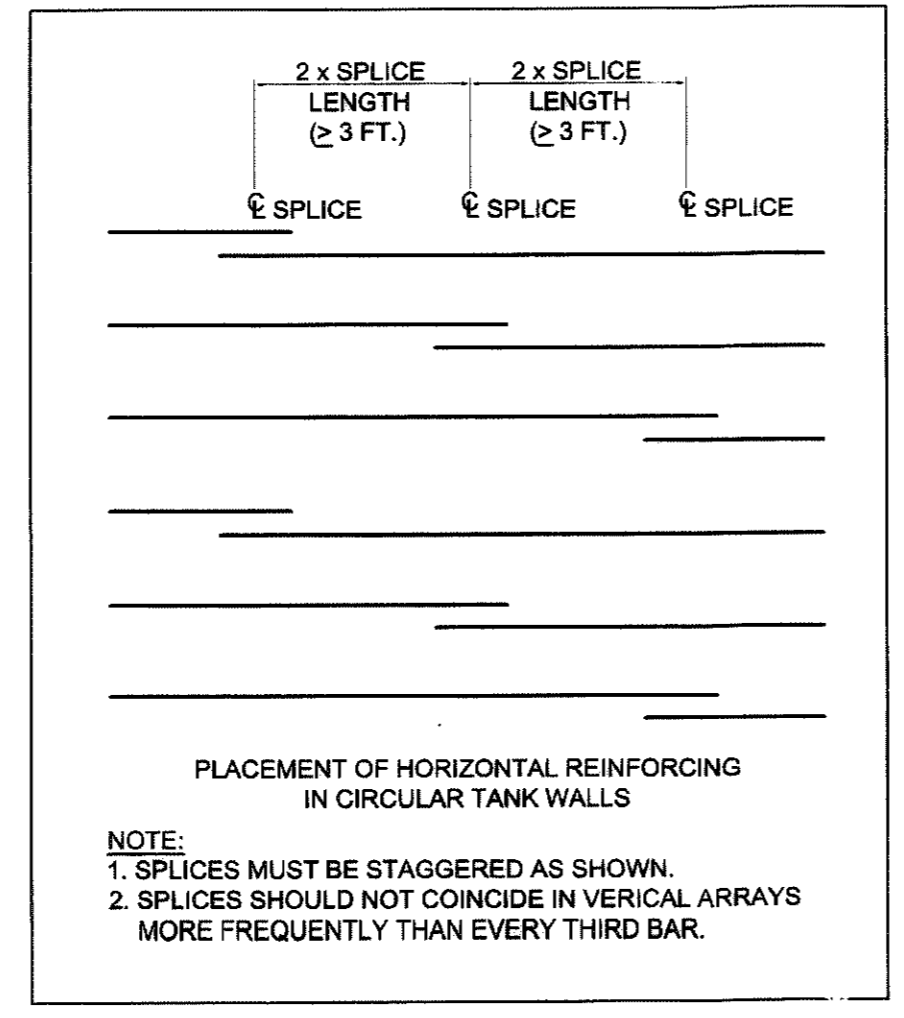


HORIZONTAL BARS SPLICE DETAIL
SCALE: 3" = 1'-0"

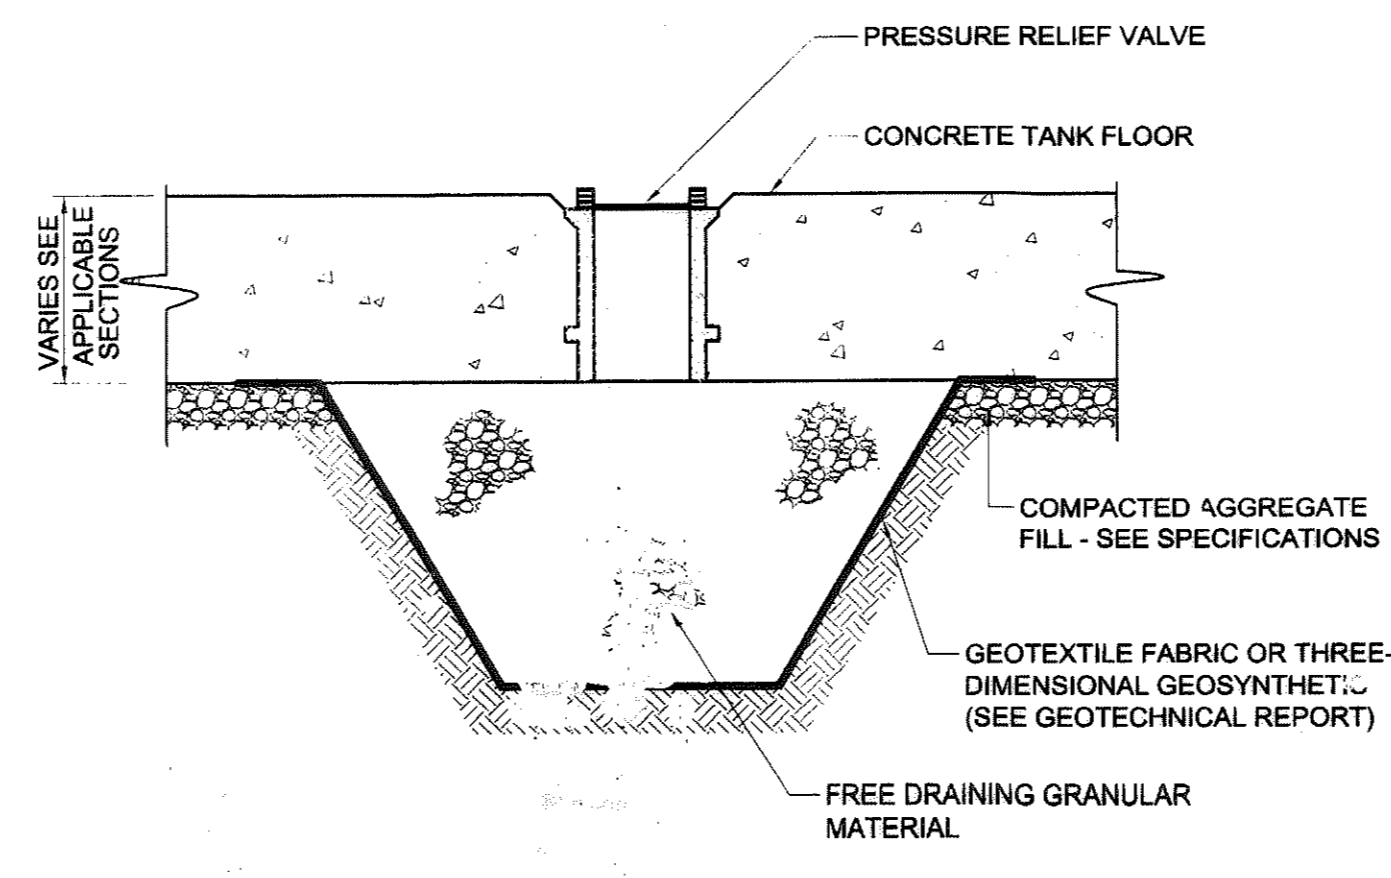

TYPICAL PRESSURE RELIEF VALVE
SCALE: 1" = 1'-0"

COPYRIGHT NOTICE: THIS ENGINEERING DRAWING IS GIVEN IN CONFIDENCE AND SHALL BE USED ONLY PURSUANT TO THE AGREEMENT WITH CE SOLUTIONS, INC. NO OTHER USE, DISSEMINATION OR DUPLICATION MAY BE MADE WITHOUT PRIOR WRITTEN CONSENT OF CE SOLUTIONS, INC. ALL COMMON LAW RIGHTS OF COPYRIGHT AND OTHERWISE ARE HEREBY SPECIFICALLY RESERVED.
CE SOLUTIONS, INC. PROJ. NO. 03-113

CE Solutions, Inc.
Structural Engineers
10 Shoshone Drive, Suite 100
Carmel, Indiana 46032
317-818-1912



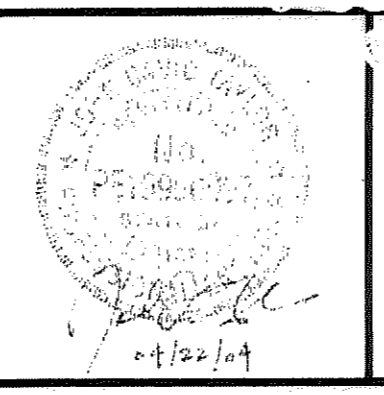


COMMONWEALTH ENGINEERS, INC.

DRAWN BY: KDD
DESIGNED BY: JDT
CHECKED BY: JDT
DATE: 04/21/04
JOB NO: S02119-02
SCALE: AS NOTED

SALOMONIE RESERVOIR
WASTEWATER TREATMENT FACILITIES IMPROVEMENTS PROJECT
PUBLIC WORKS PROJECT NO. E031410M
TREATMENT PLANT TANK
FOUNDATION PLAN AND SECTIONS

DRAWING NO.
S4
38 OF 52

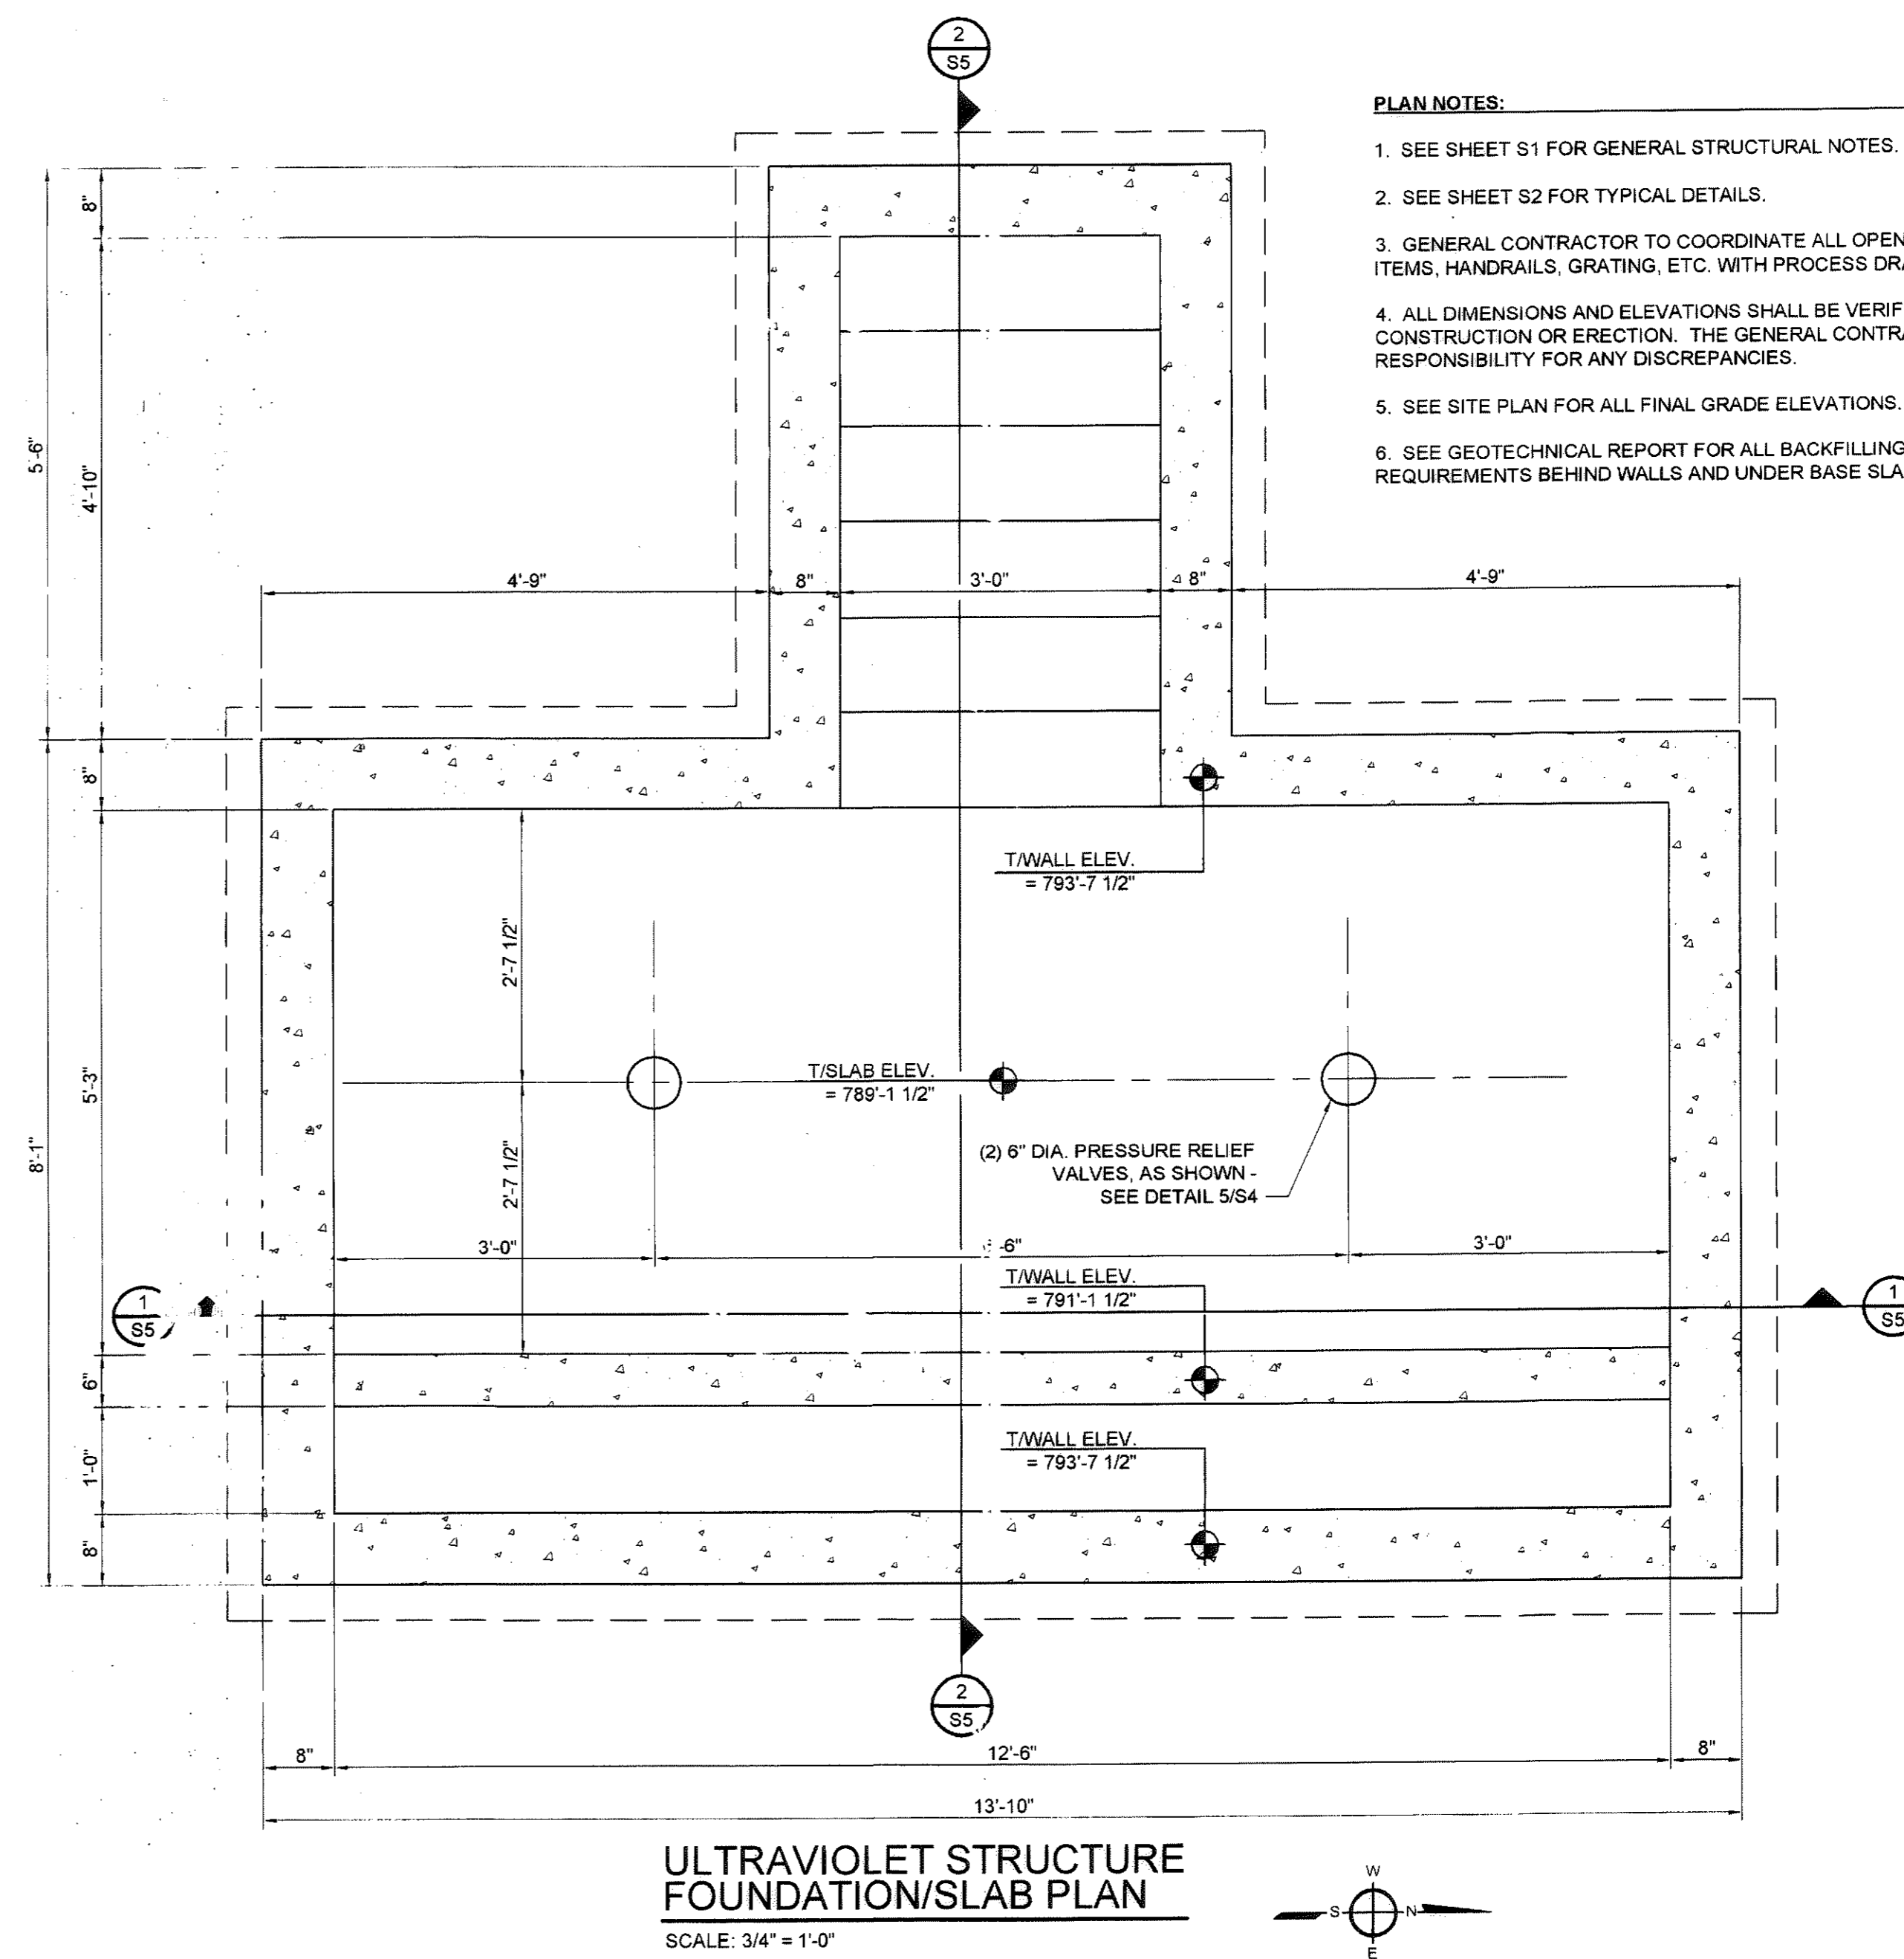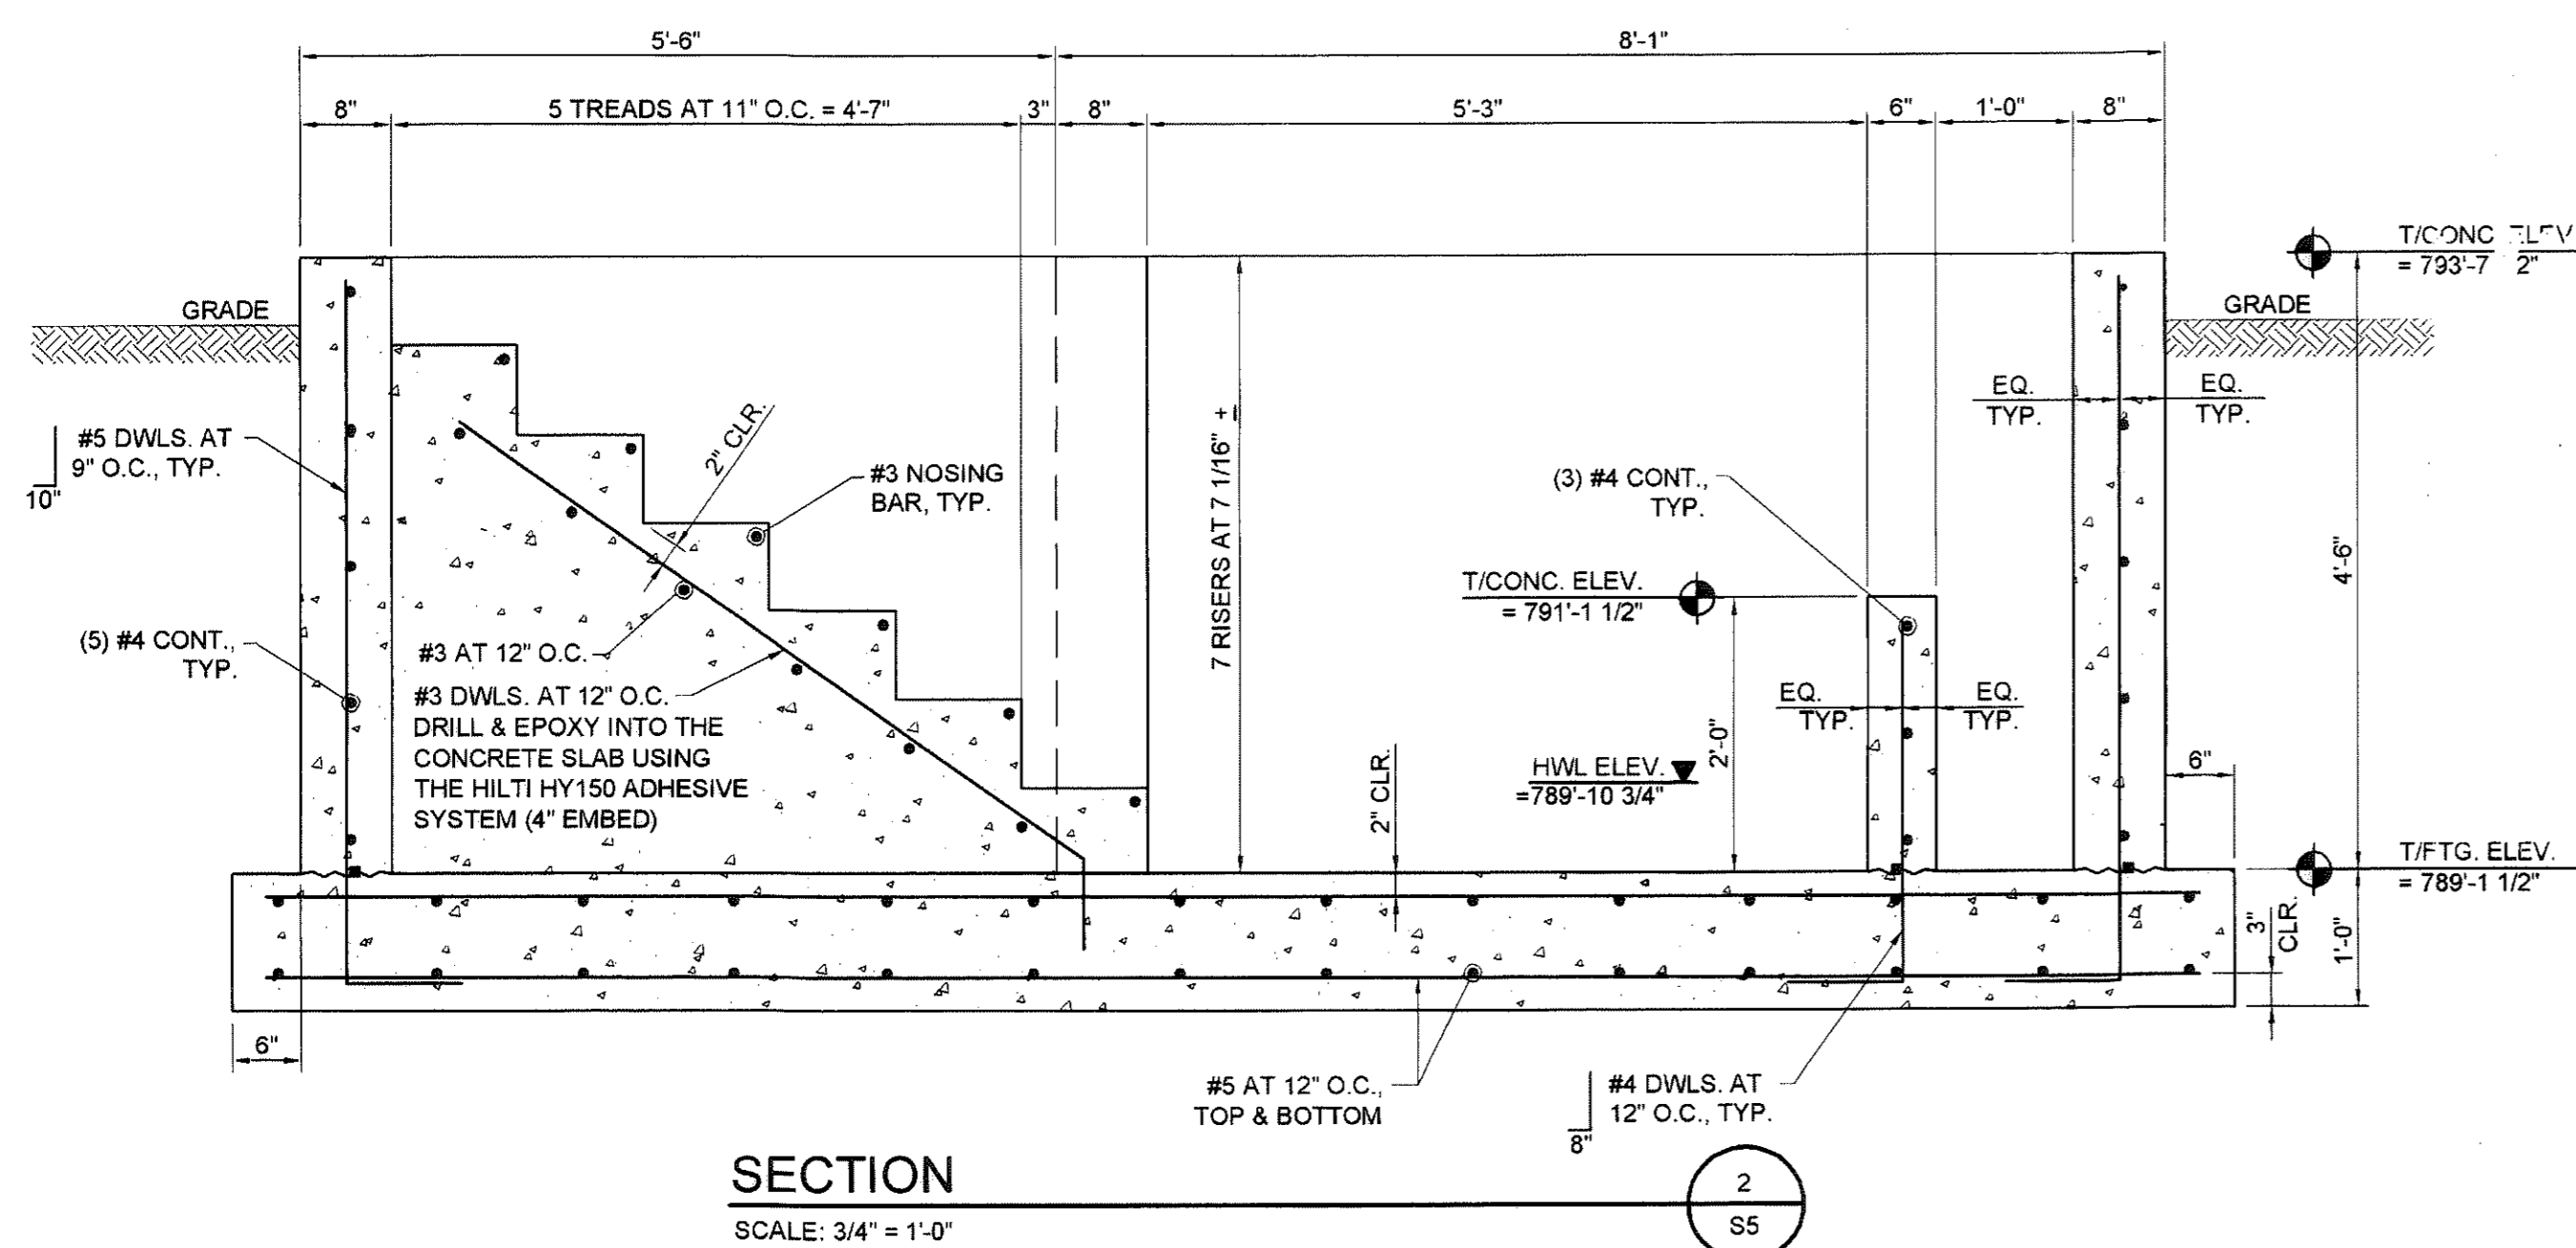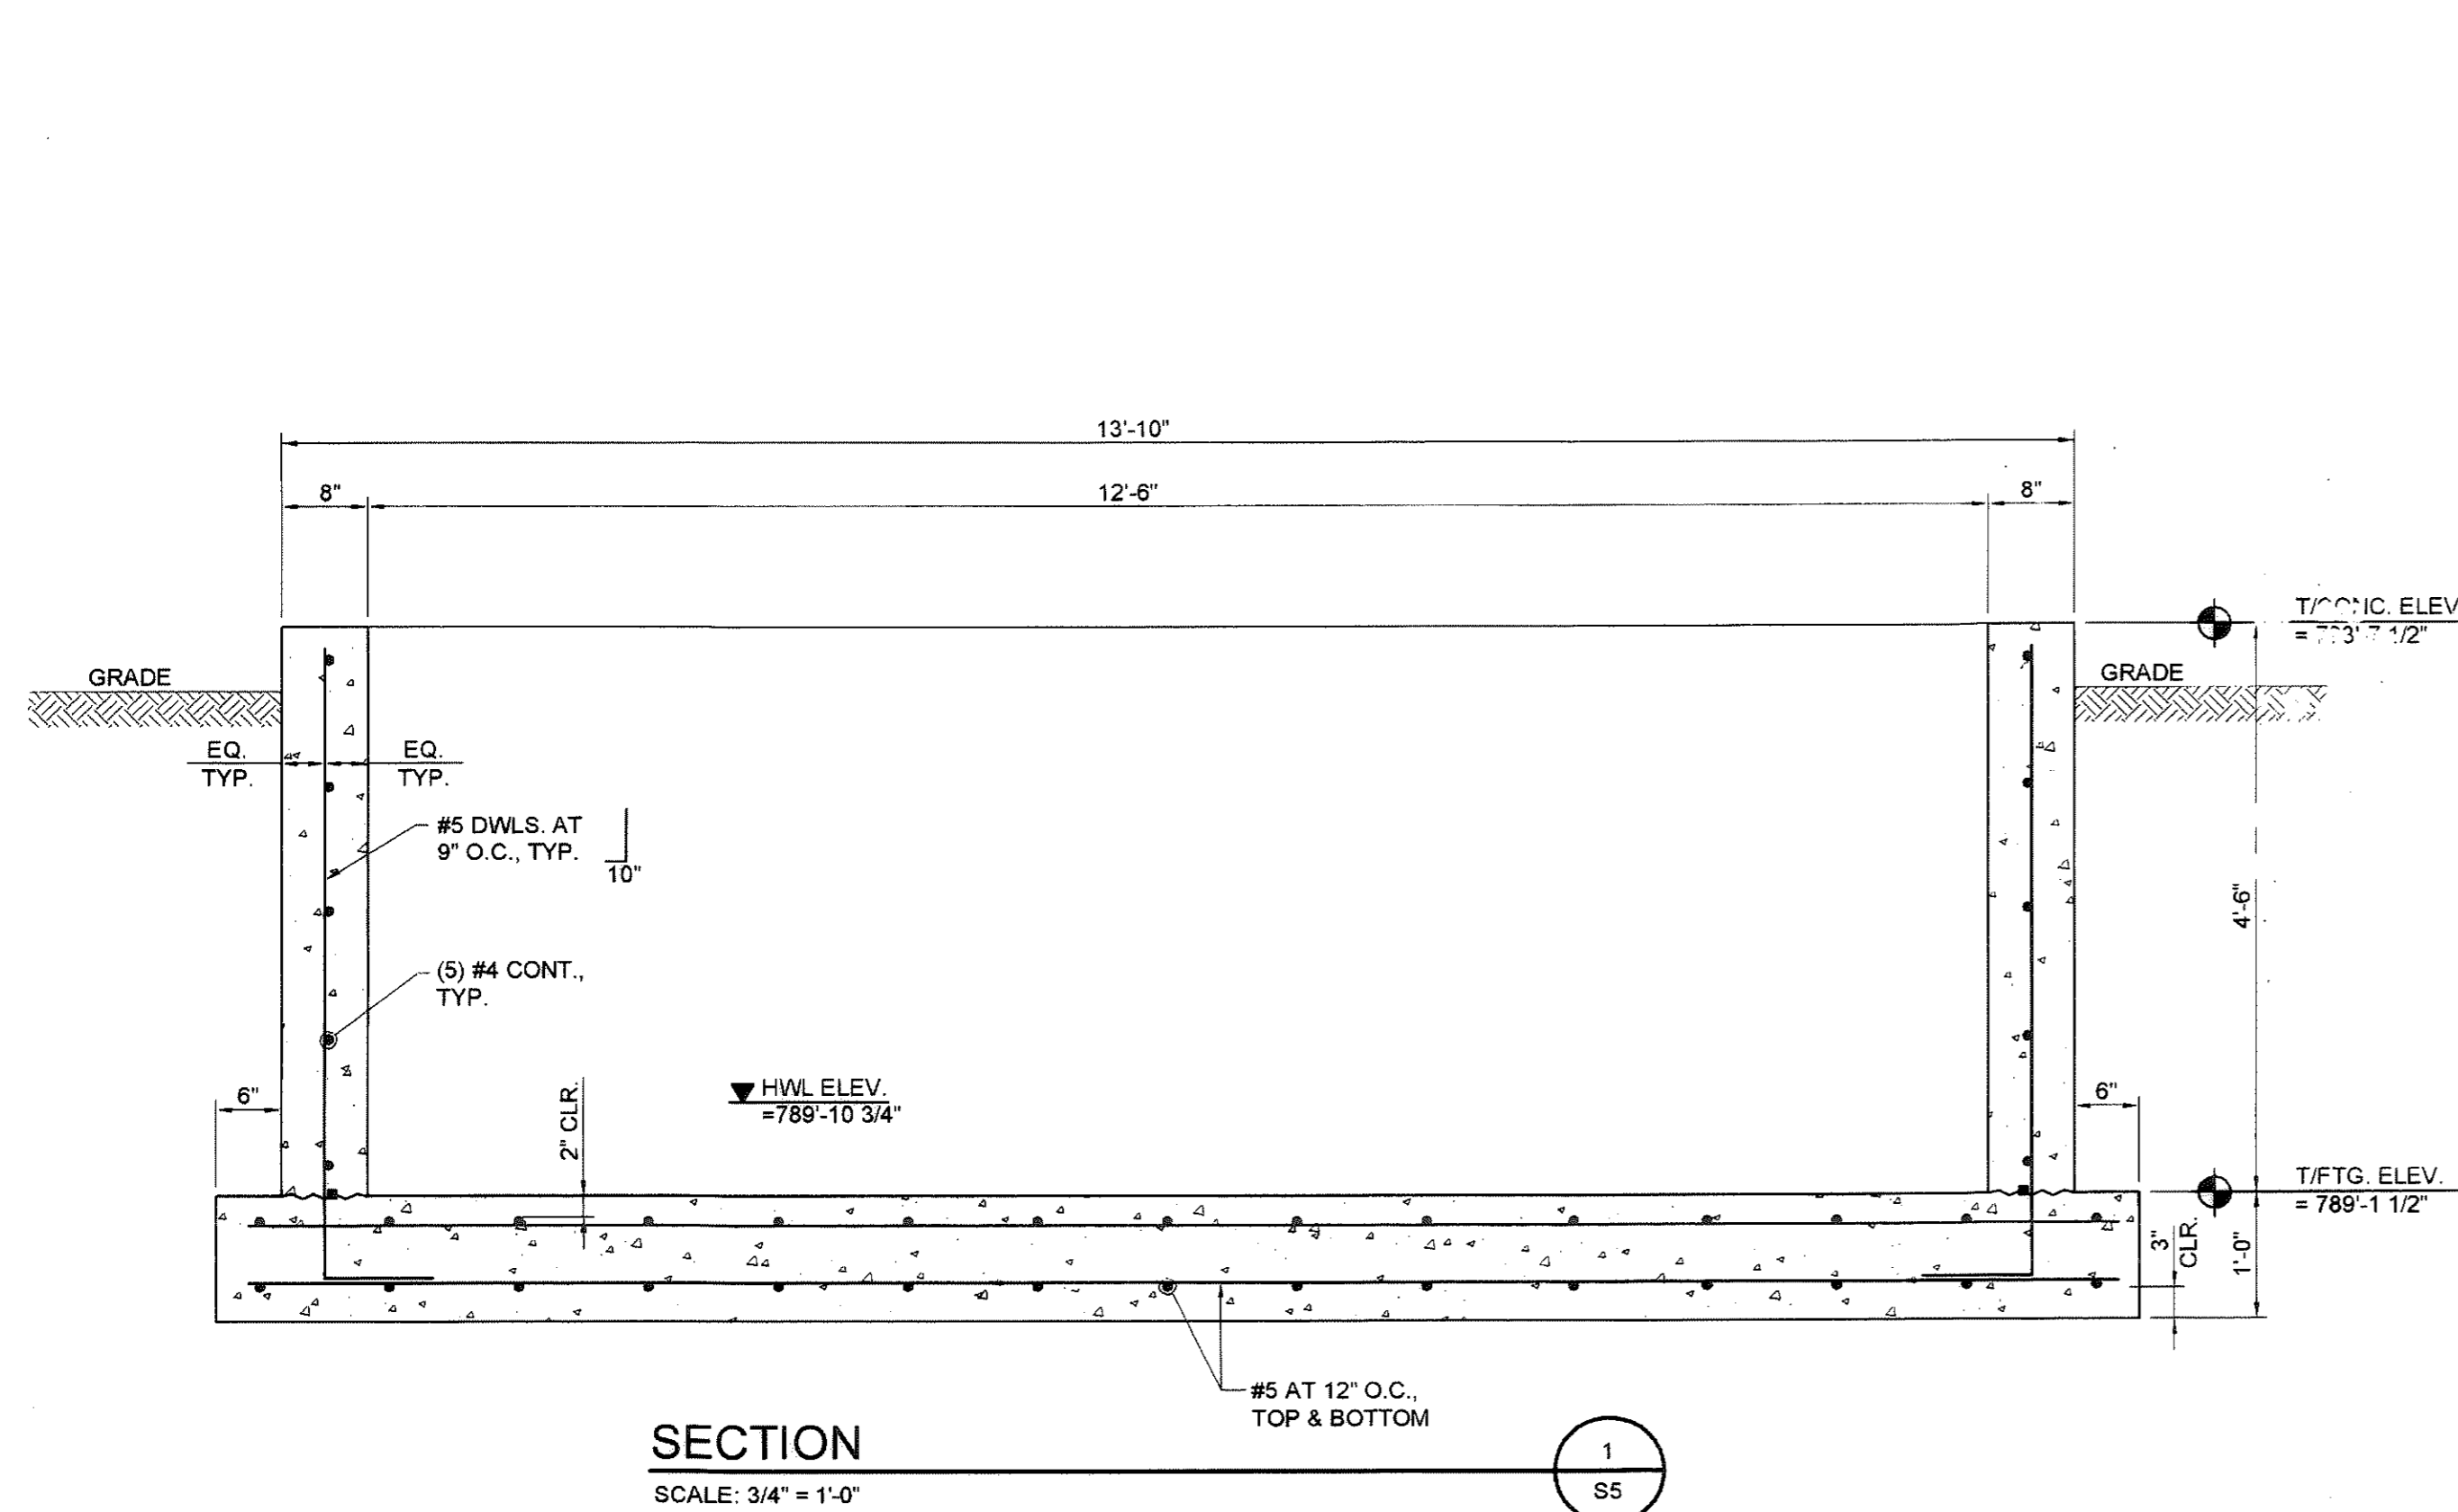

- PLAN NOTES:**
1. SEE SHEET S1 FOR GENERAL STRUCTURAL NOTES.
 2. SEE SHEET S2 FOR TYPICAL DETAILS.
 3. GENERAL CONTRACTOR TO COORDINATE ALL OPENINGS, PIPE SLEEVES, EMBED ITEMS, HANDRAILS, GRATING, ETC. WITH PROCESS DRAWINGS.
 4. ALL DIMENSIONS AND ELEVATIONS SHALL BE VERIFIED PRIOR TO FABRICATION, CONSTRUCTION OR ERECTION. THE GENERAL CONTRACTOR SHALL ASSUME RESPONSIBILITY FOR ANY DISCREPANCIES.
 5. SEE SITE PLAN FOR ALL FINAL GRADE ELEVATIONS.
 6. SEE GEOTECHNICAL REPORT FOR ALL BACKFILLING AND COMPACTION REQUIREMENTS BEHIND WALLS AND UNDER BASE SLABS.

REVISED "AS-BUILT" DRAWING


THIS DRAWING HAS BEEN REVISED IN ACCORDANCE WITH NOTES ON "RECORD" DRAWING (SHEET S1) BY THE CONTRACTOR AND WITH EXPLICIT CHANGE ORDER TO THE BEST OF OUR KNOWLEDGE AND BELIEF. THIS DRAWING SHOWS ACTUAL "AS-BUILT" CONDITIONS.

DESIGNED BY: JDT
 CHECKED BY: JDT
 DATE: 04/21/04
 JOB NO: S02119-02
 SCALE: AS NOTED

REVISOR: DA: JDT
 BY: JDT

COPYRIGHT NOTICE: THIS ENGINEERING DRAWING IS GIVEN IN CONFIDENCE AND SHALL BE USED ONLY PURSUANT TO THE AGREEMENT WITH CE SOLUTIONS, INC. NO OTHER USE, DISSEMINATION OR DUPLICATION MAY BE MADE WITHOUT PRIOR WRITTEN CONSENT OF CE SOLUTIONS, INC. ALL COMMON LAW RIGHTS OF COPYRIGHT AND OTHERWISE ARE HEREBY SPECIFICALLY RESERVED. CE SOLUTIONS, INC. PROJ. NO. 03-113

CE Solutions, Inc.
 Structural Engineers
 10 Shoshone Drive, Suite 100
 Carmel, Indiana 46032
 317-818-1912

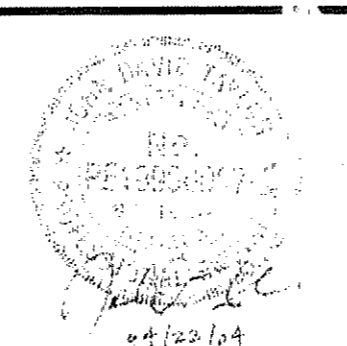


COMMONWEALTH ENGINEERS, INC.

DRAWN BY: KDD
 DESIGNED BY: JDT
 CHECKED BY: JDT
 DATE: 04/21/04
 JOB NO: S02119-02
 SCALE: AS NOTED

SALAMONIE RESERVOIR
 WASTEWATER TREATMENT FACILITIES IMPROVEMENTS PROJECT
 PUBLIC WORKS PROJECT NO. E031410M
 ULTRAVIOLET STRUCTURE
 FOUNDATION PLAN AND SECTIONS



DRAWING NO.
S5
 39 OF 52

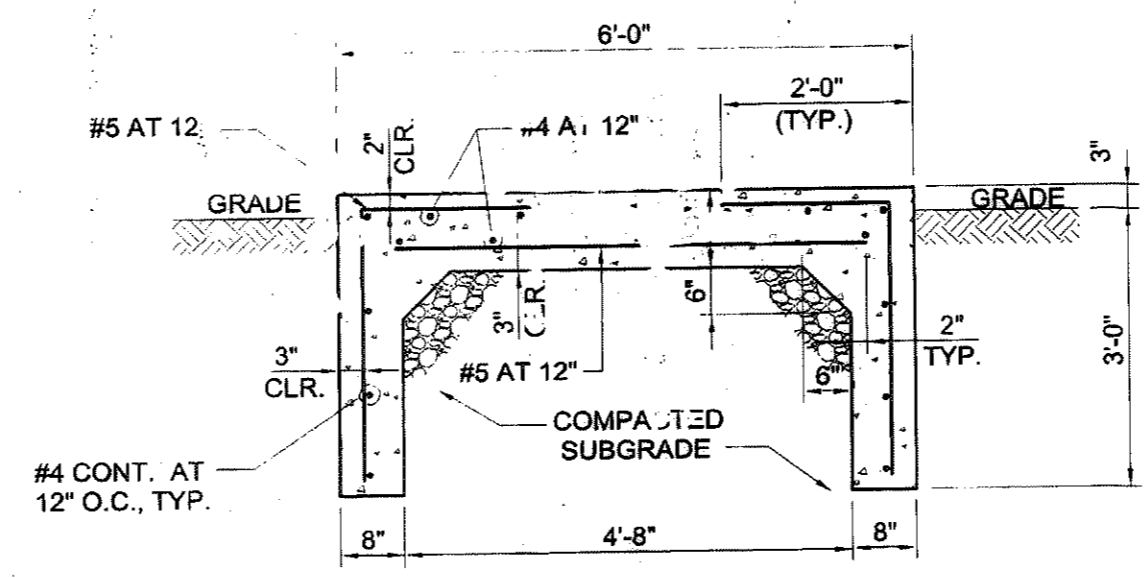

CLASS "B" CONCRETE
GRADE 60 REINFORCEMENT


EXTERIOR EQUIPMENT PAD

SCALE: 1/2" = 1'-0"

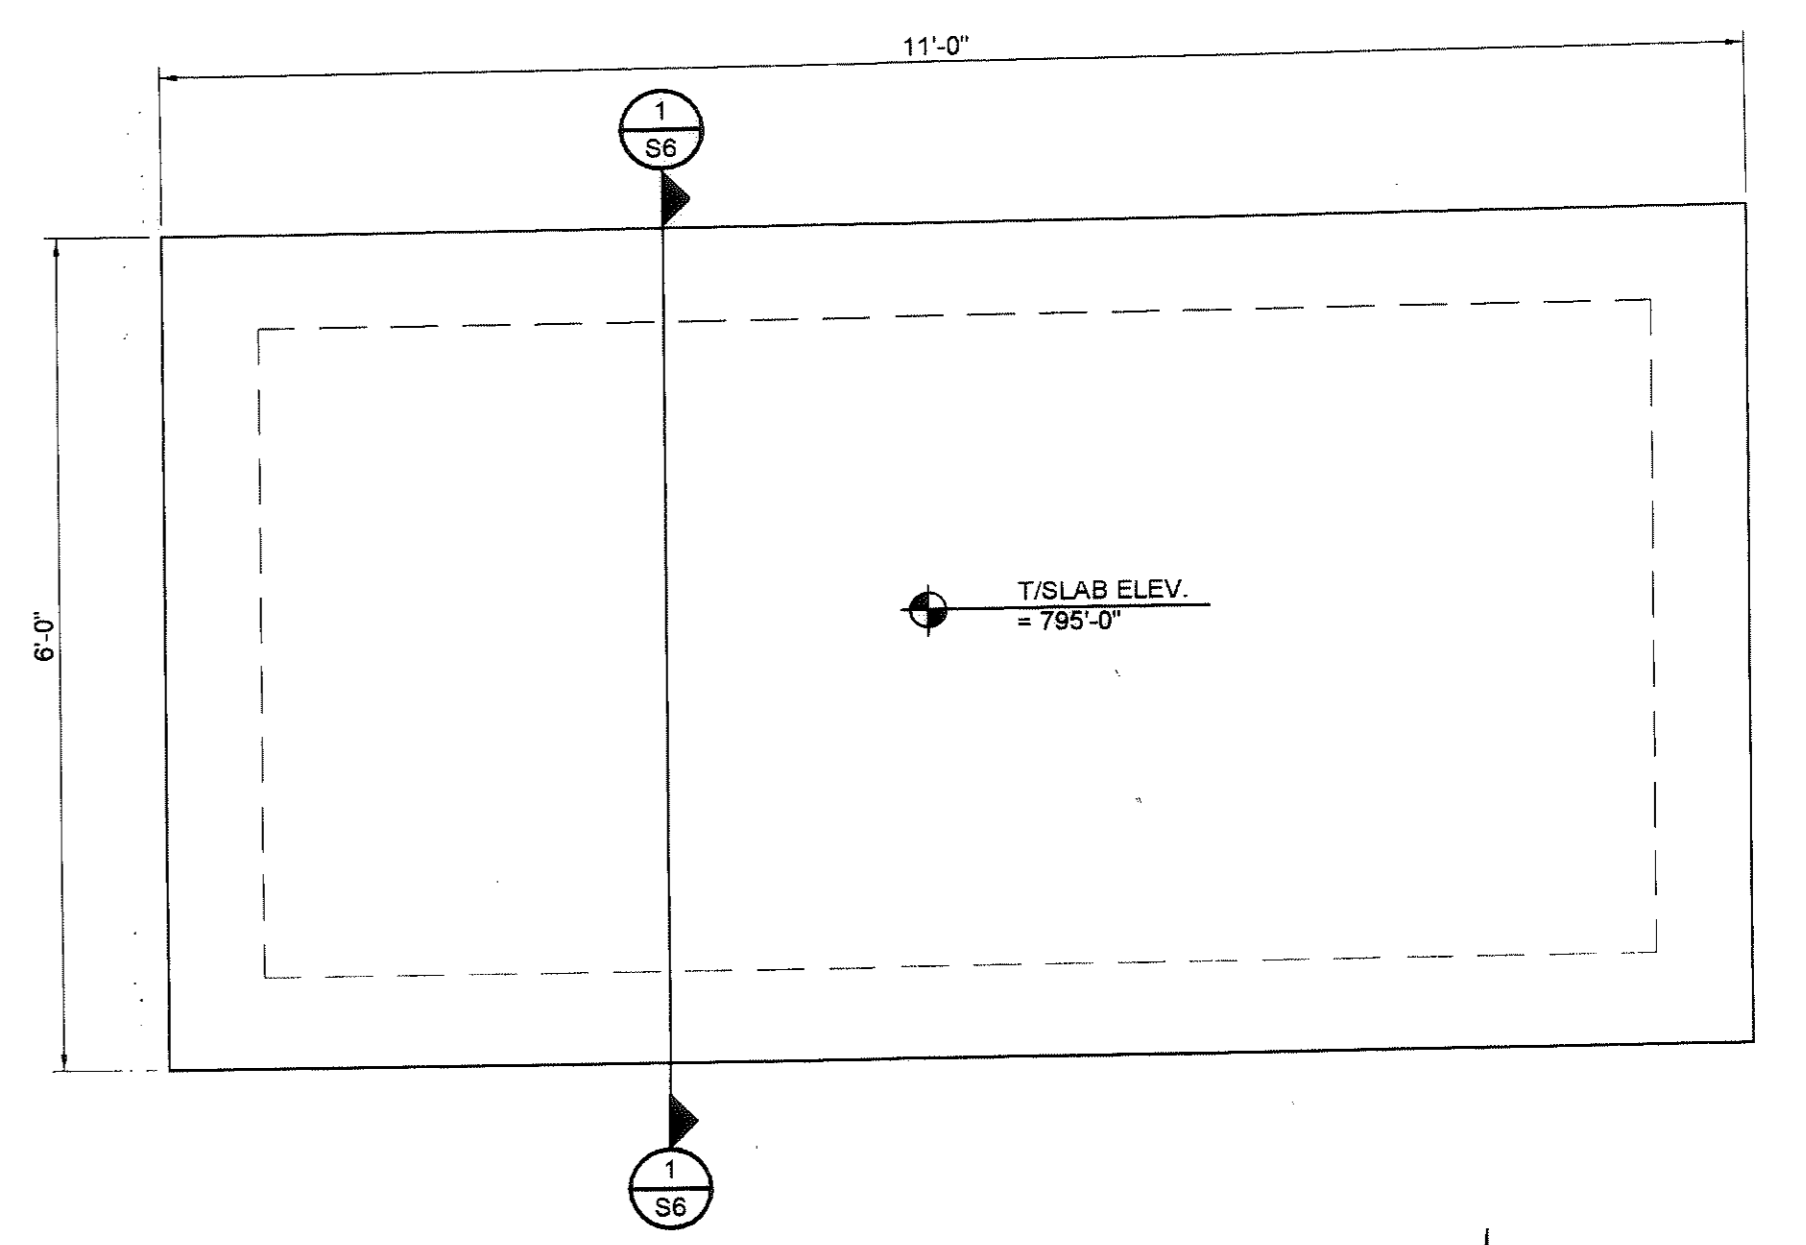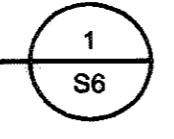

BLOWER SUPPORT PAD

SCALE: 3/4" = 1'-0"

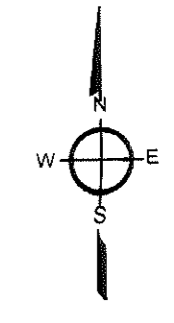

PLAN NOTES:

1. SEE SHEET S1 FOR GENERAL STRUCTURAL NOTES.
2. SEE SHEET S2 FOR TYPICAL DETAILS.
3. GENERAL CONTRACTOR TO COORDINATE ALL OPENINGS, PIPE SLEEVES, EMBED ITEMS, HANDRAILS, GRATING, ETC. WITH PROCESS DRAWINGS.
4. ALL DIMENSIONS AND ELEVATIONS SHALL BE VERIFIED PRIOR TO FABRICATION, CONSTRUCTION OR ERECTION. THE GENERAL CONTRACTOR SHALL ASSUME RESPONSIBILITY FOR ANY DISCREPANCIES.
5. SEE SITE PLAN FOR ALL FINAL GRADE ELEVATIONS.
6. SEE GEOTECHNICAL REPORT FOR ALL BACKFILLING AND COMPACTION REQUIREMENTS BEHIND WALLS AND UNDER BASE SLABS.

REVISED "AS-BUILT" DRAWING

THIS DRAWING HAS BEEN REVISED IN ACCORDANCE WITH NOTES ON "RECORD DRAWINGS" FURNISHED BY THE CONTRACTOR AND WITH EXECUTED CHANGE ORDERS. TO THE BEST OF OUR KNOWLEDGE AND BELIEF, THIS DRAWING SHOWS ACTUAL "AS-BUILT" CONDITIONS.


REVISOR: **COMMONWEALTH ENGINEERS, INC.** REVISED DATE: 10/06
BY: lew, OK BY: lew

COPYRIGHT NOTICE: THIS ENGINEERING DRAWING IS GIVEN IN CONFIDENCE AND SHALL BE USED ONLY PURSUANT TO THE AGREEMENT WITH CE SOLUTIONS, INC. NO OTHER USE, DISSEMINATION OR DUPLICATION MAY BE MADE WITHOUT PRIOR WRITTEN CONSENT OF CE SOLUTIONS, INC. ALL COMMON LAW RIGHTS OF COPYRIGHT AND OTHERWISE ARE HEREBY SPECIFICALLY RESERVED.
CE SOLUTIONS, INC. PROJ. NO. 03-113



CE Solutions, Inc.
Structural Engineers

10 Shoshone Drive, Suite 100
Carmel, Indiana 46032
317-818-1912

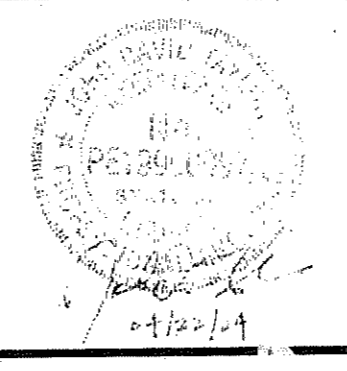

COMMONWEALTH ENGINEERS, INC.

DRAWN BY: **KDD**
DESIGNED BY: **JD**
CHECKED BY: **JD**
DATE: **3/21/11**
JOB NO: **SJ2119-01**
SCALE: **AS NOTED**

SALAMONIE RESERVOIR
WASTEWATER TREATMENT FACILITIES IMPROVEMENTS PROJECT

PUBLIC WORKS PROJECT NO. E031410M

FLUME STRUCTURE AND BLOWER PAD
FOUNDATION PLAN AND SECTIONS

DR. WING NO.
36
40 OF 52


MECHANICAL & ELECTRICAL ABBREVIATIONS

AC	AIR CONDITIONING	FFM	FEET PER MINUTE	PRESS	PRESSURE
AC	ALTERNATING CURRENT	FPS	FEET PER SECOND	PROP	PROPELLER
ADD	ADDITION	FT	FEET	PSI	POUNDS PER SQUARE INCH
AFF	ABOVE FINISHED FLOOR	FV	FACE VELOCITY	PSIA	POUNDS PER SQUARE INCH (ABSOLUTE)
ALT	ALTERNATE	FV	FULL VOLTAGE	PSIG	POUNDS PER SQUARE INCH (GAUGE)
AMB	AMBIENT	GA	GAUGE	PUH	PROPELLER UNIT HEATER
APPROX	APPROXIMATE	GALV	GALVANIZED	R22	REFRIGERANT TYPE
ATM	ATMOSPHERE	GC	GENERAL CONTRACTOR	RA	RETURN AIR RECEIVER
AUTO	AUTOMATIC	GEN	GENERATOR	RECIR	RECIRCULATING
AVG	AVERAGE	GPM	GALLONS PER MINUTE	RECT	RECTANGULAR
BDD	BACKDRAFT DAMPER	HD	HEAD	REG	REGISTER
BHP	BRAKE HORSEPOWER	HGT	HEIGHT	REINF	REINFORCED
BLDG	BUILDING	HORIZ	HORIZONTAL	REL	RELIEF
BTU	BTU	HP	HORSEPOWER	RET	RETURN
BTUH	BRITISH THERMAL UNIT/HR	HTG	HEATING	REQ'D	REQUIRED
C	CELSIUS	HVAC	HEATING, VENTILATING AND AIR CONDITIONING	REURS	REVERSING
CAP	CAPACITY	HZ	HERTZ-FREQUENCY	RH	RELATIVE HUMIDITY
CCW	COUNTERCLOCKWISE	IC	INTERCOMMUNICATION	RM	ROOM
CEIL	CEILING	ID	INSIDE DIAMETER	RPM	REVOLUTIONS PER MINUTE
CFM	CUBIC FEET PER MINUTE	IEC	INDIANA ELECTRICAL CODE	SA	SUPPLY AIR
CLG	COOLING	INCL	INCLUDE	SF	SQUARE FEET
COMP	COMPRESSOR	INSL	INSULATION	SHT	SHEET
CONC	CONCRETE	INT	INTERIOR	SP	STATIC PRESSURE
COND	CONDENSATE	INV	INVERT	SPEC	SPECIFICATIONS
CONN	CONNECTION	JB	JUNCTION BOX	SQ	SQUARE
CONST	CONSTRUCTION	KW	KILOWATT	SS	STAINLESS STEEL
CONT	CONTINUOUS	KWH	KILOWATT-HOUR	STD	STANDARD
CONTR	CONTRACTOR	LAT	LEAVING AIR TEMPERATURE	STR	STRUCTURAL
CT	CURRENT TRANSFORMER	LF	LINEAR FEET	SUP	SUPPLY
CUH	CABINET UNIT HEATER	LOC	LOCATION	SUSP	SUSPENDED
dB	DECIBELS	LVG	LEAVING	TEL	TELEPHONE
DB	DRY BULB TEMPERATURE	LWT	LEAVING WATER TEMPERATURE	T	TEMPERATURE DIFFERENCE
DEG	DEGREES	MAX	MAXIMUM	TD	TEMPERATURE DIFFERENCE
DN	DIA	MBH	THOUSANDS OF BTU'S PER HOUR	TEMP	TEMPERATURE
DISCH	DISCHARGE	MC	MECHANICAL CONTRACTOR	TEMP	TEMPORARY
DN	DOWN	MCC	MOTOR CONTROL CENTER	TOT	TOTAL
DWG	DRAWING	MCH	MECHANICAL	T*STAT	THERMOSTAT
EAT	ENTERING AIR TEMPERATURE	MFR	MANUFACTURER	TYP	TYPICAL
EC	ELECTRICAL CONTRACTOR	MIN	MINIMUM	UC	UNDERCUT
EF	EXHAUST FAN	MISC	MISCELLANEOUS	UH	UNIT HEATER
EFF	EFFICIENCY	MTD	MOUNTED	V	VOLTS
ELECT	ELECTRICAL	NA	NOT APPLICABLE	VA	VOLT-AMPERES
EL	ELEVATION	NC	NOISE CRITERIA	VAC	VOLTS AC
EMER	EMERGENCY	NC	NORMALLY CLOSED	VD	VOLUME DAMPER
ENT	ENTERING	NEC	NATIONAL ELECTRICAL CODE	VEL	VELOCITY
EQUIP	EQUIPMENT	NFPA	NATIONAL FIRE PREVENTION ASSOC.	VERT	VERTICAL
ESP	EXTERNAL STATIC PRESSURE	NIC	NOT IN CONTRACT	VOL	VOLUME
EW	ENTERING WATER TEMPERATURE	NO	NORMALLY OPEN	W	WATTS
EXH	EXHAUST	NO	NUMBER	W	W
EXIST	EXISTING	NTS	NOT TO SCALE	WB	WET BULB TEMPERATURE
EXP	EXPANSION	Ø	PHASE	W/H	WATT HOUR
EXT	EXTERIOR	OA	OUTSIDE AIR	W/O	WITHOUT
F	FAHRENHEIT	OD	OUTSIDE DIAMETER	WP	WEATHERPROOF
FA	FACE AREA	OPNG	OPENING	WT	WEIGHT
FCU	FACE COIL UNIT	OPP	OPPOSITE	WTR	WATER
FIN	FINISHED	ORIG	ORIGINAL	XFR	TRANSFORMER
FLEX	FLEXIBLE	PD	PRESSURE DROP		
FLR	FLOOR	PREFAB	PREFABRICATED		

MECHANICAL PIPING SYMBOLS



VALVE AND FITTING SYMBOLS

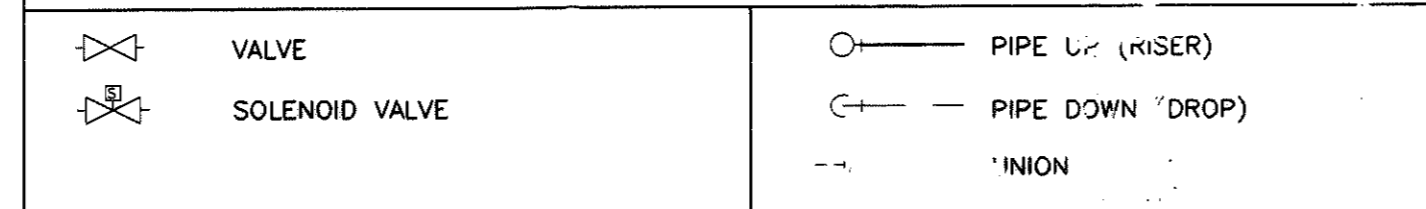

* ARROWS INDICATE DIRECTION OF FLOW ONLY
 ** ARROWS INDICATE DIRECTION OF DOWNWARD SLOPE

SHEETMETAL SYMBOLS

24"x10"	SUPPLY DUCT (SECTION) 1ST FIGURE IS TOP DIMENSION	D or R	CHANGE IN ELEVATION OF DUCT (R) RISE OR (D) DROP ARROW INDICATES DIRECTION
24"x10"	RETURN, EXHAUST, RELIEF OR INTAKE DUCT (SECTION)	VD	BRANCH DUCT TAKE-OFF 45° SHOE TAP 6" LONG
24"x10"	RECTANGULAR DUCT 1ST FIGURE IS SIDE SHOWN 2ND FIGURE IS SIDE NOT SHOWN	VD	TURNING VANES TRAILING EDGE PER SMACNA
12"Ø	ROUND DUCT (FIGURE INDICATES DIAMETER)	VD	VOLUME DAMPER
OR	FLEXIBLE DUCT	BDD	BACKDRAFT DAMPER
OR	SQUARE DIFFUSER ALL DIFFUSERS ARE 4-WAY UNLESS OTHERWISE NOTED	M	MOTORIZED DAMPER
OR	EXHAUST AIR OR RETURN AIR INLET	12X12 400	REGISTER, GRILLE, DIFFUSER TYPE NECK SIZE CFM
7'-0"	SUPPLY/RETURN REGISTER/GRILLE DIMENSION INDICATES HEIGHT OF BOTTOM AFF	(T) TH	THROAT
OR	SUPPLY AIR DIRECTION, RETURN AIR, EXHAUST AIR, OR RELIEF AIR DIRECTION	OR	ROOF EXHAUST FAN
OR		OR	ROOF VENT

NOTE: DUCT DIMENSIONS SHOWN INSIDE A BOX "24"x10" * INDICATES DUCT SHALL BE 1" INTERNALLY INSULATED.

MECHANICAL GENERAL NOTES

- CONTRACTOR SHALL REFER TO THE SPECIFICATIONS FOR REQUIREMENTS RELATING TO EQUIPMENT QUALITY, CONSTRUCTION AND FINISH OF MATERIALS.
- THESE DRAWINGS INDICATE REQUIRED SIZES AND POINTS OF TERMINATION FOR PIPING, DUCTWORK, CONDUIT, ETC. THE EQUIPMENT SHOWN ILLUSTRATES SUGGESTED ROUTING, BUT ALL NECESSARY DETAILS AND FITTINGS MAY NOT BE SHOWN. CONTRACTOR SHALL INSTALL HIS WORK IN A MANNER THAT WILL CONFORM WITH THE STRUCTURE. CONTRACTOR SHALL AVOID OBSTRUCTIONS, PRESERVE CLEARANCE AND MAINTAIN MAXIMUM CLEARANCE WITHOUT FURTHER INSTRUCTION FROM THE ENGINEER AT ADDITIONAL COST TO THE OWNER. ALL DIMENSIONS SHOWN ON THESE PLANS ARE IN FEET AND INCHES UNLESS NOTED OTHERWISE.
- ALL DUCTWORK, PIPING AND VALVES SHALL BE CONCEALED ABOVE CEILINGS AND WITHIN WALLS IN FINISHED AREAS UNLESS OTHERWISE NOTED.
- ALL VALVES, COILS, DAMPERS, ETC. SHALL BE INSTALLED ALLOWING EASY ACCESS TO THEM. AREAS ADJACENT TO THE ACCESS PANELS SHALL BE CLEAR OF ANY OBSTRUCTION.
- EACH RESPECTIVE CONTRACTOR SHALL BE RESPONSIBLE FOR COORDINATING THE INSTALLATION OF HIS WORK WITH THE WORK OF OTHER CONTRACTORS PRIOR TO THE INSTALLATION.
- CONTRACTOR SHALL BE GUIDED BY THE ARCHITECT'S REFLECTED CEILING PLAN FOR EXACT LOCATION OF DIFFUSERS, REGISTERS AND GRILLES UNLESS OTHERWISE NOTED.
- ALL EXISTING EQUIPMENT, DUCTWORK AND PIPING LOCATIONS AND SIZES SHALL BE FIELD VERIFIED, PRIOR TO CONSTRUCTION, BY THE CONTRACTOR.
- ALL EQUIPMENT SHALL BE OF, AND CONSIST OF AT LEAST THE MINIMUM SIZES SCHEDULED.
- ARROWS ON CONDENSATE PIPING AND DRAIN LINES INDICATE THE DOWNWARD PITCH OF THE PIPING.
- DUCTS PENETRATING FLOOR SLABS AND/OR WALLS SHALL BE SEALED AS REQUIRED BY CODE. DUCTS PENETRATING FIRE RATED WALLS AND/OR FLOORS SHALL HAVE OPENING AROUND DUCT SEALED WITH A MATERIAL HAVING THE SAME FIRE RATING AS THE WALL OR FLOOR. PROVIDE FIRE DAMPERS AT ALL DUCT PENETRATIONS THROUGH FIRE RATED WALLS OR FLOORS.
- ALL SHEETMETAL DUCT SIZES SHOWN ARE ACTUAL SHEETMETAL DIMENSIONS; DUCTS ARE SIZED TO ALLOW FOR ONE INCH INTERNAL INSULATION WHERE INDICATED ON DRAWINGS.
- INSTALL VOLUME DAMPER AT EACH BRANCH TAKEOFF FROM MAIN SUPPLY AIR AND RETURN AIR DUCTS.
- ALL WALL SPACE THERMOSTATS AND SPACE TEMPERATURE SENSORS SHALL BE 4'-0" ABOVE FINISHED FLOOR TO BOTTOM. LOCATE FURTHEST FROM DOOR FRAME IF SHOWN NEAR WALL MOUNTED LIGHT SWITCHES, UNLESS OTHERWISE NOTED OR DIRECTED BY THE ARCHITECT.
- COORDINATION OF WORK
 - EACH CONTRACTOR IS RESPONSIBLE TO COORDINATE HIS WORK WITH THE WORK OF OTHER TRADES. SUCH COORDINATION REQUIRES THAT EACH CONTRACTOR MAKE AVAILABLE SPECIFIC INFORMATION ABOUT HIS WORK IN THE FORM OF DETAILED FABRICATION DRAWINGS, CERTIFIED SHOP DRAWINGS AND ERECTION DRAWINGS, WHICH ARE TO BE KEPT ON FILE AT THE JOB SITE. SEE SPECIFICATIONS FOR DETAILED INFORMATION ABOUT SUBMITTALS.
 - DUE TO THE SMALL SCALE OF THESE DRAWINGS, IT IS NOT POSSIBLE TO SHOW ALL MINOR DETAILS AND DEVIATIONS NECESSARY TO COORDINATE PIPING AND DUCTWORK WITH THE BUILDING STRUCTURE, ELECTRICAL CONDUIT AND LIGHTING SYSTEMS. EACH CONTRACTOR SHALL BE RESPONSIBLE TO PLAN AND COORDINATE HIS WORK AS NECESSARY TO COMPENSATE FOR MINOR DEVIATIONS.
- ALL PIPING SHALL BE RUN TO AVOID DUCTWORK, ELECTRICAL LIGHTS, BEAMS AND OTHER STRUCTURAL MEMBERS.
- THIS CONTRACTOR SHALL VERIFY ALL EXISTING CONDITIONS AT THE JOB SITE.
- THESE DRAWINGS ARE PREPARED FROM THE ORIGINAL CONSTRUCTION DOCUMENTS OF THE BUILDING. THE DRAWINGS ARE NOT REPRESENTED TO BE "AS-BUILT" DRAWINGS AND DISCREPANCIES BETWEEN THE DRAWINGS AND ACTUAL FIELD CONDITIONS CAN BE EXPECTED. THE BIDDER SHALL INVESTIGATE ACTUAL FIELD CONDITIONS PRIOR TO BIDDING THE WORK TO BECOME FAMILIAR WITH THE EXISTING CONDITIONS.
- CONTRACTOR SHALL FIELD VERIFY EXACT SIZE AND LOCATION OF EXISTING PIPING PRIOR TO INSTALLATION. NOTIFY ENGINEER OF ANY DISCREPANCIES IMMEDIATELY.
- CONTRACTOR TO VERIFY EXACT LOCATION OF EXISTING EQUIPMENT, DUCTWORK AND PIPING, AND COORDINATE DUCT AND PIPE TO BE INSTALLED WITH SAME.
- ALL FLOOR, WALL AND CEILING FINISHES WHICH ARE TO BE CUT AND PATCHED BY THIS CONTRACTOR IN ACCORDANCE WITH THE SPECIFICATION REQUIREMENTS. ALL AREAS DISTURBED BY CONSTRUCTION SHALL BE RESTORED TO MATCH EXISTING.
- CORE DRILL ALL PIPE PENETRATIONS THROUGH EXISTING CONCRETE WALLS AND FLOORS.

ELECTRICAL SYMBOLS

	CEILING OUTLET - SURFACE OR SUSPENDED TYPE FIXTURE
	CEILING OUTLET - RECESSED TYPE FIXTURE
	A=FIXTURE TYPE - B2=BRANCH CIRCUIT - C=SWITCH LEG
	FLUORESCENT TYPE FIXTURE - SURFACE MTD OR SUSPENDED
	FLUORESCENT TYPE FIXTURE - RECESSED
	WALL OUTLET
	DENOTES FIXTURE WITH FLUORESCENT BATTERY INVERTER UNIT
	SWITCH - S ₃ = 3-WAY S ₄ = 4-WAY S _{4M} = MOMENTARY (+48)
	RECEPTACLE - 20 AMP - 125 VOLT DUPLEX (+18)
	RECEPTACLE - 20 AMP - 125 VOLT DUPLEX (+48) ABOVE COUNTER
	RECEPTACLE - 250V N=NUMBER OF ACTIVE POLES R=AMPERAGE RATING
	RECEPTACLES MOUNTED IN SURFACE RACEWAY
	RECEPTACLE - 20 AMP - 125 VOLT DUPLEX W/SOLATED GROUND
	RECEPTACLE - 20 AMP - 125 VOLT DOUBLE DUPLEX
	JUNCTION OR PULLBOX
	TELECOMMUNICATIONS OUTLET (+18)
	FUSED SAFETY SWITCH
	DISCONNECT SWITCH (C = BY OTHERS)
	MOTOR STARTER 2=STARTER NUMBER
	PANELBOARD (A = DESIGNATION)
	SINGLE PHASE MOTOR
	NUMBER OF WIRES IN CONDUIT (I = GROUNDING CONDUCTOR)
	INDICATES DETAIL "A" ON SHEET #E-4

ELECTRICAL GENERAL NOTES

1. NOTED HEIGHTS ARE TO THE BOTTOM OF THE DEVICE, EQUIPMENT, LIGHTING FIXTURE, ETC. HEIGHTS INDICATED ARE APPROXIMATE AND FOR ESTIMATING PURPOSES ONLY, EXCEPT AS SPECIFICALLY NOTED. ROUGH-IN HEIGHTS AND LOCATIONS SHALL BE COORDINATED WITH UNIT DIMENSIONS AND ADJACENT CASEWORK, GENERAL CONSTRUCTION, EQUIPMENT, ETC. COORDINATE WITH THE WORK OF OTHER TRADES AND THE OWNER.

REVISED "AS-BUILT" DRAWING
 THIS DRAWING HAS BEEN REVISED IN ACCORDANCE WITH NOTES ON "RECORD DRAWINGS" FURNISHED BY THE CONTRACTOR AND WITH EXECUTED CHANGE ORDERS. TO THE BEST OF OUR KNOWLEDGE AND BELIEF, THIS DRAWING SHOWS ACTUAL AS-BUILT CONDITIONS.
 COMMONWEALTH ENGINEERS, INC. REVISED DATE 10/06
 BY JEW, CK BY (u.w.)

Rotz Engineers

STATE OF INDIANA
 PROFESSIONAL ENGINEER
 No. PE19900470



COMMONWEALTH ENGINEERS, INC.

DRAWN BY: LTG/RCL
 DESIGNED BY: JTH/SDL
 CHECKED BY: RMS/GAMC
 DATE: 3/04
 JOB NO: 6038S
 SCALE: AS NOTED

SALAMONIE RESERVOIR
 WASTEWATER TREATMENT PLANT IMPROVEMENTS PROJECT
 PUBLIC WORKS PROJECT NO. E031410M
 MECHANICAL AND ELECTRICAL
 SYMBOLS, ABBREVIATIONS AND GENERAL NOTES

DRAWING NO.
ME1
 42 OF 52

301-63

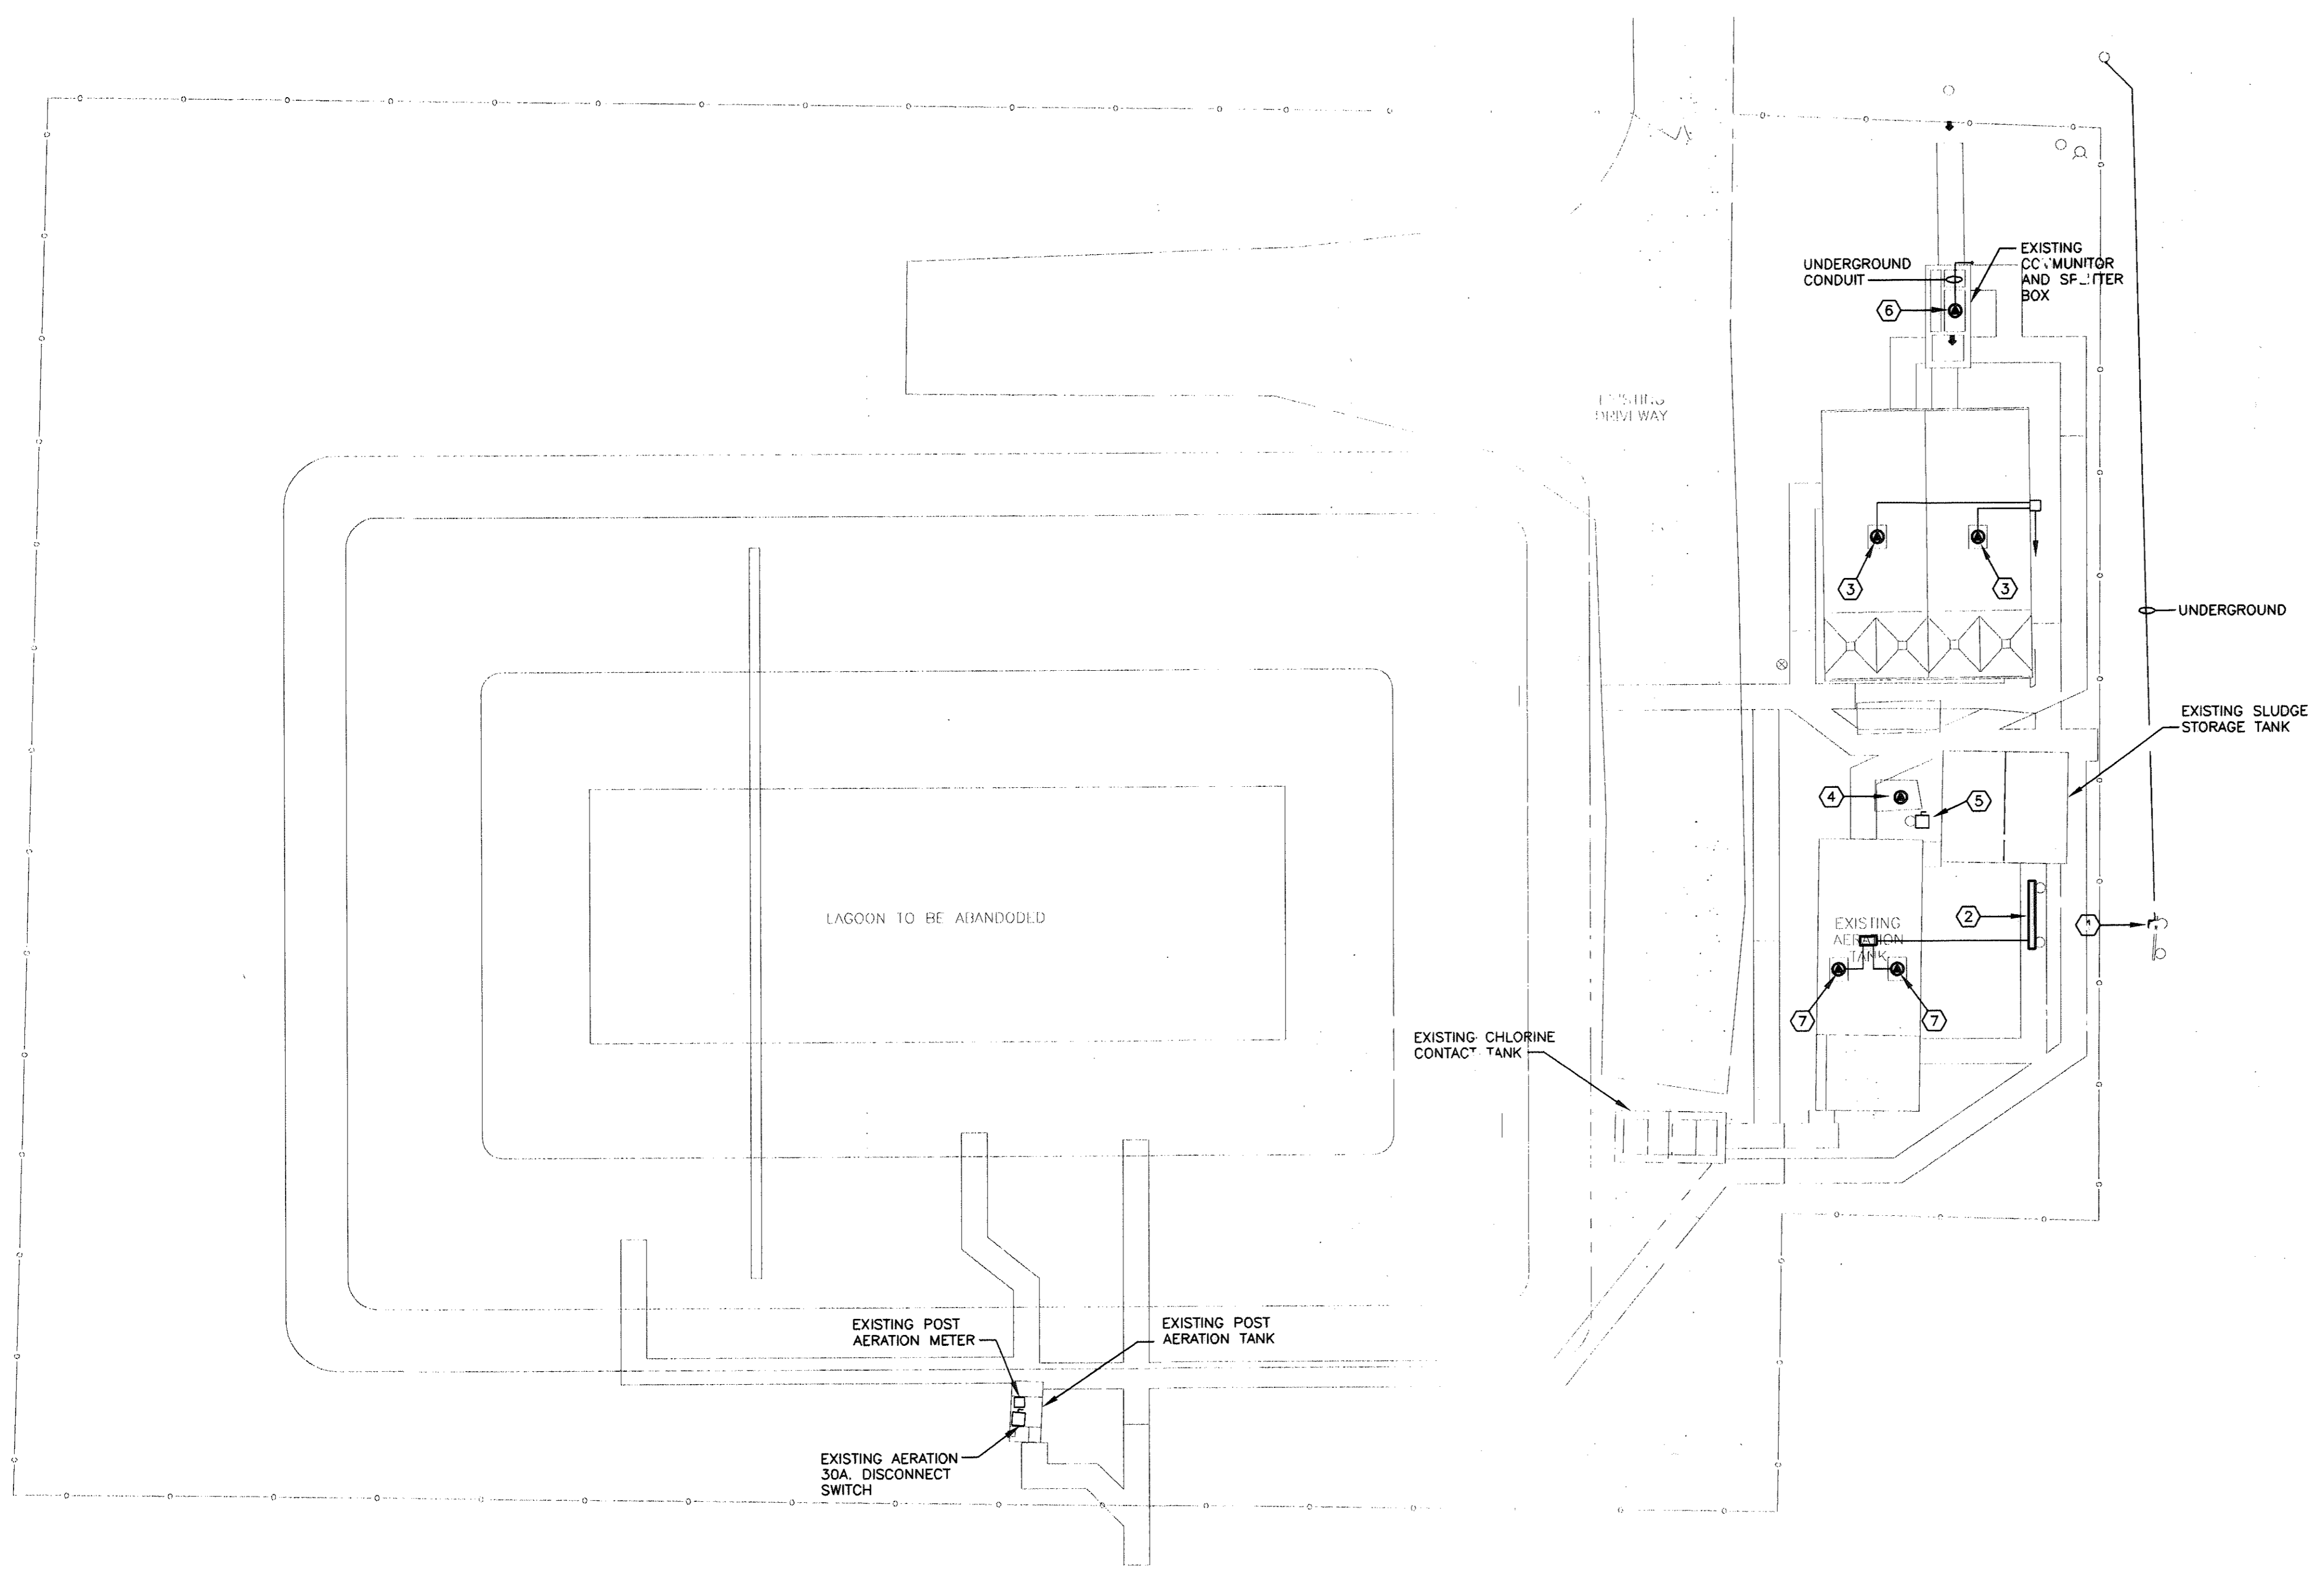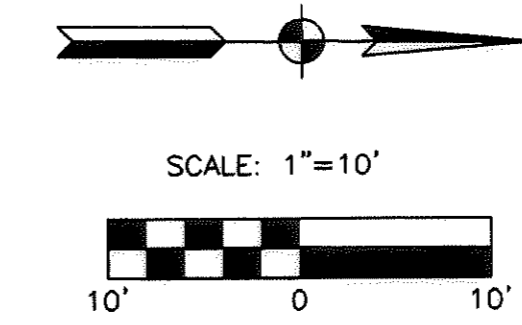

- ELECTRICAL - DEMOLITION PLAN NOTES:**
- ① EXISTING SERVICE METER SHALL REMAIN IN SERVICE UNTIL THE END OF THE PROJECT.
 - ② EXISTING CONTROL PANEL SHALL REMAIN IN SERVICE UNTIL THE END OF THE PROJECT.
 - ③ EXISTING BLOWER; 5HP, 240V., 1Ø.
 - ④ EXISTING POST AERATION DIGESTER; 3HP, 240V., 1Ø. TO REMAIN IN SERVICE UNTIL THE END OF PROJECT.
 - ⑤ EXISTING DISCONNECT SWITCH SERVING THE POST AERATION DIGESTER; 240V., 1Ø, 30A.
 - ⑥ EXISTING COMMUNICATOR; 1/2HP, 240V., 1Ø.
 - ⑦ EXISTING BLOWER; 5HP, 240V., 1Ø. TO REMAIN IN SERVICE UNTIL END OF PROJECT.

- ELECTRICAL - DEMOLITION GENERAL NOTES:**
- 1.) COORDINATE THE DEMOLITION WORK WITH NEW CONSTRUCTION. PORTIONS OF THE EXISTING WASTEWATER TREATMENT PLANT SHALL REMAIN IN OPERATION DURING THE NEW CONSTRUCTION.

HOLEY MOLEY SAYS
'DON'T DIG BLIND'



CALL 2 WORKING DAYS BEFORE YOU DIG
1-800-382-5544
GIT'S THE LAW

REVISED "AS-BUILT" DRAWING

THIS DRAWING HAS BEEN REVISED IN ACCORDANCE WITH NOTES ON "RECORD DRAWINGS" FURNISHED BY THE CONTRACTOR AND WITH EXECUTED CHANGE ORDERS. TO THE BEST OF OUR KNOWLEDGE AND BELIEF, THIS DRAWING SHOWS ACTUAL "AS-BUILT" CONDITIONS.

REVISOR: JTH/SDL
DATE: 10/06
BY: JKL, OK BY: CLW

**MECHANICAL AND ELECTRICAL
TREATMENT PLANT DEMOLITION PLAN**
SCALE: 1"=10'-0"

Rotz Engineers
INC

3071 REGISTERED ENGINEER
STATE OF NEW JERSEY
PE1-900470

COMMONWEALTH ENGINEERS, INC.

DRAWN BY:	LTG/RCL
DESIGNED BY:	JTH/SDL
CHECKED BY:	RMS/GAMc
DATE:	3/04
JOB NO.:	6038S
SCALE:	AS NOTED

SALAMONIE RESERVOIR WASTEWATER TREATMENT PLANT IMPROVEMENTS PROJECT
PUBLIC WORKS PROJECT NO. E031410M
MECHANICAL AND ELECTRICAL TREATMENT PLANT DEMOLITION PLAN

DRAWING NO.
ME2
43 OF 52

301-63

ROOF VENT SCHEDULE

NO.	DESIGNATION	CFM	THROAT AREA SQ. FT.	ROOF OPNG " DIA.	HOOD SIZE " DIA.	NECK VELO FPM	NOTES	MANUFACTURER OR EQUAL
1	AIR INTAKE	400	.57	10.25	20.5	700	1,2	"GREENHECK" MODEL GRS-10

- NOTES:
 1. ALL ALUMINUM CONSTRUCTION PROVIDE BIRD SCREEN.
 2. ROOF VENT SHALL BE LOCATED MIN. OF +10'-0" AWAY FROM EXH. FAN, GAS VENT OR ANY OTHER DEVICE REJECTING POLLUTED AIR.

GRILLE AND DIFFUSER SCHEDULE

TYPE	STYLE	DESCRIPTION	MAX. N.C. LEVEL	NOTES	MANUFACTURER OR EQUAL
(A)	DIFFUSER	12"x12" FACE, 6" DIA. NECK	35	1	"TITUS" MODEL TMS
(B)	DIFFUSER	12"x12" FACE, 7" DIA. NECK	35	1	"TITUS" MODEL TMS
(C)	DIFFUSER	12"x12" FACE, 8" DIA. NECK	35	1	"TITUS" MODEL TMS
(1)	GRILLE	EGGCRATE, 1/2"x1/2"x1/2"	25	1,2	"TITUS" MODEL 50F
(2)	GRILLE	1/2" SPACING, 45° DEFLECTION	25	2	"TITUS" MODEL 4FL

- NOTES:
 1. PROVIDE 24"x24" PANEL FOR MOUNTING IN LAY-IN CEILING WHERE REQUIRED.
 2. ALL ALUMINUM CONSTRUCTION.

ELECTRIC UNIT HEATER SCHEDULE

NO.	LOCATION	STYLE		FAN DATA				HEATING DATA				MOUNTING ARRANGEMENT	NOTES	MANUFACTURER OR EQUAL	
		UH	CUH	CFM	AMPS	VOLTS	φ	SPEED	MBH	E.A.T. °F	L.A.T. °F				KW
CUH-1	TOILET/SHOWER			65	8.4	120	1	1	3.4	50	98	1.0	WALL-RECESSED	1,2	"Q-MARK" MODEL CWH-21-1

- NOTES:
 1. SLEEVE FOR RECESSED MOUNTING AND BUILT-IN THERMOSTAT PROVIDED BY UNIT MANUFACTURER.
 2. UNIT SHALL BE MTD 6" A.F.F. TO BOTTOM.

DUCT MOUNTED ELECTRIC HEATING COIL SCHEDULE


UNIT NO.	LOCATION	AREA SERVED	MBH	CFM	NO. OF STEPS	KW	VOLTS	PHASE	E.A.T. °F	L.A.T. °F	MAX. AIR P.D.	SIZE		NOTES	MANUFACTURER OR EQUAL
												H"	W"		
1	ATTIC	LABORATORY	20.5	300	2	6.0	240	1	0	63	.05"	8	12	1	"INDEECO" MODEL TFQU FIN TUBULAR TYPE

- NOTES:
 1. PROVIDE ELECTRONIC CONTROLS INCLUDING THERMAL CUTOUPS, AIR PRESSURE SWITCH, PROTECTIVE FUSES, CONTROL TRANSFORMER, ROOM THERMOSTAT, ETC.

FAN SCHEDULE


HP	VOLTS	PHASE	SPEED	NO.	DESIGNATION	LOCATION	CFM	S.P. "WG	RPM	DRIVE	SONES	ROOF OPENING	NOTES	MANUFACTURER OR EQUAL
1/4	120	1	1	1	EXHAUST	TOILET	100	0.375	990	BELT	3.5	12-1/2" x 12-1/2"	1,2,3	"GREENHECK" MODEL GB-70-4
1/4	120	1	1	2	EXHAUST	LABORATORY	300	0.375	1250	BELT	6.0	12-1/2" x 12-1/2"	1,2,3,5	"GREENHECK" MODEL GB-80-4
1/4	120	1	1	3	SUPPLY	LABORATORY	300	0.5	1300	BELT	10.0	-	1,4,5	"GREENHECK" MODEL BSQ-80-4

- NOTES:
 1. ALL ALUMINUM CONSTRUCTION WITH A HERESITE COATING.
 2. PREFABRICATED ROOF CURB, BACKDRAFT DAMPER, BIRD SCREEN, AND DISCONNECT SWITCH PROVIDED BY FAN MANUFACTURER.
 3. ROOF MTD. CENTRIFUGAL FAN.
 4. IN-LINE CENTRIFUGAL FAN.
 5. FAN #2 & #3 SHALL BE INTERLOCKED TO OPERATE TOGETHER.

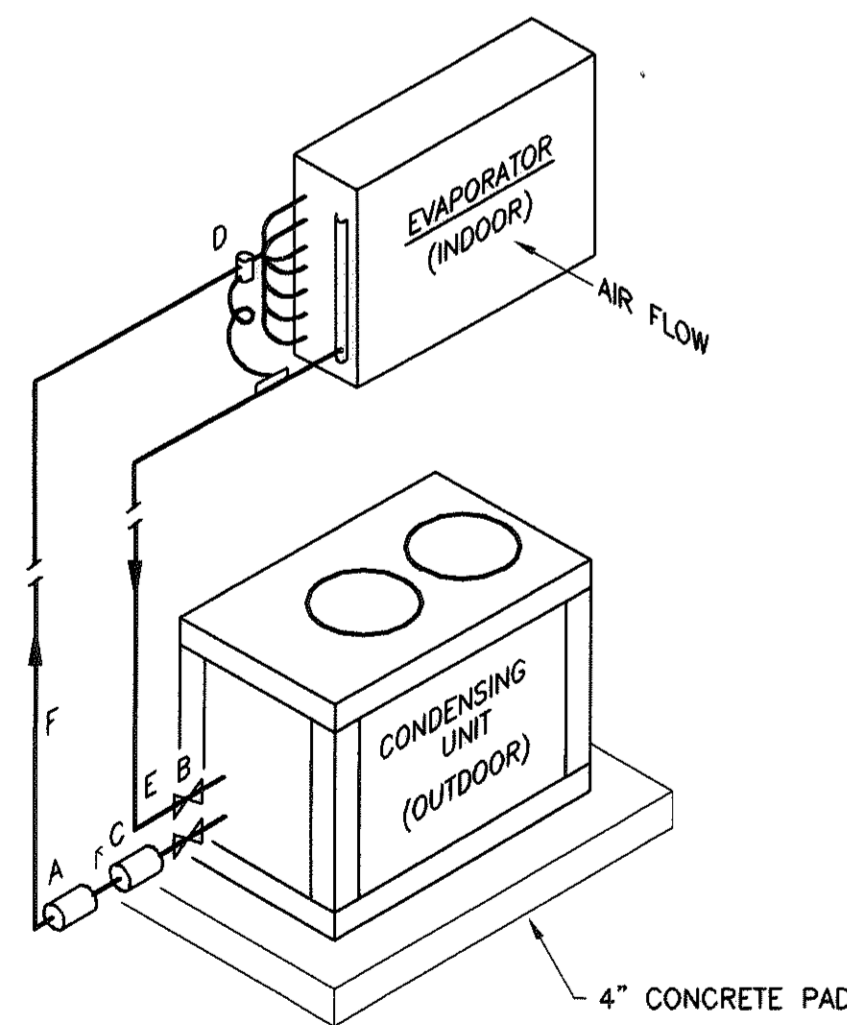


- NOTES:
 1. PITCH ALL HORIZONTAL LINES A MINIMUM OF 1/2" IN 10 FEET IN DIRECTION OF REFRIGERANT FLOW
 2. INSULATE ALL SUCTION LINES WITH 3/4" THICK ELASTOMERIC FOAM INSULATION (25/50)
 3. WRITTEN APPROVAL FROM UNIT MFR. FOR ALL LINES & VALVE SIZES AND EXACT LINE ROUTING MUST BE OBTAINED BEFORE CONSTRUCTION BEGINS.


- LEGEND
 A FILTER-DRIER
 B SHUT OFF VALVE
 C SIGHTGLASS/MOISTURE INDICATOR
 D THERMAL EXP. VALVE OR METERING DEVICE
 E SUCTION LINE, PITCHED TOWARD COMPRESSOR
 F LIQUID LINE

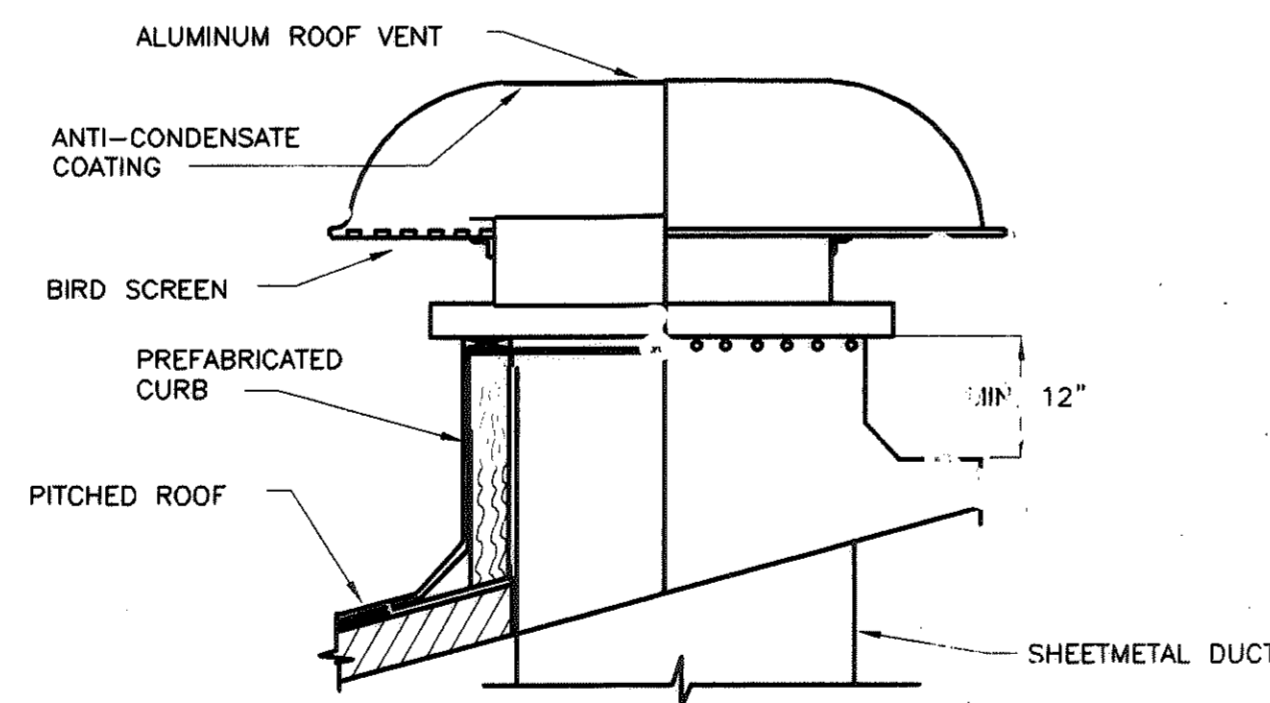

ROOF VENT DETAIL
NO SCALE

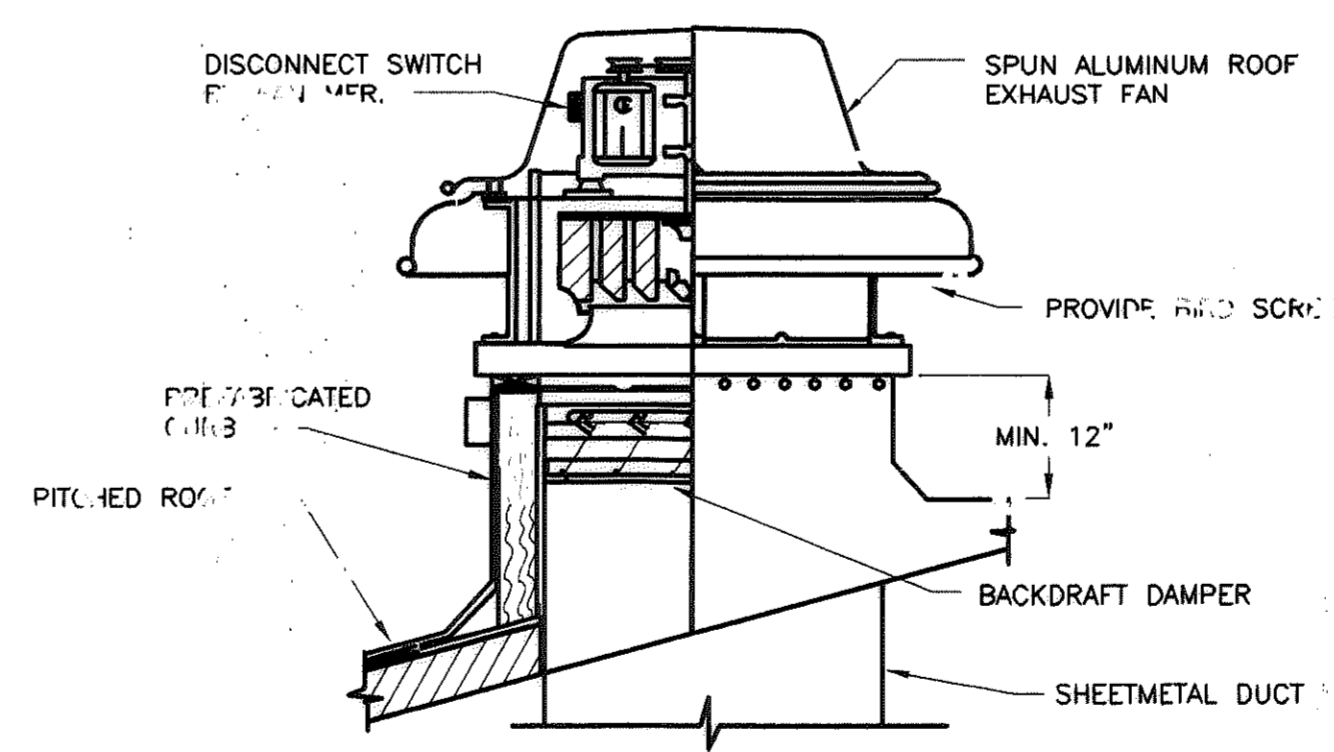

EXHAUST FAN DETAIL
NO SCALE

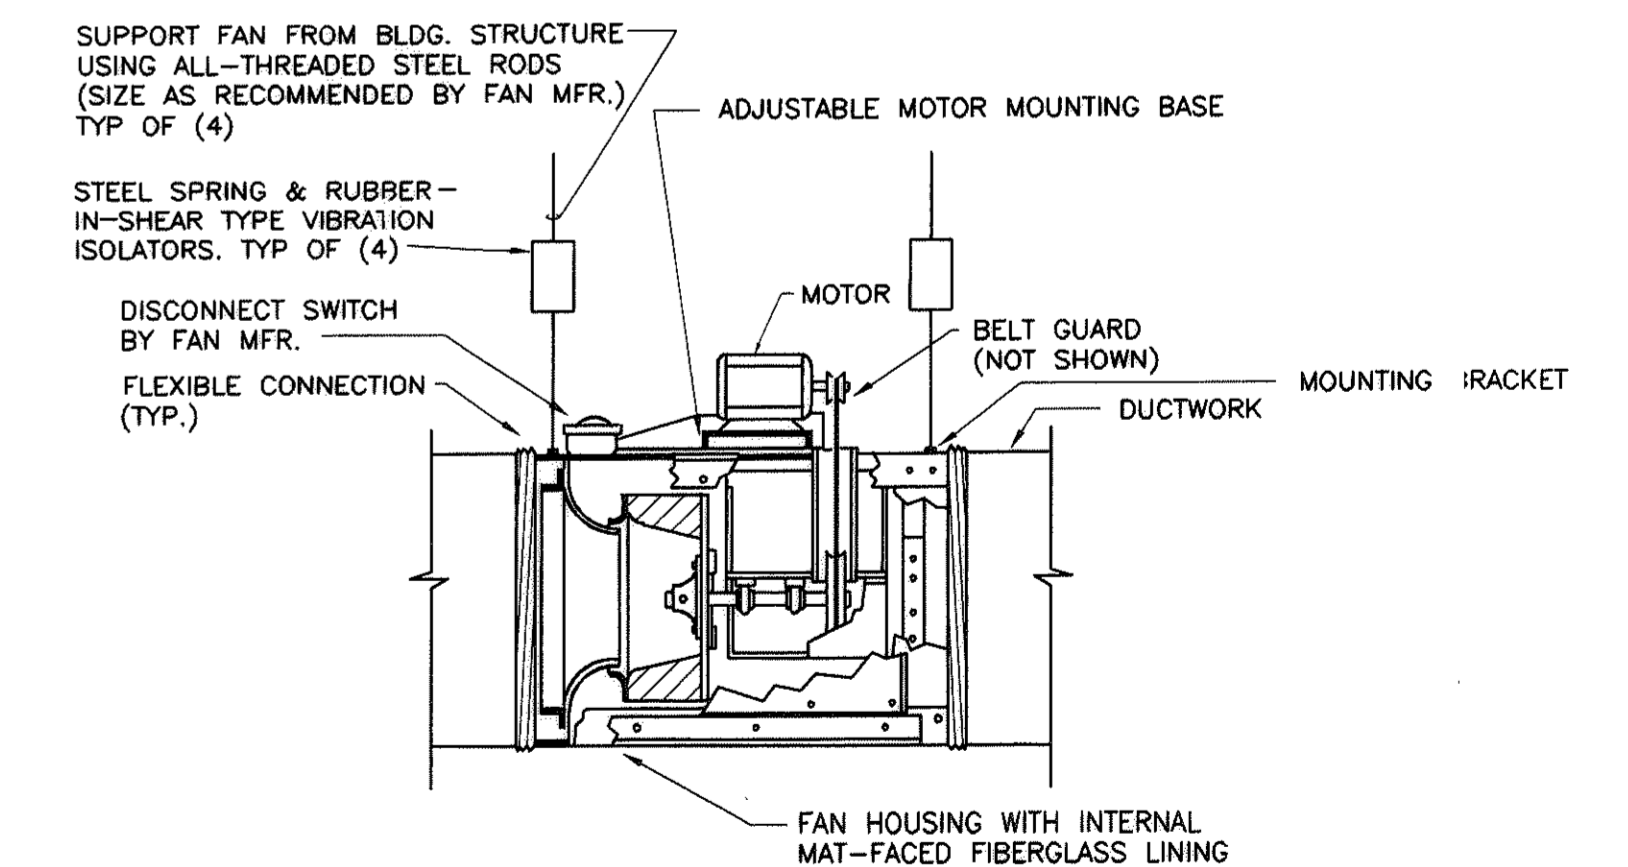


CENTRIFUGAL IN-LINE FAN DETAIL
NO SCALE

REFRIGERANT PIPING DETAIL
NO SCALE

REVISED "AS-BUILT" DRAWING
 THIS DRAWING HAS BEEN REVISED IN ACCORDANCE WITH NOTES ON "RECORD DRAWINGS" FURNISHED BY THE CONTRACTOR AND WITH EXECUTED CHANGE ORDERS. TO THE BEST OF OUR KNOWLEDGE AND BELIEF, THIS DRAWING SHOWS ACTUAL "AS-BUILT" CONDITIONS.
 REVISED DATE: 10/06
 BY: JEM, CK BY: LWB

Rotz Engineers

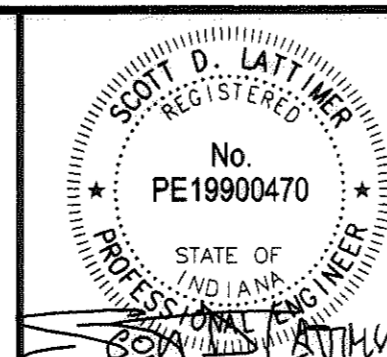

COMMONWEALTH ENGINEERS, INC.

DRAWN BY: RCL
 DESIGNED BY: GAMc
 CHECKED BY: GAMc
 DATE: 3/04
 JOB NO: 6038S
 SCALE: NONE

SALAMONIE RESERVOIR
 WASTEWATER TREATMENT PLANT IMPROVEMENTS PROJECT
 PUBLIC WORKS PROJECT NO. E031410M
 MECHANICAL SCHEDULES AND DETAILS


DRAWING NO.
M1
 45 OF 52

(NOTE: THIS SHEET PART OF ALTERNATE BID)

EQUIPMENT NOTES:

HEAT PUMP - INDOOR UNIT - NOMINAL 2 TONS COOLING CAPACITY. 18.0 MBH HEATING CAPACITY AT 47°F OUTDOOR TEMP. 670 CFM AT 0.4" E.S.P. THE EXTERNAL STATIC PRESSURE OF 0.4" SHALL BE AVAILABLE AFTER COOLING COIL, HEATING COIL AND FILTER ARE INSTALLED. 100 CFM OF OUTSIDE AIR. 230V, SINGLE PHASE, SINGLE POINT POWER SUPPLY. 1/4 HP, 3 SPEED BLOWER MOTOR. INTEGRAL 8.0 KW, MULTI-STAGE RESISTANCE ELECTRIC SUPPLEMENTAL HEATING COIL. REFRIGERANT COIL WITH 2.23 SQ. FT. OF FACE AREA AND R-22 TYPE REFRIGERANT. FILTER RACK, REFRIGERANT COIL MULTI-STAGE SUPPLEMENTAL HEATING COIL AND RETURN AIR PLENUM SHALL BE PROVIDED BY UNIT MANUFACTURER. UNIT SHALL BE PROVIDED WITH ALL OPERATING & SAFETY CONTROLS INCLUDING LIMIT SWITCHES, CIRCUIT BREAKERS, SEQUENCER, CONTROL TRANSFORMER, OUTDOOR THERMOSTAT FOR SUPPLEMENTAL HEATING COIL CONTROL, ETC. MANUFACTURER LIKE "BRYANT" MODEL FB4ANBC024008.

HEAT PUMP - OUTDOOR UNIT - 230 VOLT, SINGLE PHASE POWER SUPPLY. COMPRESSOR RLA = 10.4, CONDENSER FAN MOTOR = 1/12 HP UNIT SHALL HAVE ALL OPERATING & SAFETY CONTROLS, INCLUDING INDOOR FAN TIME DELAY RELAY, LOW AMBIENT CONTROLLER AND MOTOR, WINTER START CONTROL, EVAPORATOR FREEZE THERMOSTAT, OUTDOOR THERMOSTAT, SNOW STAND ETC. PROVIDED BY UNIT MANUFACTURER. NOMINAL 1.5 TON COOLING CAPACITY AT 95°F AMBIENT TEMP. AND 18.0 MBH HEATING CAPACITY AT 47°F AMBIENT TEMP. MANUFACTURER LIKE "BRYANT" MODEL 693D018-C.

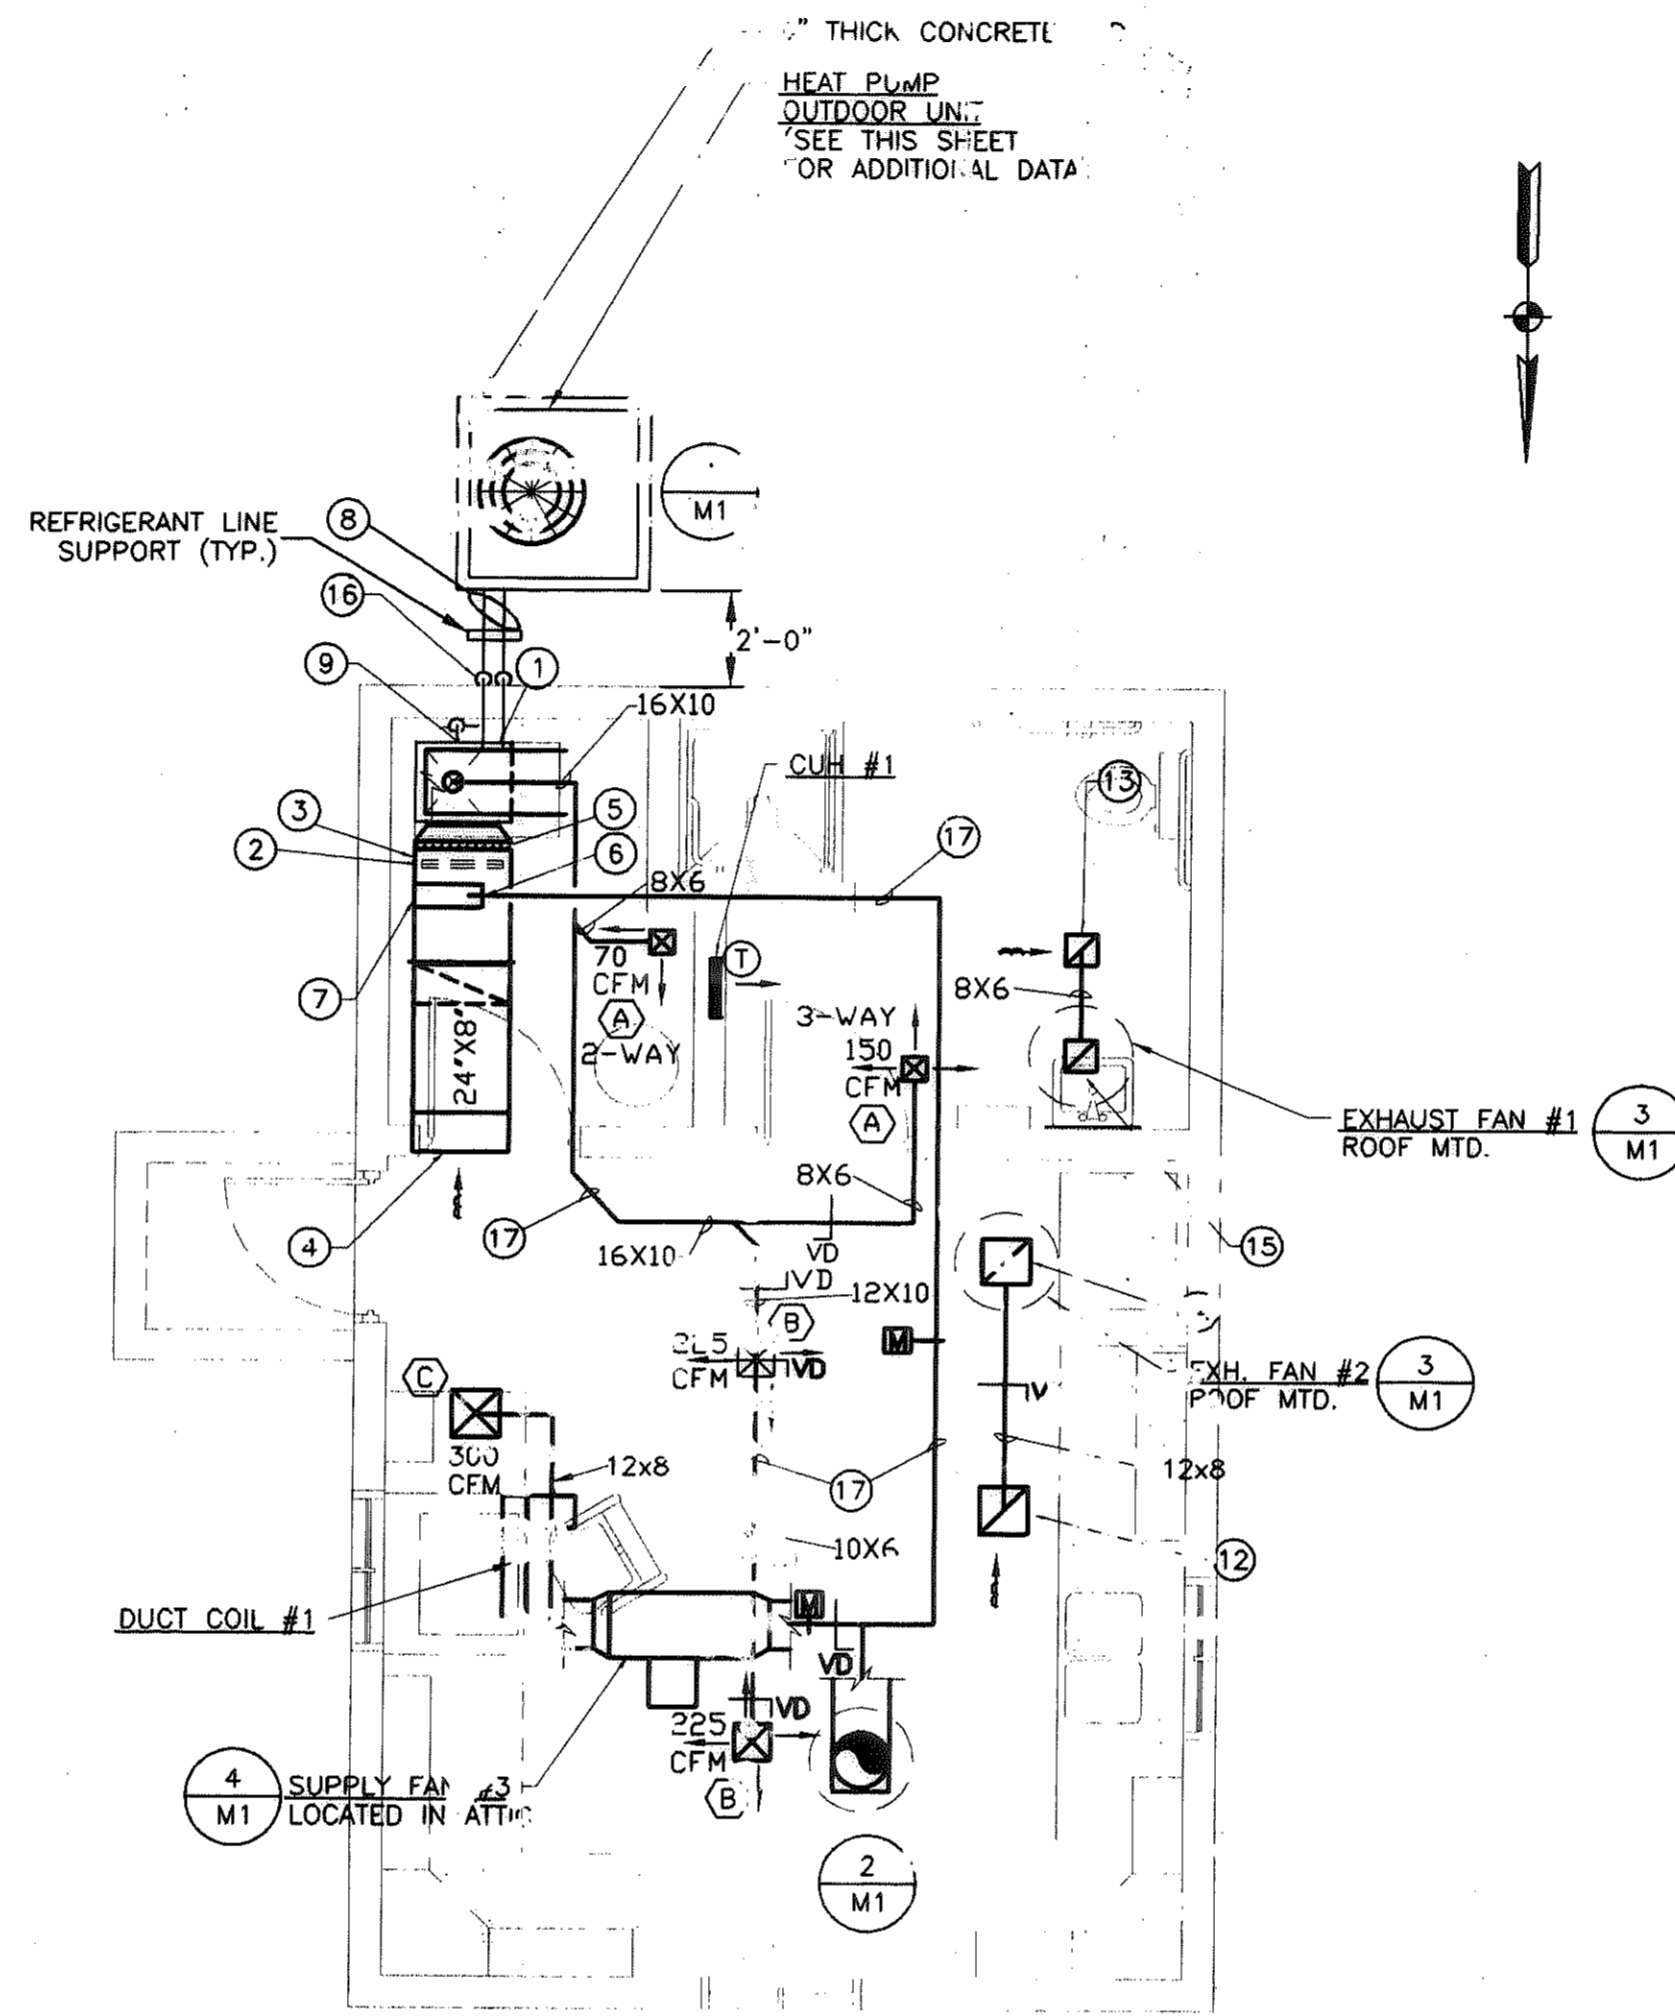

PLAN NOTES:

- ① HEAT PUMP - INDOOR UNIT: MTD. ON NEOPRENE VIBRATION ISOLATORS. SEE THIS SHEET FOR ADDITIONAL UNIT DATA
- ② 2" THICK PLEATED DISPOSABLE FILTER. PROVIDE DUCT ACCESS DOOR WITH LATCH FOR FILTER REMOVAL
- ③ 24"x8" RETURN AIR DUCT NEAR FLOOR
- ④ TYPE ②, 24"x12" RETURN AIR GRILLE MOUNTED ON WALL, 670 CFM
- ⑤ FLEXIBLE CONNECTION
- ⑥ 8"x6" OUTSIDE AIR DUCT DOWN TO RETURN AIR DUCT NEAR FLOOR, 100 CFM
- ⑦ 8"x6" OUTSIDE AIR DUCT IN ATTIC
- ⑧ REFRIGERANT LINES FROM OUTDOOR UNIT TO COOLING COIL OF INDOOR UNIT.
- ⑨ 3/4", PVC CONDENSATE DRAIN LINE TO NEAREST FLOOR DRAIN.
- ⑩ INTERLOCK MOTORIZED DAMPER WITH HEAT PUMP INDOOR UNIT.
- ⑪ INTERLOCK MOTORIZED DAMPER WITH SUPPLY FAN #3
- ⑫ 12"x12" TYPE ① EXHAUST GRILLE.
- ⑬ 8"x6" TYPE ① EXHAUST GRILLE.
- ⑭ 12"x12" EXHAUST DUCT UP TO ROOF FAN.
- ⑮ 8"x8" EXHAUST DUCT UP TO ROOF FAN.
- ⑯ REFRIGERANT LINES SHALL BE INSTALLED ON WALL.
- ⑰ DUCTWORK SHALL BE INSTALLED IN THE ATTIC. DUCTWORK SHALL BE INSULATED WITH 3" THICK, 0.75pcf DENSITY FIBERGLASS BLANKET INSULATION.

**LAB/ADMIN. BUILDING
MECHANICAL FLOOR PLAN**
SCALE: 1/4"=1'-0"

(ALTERNATE BID)


REVISED "AS-BUILT" DRAWING

THIS DRAWING HAS BEEN REVISED IN ACCORDANCE WITH NOTES ON "RECORD DRAWINGS" FURNISHED BY THE CONTRACTOR AND WITH EXECUTED CHANGE ORDERS. TO THE BEST OF OUR KNOWLEDGE AND BELIEF, THIS DRAWING SHOWS ACTUAL "AS-BUILT" CONDITIONS.

COMMONWEALTH ENGINEERS, INC. REVISED DATE 10/06
BY *CLW* CK. BY *CLW*


(NOTE: THIS SHEET PART OF ALTERNATE BID)

			DRAWN BY: RCL DESIGNED BY: GAMc CHECKED BY: GAMc DATE: 3/04 JOB NO: 6038S SCALE: AS NOTED	SALAMONIE RESERVOIR WASTEWATER TREATMENT PLANT IMPROVEMENTS PROJECT PUBLIC WORKS PROJECT NO. E031410M	DRAWING NO.
			LABORATORY/ADMINISTRATION BUILDING MECHANICAL FLOOR PLAN	M2	
					46 OF 52

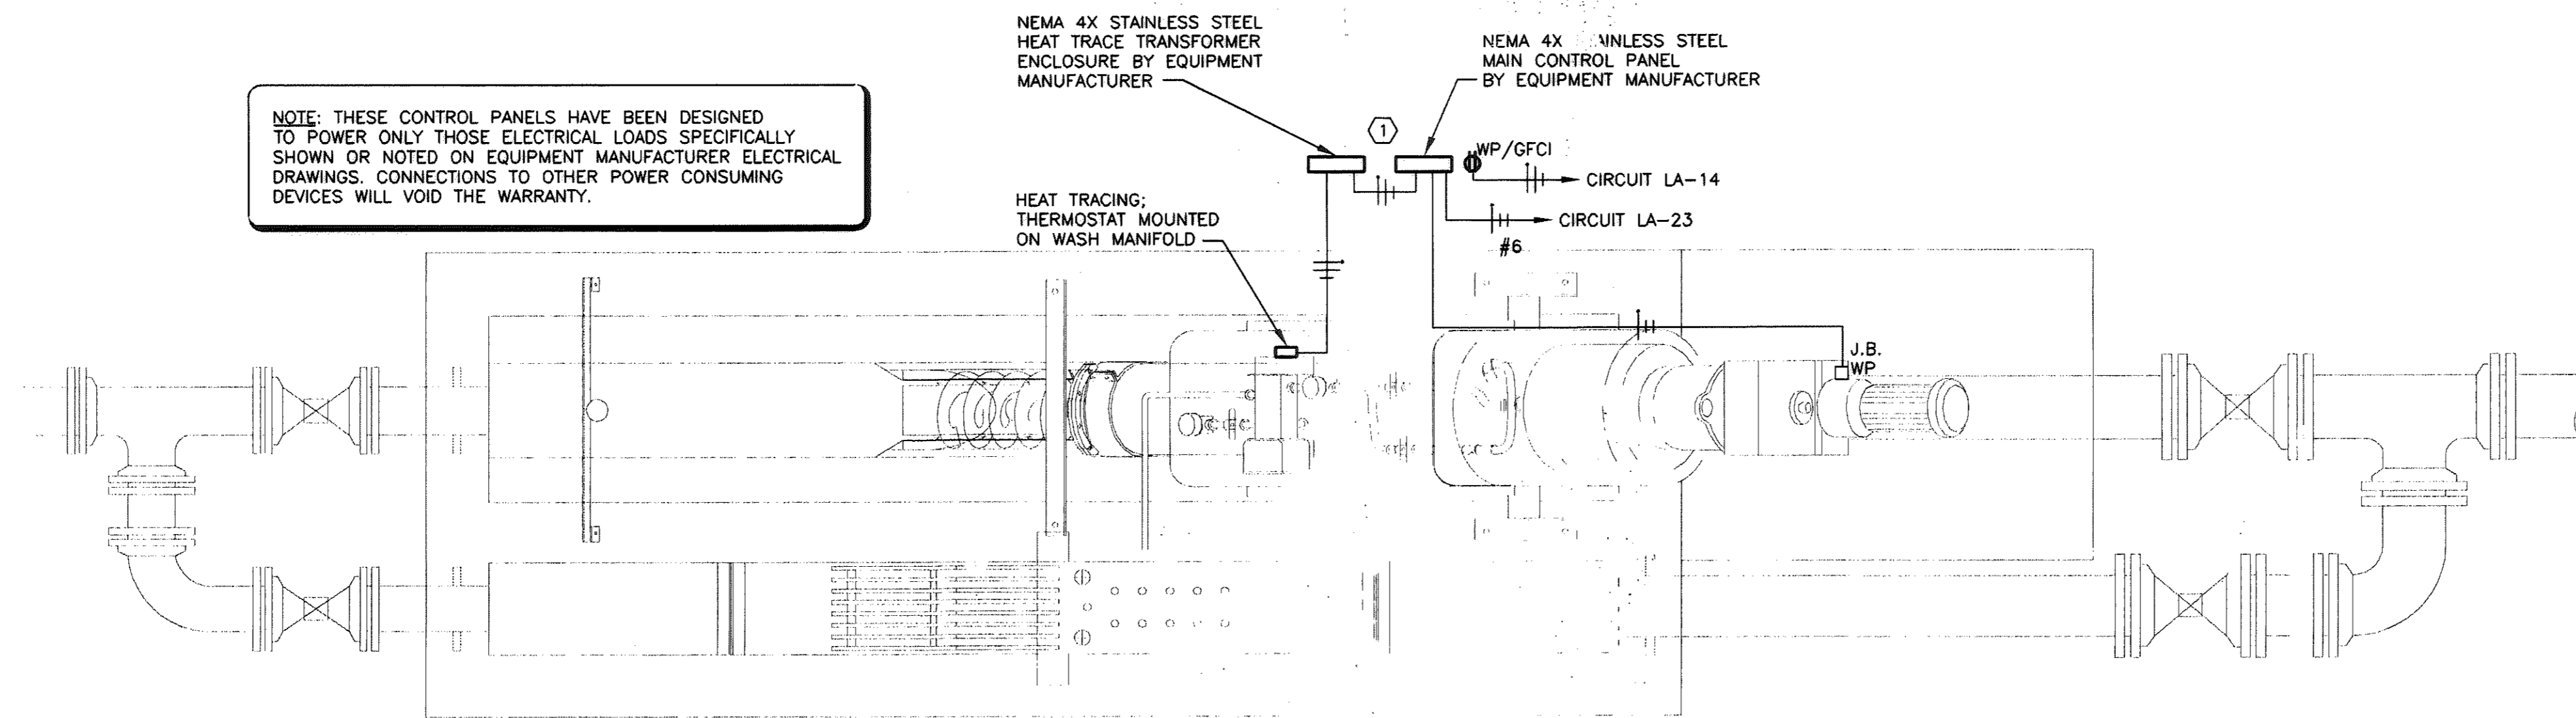

NOTE: THESE CONTROL PANELS HAVE BEEN DESIGNED TO POWER ONLY THOSE ELECTRICAL LOADS SPECIFICALLY SHOWN OR NOTED ON EQUIPMENT MANUFACTURER ELECTRICAL DRAWINGS. CONNECTIONS TO OTHER POWER CONSUMING DEVICES WILL VOID THE WARRANTY.

**HEADWORKS STRUCTURE
ELECTRICAL PLAN VIEW**
SCALE: 3/4"=1'-0"

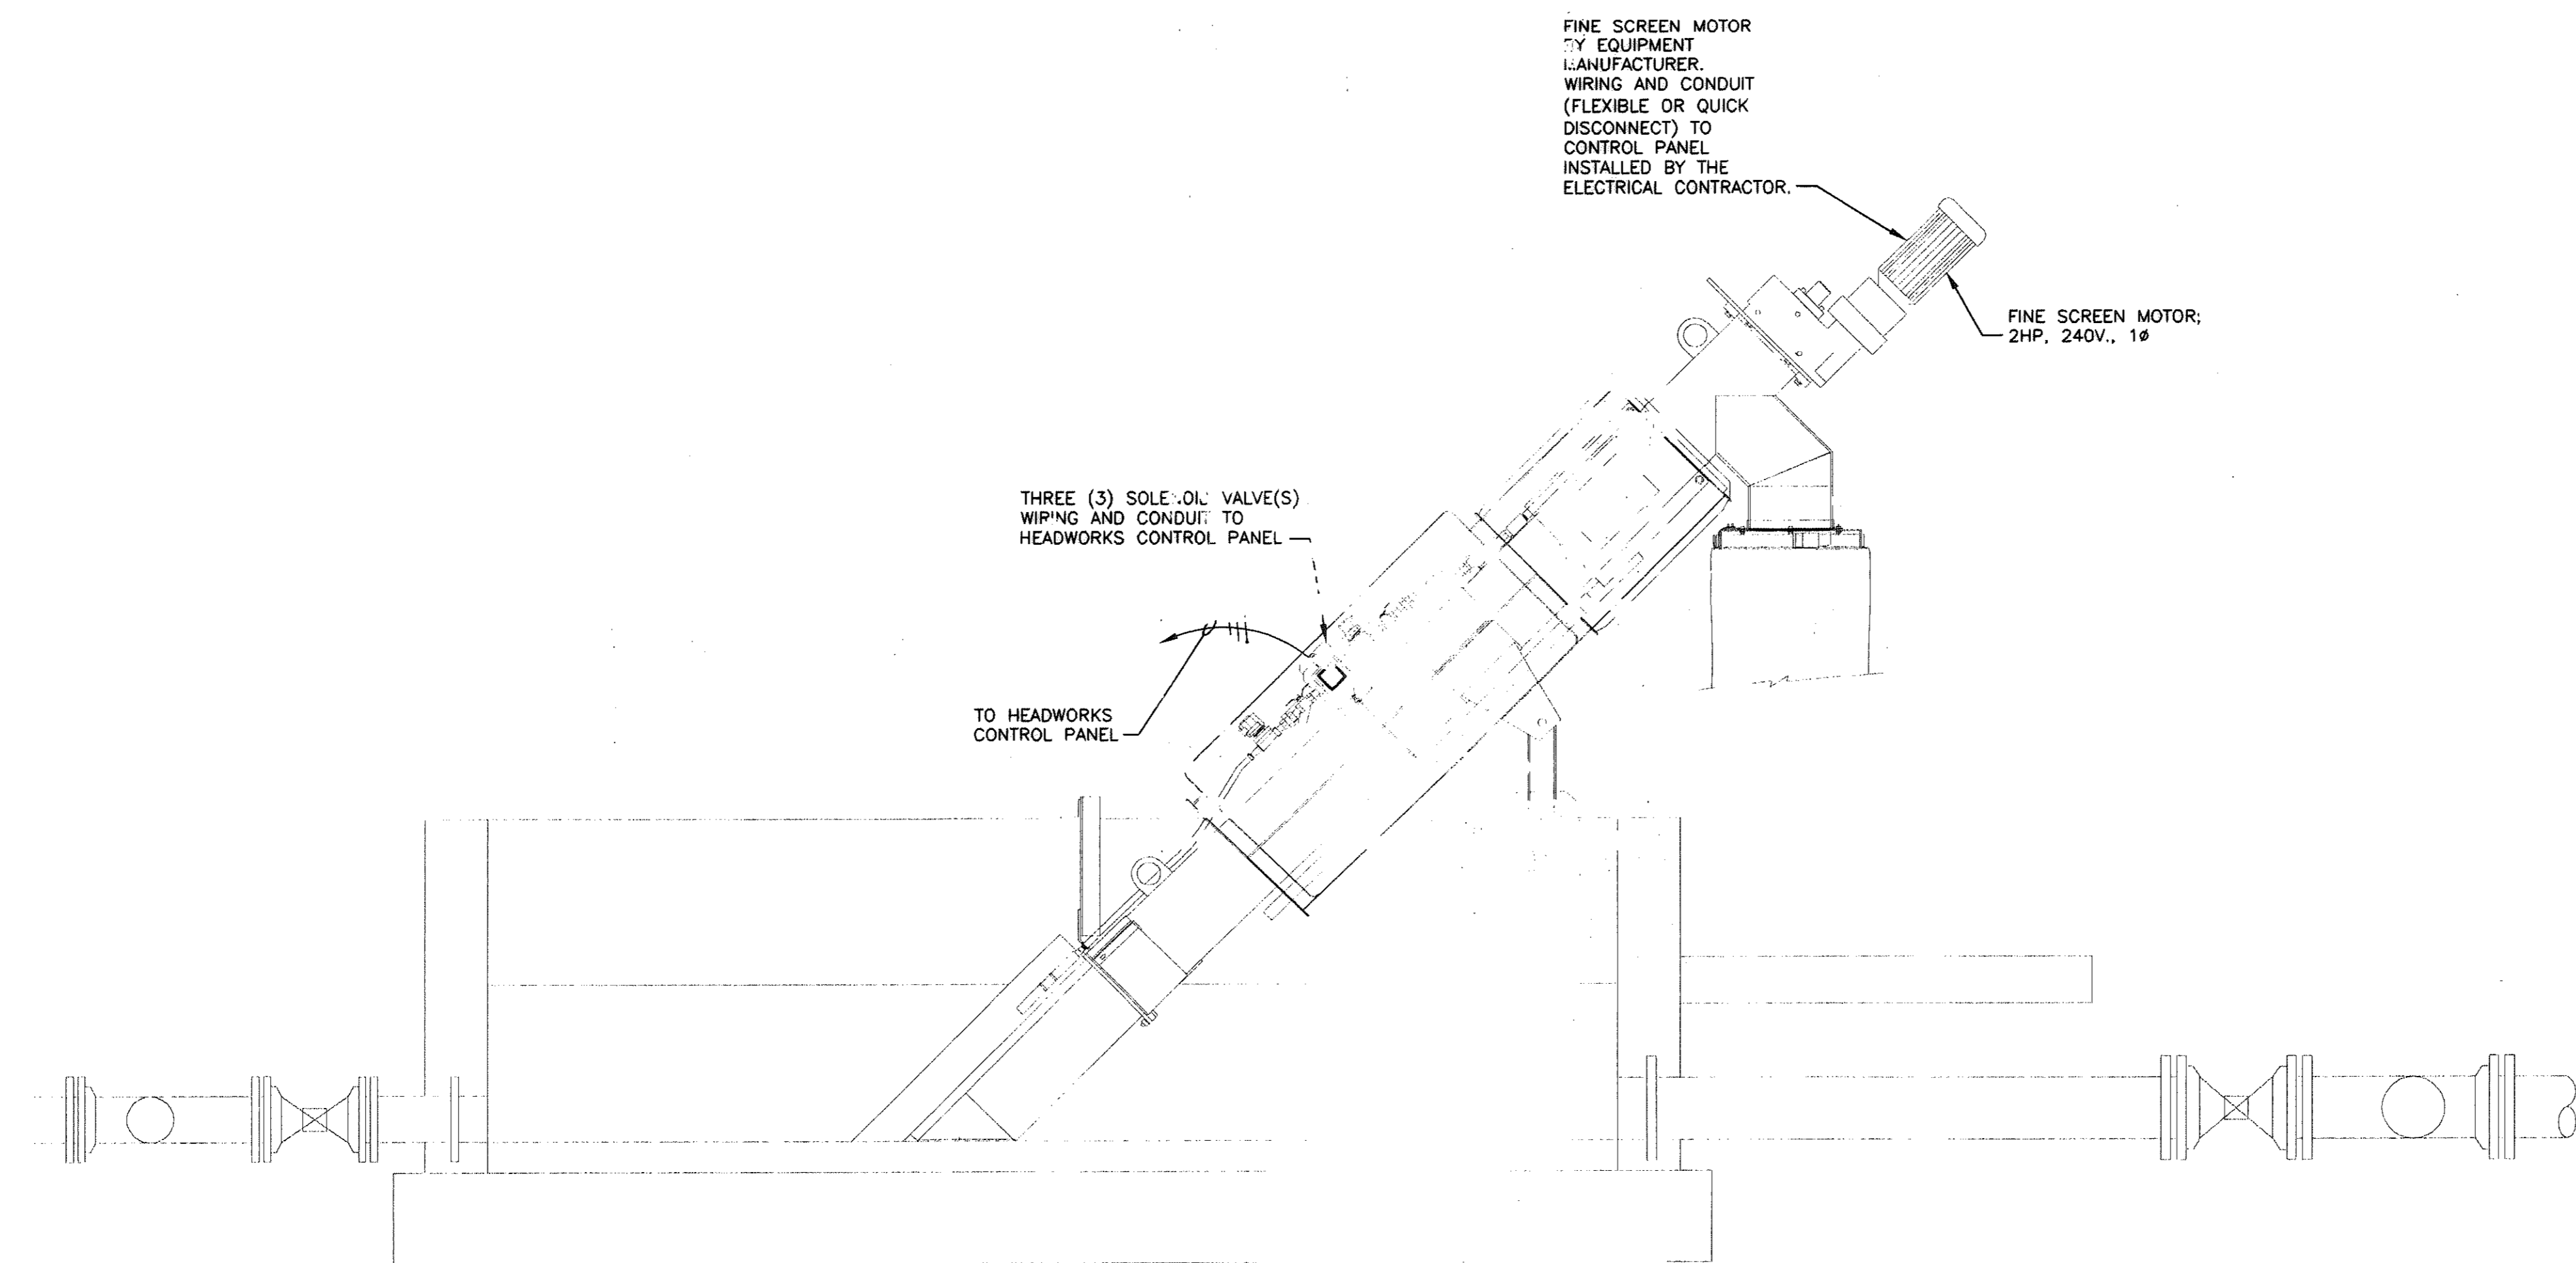

FINE SCREEN MOTOR BY EQUIPMENT MANUFACTURER. WIRING AND CONDUIT (FLEXIBLE OR QUICK DISCONNECT) TO CONTROL PANEL INSTALLED BY THE ELECTRICAL CONTRACTOR.

FINE SCREEN MOTOR: 2HP, 240V, 1Ø

THREE (3) SOLE OIL VALVE(S) WIRING AND CONDUIT TO HEADWORKS CONTROL PANEL

TO HEADWORKS CONTROL PANEL

PLAN NOTES:

① STARTER AND CONTROLS FOR BOOSTER PUMP IS PART OF THE FINE SCREEN CONTROL PANEL. BOOSTER PUMP; 1HP, 240 VOLT, SINGLE PHASE. CONTRACTOR SHALL WIRE TO BOOSTER PUMP.

GENERAL NOTES:

1.) ELECTRICAL CONNECTIONS TO BE FLEXIBLE OR QUICK DISCONNECT TYPE TO ALLOW TO PIVOT OUT OF CHANNEL.



2.) KEEP AREA UNDER SCREENINGS TRANSPORT SCREW FREE FROM OBSTRUCTION SUCH AS ELECTRICAL CONDUIT TO PERMIT ROTATION OF THE SCREEN OF THE CHANNEL FOR SERVICING.

**HEADWORKS STRUCTURE
ELECTRICAL ELEVATION VIEW**
SCALE: 3/4"=1'-0"

REVISED "AS-BUILT" DRAWING

THIS DRAWING HAS BEEN REVISED IN ACCORDANCE WITH NOTES ON "RECORD DRAWINGS" FURNISHED BY THE CONTRACTOR AND WITH EXECUTED CHANGE ORDERS. TO THE BEST OF OUR KNOWLEDGE AND BELIEF, THIS DRAWING SHOWS ACTUAL "AS-BUILT" CONDITIONS.


COMMONWEALTH ENGINEERS, INC. REVISOR: DATE 10/06
BY: [Signature] CK: [Signature]

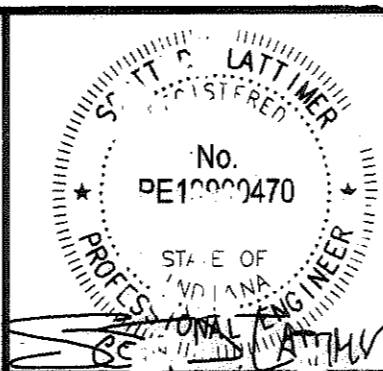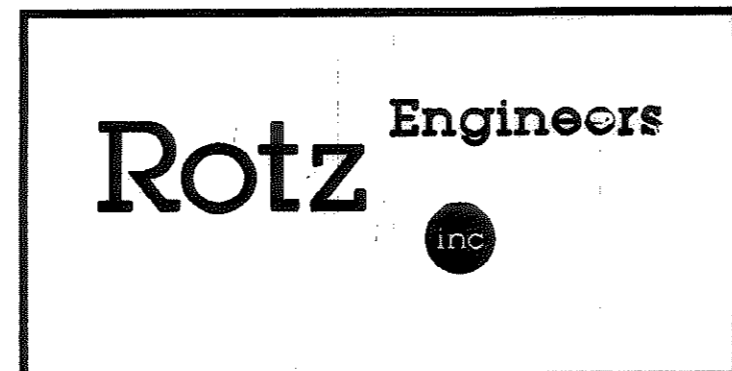

DRAWN BY:	LTG
DESIGNED BY:	JTH
CHECKED BY:	RMS
DATE:	3/04
JOB NO.:	6038S
SCALE:	AS NOTED

SALOMIE RESERVOIR WASTEWATER TREATMENT PLANT IMPROVEMENTS PROJECT	
PUBLIC WORKS PROJECT NO. E031410M	
HEADWORKS STRUCTURE ELECTRICAL ELEVATION AND PLAN VIEW	

DRAWING NO.	E1
47 OF 52	


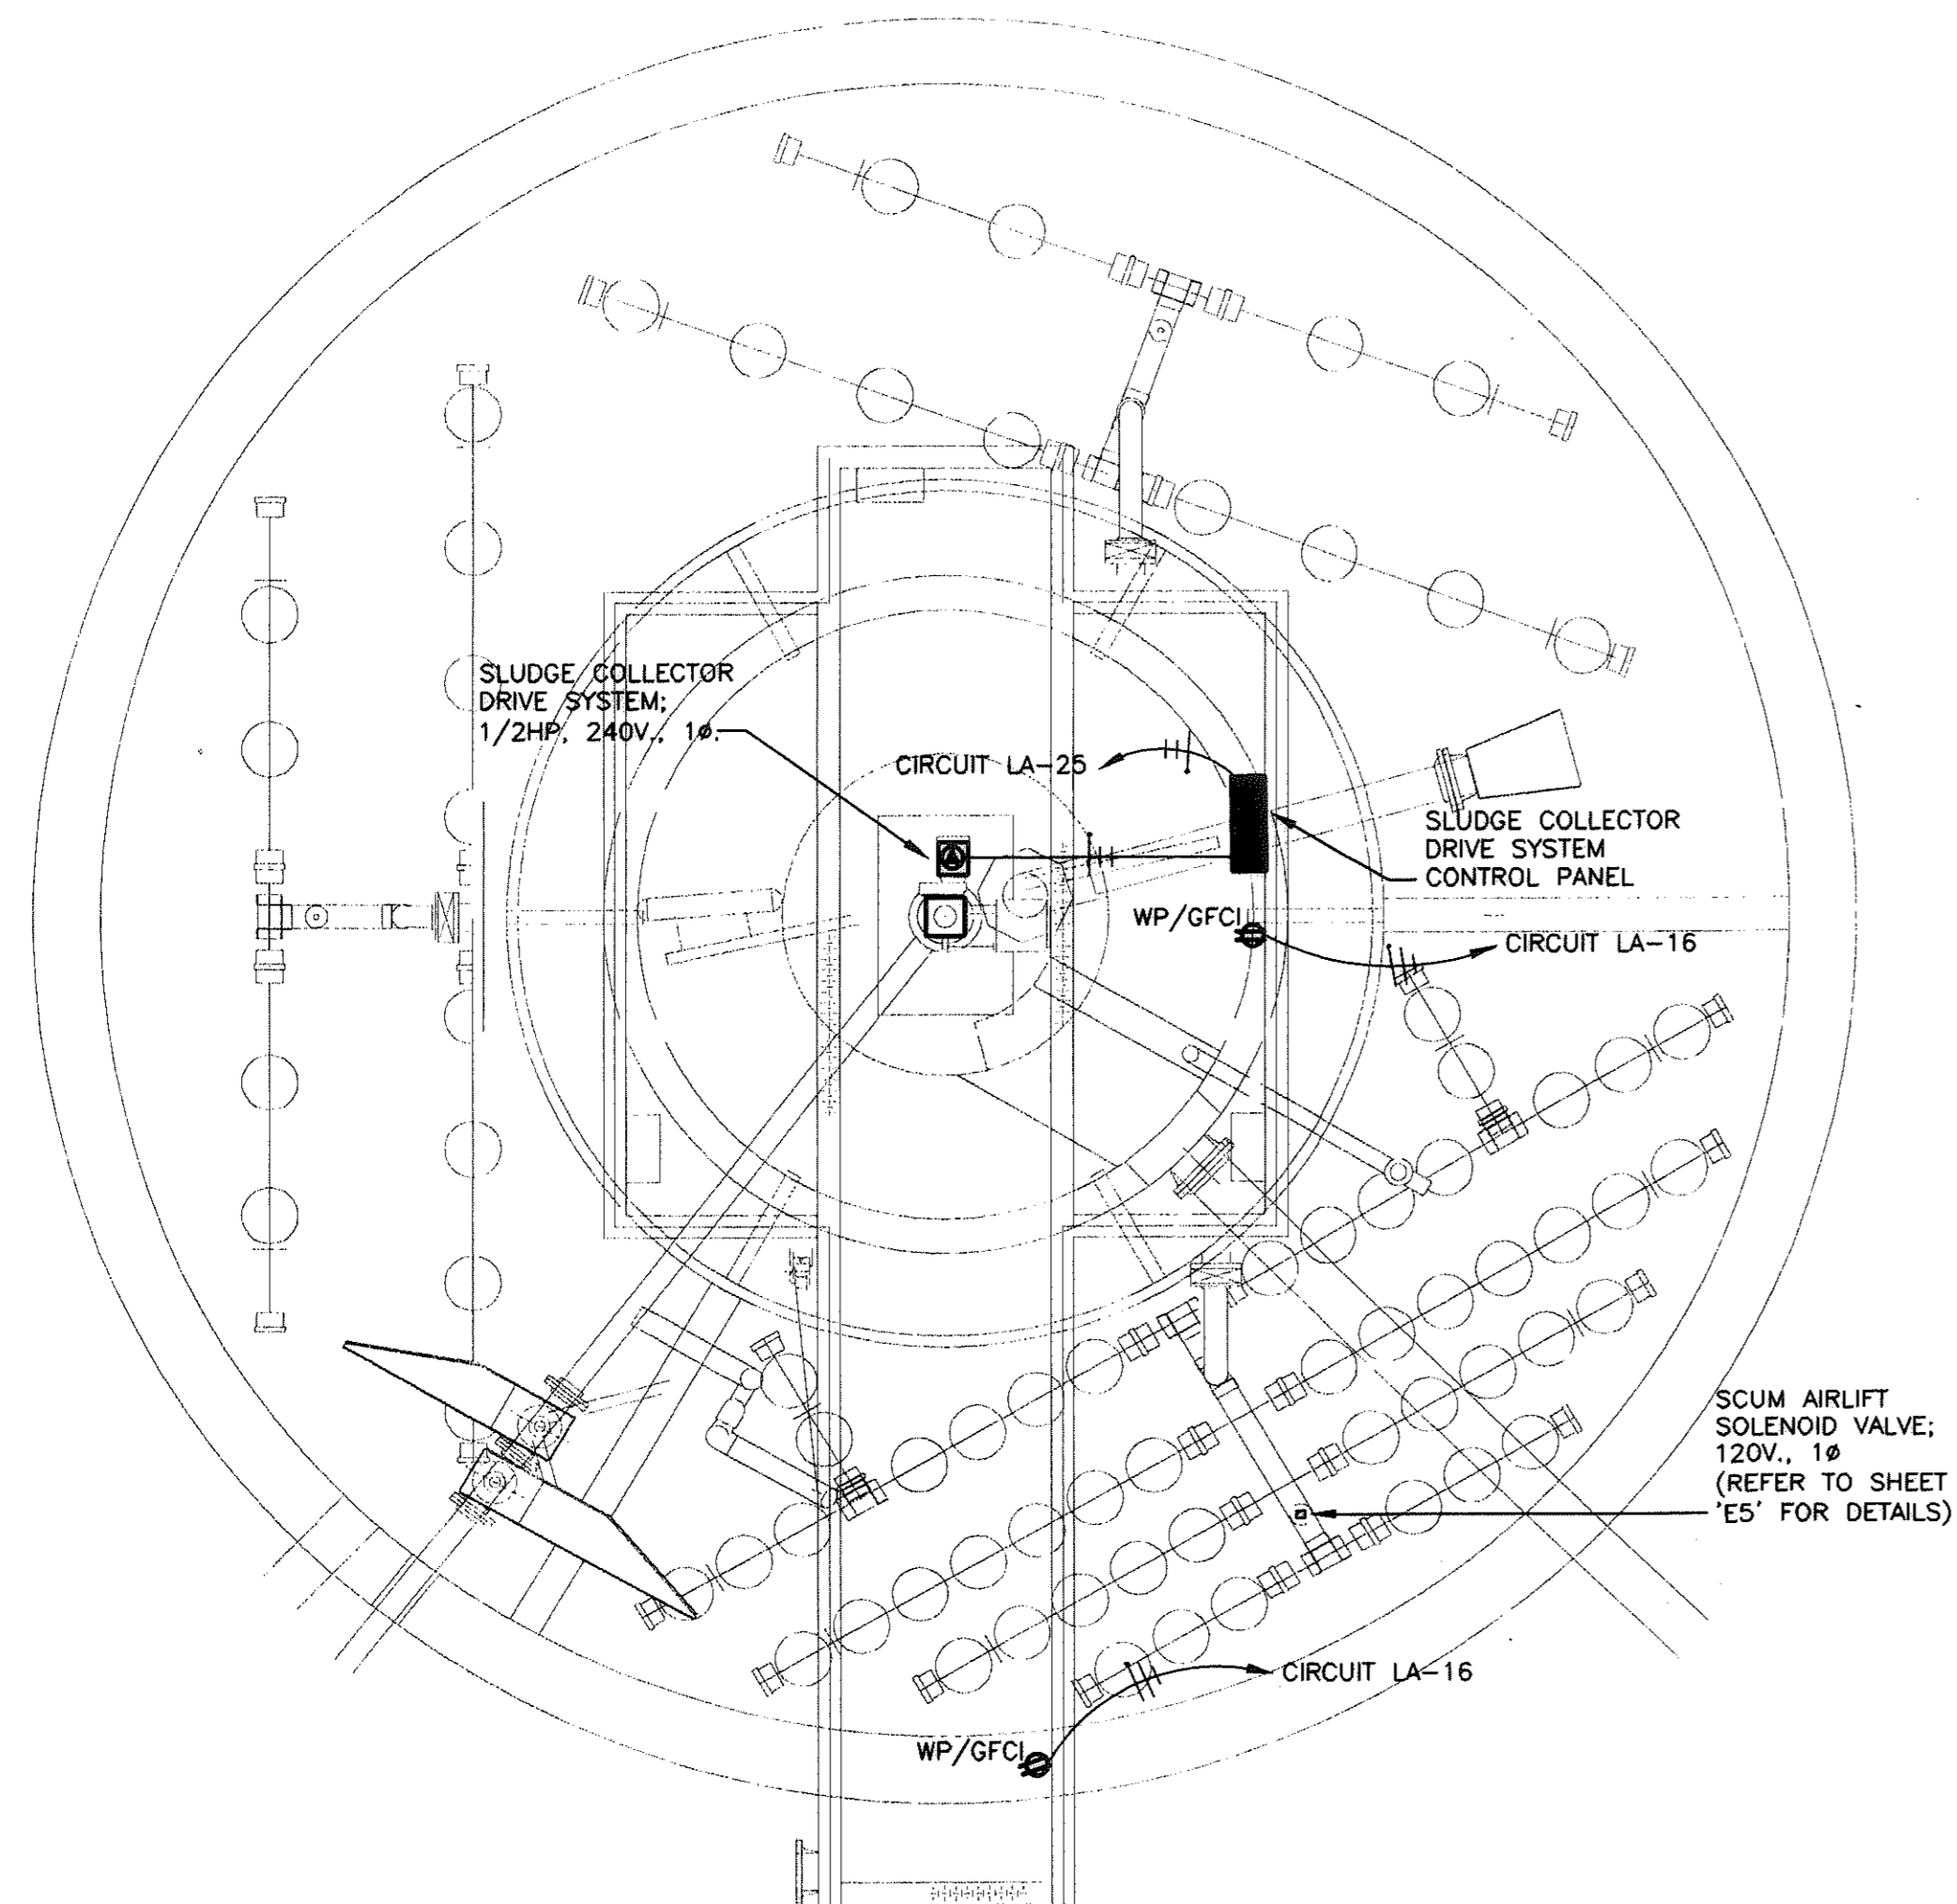


**AERATION TANK
PLAN VIEW**
SCALE: 3/8"=1'-0"



REVISED "AS-BUILT" DRAWING

THIS DRAWING HAS BEEN REVISED IN ACCORDANCE WITH NOTES ON "RECORD DRAWINGS" FURNISHED BY THE CONTRACTOR AND WITH EXECUTED CHANGE ORDERS. TO THE BEST OF OUR KNOWLEDGE AND BELIEF, THIS DRAWING SHOWS ACTUAL "AS-BUILT" CONDITIONS.

COMMONWEALTH ENGINEERS, INC. REVISED DATE: 10/06
BY: JKW, CK. BY: CWW

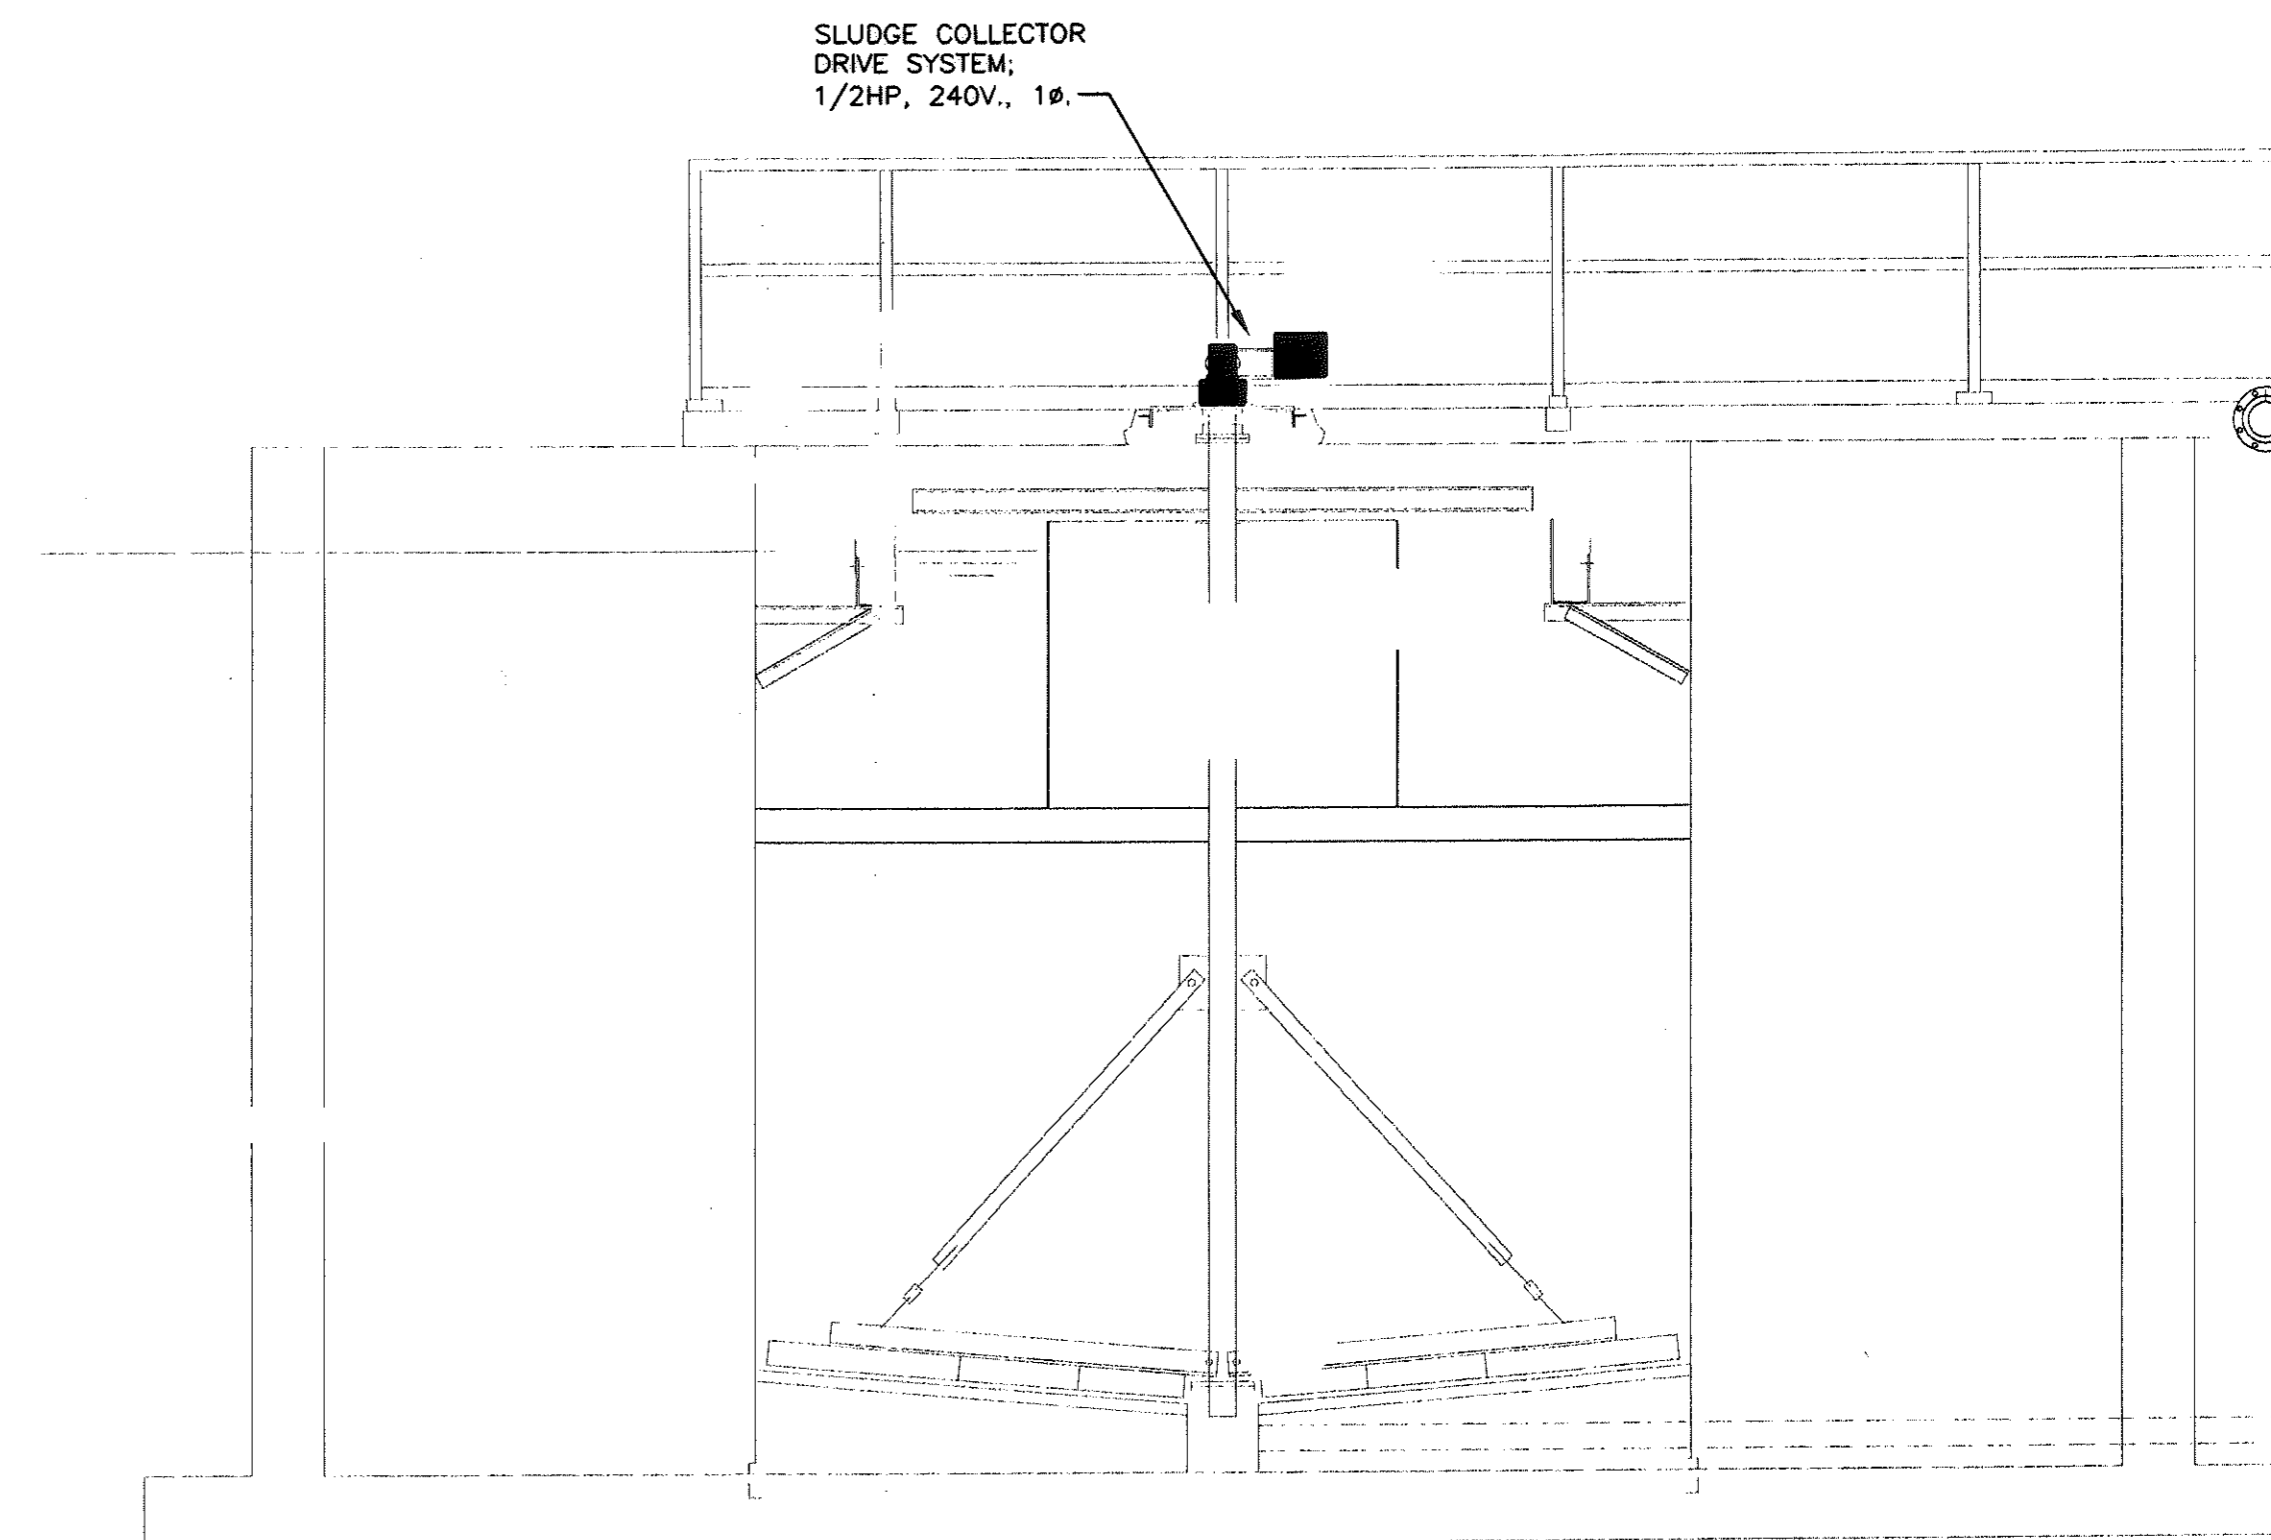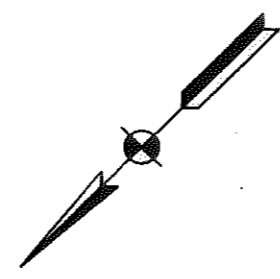

**TREATMENT PLANT
SECTION VIEW**
SCALE: 3/8"=1'-0"

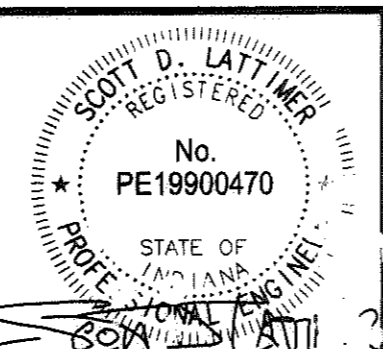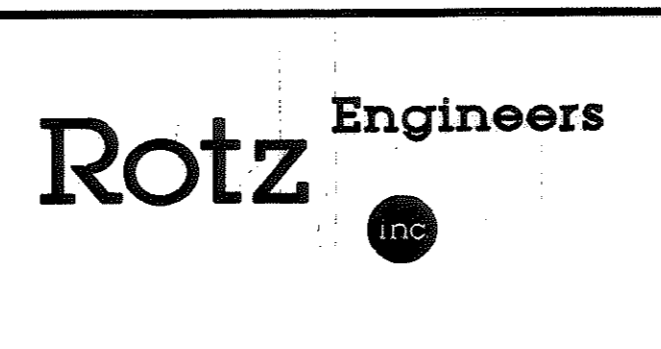




COMMONWEALTH ENGINEERS, INC.

DRAWN BY:	LTG
DESIGNED BY:	JTH
CHECKED BY:	RMS
DATE:	3/04
DWG NO:	6038S
SCALE:	AS NOTED


SALAMONIE RESERVOIR
WASTEWATER TREATMENT PLANT IMPROVEMENTS PROJECT
PUBLIC WORKS PROJECT NO. E031410M
TREATMENT PLANT/SLUDGE HOLDING TANK AND AERATION TANK
ELECTRICAL PLAN

DRAWING NO.	E2
48 OF 52	

301-63

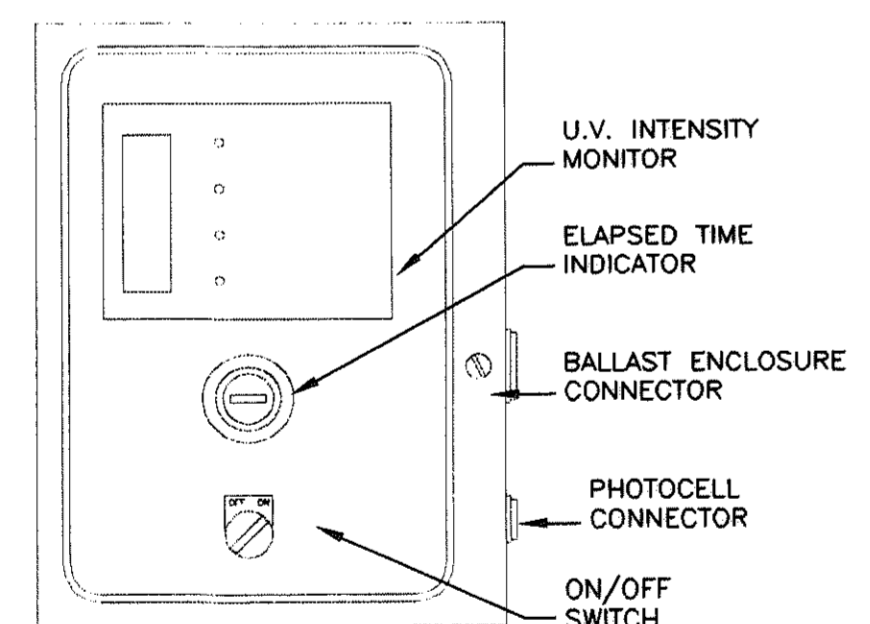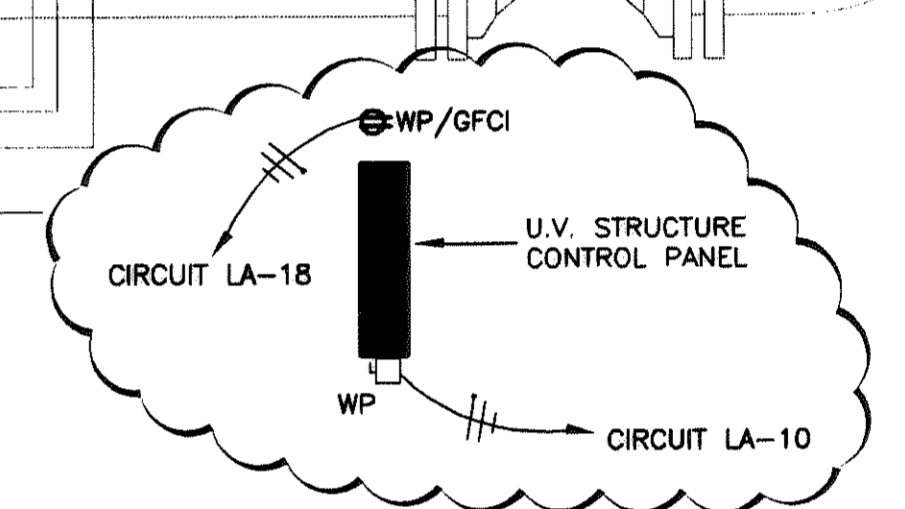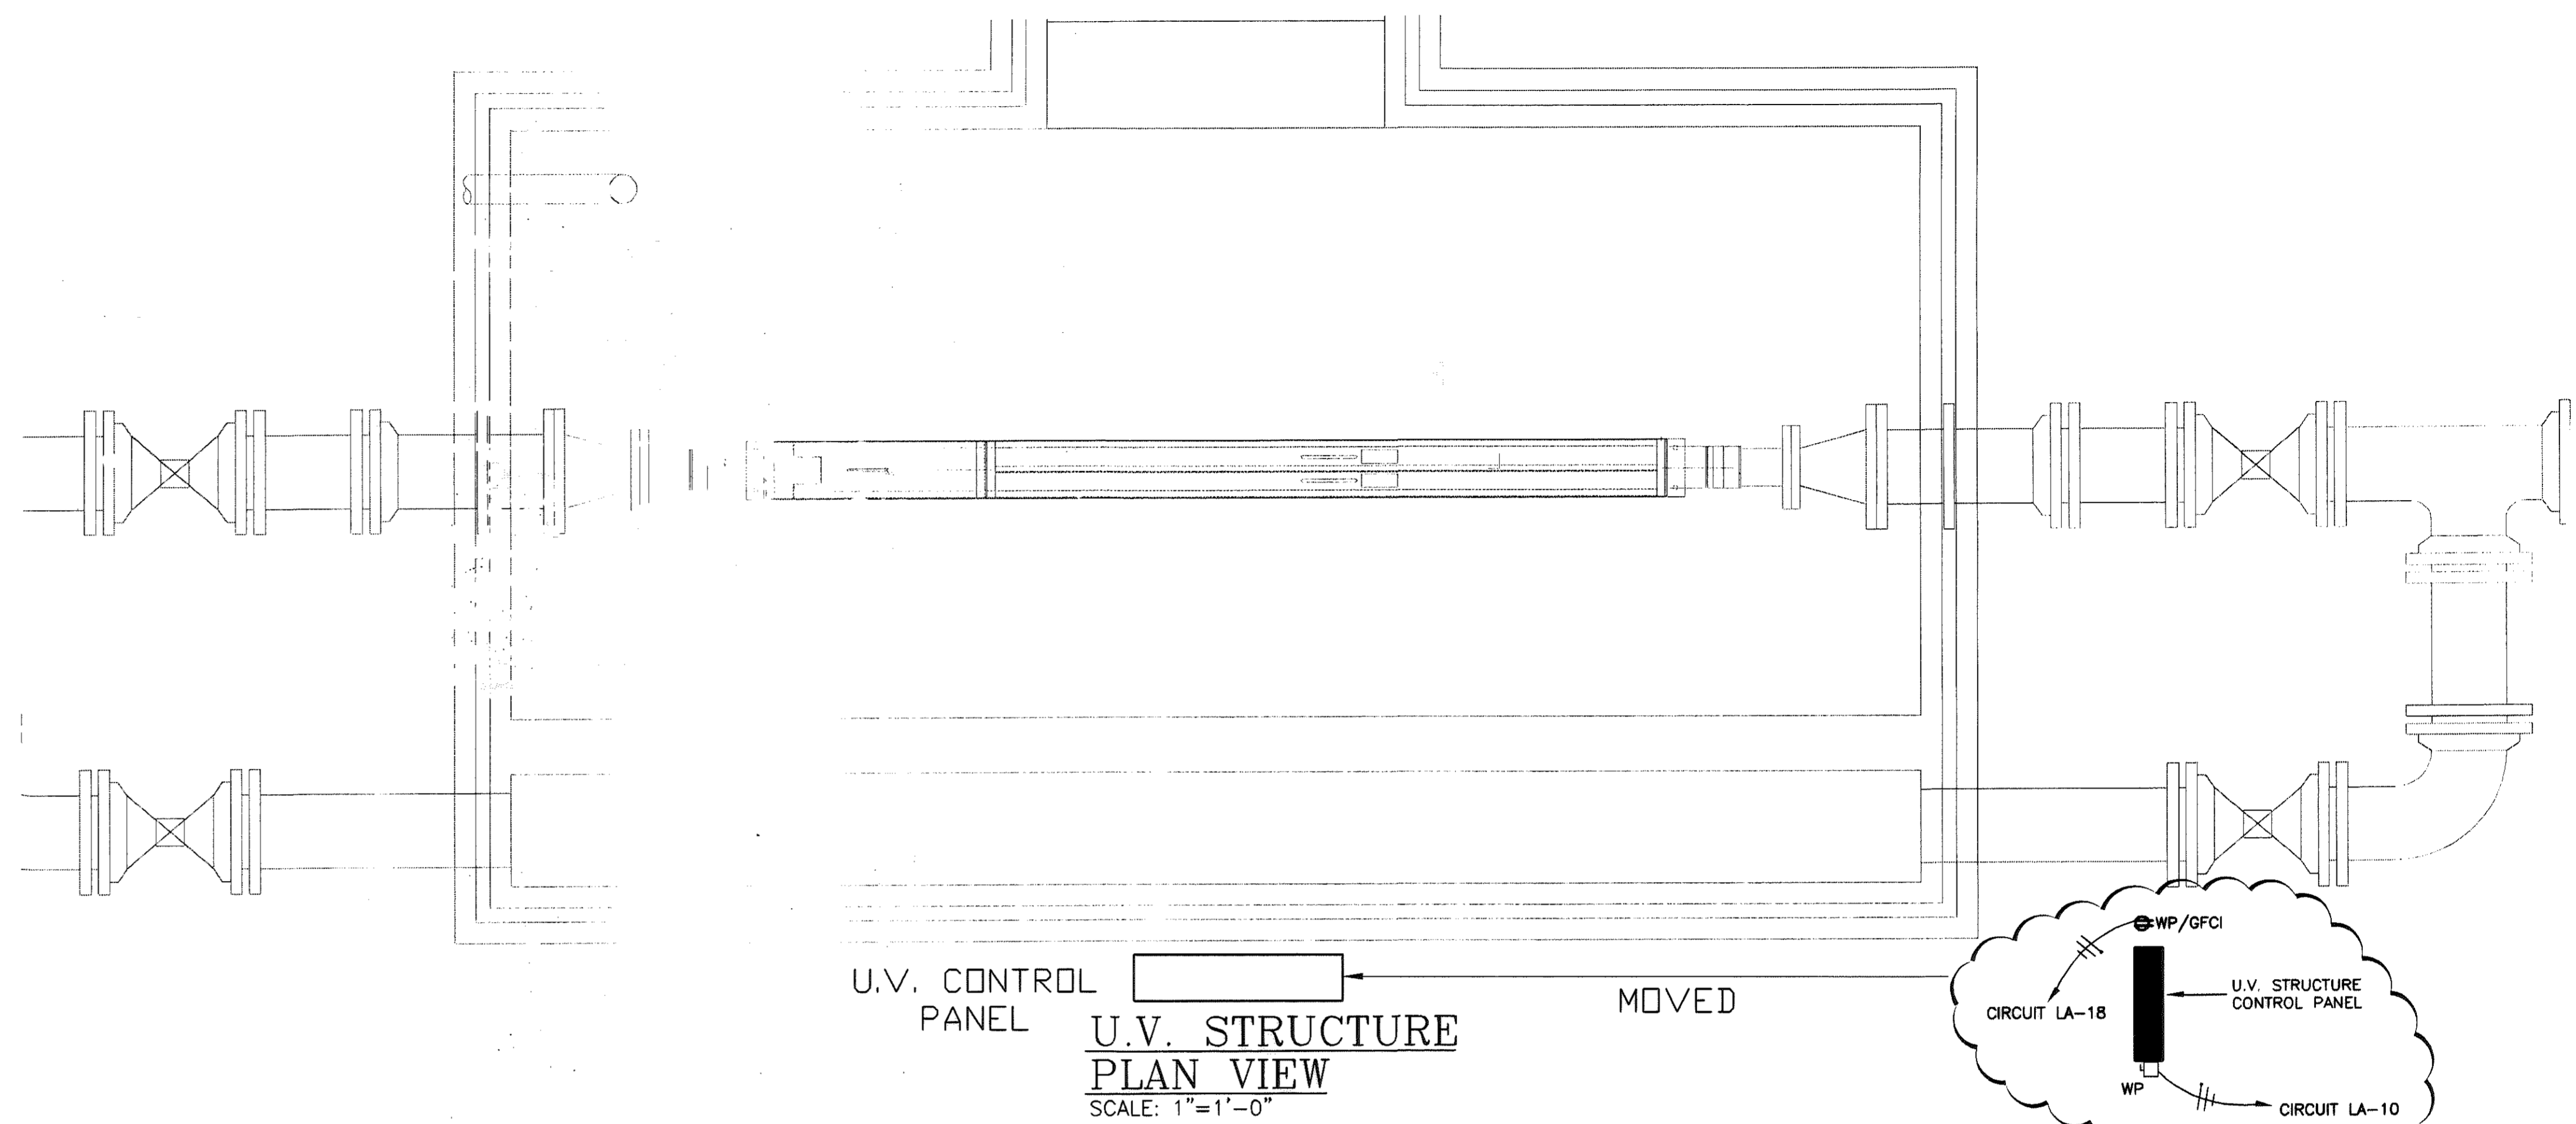


U.V. STRUCTURE CONTROL PANEL DETAIL
SCALE: N.T.S.

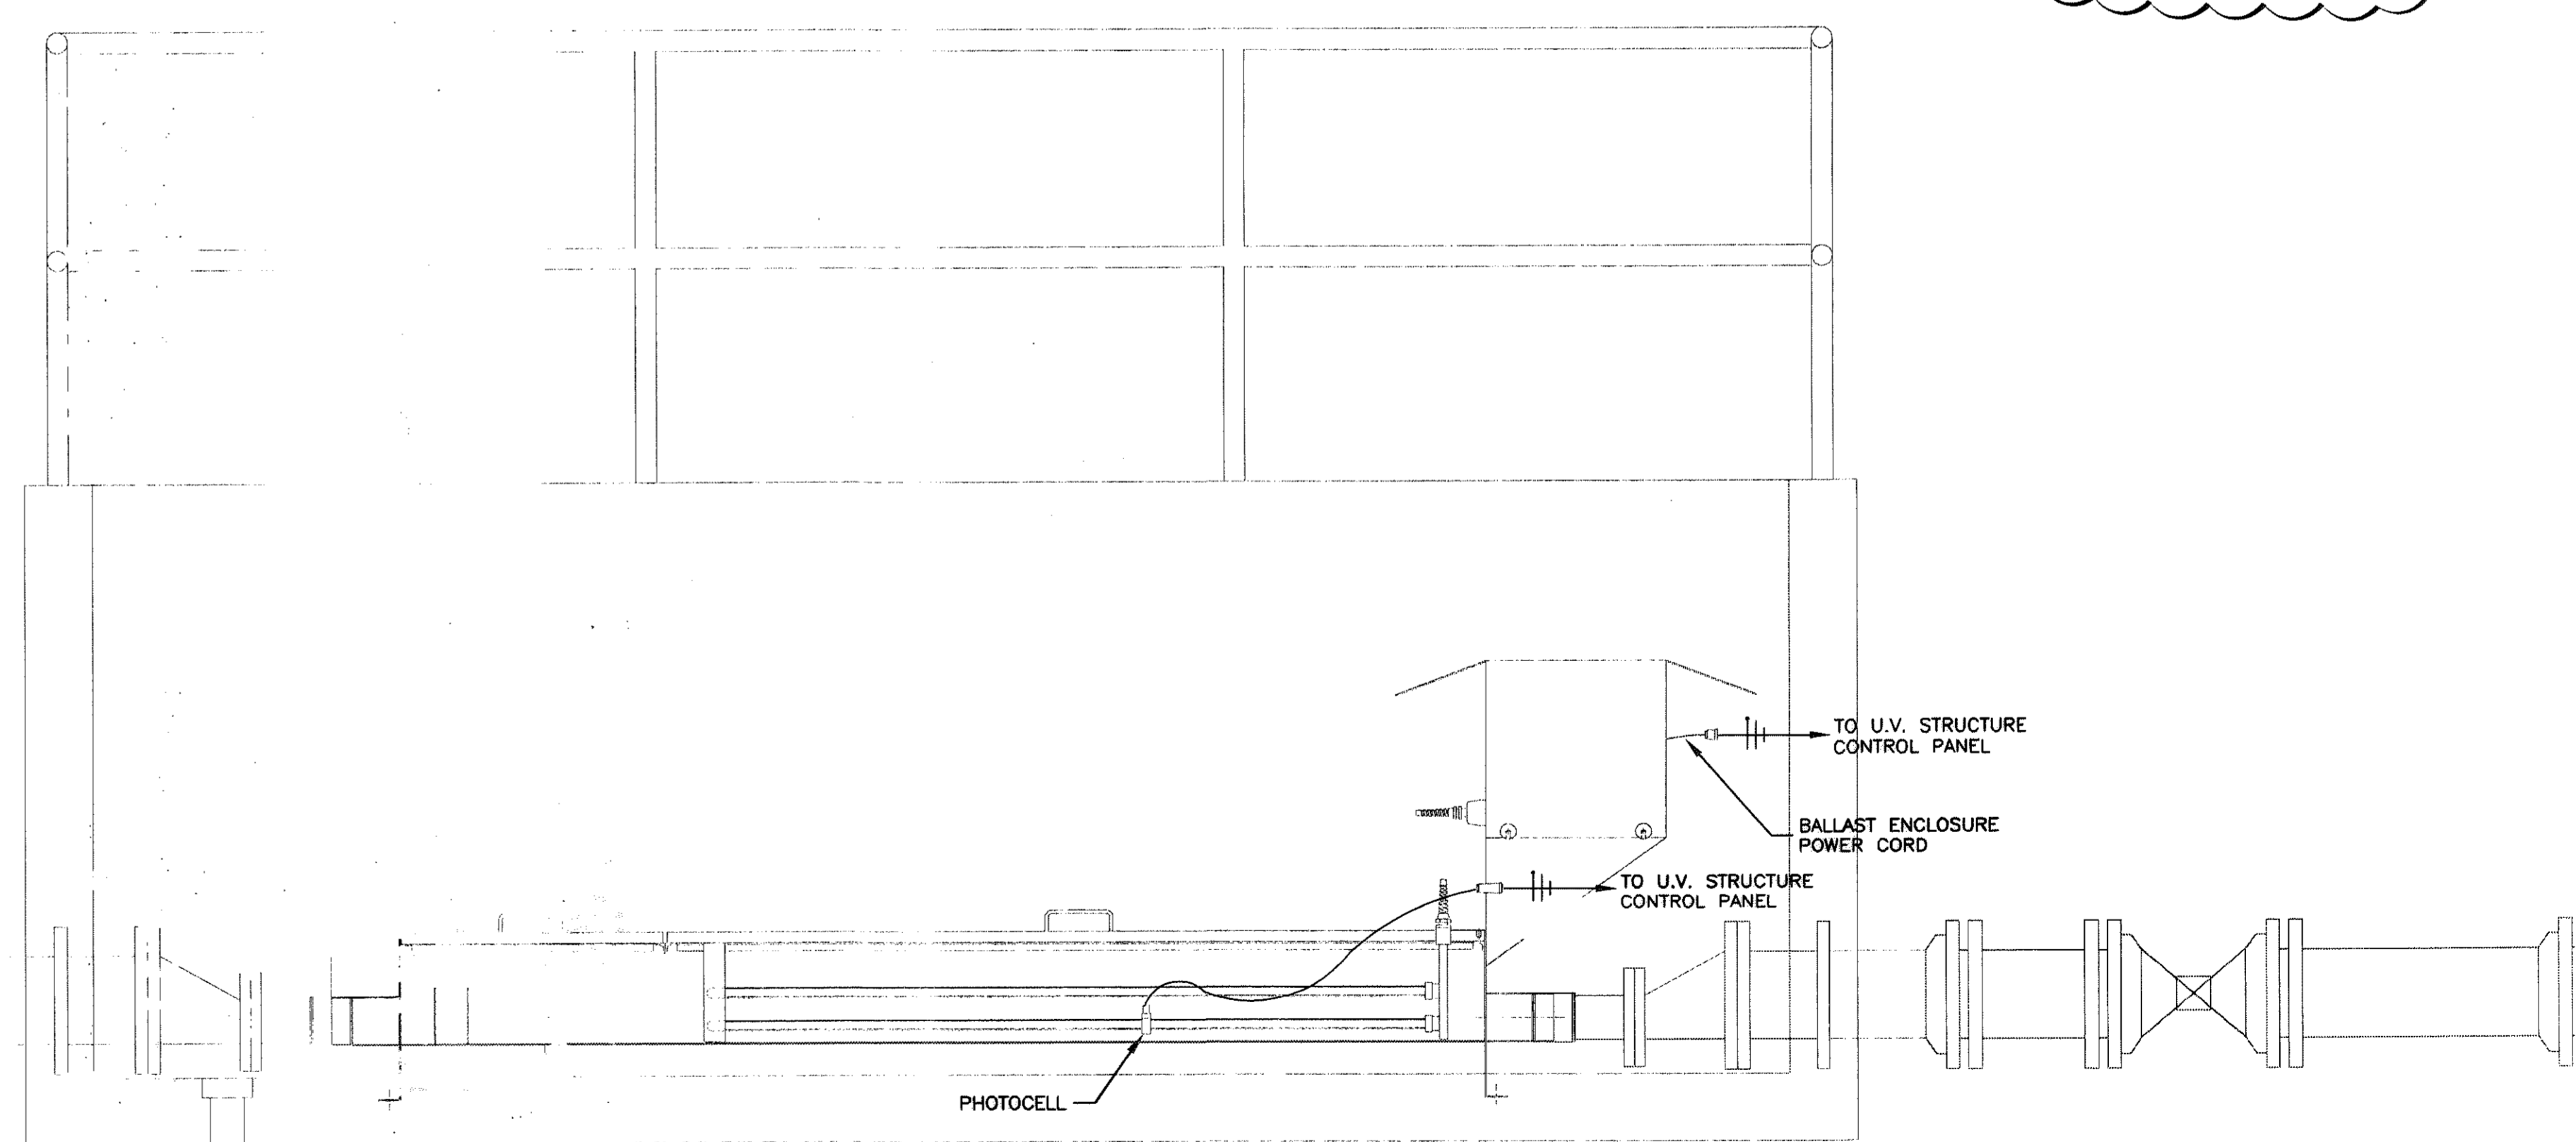

U.V. STRUCTURE SECTION VIEW
SCALE: 1"=1'-0"

REVISED "AS-BUILT" DRAWING
THIS DRAWING HAS BEEN REVISED IN ACCORDANCE WITH NOTES ON "RECORD DRAWINGS" FURNISHED BY THE CONTRACTOR AND WITH EXECUTED CHANGE ORDERS. TO THE BEST OF OUR KNOWLEDGE AND BELIEF, THIS DRAWING SHOWS ACTUAL "AS-BUILT" CONDITIONS.
COMMONWEALTH ENGINEERS, INC.
REVISED DATE 10/06
BY JCW, CK BY

Rotz Engineers

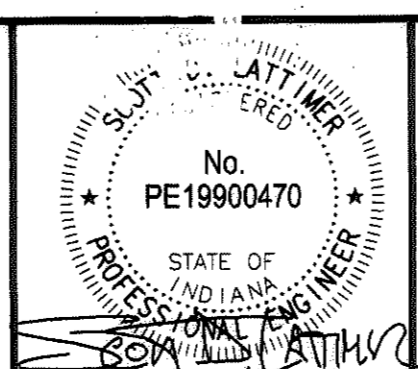

COMMONWEALTH ENGINEERS, INC.

DRAWN BY: LTG
DESIGNED BY: JTH
CHECKED BY: RMS
DATE: 3/04
JOB NO: 6038S
SCALE: AS NOTED


SALAMONIE RESERVOIR
WASTEWATER TREATMENT PLANT IMPROVEMENTS PROJECT
PUBLIC WORKS PROJECT NO. E031410M
U.V. STRUCTURE
ELECTRICAL PLAN AND SECTION VIEW

DRAWING NO.
E3
49 OF 52

301-63

PANEL LA	LOCATION LAB BUILDING	MOUNTING: SURFACE				VOLTAGE: 120/240V., 1 PHASE 3W				MAIN 2P-400A MCB PROVIDE GROUND BUS BAR	
		LOAD DESIGNATION	CKT BKR	NO.	CONNECTED LOAD (KVA)	CKT NO.	PHASE A	PHASE C	CKT NO.		
		LTS- LAB, RESTROOM & MECH. ROOM	1P-20	1	1.2	0.6			2	1P-20	RECPT- LAB
		RECPT- REFRIGERATOR	1P-20	3			1.2	1.0	4	1P-20	RECPT- RESTROOM
		RECPT- ABOVE COUNTER	1P-20	5	0.6	0.4			6	1P-20	M- ULTRASONIC LEVEL CONTROL
		RECPT- ABOVE COUNTER	1P-20	7			0.6	0.9	8	1P-20	LT- SITE LIGHTING
		RECPT- AT DESK	1P-20	9	0.4	1.2			10	1P-20	M- U.V. DISINFECTION EQUIPMENT
		RECPT- AT BLOWER CONTROL PANEL	1P-20	11			0.4	0.6	12	1P-20	M- AUTOMATIC SAMPLER/FLOWMETER
		F- EXHAUST FAN #1 AND #2	1P-20	13	1.4	0.4			14	1P-20	RECPT- HEADWORKS
		M- CHEMICAL FEED BUILDING	1P-30	15			1.8	1.0	16	1P-20	RECPT- AT AERATION TANK
		H- CHU-1	1P-20	17	1.2	0.4			18	1P-20	RECPT- AT U.V. STRUCTURE
		F- EXHAUST FAN #3	1P-20	19			0.7		20	1P-20	M- INCUBATOR
		SPARE	1P-20	21			1.5		22	1P-20	WH- WATER HEATER
		M- FINE SCREEN CONTROL PANEL	2P-60	23			3.8	1.5	24	2P-20	H- HEAT PUMP (OUTDOOR)
		M- 2HP FINE SCREEN			3.8	1.5					H- HEAT PUMP (INDOOR)
		M- SLUDGE COLLECTOR DRIVE SYSTEM	2P-15	25			0.6	3.0	26		M- DUCT COIL #1 6KW
		M- CONTROL PANEL 1/2HP			0.6	3.0					M- DUCT COIL #2 2KW
		M- GRINDER PUMP 2HP	2P-20	27			1.5		28		SPACE
		M- GRINDER PUMP 2HP			1.5						SPACE
		H- HEAT PUMP (INDOOR)	2P-45	29			3.6		30		SPACE
		H- HEAT PUMP (INDOOR)			3.6						SPACE
		SPACE	2P-	31			10.1		32		BLOWER CONTROL PANEL
		SPACE									M- BLOWER CONTROL PANEL
TOTAL CONNECTED LOAD (KVA)					65.7		33.4				32.3

* (NOTE: IF ALTERNATE BID IS NOT ACCEPTED CIRCUIT BECOMES A SPACE)
 NOTE: BASE BID: ELECTRICAL PANELBOARD 'LA'; NEMA 4X STAINLESS STEEL ENCLOSURE.
 ALTERNATE BID: ELECTRICAL PANELBOARD 'LA'; NEMA 1 ENCLOSURE.

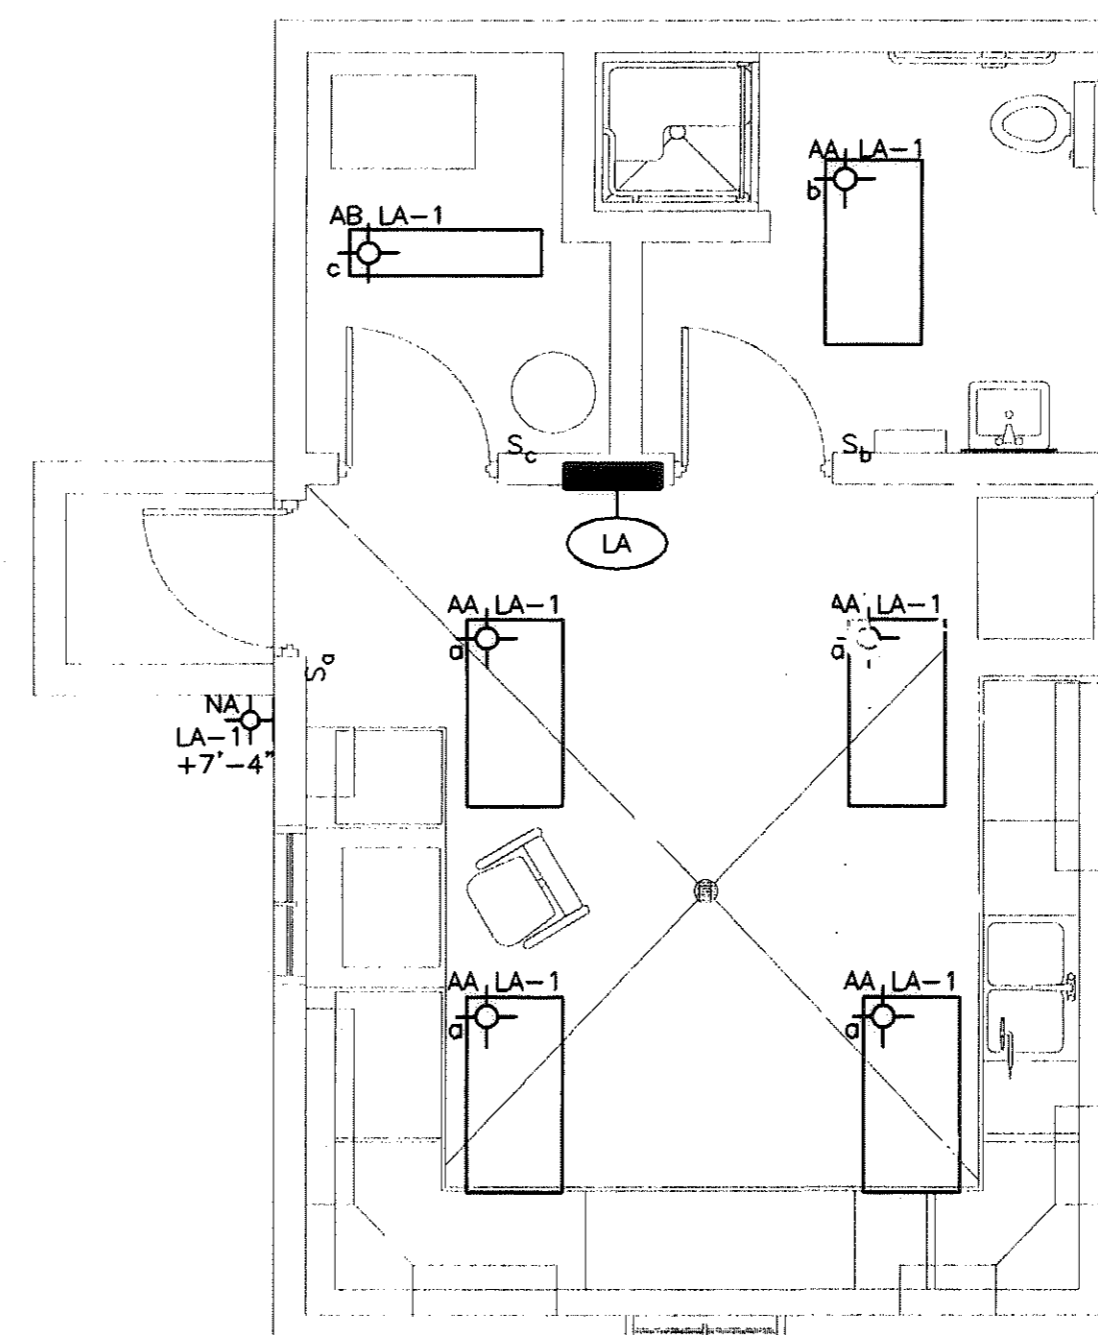


LAB BUILDING LIGHTING FLOOR PLAN (ALT. BID)
 SCALE: 1/4"=1'-0"

CODE NO.	MANUAL	MOTOR STARTERS			LOCATION	IN START COVER	CONTROLS			HP	VOLTS	PHASE	SPEED	DESIGNATION
		COMBINATION CIR BKR	SW-FUSE	TYPE START			STYLE	LOCATION	NEMA ENCL					
1	●				LAB BUILDING	4				1/4	120	1	1	EXHAUST FAN #1
2	●				LAB BUILDING	4				1/4	120	1	1	EXHAUST FAN #2
3	●				LAB BUILDING	4				1/4	120	1	1	EXHAUST FAN #3

STYLE	ILLUSTRATION	FUNCTION
1		ON PILOT LIGHT
2		HAND-OFF-AUTO SWITCH
3		ON-OFF CONTROL
4		ON PILOT LIGHT ON-OFF CONTROL
5		FAST PILOT LIGHT SLOW PILOT LIGHT FAST SLOW SELECTOR SW.
6		FAST PILOT LIGHT SLOW PILOT LIGHT FAST PUSHBUTTON SLOW PUSHBUTTON STOP PUSHBUTTON

TYPE	MOUNTING	LAMPS	NOMINAL DIMENSION	MFGR & CAT NO. OR ACCEPTABLE EQUIVALENT	REMARKS
AA (ALT. BID)	SURFACE	(4) 32W F32TB	2' x 4'	LITHONIA 'M SERIES' DAYBRITE, METALUX, KLP, HUBBELL, COLUMBIA	SURFACE MOUNTED, 0.125" KSH-K12 ACRYLIC PRISMATIC LENS IN FLUSH STEEL DOOR, STEEL HOUSING, BAKED WHITE ENAMEL FINISH, 120 VOLT ELECTRONIC BALLAST(S).
AB	SURFACE	(2) 32W F32TB	6" x 4'	DAYBRITE 'VAPORLUME' METALUX 'VT SERIES' LITHONIA 'DV SERIES'	WHITE ONE PIECE, MOLDED FIBERGLASS REINFORCED POLYESTER BODY, NON-CORROSION, CONTINUOUS COMPRESSIBLE CLOSED CELL GASKETED TIGHT SEAL BETWEEN PLASTIC ENCLOSURE AND BODY. U.L. LISTED FOR DAMP LOCATION. LOW TEMPERATURE 120V. ELECTRONIC BALLAST.
NA	WALL	(1) 70W HPS		HUBBELL 'PERIMAX' HOLOPHANE KEENE	WALL MOUNTED, DIE CAST ALUMINUM HOUSING, PRISMATIC POLYCARBONATE REFRACTOR, U.L. LISTED WET LOCATION LABEL, FL-5H AS SELECTED BY ENGINEER, INTEGRAL PHOTOCCELL, 120V HPF, PRIMARY FUSEL BALLAST RATED -20F.
PA	POLE	(1) 100W HPS	10-5/16" x 14-1/2" x 25-1/4"	HUBBELL 'NTP-150SB-NA-1' GARDCO, LITHONIA	ONE PIECE CAST ALUMINUM HOUSING, BRONZE FINISH, WITH GLASS REFRACTOR, 120V. HPF PRIMARY FUSED BALLAST, RATED -20F, U.L. LISTED FOR WET LOCATION. 12"-0" ROUND STRAIGHT ALUMINUM POLE, BRONZE FINISH LUMINAIRE. PROVIDE TENON POST MOUNT. (BASE BID WORK)

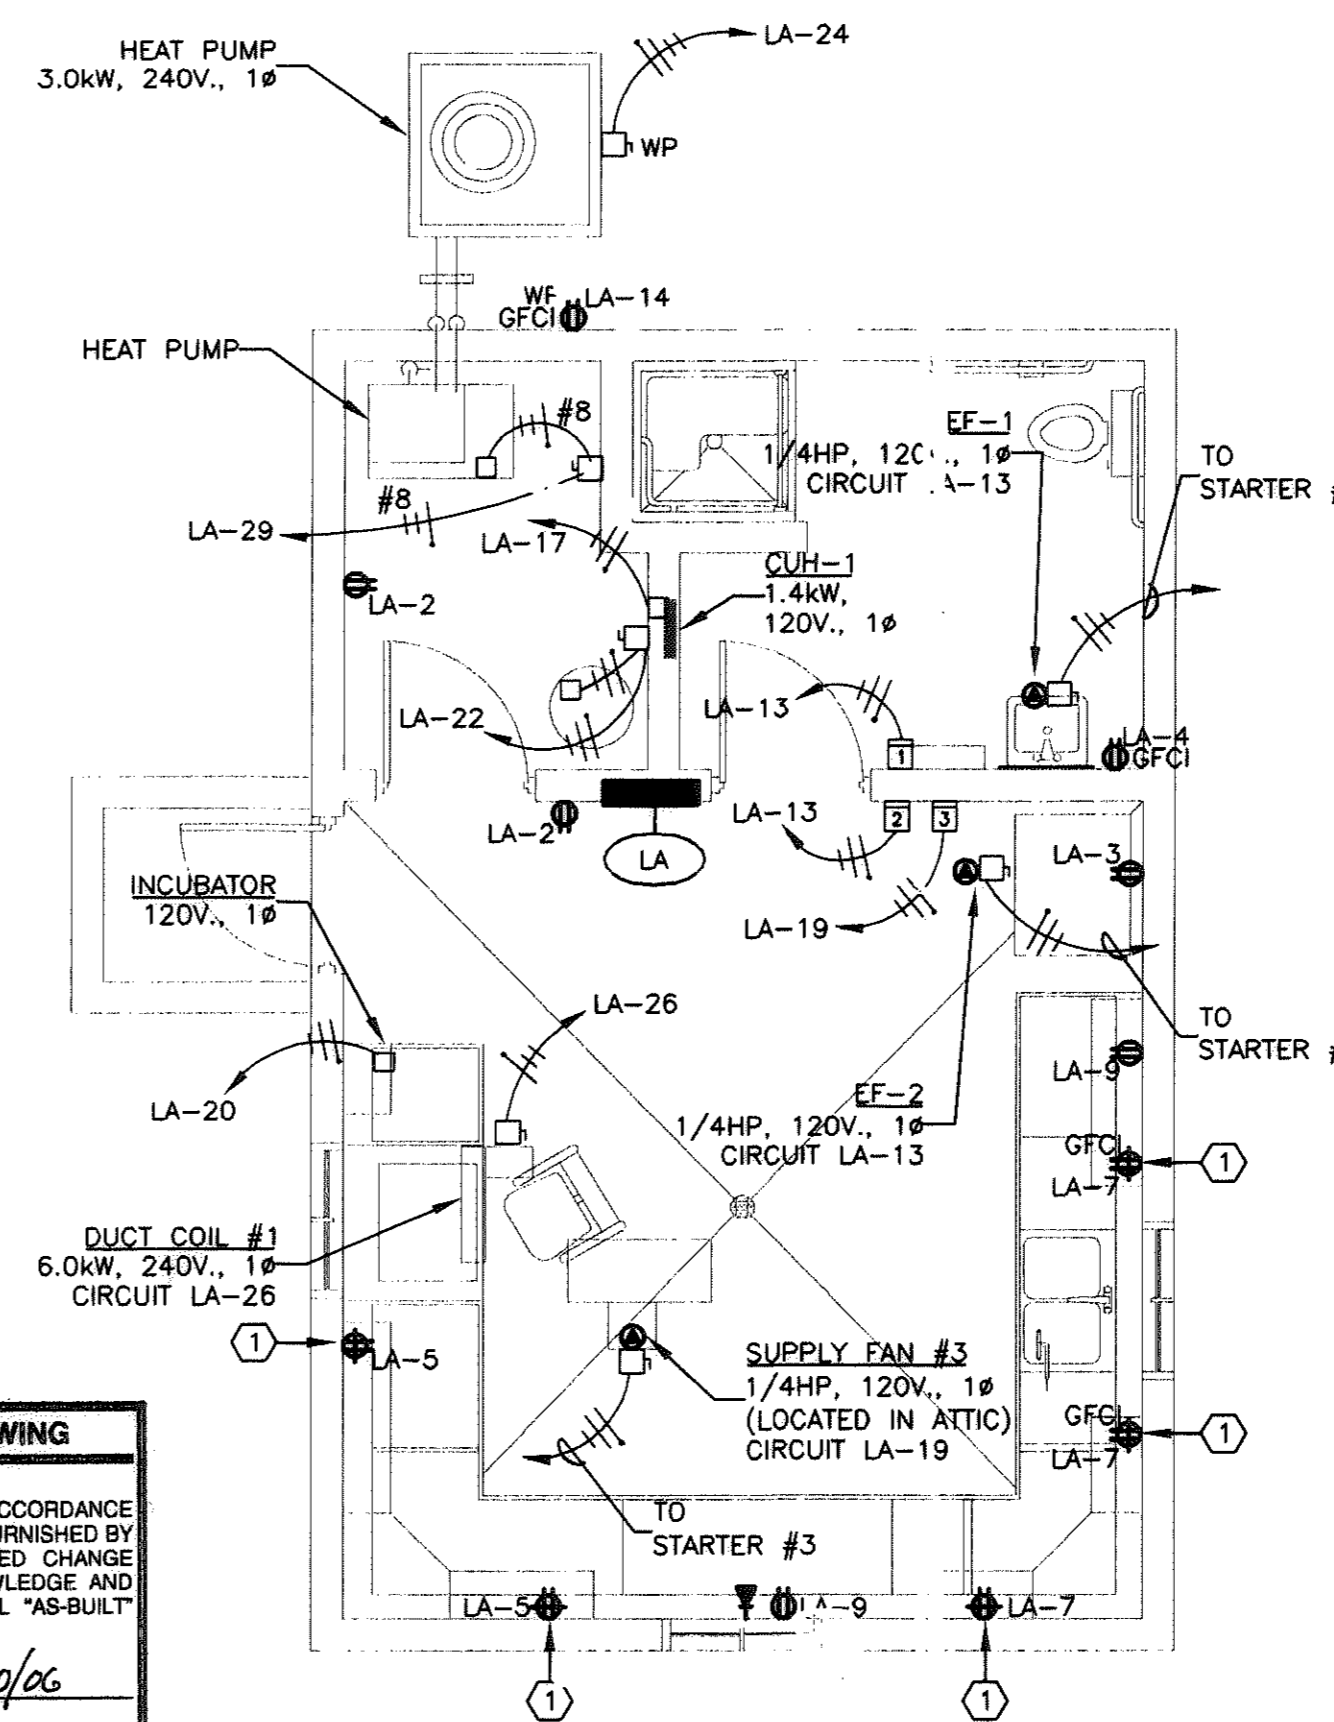


REVISED "AS-BUILT" DRAWING
 THIS DRAWING HAS BEEN REVISED IN ACCORDANCE WITH NOTES ON "PROPOSAL" AND "CHANGE ORDERS". TO THE BEST OF OUR KNOWLEDGE AND BELIEF, THIS DRAWING IS A TRUE "AS-BUILT" REPRESENTATION OF THE WORK.
 COMMONWEALTH ENGINEERS, INC. REVISION DATE 10/06
 BY: [Signature] OK BY: [Signature]

PLAN NOTES:
 (1) RECEPTACLE TO BE MOUNTED HORIZONTALLY ABOVE THE COUNTER BACKSPLASH.


LAB BUILDING POWER AND SYSTEMS FLOOR PLAN (ALT. BID)
 SCALE: 1/4"=1'-0"

(NOTE: THIS SHEET PART OF ALTERNATE BID)


			DRAWN BY: LTG DESIGNED BY: JTH CHECKED BY: RMS DATE: 3/04 JOB NO: 60385 SCALE: AS NOTED	SALAMONIE RESERVOIR WASTEWATER TREATMENT PLANT IMPROVEMENTS PROJECT PUBLIC WORKS PROJECT NO. E031410M LAB/ADMIN. BUILDING ELECTRICAL PLAN	DRAWING NO. E4 50 OF 52
			301-67		

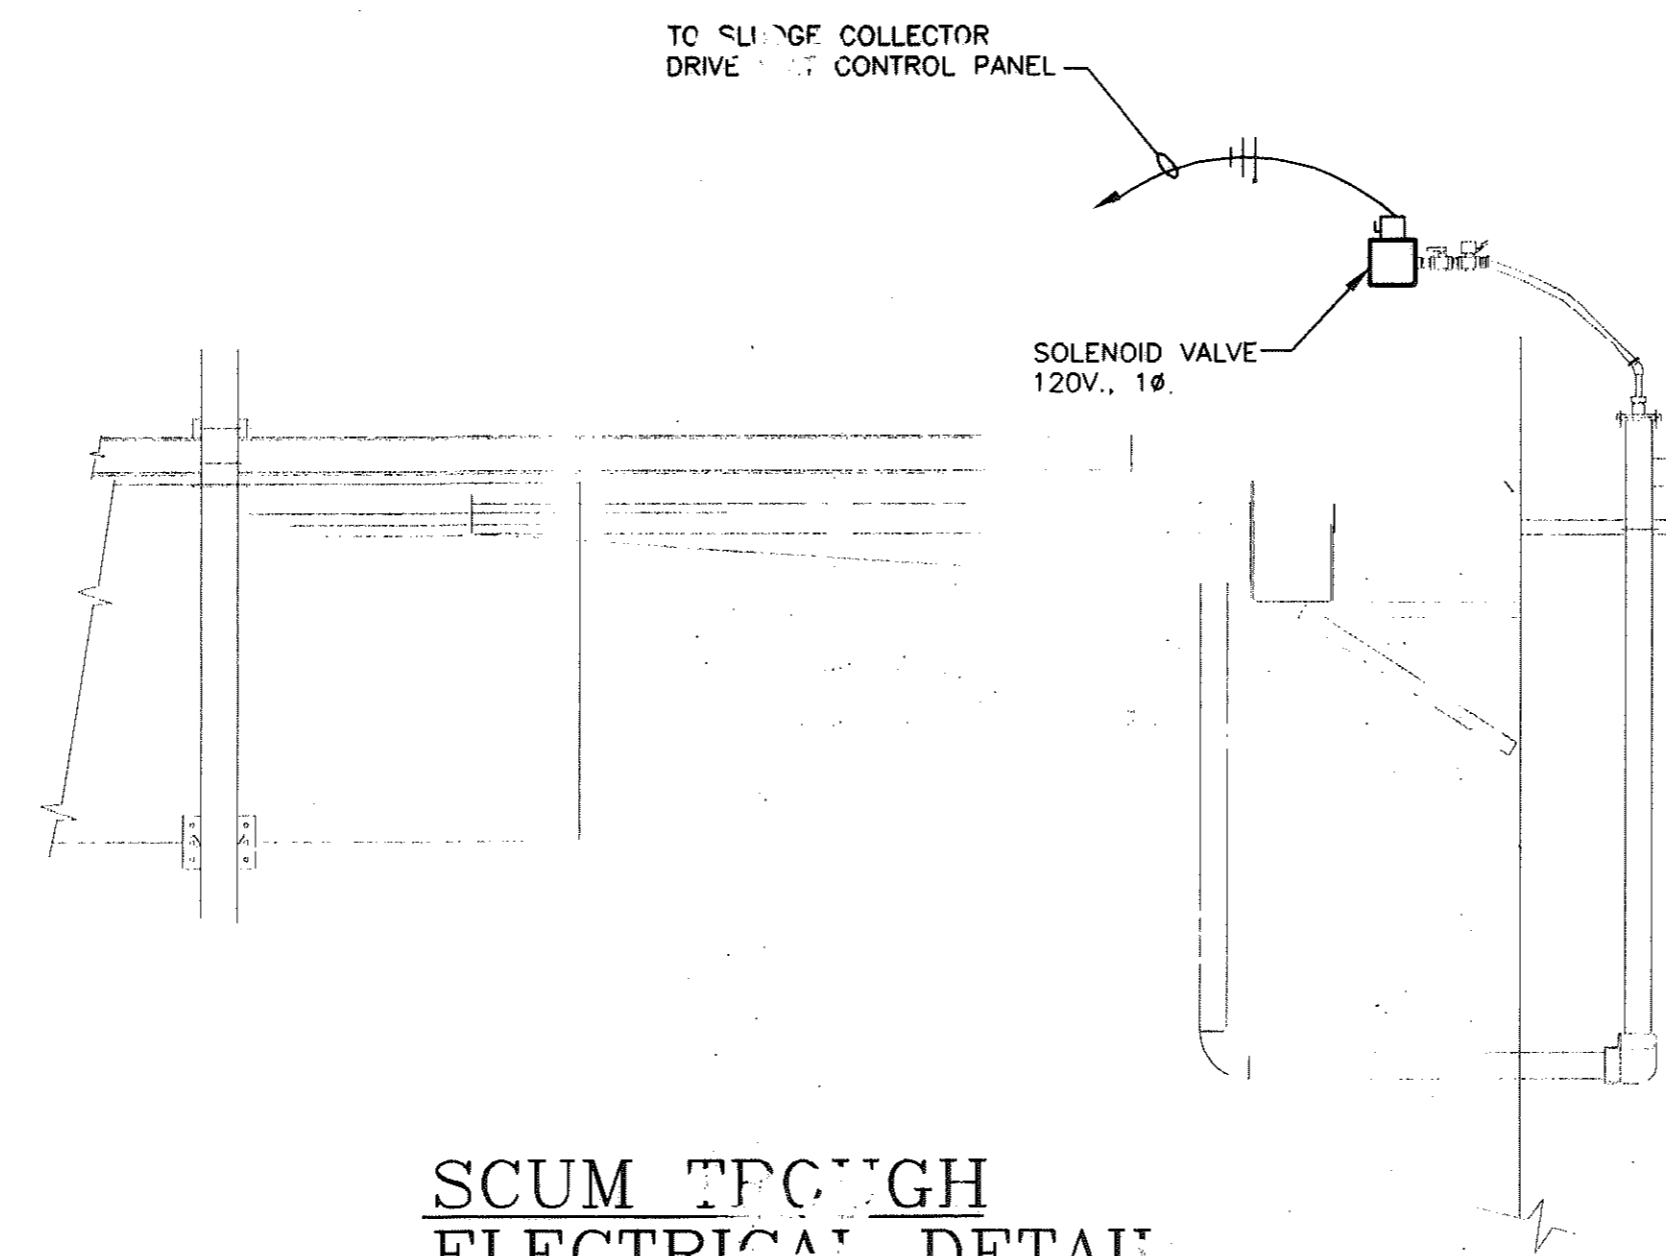


**SCUM TROUGH
ELECTRICAL DETAIL**
SCALE: N.T.S.

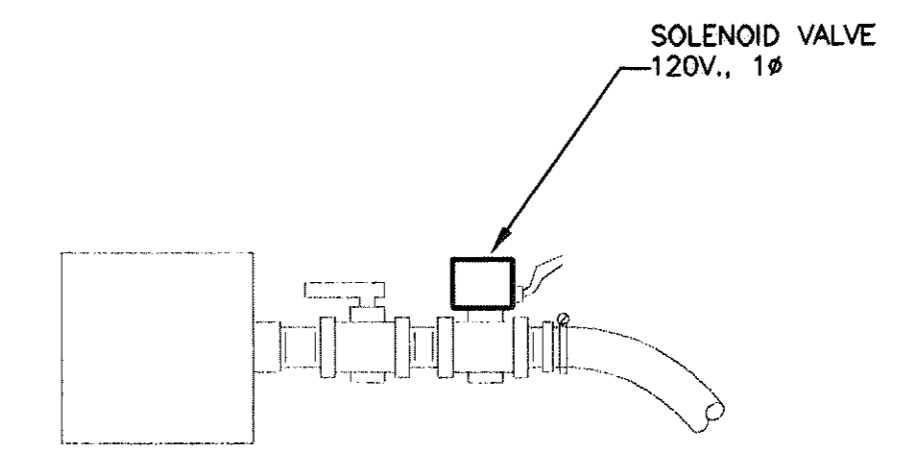

**3/4" SCUM EJECTOR AIR SUPPLY
ELECTRICAL DETAIL**
SCALE: N.T.S.

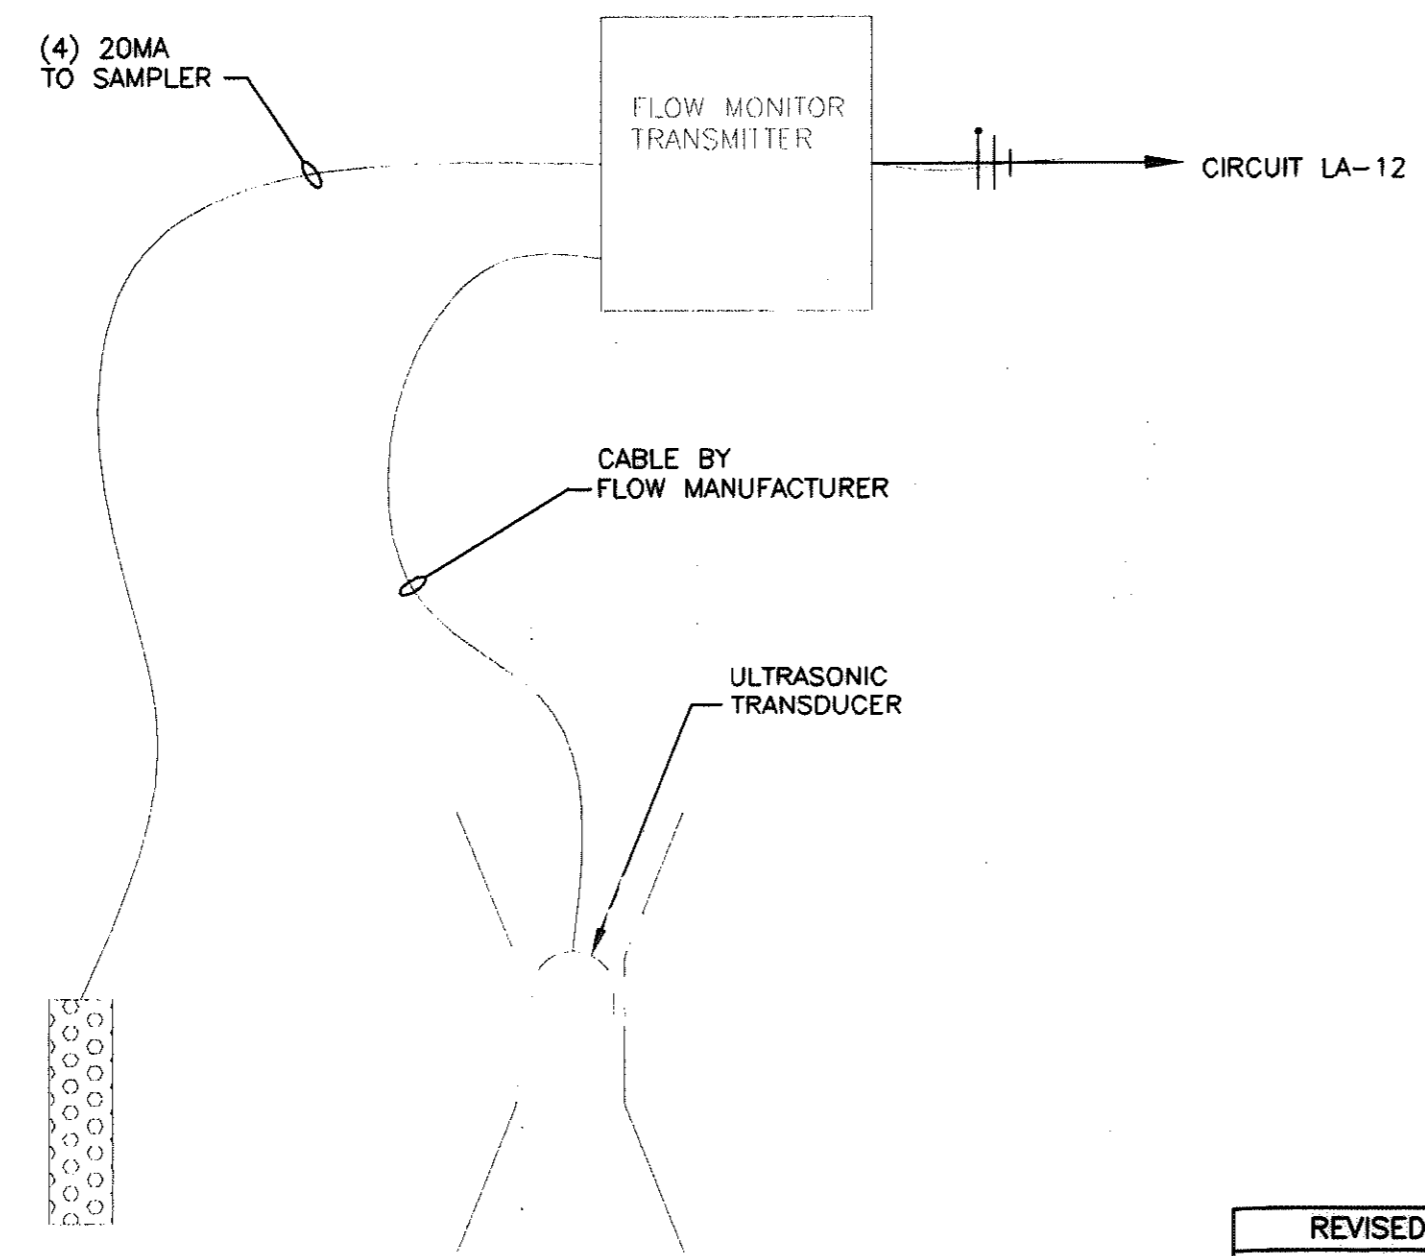


**METERING/SAMPLING CONTROLS
ELECTRICAL DIAGRAM**
SCALE: N.T.S.

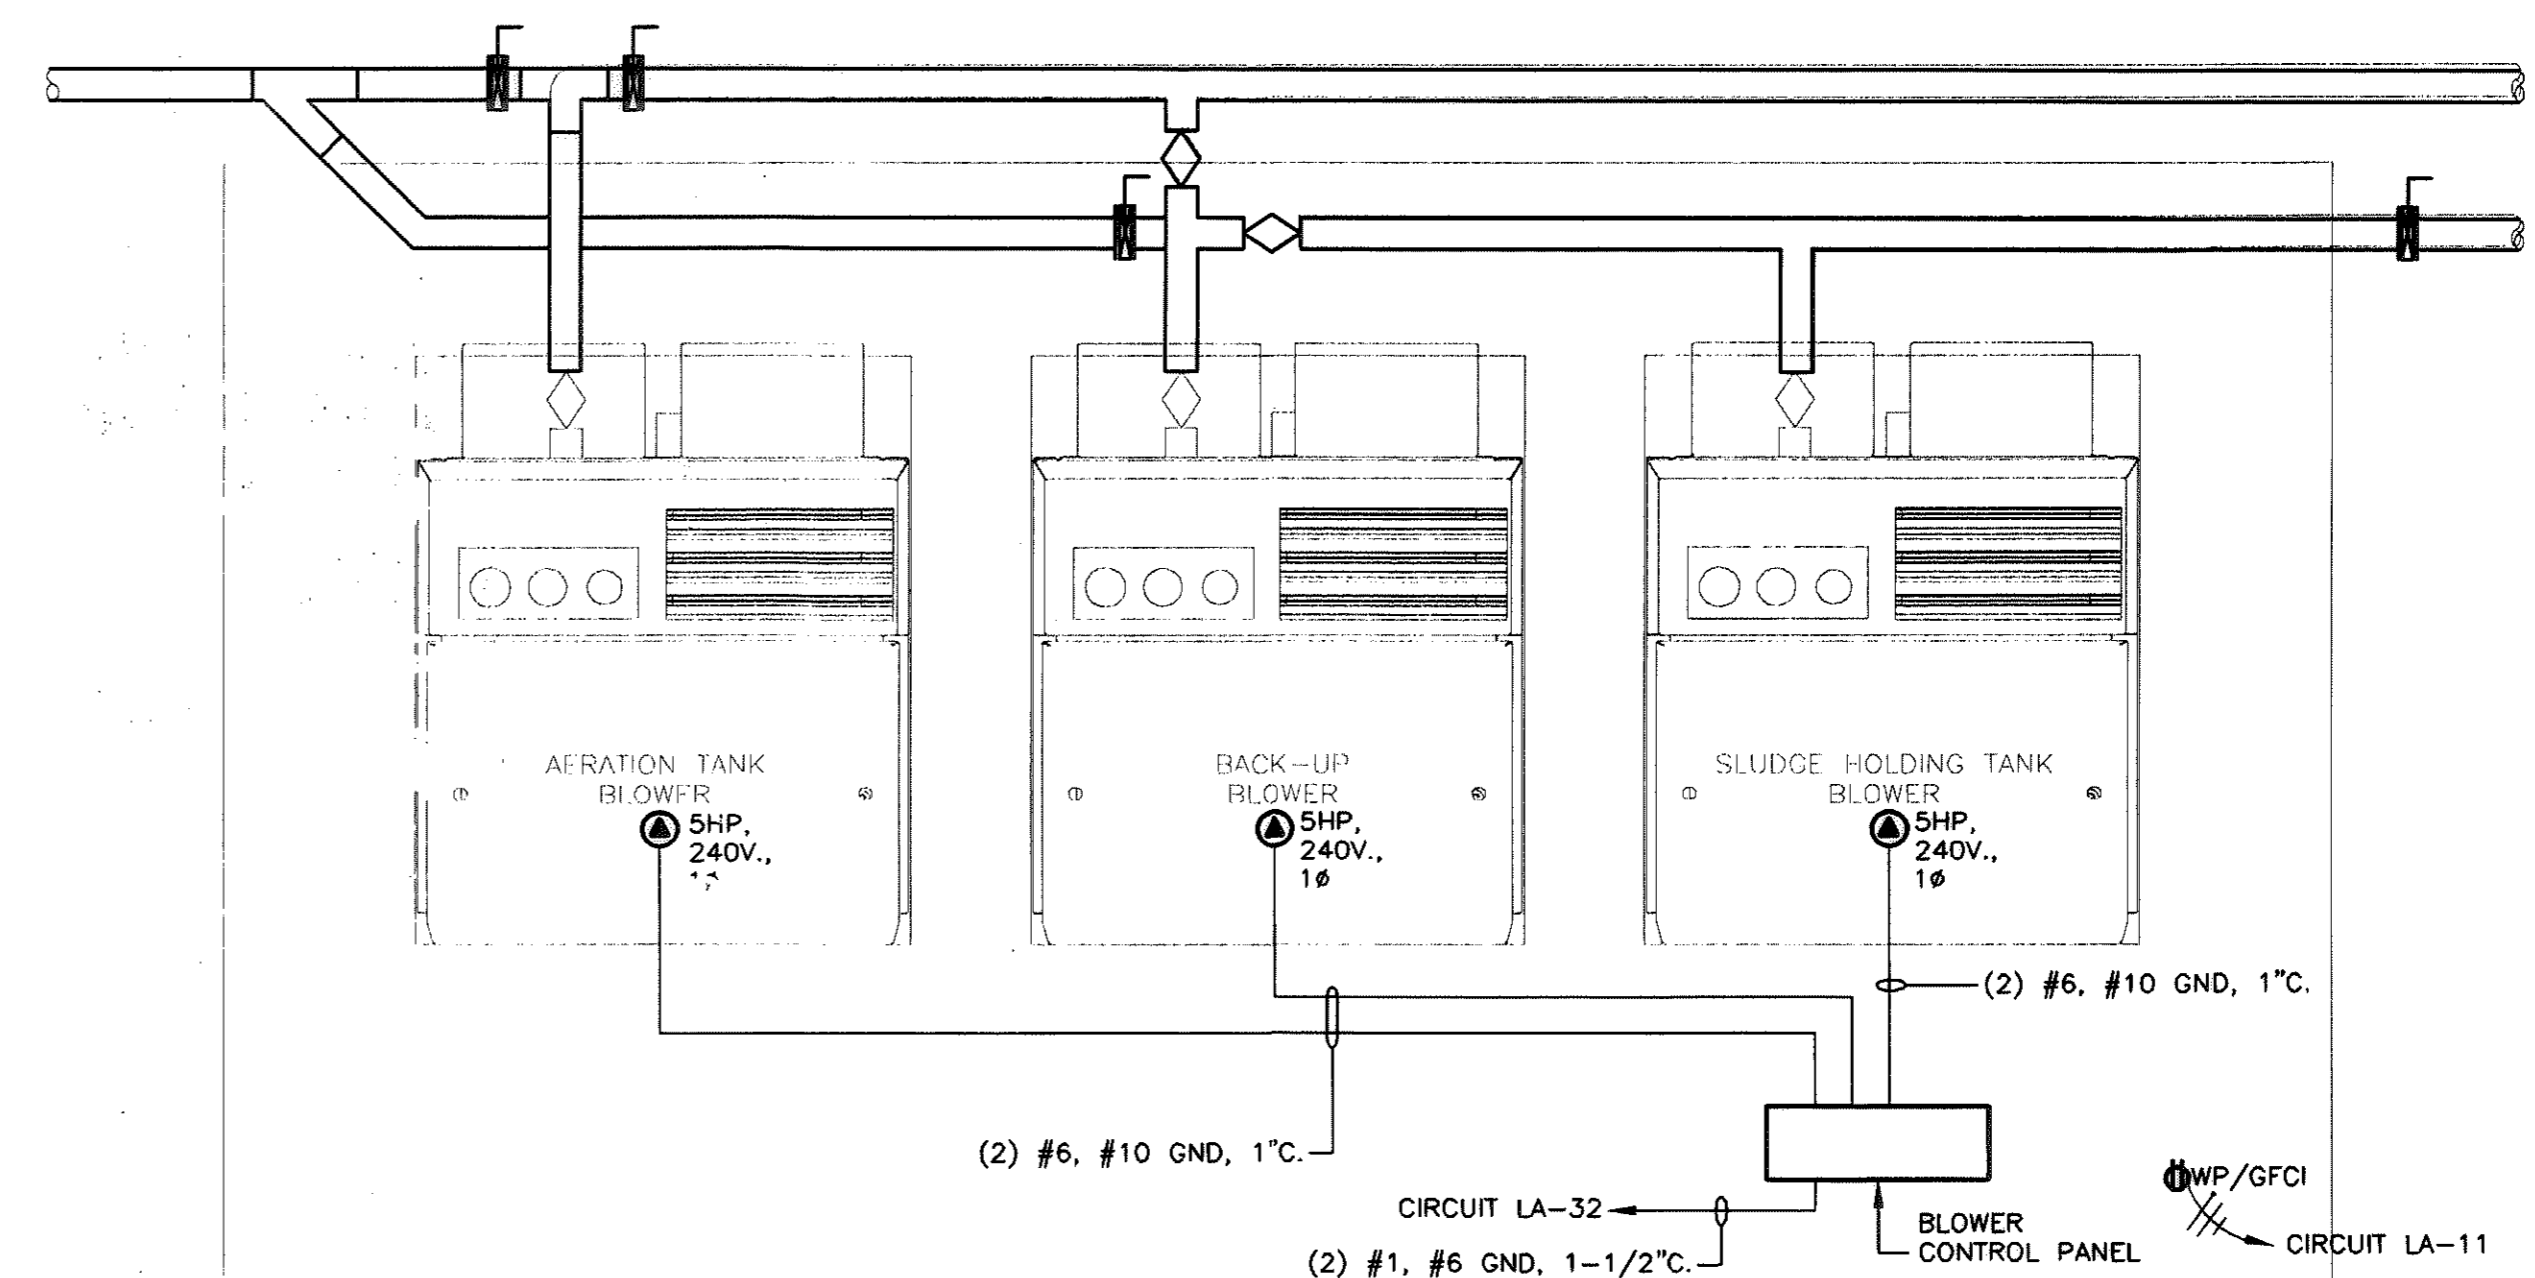

**BLOWER PAD
ELECTRICAL PLAN VIEW**
SCALE: N.T.S.

REVISED "AS-BUILT" DRAWING
THIS DRAWING HAS BEEN REVISED IN ACCORDANCE WITH NOTES ON "RECORD DRAWINGS" FURNISHED BY THE CONTRACTOR AND WITH EXECUTED CHANGE ORDERS. TO THE BEST OF OUR KNOWLEDGE AND BELIEF, THIS DRAWING SHOWS ACTUAL "AS-BUILT" CONDITIONS.
COMMONWEALTH ENGINEERS, INC.
REVISED DATE: 10/06
BY: J.C.W., CK. BY:

Rotz Engineers
inc.

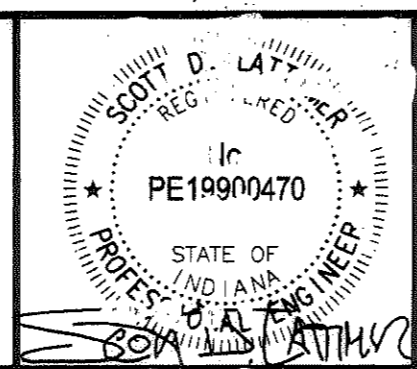

COMMONWEALTH ENGINEERS, INC.

DRAWN BY: LTG
DESIGNED BY: JTH
CHECKED BY: RMS
DATE: 3/04
JOB NO: 6038S
SCALE: AS NOTED

SALAMONIE RESERVOIR
WASTEWATER TREATMENT PLANT IMPROVEMENTS PROJECT
PUBLIC WORKS PROJECT NO. E031410M
MISCELLANEOUS ELECTRICAL DETAILS

DRAWING NO.
E5
51 OF 52

301-63