



Indiana Department of Environmental Management Office of Water Quality Wetlands Section

Publication Date:
September 10, 2024

IDEM ID Number:
2024-694-92-GCW-WQC

Closing Date:
October 1, 2024

PUBLIC NOTICE

Corps of Engineers ID Number:
LRE-2024-00470-192-N24

To all interested parties:

This letter shall serve as a formal notice of the receipt of an application for **Section 401 Water Quality Certification** by the Indiana Department of Environmental Management (IDEM). The purpose of the notice is to inform the public of active applications submitted for water quality certification under Section 401 of the Clean Water Act (33 U.S.C. § 1341) and to solicit comments and information on any impacts to water quality related to the proposed project. IDEM will evaluate whether the project complies with Indiana's water quality standards as set forth at 327 IAC 2.

1. Applicant: Jacob Burskey
Indiana Department of Transportation
100 N Senate Ave N 758-ES
Indianapolis, IN 46204

2. Agent: Lucas Bauer
DLZ Indiana
138 N Delaware St
Indianapolis, IN 46204

3. Project location: Latitude: 41.125410 Longitude: -85.507800

4. Affected waterbody: County Farm Ditch, one(1) emergent wetland, and one(1) forested wetland

5. Project Description: The existing structure carrying State Road 205 over County Farm Ditch will be replaced with a 120 ft long by 17 ft wide by 10 ft tall reinforced concrete box. This project will result in 120 linear feet of stream encapsulation, 5 linear feet of stream loss due to stream realignment, 53 linear feet of bank stabilization from the placement of riprap, and 0.02 acre of wetland impacts from the placement of riprap, concrete, and backfill. No mitigation is proposed for this project. Additional information may be found online at <https://www.in.gov/idem/5474.htm>

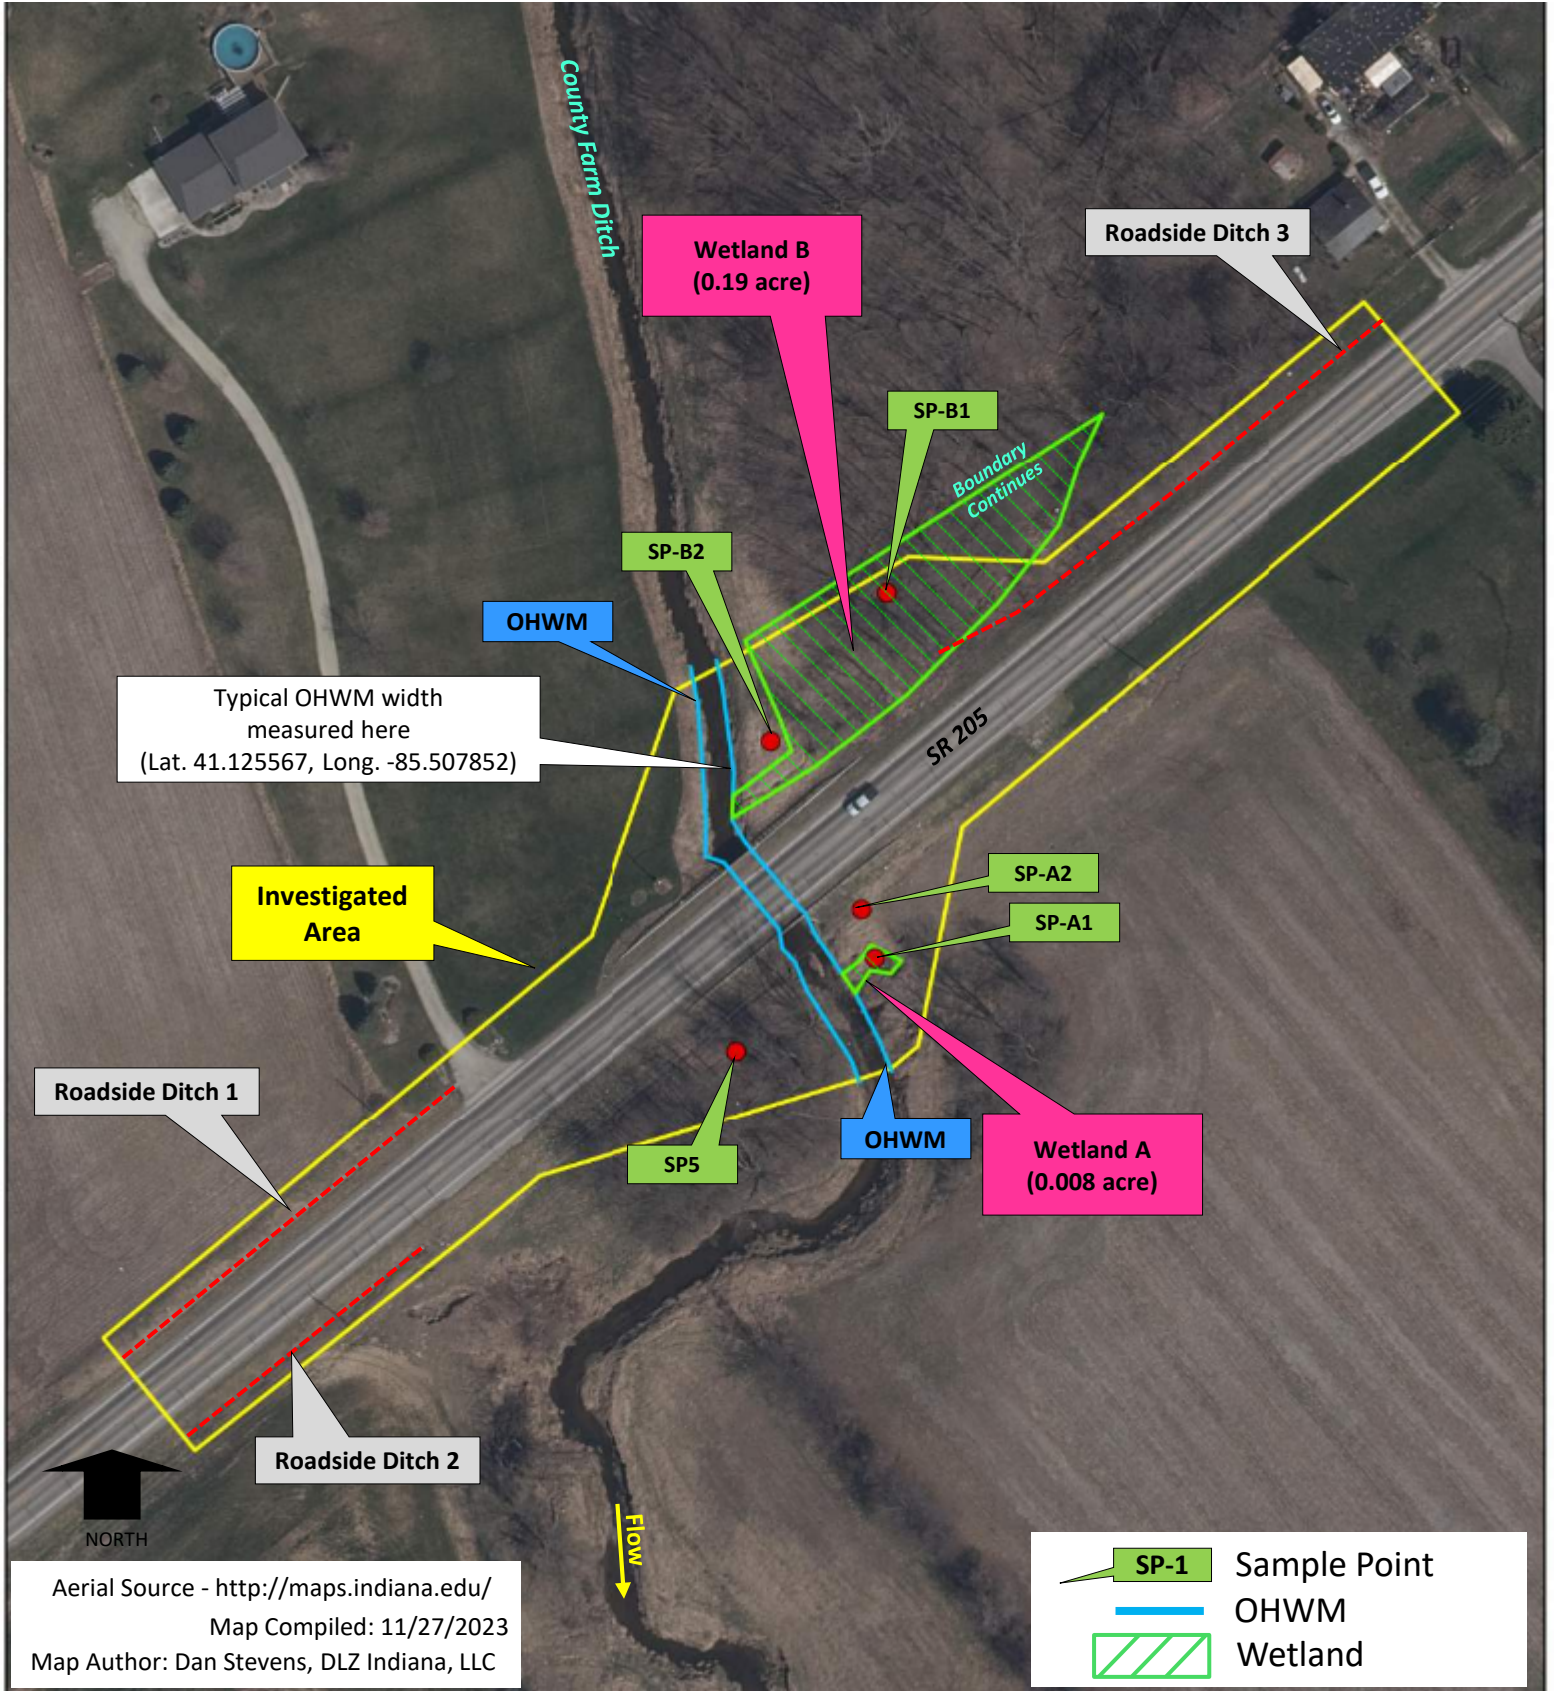
Comment period: Any person or entity who wishes to submit comments or information relevant to the aforementioned project may do so by the closing date noted above. Only comments or information related to water quality or potential impacts of the project on water quality can be considered by IDEM in the water quality certification review process.

Public Hearing: Any person may submit a written request that a public hearing be held to consider issues related to water quality in connection with the project detailed in this notice. The request for a hearing should be submitted within the comment period to be considered timely. The request should also state the reason for the public hearing as specifically as possible to assist IDEM in determining whether a public hearing is warranted.




Questions? Additional information may be obtained from Graham Wrin, Project Manager, by phone at 317-605-4105 or by e-mail at GCWrin@idem.in.gov. Please address all correspondence to the project manager and reference the IDEM project identification number listed on this notice. Indicate if you wish to receive a copy of IDEM's final decision. Written comments and inquiries may be forwarded to -


Indiana Department of Environmental Management
100 North Senate Avenue
MC65-42 WQS IGCN 1255
Indianapolis, Indiana 46204-2251 FAX: 317/232-8406

Site Map



Aerial Source - <http://maps.indiana.edu/>
 Map Compiled: 11/27/2023
 Map Author: Dan Stevens, DLZ Indiana, LLC

	SP-1 Sample Point
	OHWM
	Wetland

	WATERS REPORT SR 205 in Whitley County, Indiana Small Structure Replacement over County Farm Ditch 7.48 miles North of SR 5 Des: 2002247, Asset ID: 93002238, Structure: CV 205-092-007.48	Scale: 1"=100' <hr/> Figure: 8
---	---	-----------------------------------